


ESTIMATED QUANTITIES			
ITEM	DESCRIPTION	UNIT	QUANTITY
100.	Prepare Roadway R.O.W	Sta.	5
104.1	Remove Old Concrete, Pavement & Median	SY	146.5
104.2	Sawed Break-Out Groove	LF	269
110	Unclassified Road Excavation(Dens Cont.)	CY	2465
160	Placing 4\"/>		

LEGEND			
(Symbol)	Hand Mark		
(Symbol)	Low Pole		
(Symbol)	Municipal		
(Symbol)	Gas Meter		
(Symbol)	Gas Valve		
(Symbol)	Gas Line		
(Symbol)	Power Pole (Typical Pole Symbol)		
(Symbol)	Power Line		
(Symbol)	Guy Wire Anchor		
(Symbol)	Telephone Line		
(Symbol)	Water Meter		
(Symbol)	Water Valve		
(Symbol)	Water Line		
(Symbol)	Fire Hydrant		
(Symbol)	Manhole		
(Symbol)	Sanitary Sewer Line		
(Symbol)	Fence Line		
(Symbol)	Flow Direction Indicator		
(Symbol)	Property or Right-of-Way Line(ROW)		
(Symbol)	Existing Line		
(Symbol)	Traffic Pole Box		
(Symbol)	Man Arm Pole Foundation (Type A or B)		
(Symbol)	Padmount Pole Foundation (Type C)		
(Symbol)	Signal Illustration Pole Foundation (Type D)		
(Symbol)	Top Of Curb		
(Symbol)	Flow Line		

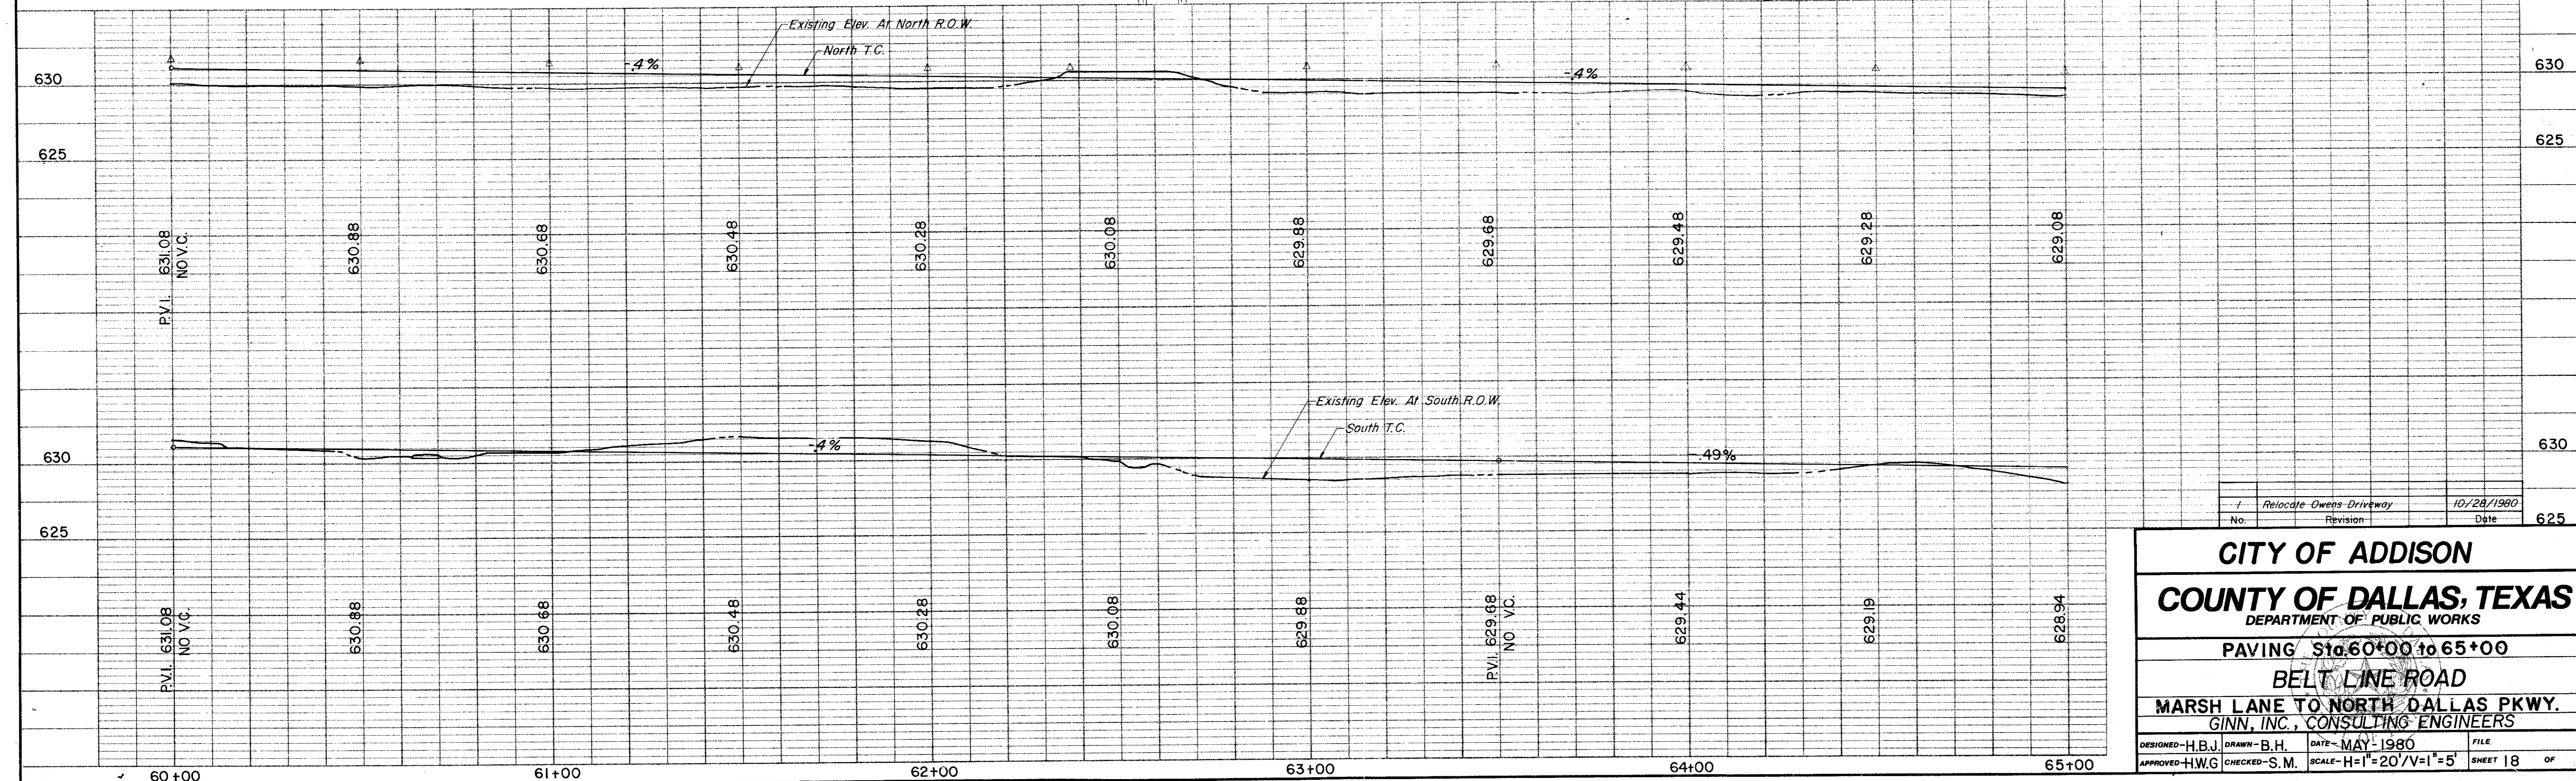

1 Relocate Owens Driveway 10/28/1980
No Revision Date

CITY OF ADDISON
COUNTY OF DALLAS, TEXAS
DEPARTMENT OF PUBLIC WORKS

PAVING STA. 60+00 to 65+00
BELT LINE ROAD
MARSH LANE TO NORTH DALLAS PKWY.
GINN, INC., CONSULTING ENGINEERS

DESIGNED-H.B.J. DRAWN-B.H. DATE-MAY-1980 FILE
APPROVED-H.W.G. CHECKED-S.M. SCALE-H=1"=20'/V=1"=5' SHEET 18 OF