


ESTIMATED QUANTITIES			
ITEM	DESCRIPTION	UNIT	QUANTITY
479.7	Sewer Encasement / C.I. Pipe	LF	10.0
465.1	18" R.C.P. CI III	LF	24.0
465.2	21" R.C.P. CI III	LF	50.0
470.2	10" Rec. Inlet - Comp. In Pl.	EA	2.0
479.6	Adjust 12" Water	LF	30.0
479.3	Adjust 20" Water	LF	10.0
469.3	Remove 54" R.C.P.	LF	297.0
464.14	Relay 54" R.C.P.	LF	135.0

LEGEND	
□	Bench Mark
○	Iron Pin
○	Manhole
○	Gas Meter
○	Gas Valve
○	Gas Line
○	Power Pole (Typical Pole Symbol)
○	Power Line
○	Ray Wire Anchor
○	Telephone Line
○	Water Meter
○	Water Valve
○	Water Line
○	Fire Hydrant
○	Mechanic
○	Sanitary Sewer Line
○	Force Line
○	Flow Direction Indicator
○	Property or Right-of-Way Line(S/W)
○	Encasement Line
○	Traffic Pull Box
○	Mass Arm Pole Foundation (Type A or B)
○	Pedestal Pole Foundation (Type C)
○	Signal Illumination Pole Foundation (Type D)
○	Top of Curb
○	Flow Line

B.M. 13, "o" Top of Curb At Curb Return - East Side Of Business Ave. & North Of Belt Line, ELEV = 579.88

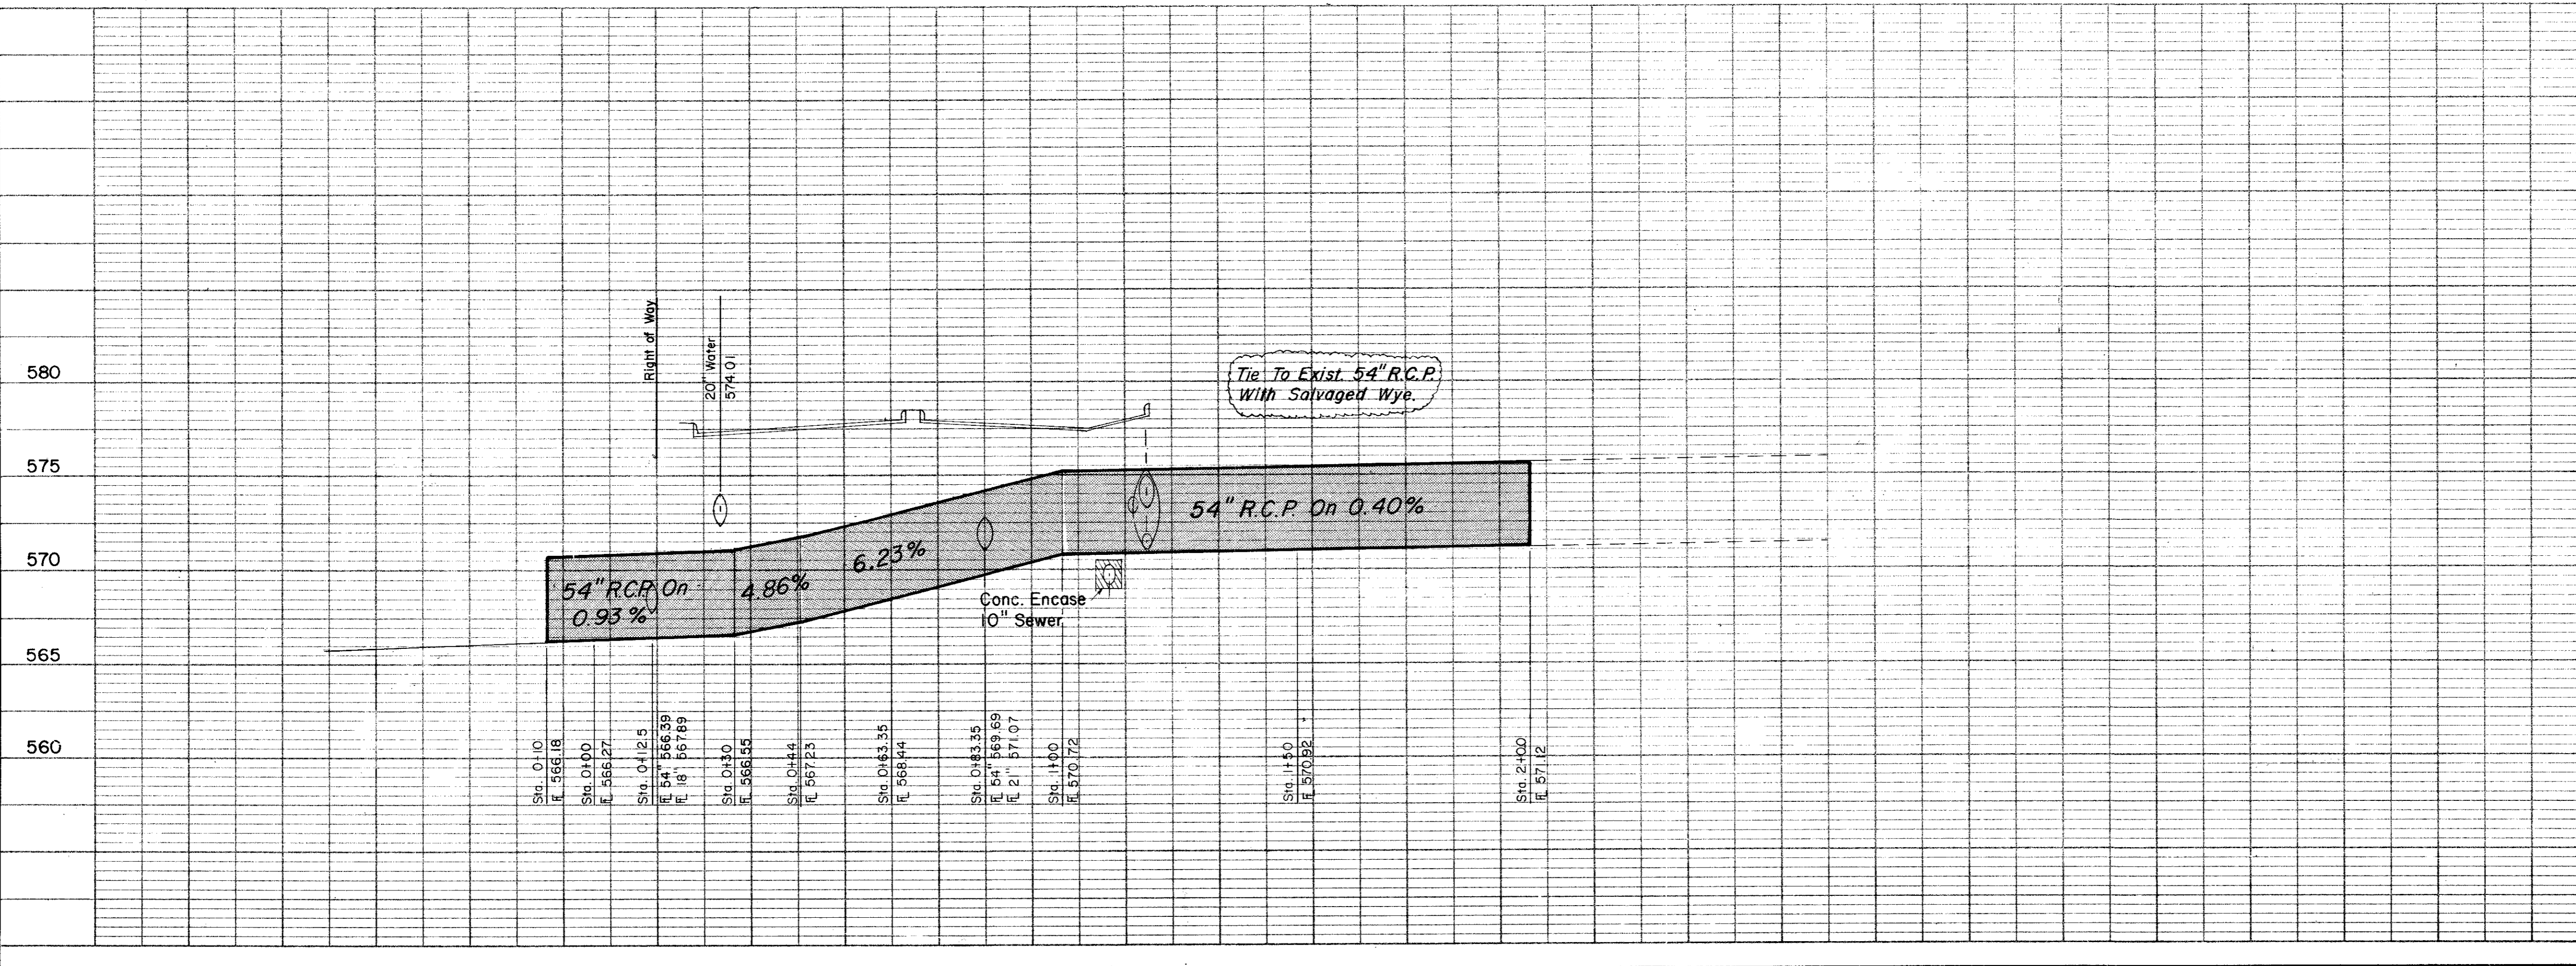

NO.	REVISION	DATE
3	Chg 54" R.C.P.	9-22-80
2	Chg 54" R.C.P.	7-24-80
1	Added Sh.	6-13-80

CITY OF ADDISON
COUNTY OF DALLAS, TEXAS
 DEPARTMENT OF PUBLIC WORKS

DRAINAGE STA. 10100 - 15100
BELT LINE ROAD

MARSH LN. TO NORTH DALLAS PKWY.
GINN, INC., CONSULTING ENGINEERS

DESIGNED-A.C.F. DRAWN-S.M. DATE-JUNE 1980 FILE
 APPROVED-HWG. CHECKED-B.H. SCALE-H=1"=20'/V=1"=5' SHEET 32A OF