


ITEM	DESCRIPTION	UNIT	QUANTITY
421.3	Cl. A Conc. For Manhole	CY	4.76
440.3	Extend 6x3 Box (Conc.)	CY	12.34
440.3	Reinf. Steel - Manhole	LBS	479.0
440.4	Reinf. Steel - Box Culvert	LBS	2085.0
465.1	18" RCP, CI III	LF	73.0
465.2	21" RCP, CI III	LF	99.0
465.3	24" RCP, CI III	LF	165.0
465.4	30" RCP, CI III	LF	149.0
	Std 5x5' Y Inlet	EA	1.0

LEGEND	
●	Check Mark
○	Iron Pin
□	Manhole
⊠	Gas Meter
⊞	Gas Valve
⊟	Gas Line
⊠	Power Pole (Typical Pole Symbol)
⊞	Power Line
⊟	Utility Wire Anchor
⊠	Telephone Line
⊞	Water Meter
⊟	Water Valve
⊠	Water Line
⊞	Fire Hydrant
⊟	Manhole
⊠	Sanitary Sewer Line
⊞	Fence Line
⊟	Flow Direction Indicator
⊠	Property or Right-of-Way Line (Dotted)
⊞	Traffic Pole Box
⊟	Man Arm Pole Foundation (Type A or B)
⊠	pedestal Pole Foundation (Type C)
⊞	Signal Illumination Pole Foundation (Type D)
⊟	Top of Curb
⊠	Flow Line

Curve	Δ	R	T	L
C-1	6° 28' 33"	820'	47.57'	95.03'
C-2	16° 39' 52"	250'	36.61'	72.71'

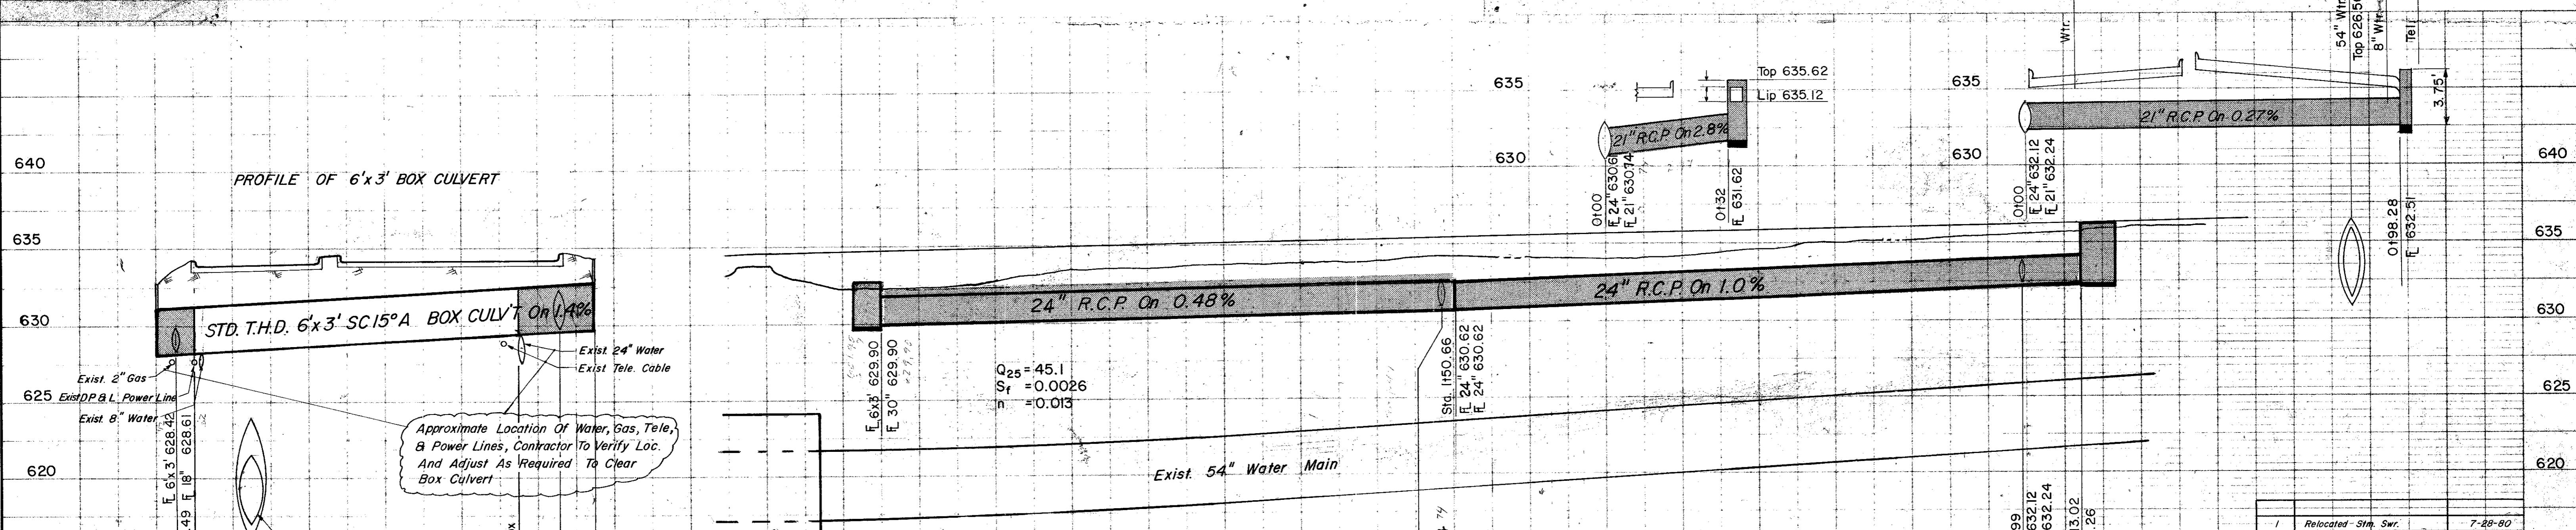

CITY OF ADDISON
COUNTY OF DALLAS, TEXAS
 DEPARTMENT OF PUBLIC WORKS
DRAINAGE STA. 78100 - 82100
BELT LAKE ROAD
MARSH LN. TO NORTH DALLAS PKWY.
GINN, INC., CONSULTING ENGINEERS

DESIGNED - J.C.H. DRAWN - S.M. DATE - MAY - 1980 FILE
 APPROVED - HWG CHECKED - S.M. SCALE - H=1"=20' V=1"=5' SHEET 42 OF