

83-2  
BELT LINE 2002 GROOVING

ACC BELT LINE Rd. 2002-2003

Pavement Markings

West Bound Belt Line Missing for Plan.

- 1) SB Runway - Left Turn Arrow
- 2) Local lane W of Commercial - 4 right turn Arrows
- 3) SE Business - 1 Left turn Arrow, 1 Straight/Right Arrow
- 4) Local lane @ 3711 E. - 1 Rt. arrow
- 5) WB & right lane - 2 straight/right arrows

EB Belt Line

- 1) Repair tail on arrow (first left turn arrow approaching Business)
- 2) NB Beltwood - Left arrow
- 3) NB Inwood - stop bar
- 4) NB landmark - stop bar
- 5) Local lane/Rt. turn lane approaching DP - 2 rt. turn arrows

Questions

- 1) Crosswalk @ Dallas Plwy. - Atk. diff.
- 2) Crosswalk south side of Inwood/BL between Benedicts + Candanial
- 3) Stop bars @ Inwood (NB) and Beltwood (NB) should be closer to intersection
- 4) Triangle @ Shell station is hatched, but no direction given
- 5) Bold arrow @ Bayless/Harveys NE driveway, but no direction

# TOWN OF ADDISON


## CONSTRUCTION PLANS FOR

# PAVEMENT GROOVING IMPROVEMENTS

### AUGUST 2002

### INDEX OF DRAWINGS

- 1. COVER SHEET
- 2. GENERAL NOTES & QUANTITY SHEET
- 3. CONSTRUCTION PHASING PLAN
- 4. PAVEMENT REPAIR PLAN
- 5. PAVEMENT MARKING PLAN
- 6. DETAIL SHEET

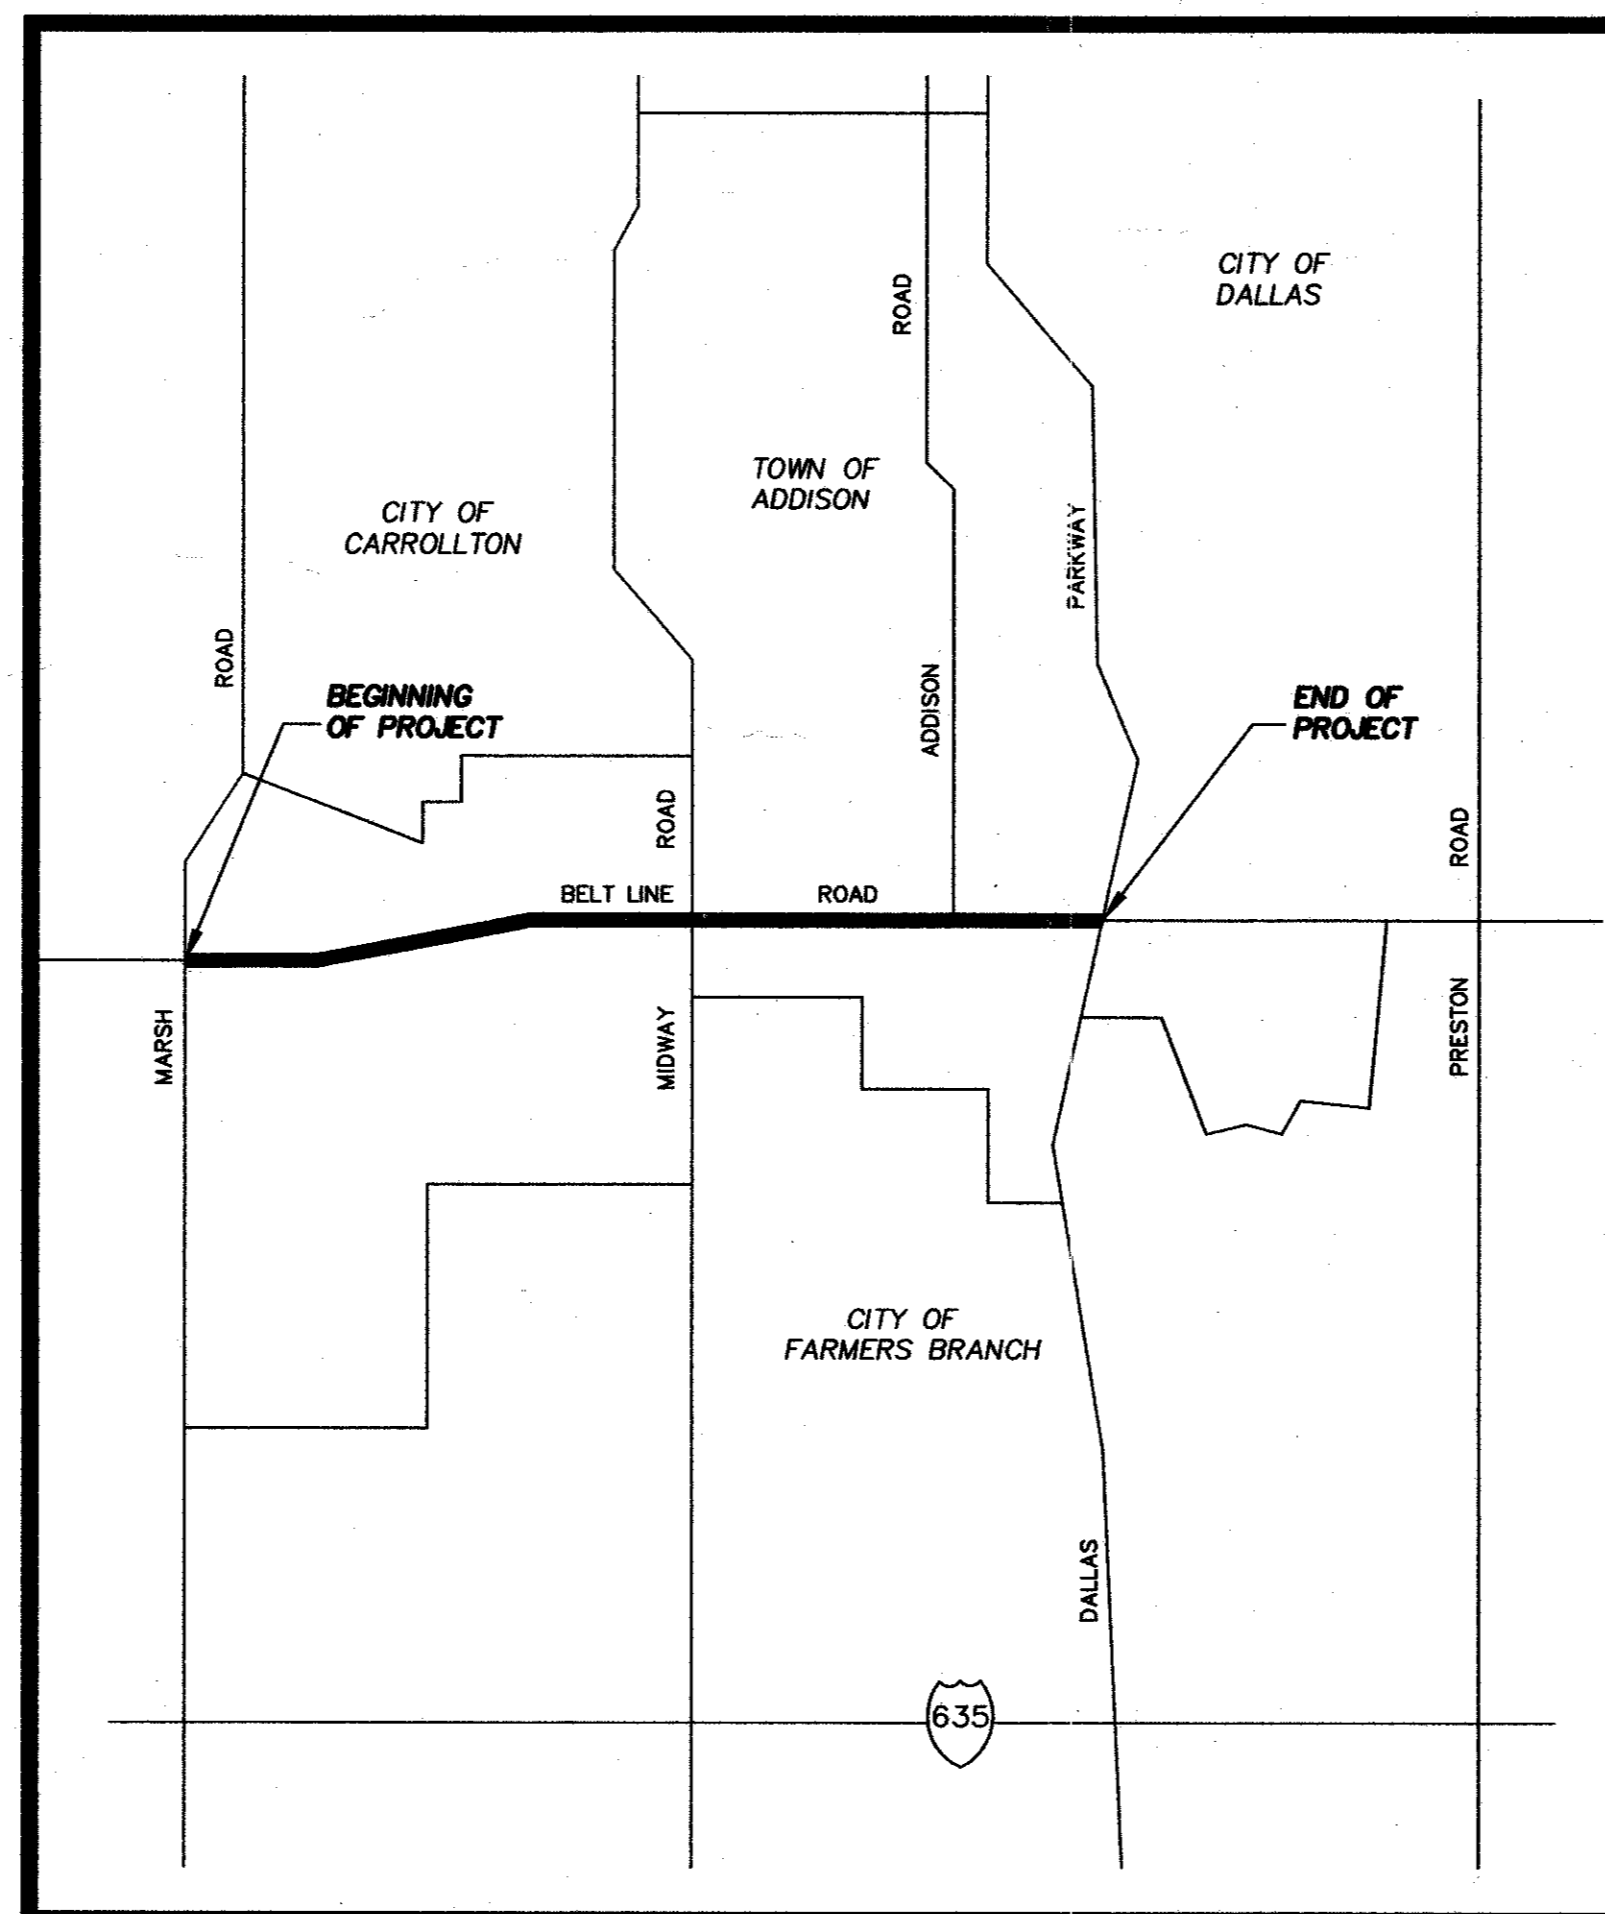

VICINITY MAP  
N.T.S.

### CITY OFFICIALS

**MAYOR**  
R. Scott Wheeler

**COUNCIL**  
Cathy Ways (Mayor Pro Tempore)  
Bob Barrett (Deputy Mayor Pro Tempore)  
Diane Mallory  
Glynda Turner  
Joe Chow  
Fredric M. Silver


**CITY MANAGER**  
Ron Whitehead

**DIRECTOR OF PUBLIC WORKS**  
Mike Murphy, P.E.

APPROVED BY: Nicholas E. Murphy  
DIRECTOR OF PUBLIC WORKS  
TOWN OF ADDISON



5999 Summerside Drive, Suite 202  
Dallas, Texas 75252 (972)380-2605

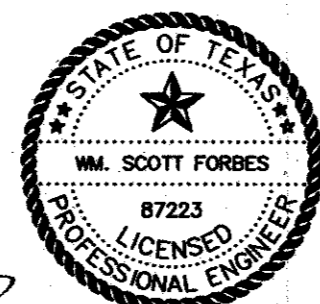

Wm Scott Forbes August 27, 2002  
WM. SCOTT FORBES, P.E.

PBS&J JOB NO. 450949

83-2  
BELT LINE GROOVING