


CITY OF ADDISON DALLAS COUNTY, TEXAS

CONSTRUCTION PLANS FOR: BELT LINE ROAD STORM SEWER

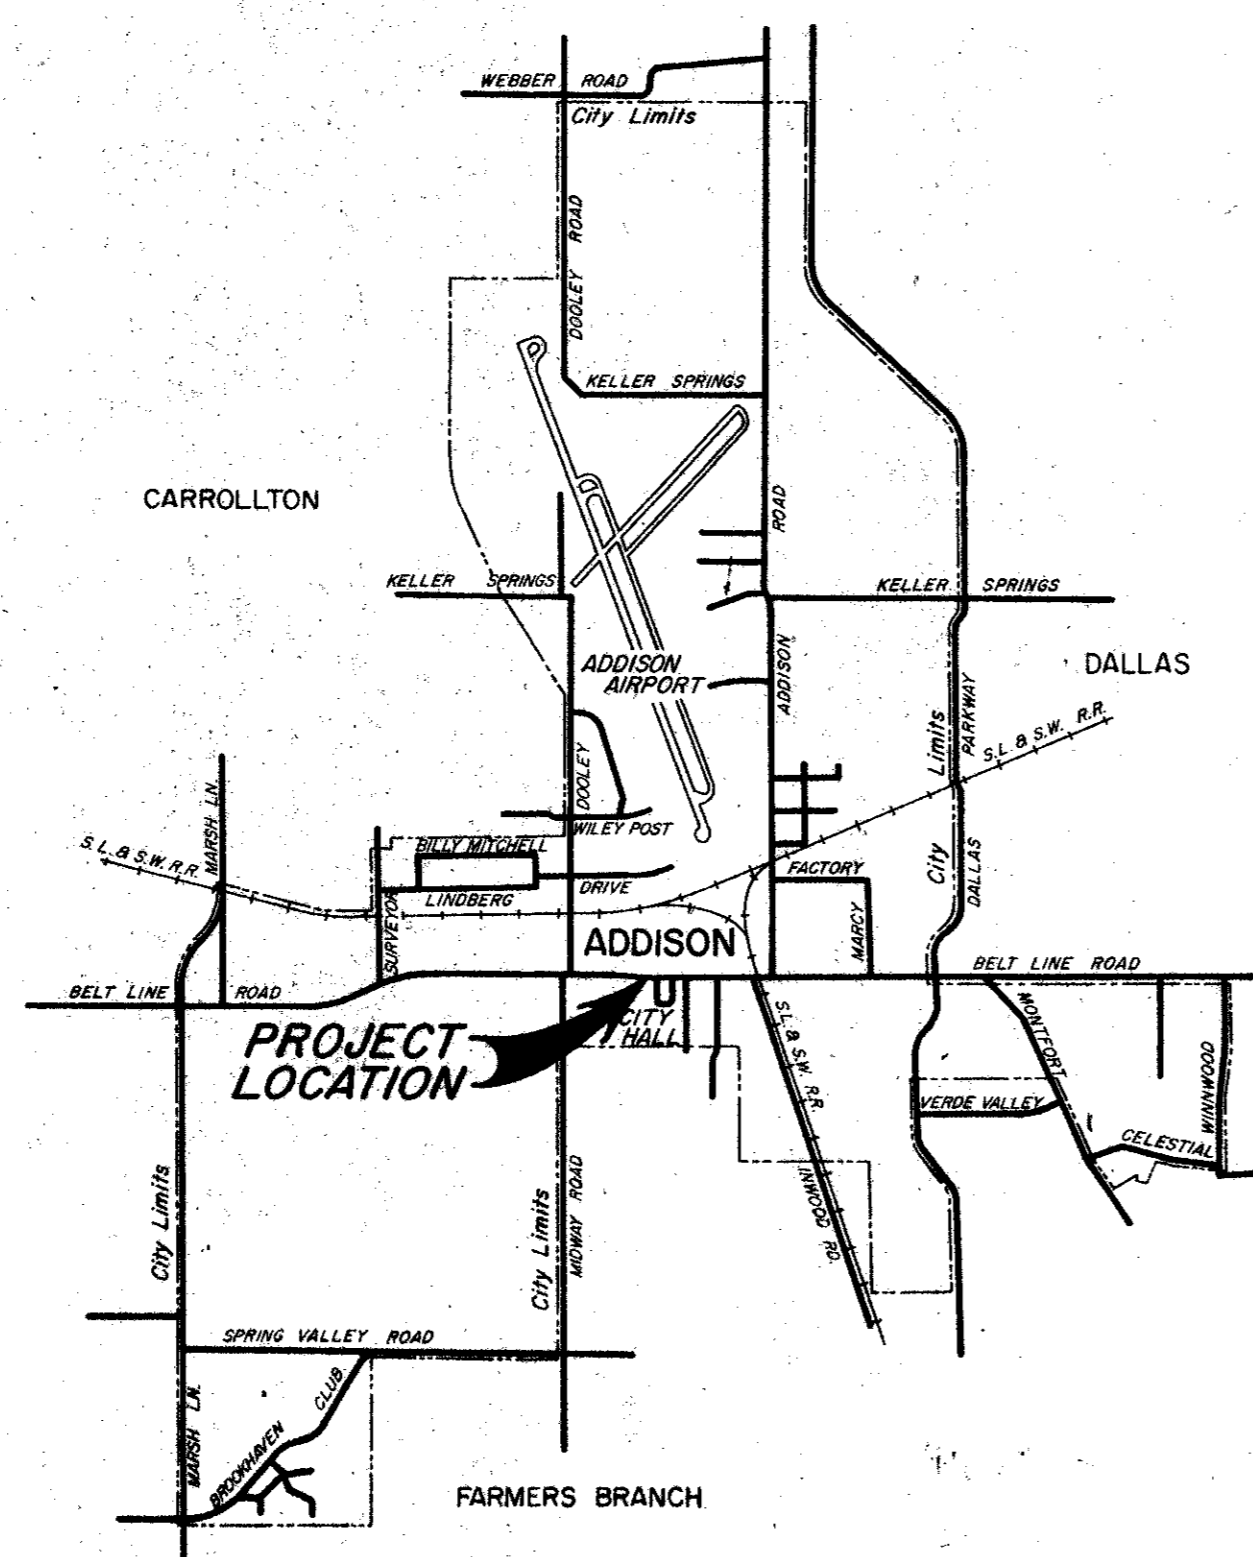

**JERRY J. REDDING - MAYOR
COUNCILMEN:**

**JOHN B. ALLEN
RICHARD RODER
WILLIAM F. SELLMAYER
A. E. MARCY
TERRY ROBERTS**

C. J. WEBSTER - CITY ADMINISTRATOR

GINN & STACY, INC.
CONSULTING ENGINEERS
DALLAS, TEXAS
1977



*Drawer # 5
Iron # 7*

RECORD DRAWINGS