
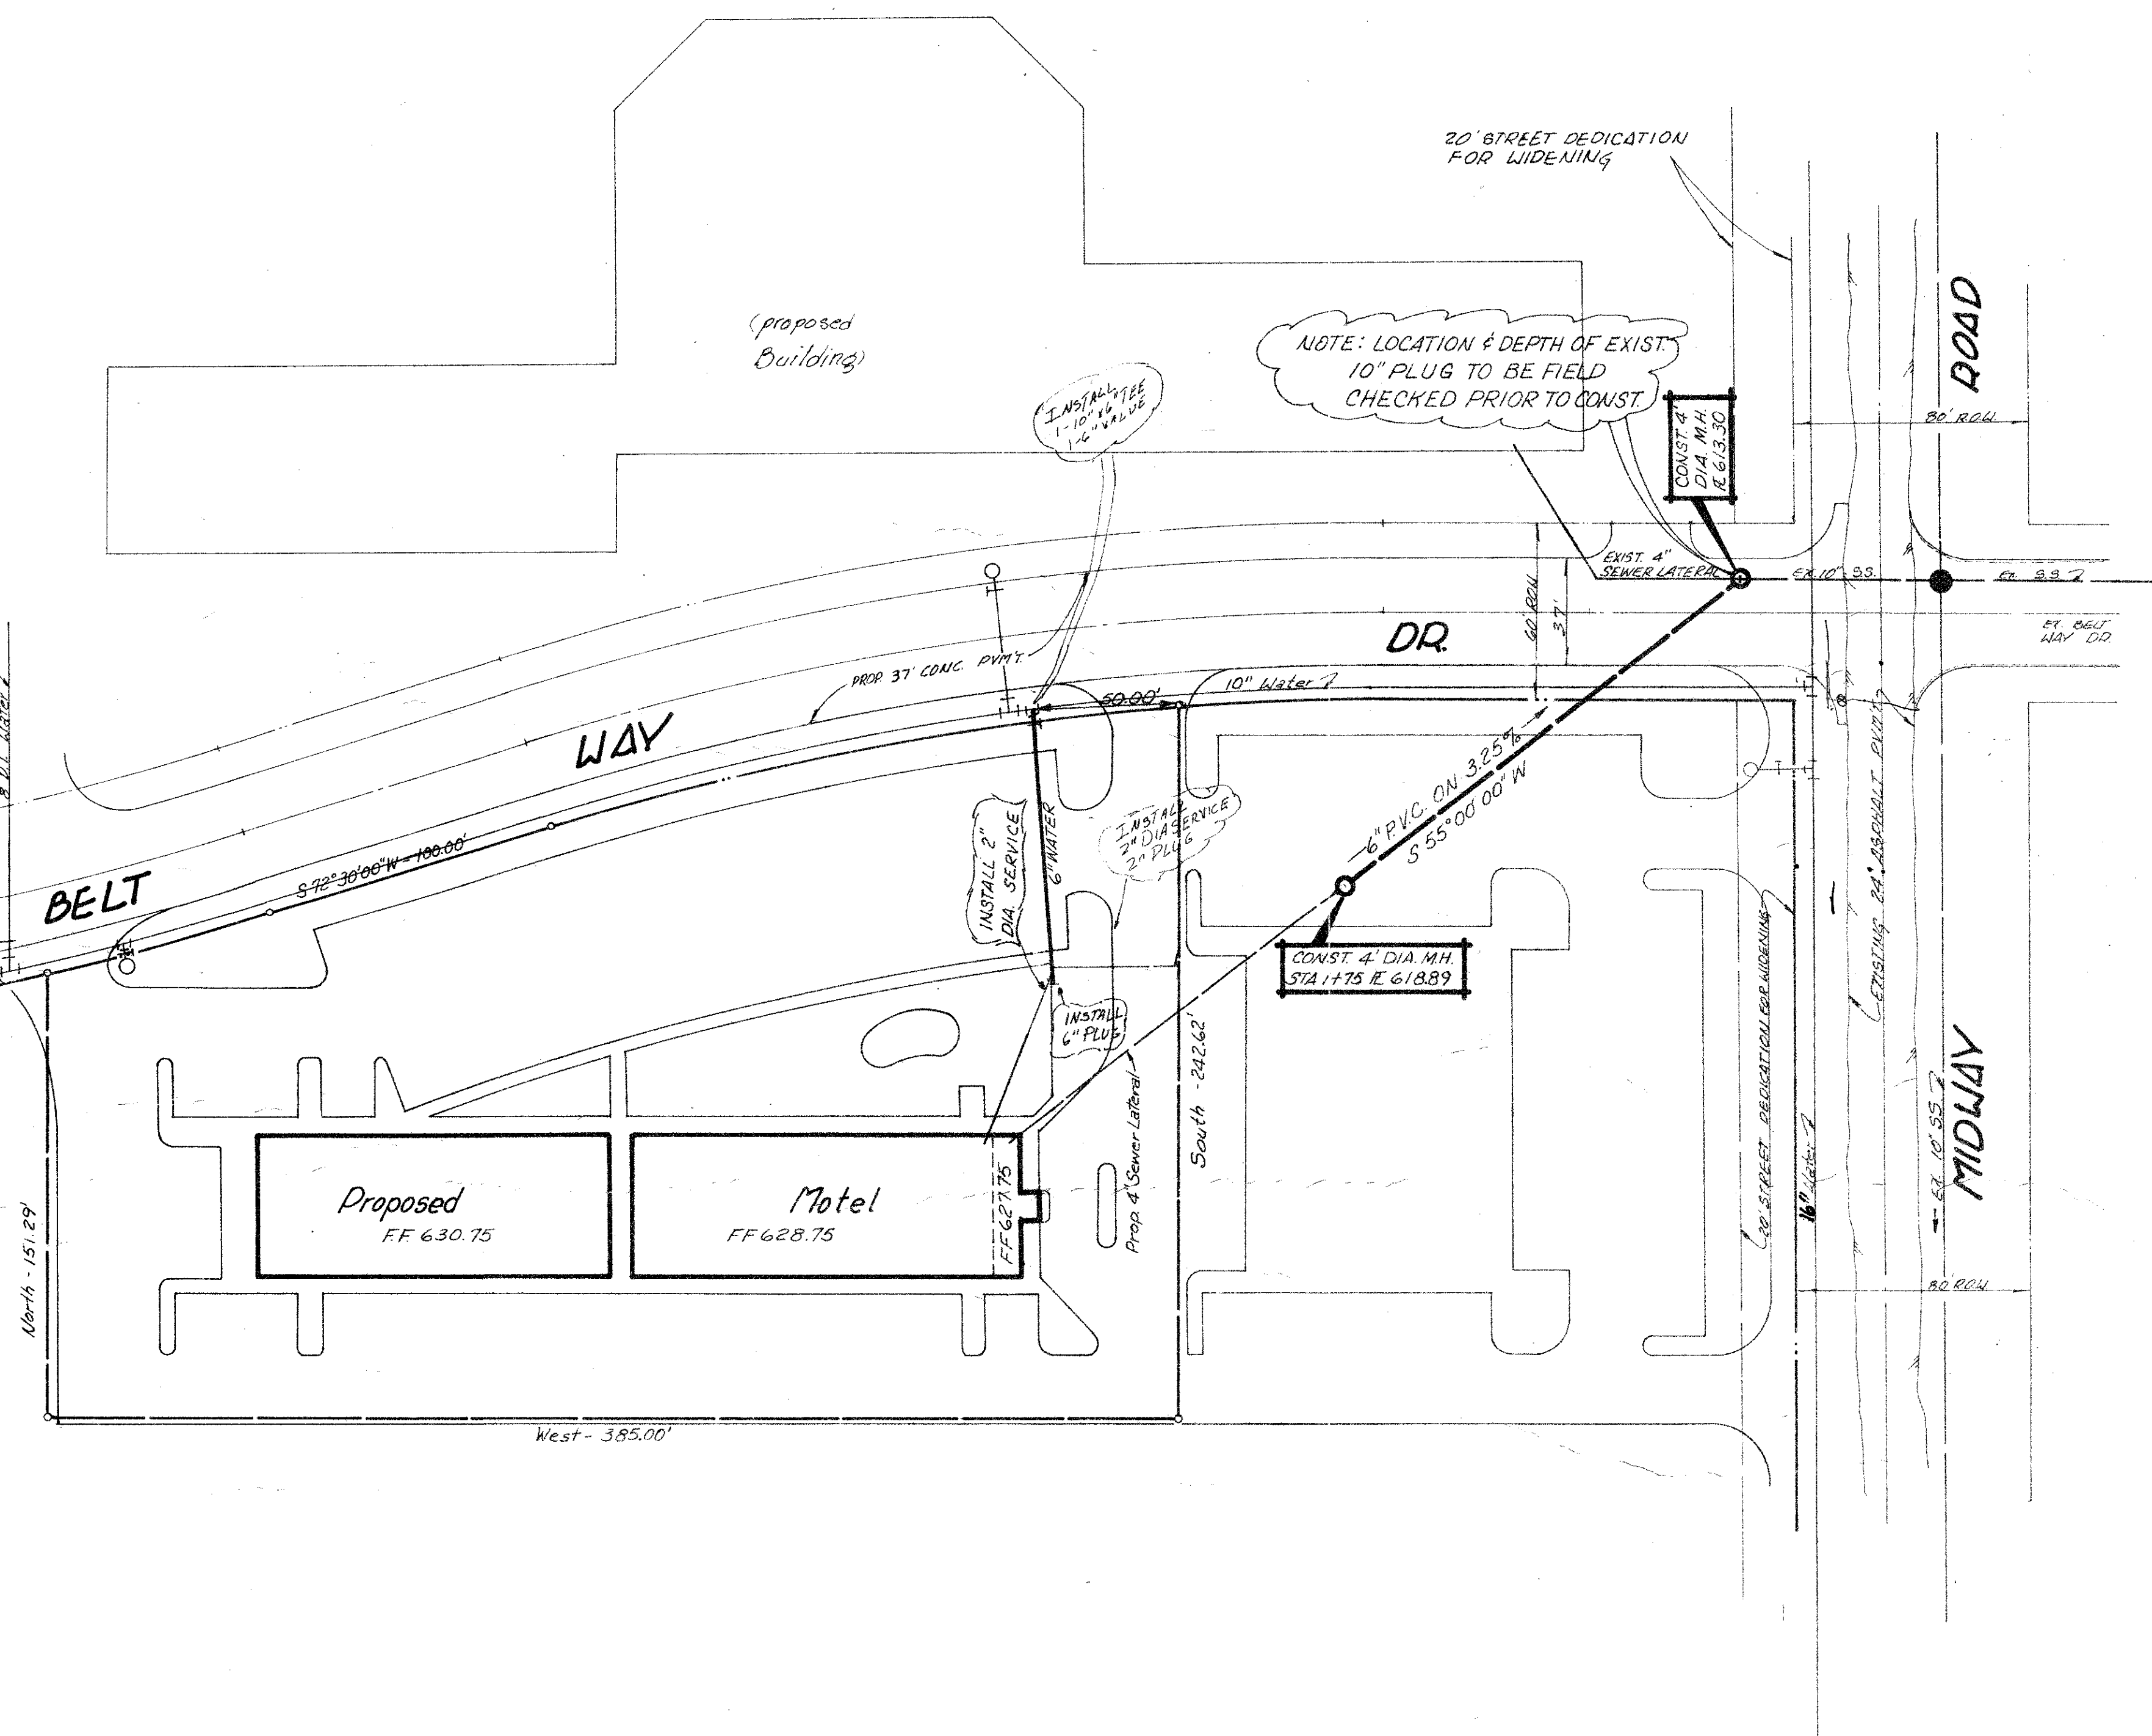


GENERAL NOTES

1. All 8" water mains to be SDR-18 PVC with #12 tracer wire.
2. All 8" water mains to have a minimum of 4' cover below street grade or as noted, clear other utilities.
3. Fire hydrant and valve grade adjustments (after paving) shall be the responsibility of the utility contractor.
4. Water and sanitary sewer easements shall also include additional area of easement for construction and maintenance of the system. Additional easement area to be conveyed for installation and maintenance of manholes, laterals, fire hydrants, laterals, meters, and other appurtenances necessary for proper operation of the sanitary sewer pipe joints shall conform to current A.S.T.M. designation SDR-35 PVC.
5. Unless otherwise noted, all material and construction shall conform to the specifications of the City of Addison, Texas. In the event an item is not covered by the City of Addison specifications, the City Engineer's decision shall prevail.
6. The location of all existing utilities to be verified by contractor prior to construction.
7. Contractor to notify utility companies at least 48 hours (2 working days) prior to construction.
8. All fire hydrants shall be Mueller Centurion model.
9. Tapping sleeves to be Mueller or Clow.

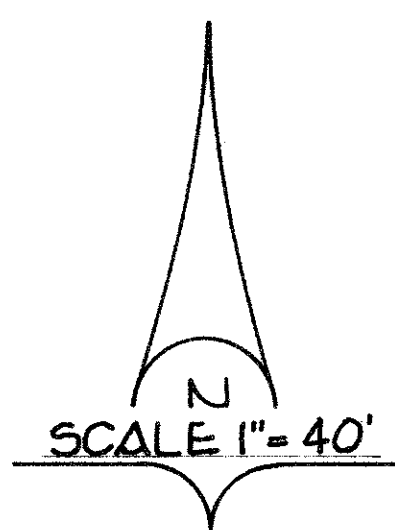

B.M. "D" CUT ON PAD OF TRAFFIC SIGNAL CONTROLLER AT N.E. COR. OF INTERSECTION OF BELTLINE & MIDWAY. ELEV. 60.75

40
4.25

SPAIN-AYRES ASSOCIATES, INC. CONSULTING ENGINEERS 2342 FABENS RD. - DALLAS, TEXAS 814 243-7881		WATER MAINS FOR GENERAL CITY OF ADDISON	
		DESIGN	DR. (U)
		5/20/81	