


# TOWN OF ADDISON, TEXAS

CONSTRUCTION PLANS FOR

## BELTWOOD PARKWAY WATER LINE REPLACEMENT AND

## INWOOD ROAD

## SANITARY SEWER REPLACEMENT

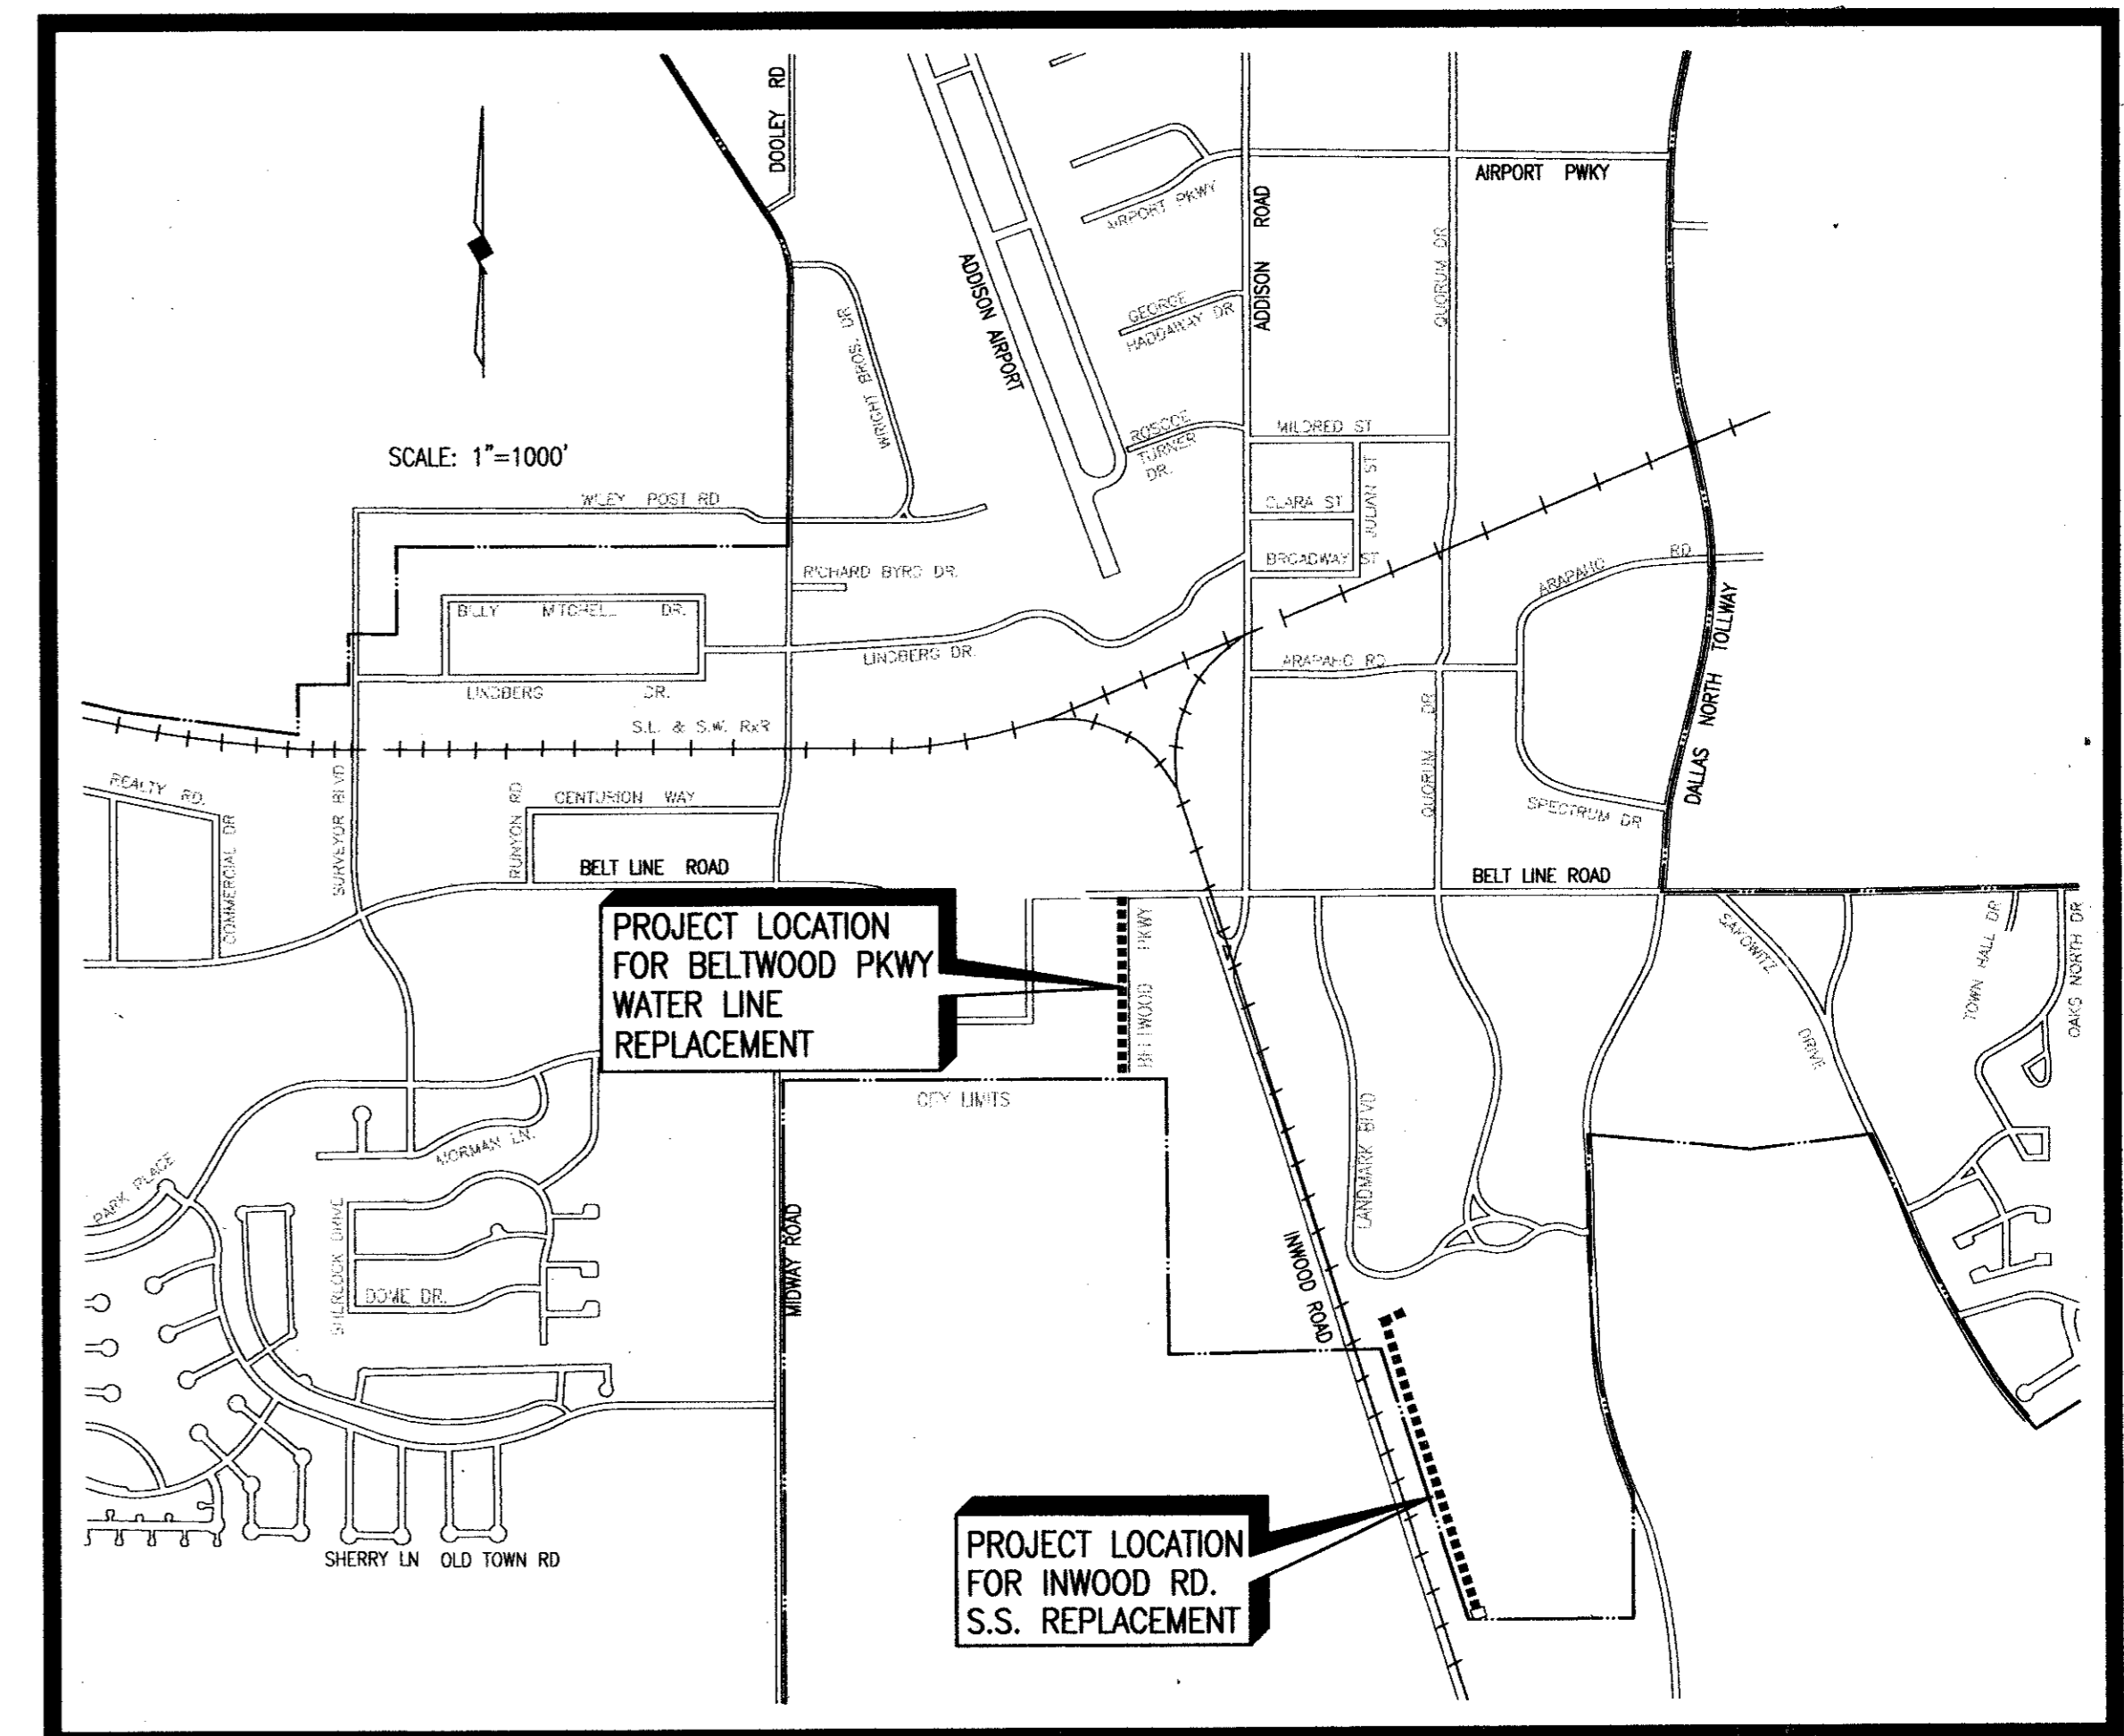

B13-10  
Beltwood Water Line  
Inwood Sewer Line  
Replacement - As Built

### SHEET INDEX

#### SHEET DESCRIPTION

#### SHEET NO.

|   |                           |
|---|---------------------------|
| BELTWOOD PKWY WATER LINE REPLACEMENT-PLAN/PROFILE 0+00 TO 6+00        | 1                         |
| BELTWOOD PKWY WATER LINE REPLACEMENT-PLAN/PROFILE 6+00 TO 10+46       | 2                         |
| BELTWOOD PKWY WATER LINE REPLACEMENT-PLANTING                         | 3                         |
| BELTWOOD PKWY WATER LINE REPLACEMENT-IRRIGATION                       | 4                         |
| BELTWOOD PKWY WATER LINE REPLACEMENT-WATER VALVE REPLACEMENT LOCATION | 5 <i>March Ln.</i>        |
| BELTWOOD PKWY WATER LINE REPLACEMENT-WATER VALVE REPLACEMENT LOCATION | 6 <i>Greenhill School</i> |
| BELTWOOD PKWY WATER LINE REPLACEMENT-WATER VALVE INSTALLATION         | 7 <i>Inwood</i>           |
| INWOOD RD. S.S. REPLACEMENT-PLAN/PROFILE 0+00 TO 6+00                 | 8                         |
| INWOOD RD. S.S. REPLACEMENT-PLAN/PROFILE 6+00 TO 12+00                | 9                         |
| INWOOD RD. S.S. REPLACEMENT-PLAN/PROFILE 12+00 TO 18+31.62            | 10                        |
| DETAIL SHEET  | 11                        |
| DETAIL & GENERAL NOTES SHEET  | 12                        |

#### CITY COUNCIL

RICHARD N. BECKERT, MAYOR  
ANN B. SUDDUTH, MAYOR PRO TEM  
GREGORY ROACH      ROBERT L. DOEPFNER  
RIK CREWS          MARY J. DOLAN  
SUSAN M. HALPERN

#### CITY MANAGER

RON WHITEHEAD

#### DIRECTOR OF PUBLIC WORKS

JOHN BAUMGARTNER, P.E.

#### PUBLIC WORKS ENGINEER


DAVID C. NIGHSWONGER, P.E.

#### CITY SECRETARY

CARMEN MORAN

SHIMEK, JACOBS & FINKLEA, L.L.P.  
CONSULTING ENGINEERS  
Dallas, Texas

REVISED TO CONFORM  
TO CONSTRUCTION RECORDS  
BY *JWB* DATE *8/26/97*

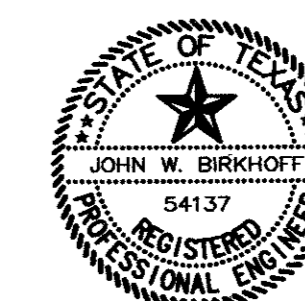

THESE DOCUMENTS ARE FOR  
BIDDING, CONSTRUCTION,  
AND PERMIT PURPOSES.  
*John W. Bulliff*  
DATE: *11/20/96*

NOVEMBER, 1996

B13-10