


TOWN OF ADDISON, TEXAS

CONSTRUCTION PLANS FOR

BELTWOOD PARKWAY WATER LINE REPLACEMENT AND INWOOD ROAD SANITARY SEWER REPLACEMENT

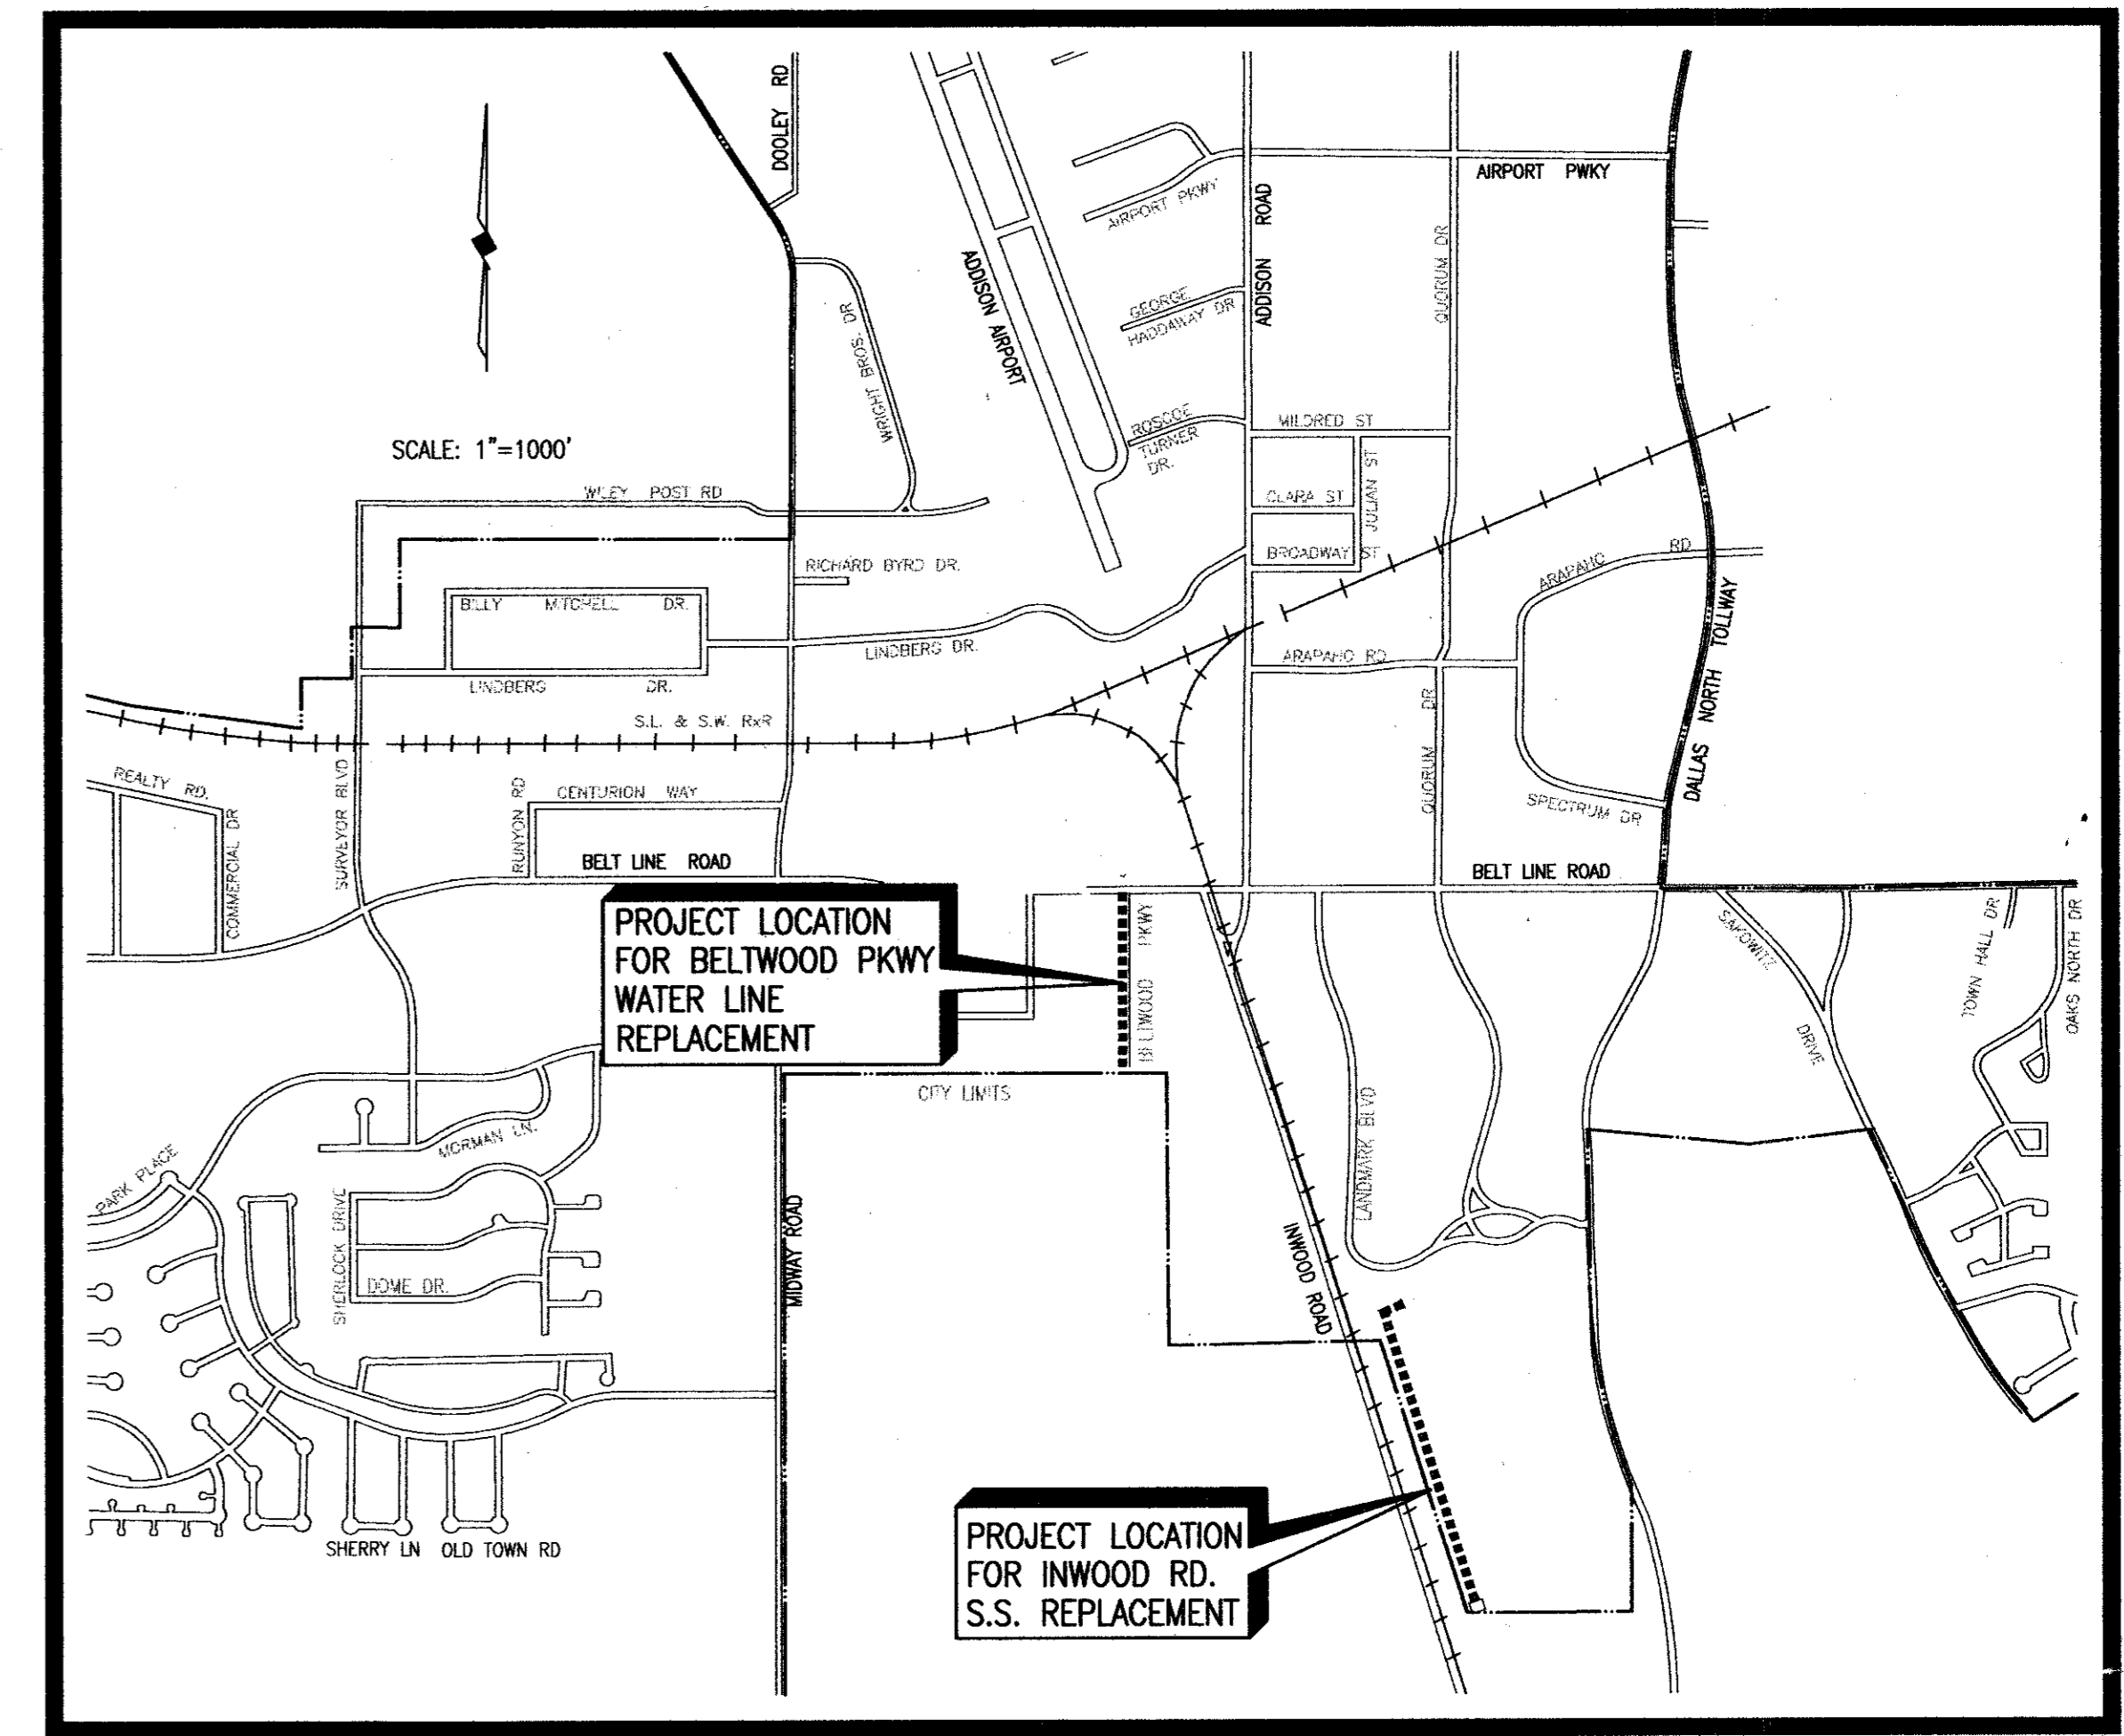

SHEET INDEX

SHEET DESCRIPTION	SHEET NO.
BELTWOOD PKWY WATER LINE REPLACEMENT-PLAN/PROFILE 0+00 TO 6+00	1
BELTWOOD PKWY WATER LINE REPLACEMENT-PLAN/PROFILE 6+00 TO 10+46	2
BELTWOOD PKWY WATER LINE REPLACEMENT-PLANTING	3
BELTWOOD PKWY WATER LINE REPLACEMENT-IRRIGATION	4
BELTWOOD PKWY WATER LINE REPLACEMENT-WATER VALVE REPLACEMENT LOCATION	5
BELTWOOD PKWY WATER LINE REPLACEMENT-WATER VALVE REPLACEMENT LOCATION	6
BELTWOOD PKWY WATER LINE REPLACEMENT-WATER VALVE INSTALLATION	7
INWOOD RD. S.S. REPLACEMENT-PLAN/PROFILE 0+00 TO 6+00	8
INWOOD RD. S.S. REPLACEMENT-PLAN/PROFILE 6+00 TO 12+00	9
INWOOD RD. S.S. REPLACEMENT-PLAN/PROFILE 12+00 TO 18+31.62	10
DETAIL SHEET	11
DETAIL & GENERAL NOTES SHEET	12

CITY COUNCIL

RICHARD N. BECKERT, MAYOR
ANN B. SUDDUTH, MAYOR PRO TEM
GREGORY ROACH ROBERT L. DOEPFNER
RIK CREWS MARY J. DOLAN
SUSAN M. HALPERN

CITY MANAGER

RON WHITEHEAD

DIRECTOR OF PUBLIC WORKS

JOHN BAUMGARTNER, P.E.

PUBLIC WORKS ENGINEER


DAVID C. NIGHSWONGER, P.E.

CITY SECRETARY

CARMEN MORAN

SHIMEK, JACOBS & FINKLEA, L.L.P.
CONSULTING ENGINEERS
Dallas, Texas

REVISED TO CONFORM
TO CONSTRUCTION RECORDS
BY JWB DATE 8/26/97

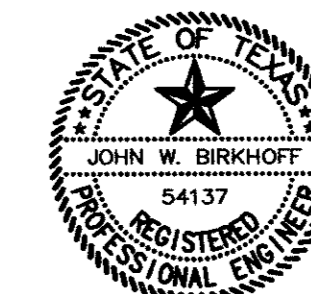

THESE DOCUMENTS ARE FOR
BIDDING, CONSTRUCTION,
AND PERMIT PURPOSES.
John W. Birkhoff
DATE: 11/20/96

NOVEMBER, 1996