


# TOWN OF ADDISON, TEXAS

CONSTRUCTION PLANS FOR

## BELTWOOD PARKWAY WATER LINE REPLACEMENT AND INWOOD ROAD SANITARY SEWER REPLACEMENT

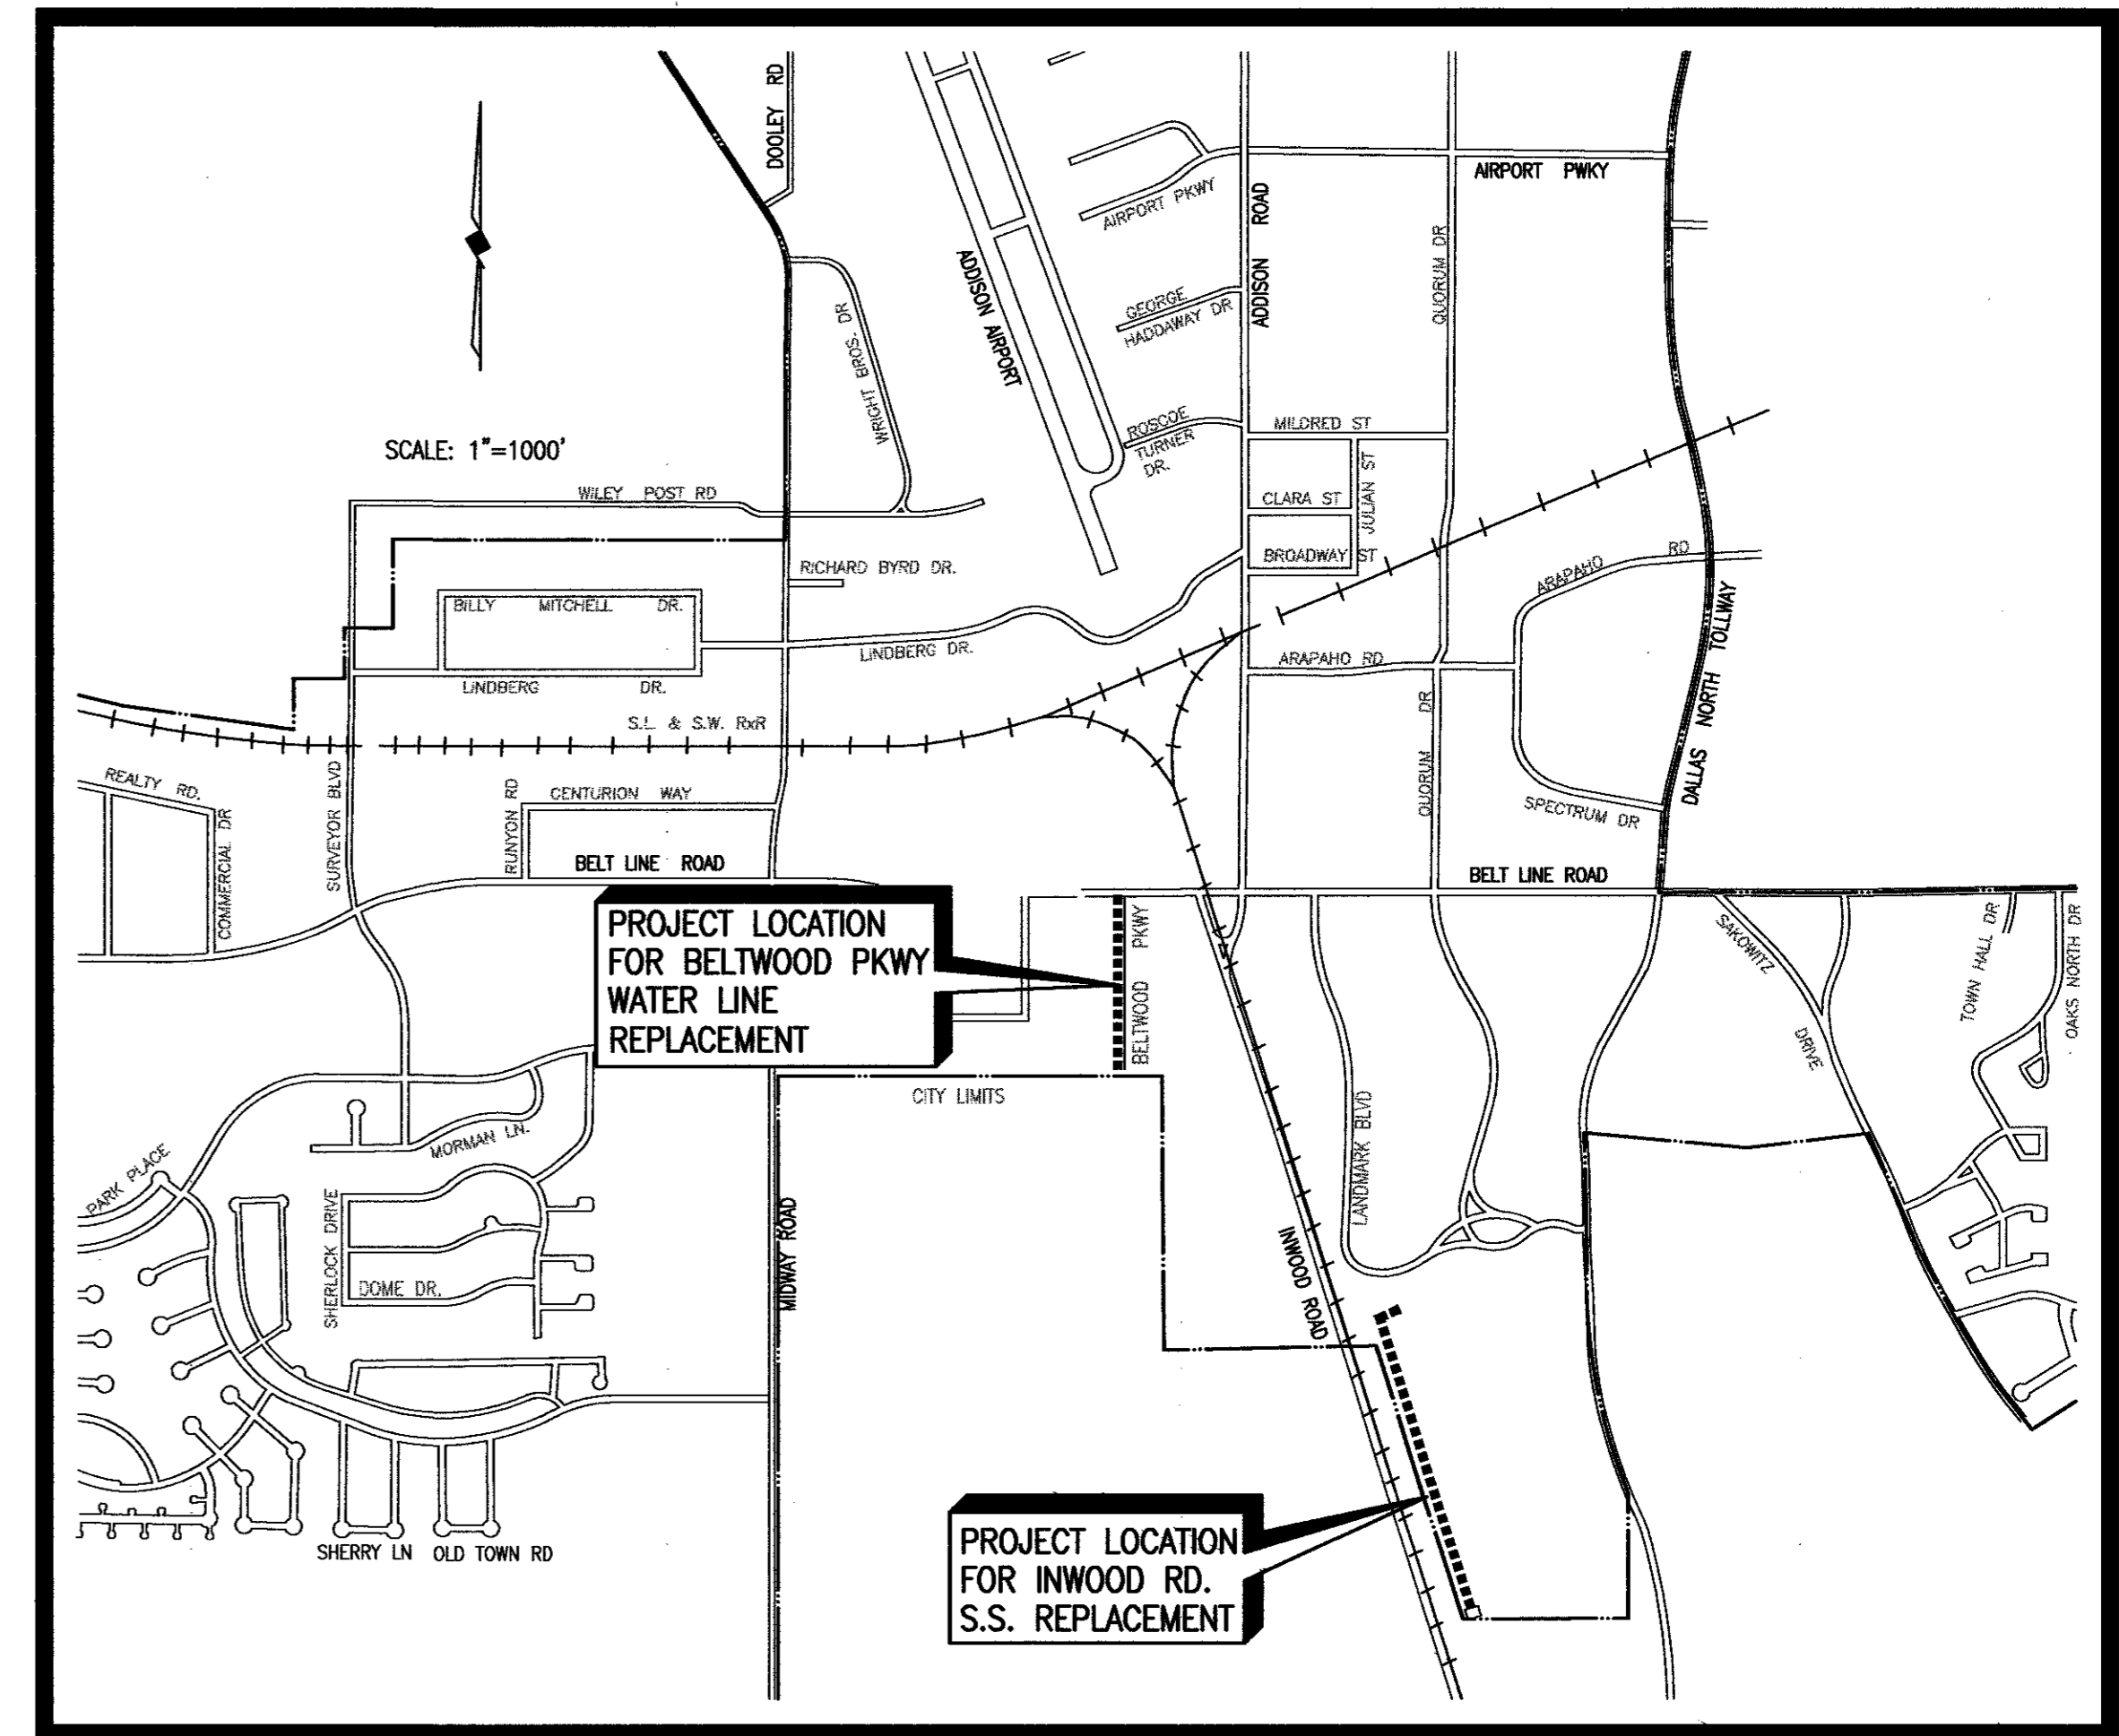

### SHEET INDEX

SHEET DESCRIPTION	SHEET NO.
BELTWOOD PKWY WATER LINE REPLACEMENT-PLAN/PROFILE 0+00 TO 6+00	1
BELTWOOD PKWY WATER LINE REPLACEMENT-PLAN/PROFILE 6+00 TO 10+46	2
BELTWOOD PKWY WATER LINE REPLACEMENT-PLANTING	3
BELTWOOD PKWY WATER LINE REPLACEMENT-IRRIGATION	4
BELTWOOD PKWY WATER LINE REPLACEMENT-WATER VALVE REPLACEMENT LOCATION	5
BELTWOOD PKWY WATER LINE REPLACEMENT-WATER VALVE REPLACEMENT LOCATION	6
BELTWOOD PKWY WATER LINE REPLACEMENT-WATER VALVE INSTALLATION	7
INWOOD RD. S.S. REPLACEMENT-PLAN/PROFILE 0+00 TO 6+00	8
INWOOD RD. S.S. REPLACEMENT-PLAN/PROFILE 6+00 TO 12+00	9
INWOOD RD. S.S. REPLACEMENT-PLAN/PROFILE 12+00 TO 18+31.62	10
DETAIL SHEET	11
DETAIL & GENERAL NOTES SHEET	12

**CITY COUNCIL**

- RICHARD N. BECKERT, MAYOR
- ANN B. SUDDUTH, MAYOR PRO TEM
- GREGORY ROACH      ROBERT L. DOEPFNER
- RIK CREWS            MARY J. DOLAN
- SUSAN M. HALPERN

**CITY MANAGER**

RON WHITEHEAD

**DIRECTOR OF PUBLIC WORKS**

JOHN BAUMGARTNER, P.E.

**PUBLIC WORKS ENGINEER**


DAVID C. NIGHSWONGER, P.E.

**CITY SECRETARY**

CARMEN MORAN

**SHIMEK, JACOBS & FINKLEA, L.L.P.**  
CONSULTING ENGINEERS  
Dallas, Texas

REVISED TO CONFORM  
TO CONSTRUCTION RECORDS  
BY JWB DATE 8/26/97

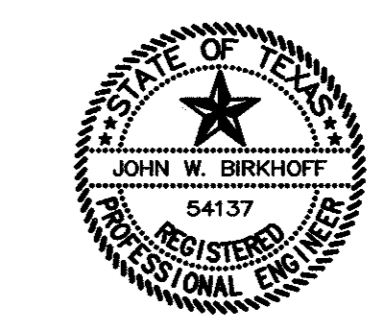

THESE DOCUMENTS ARE FOR  
BIDDING, CONSTRUCTION,  
AND PERMIT PURPOSES.  
*John W. Birkhoff*  
DATE: 11/15/96

NOVEMBER, 1996