



Block A
BELTWOOD NORTH AIRPORT ADDN.

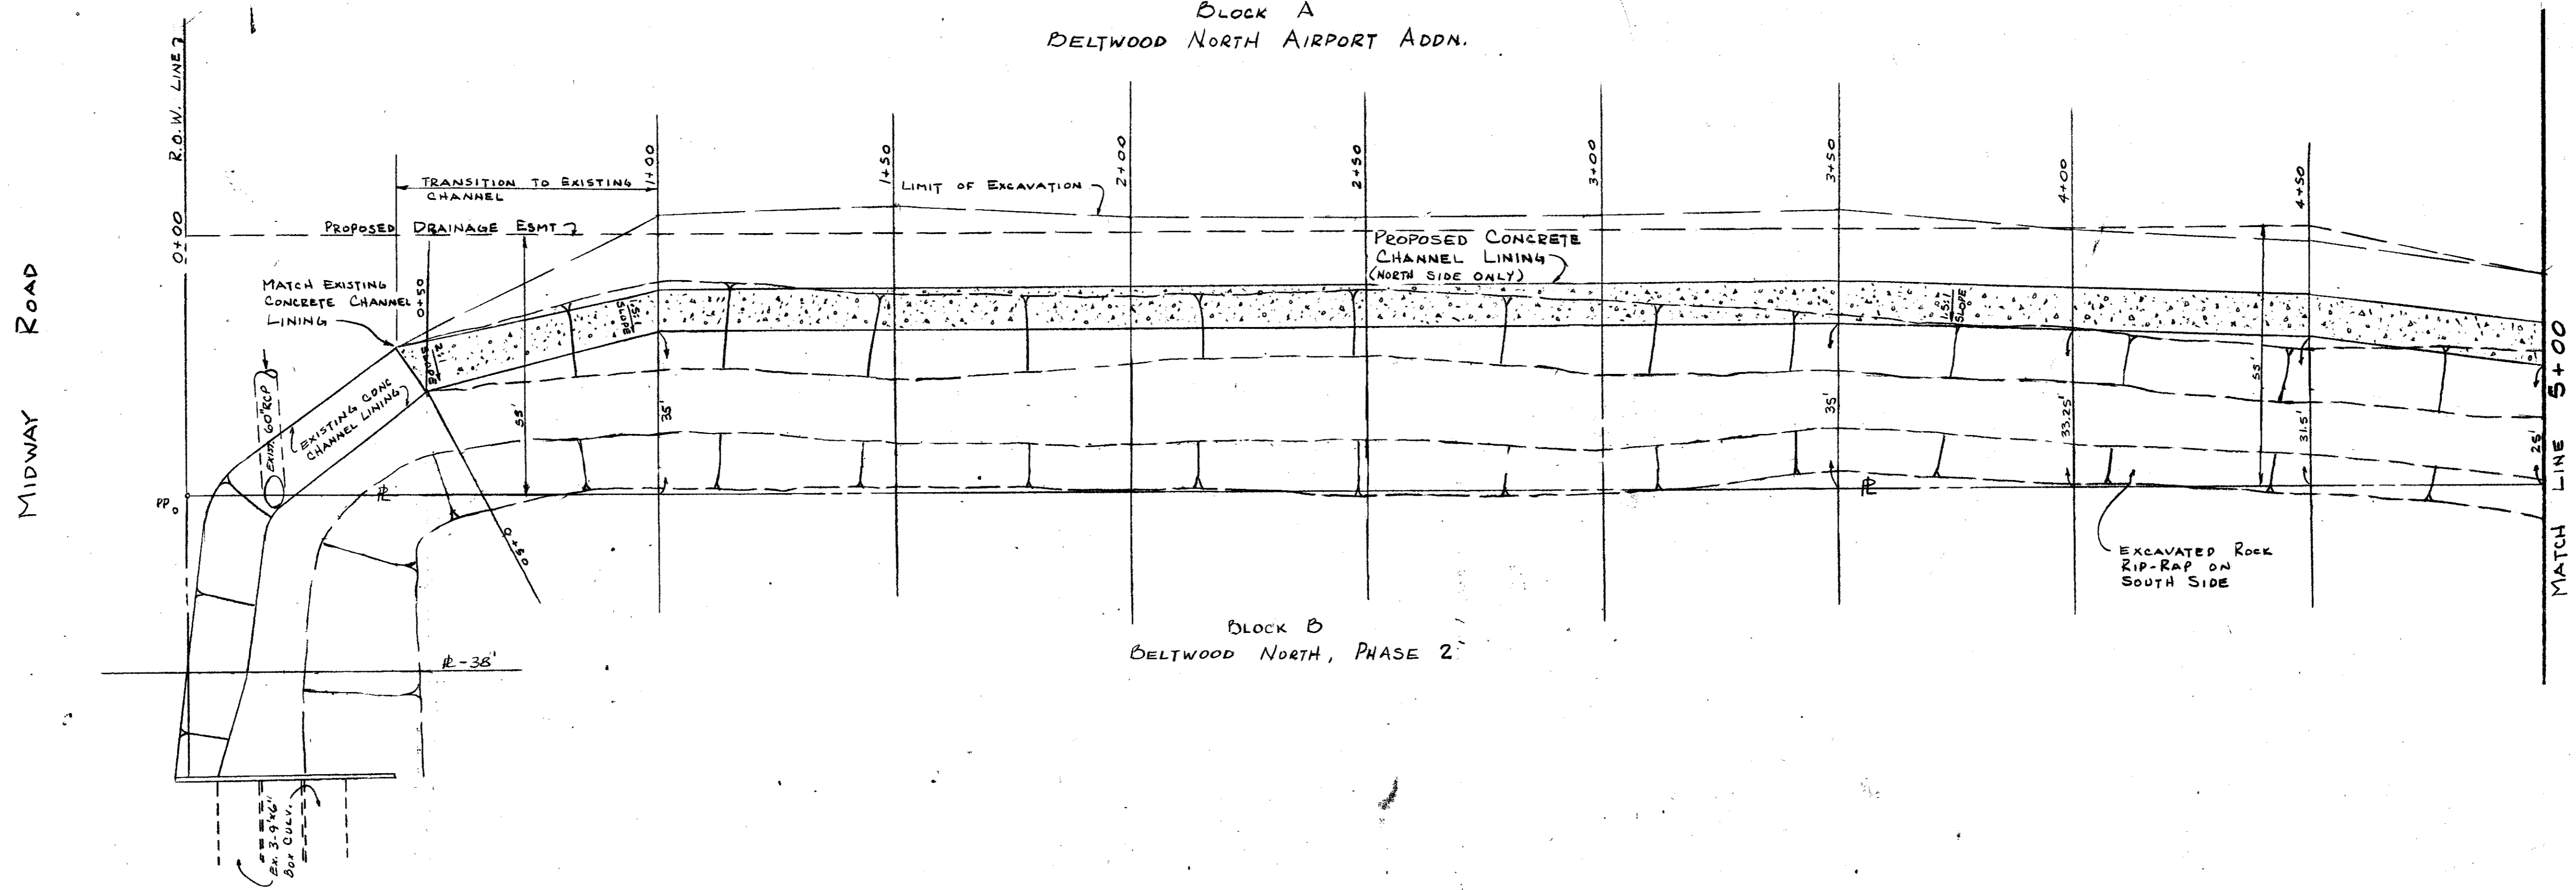

Block B
BELTWOOD NORTH, PHASE 2

BM: OPERATING NUT OF FIRE HYDRANT
AT SW CORNER OF SITE.
ELEV. = 609.16

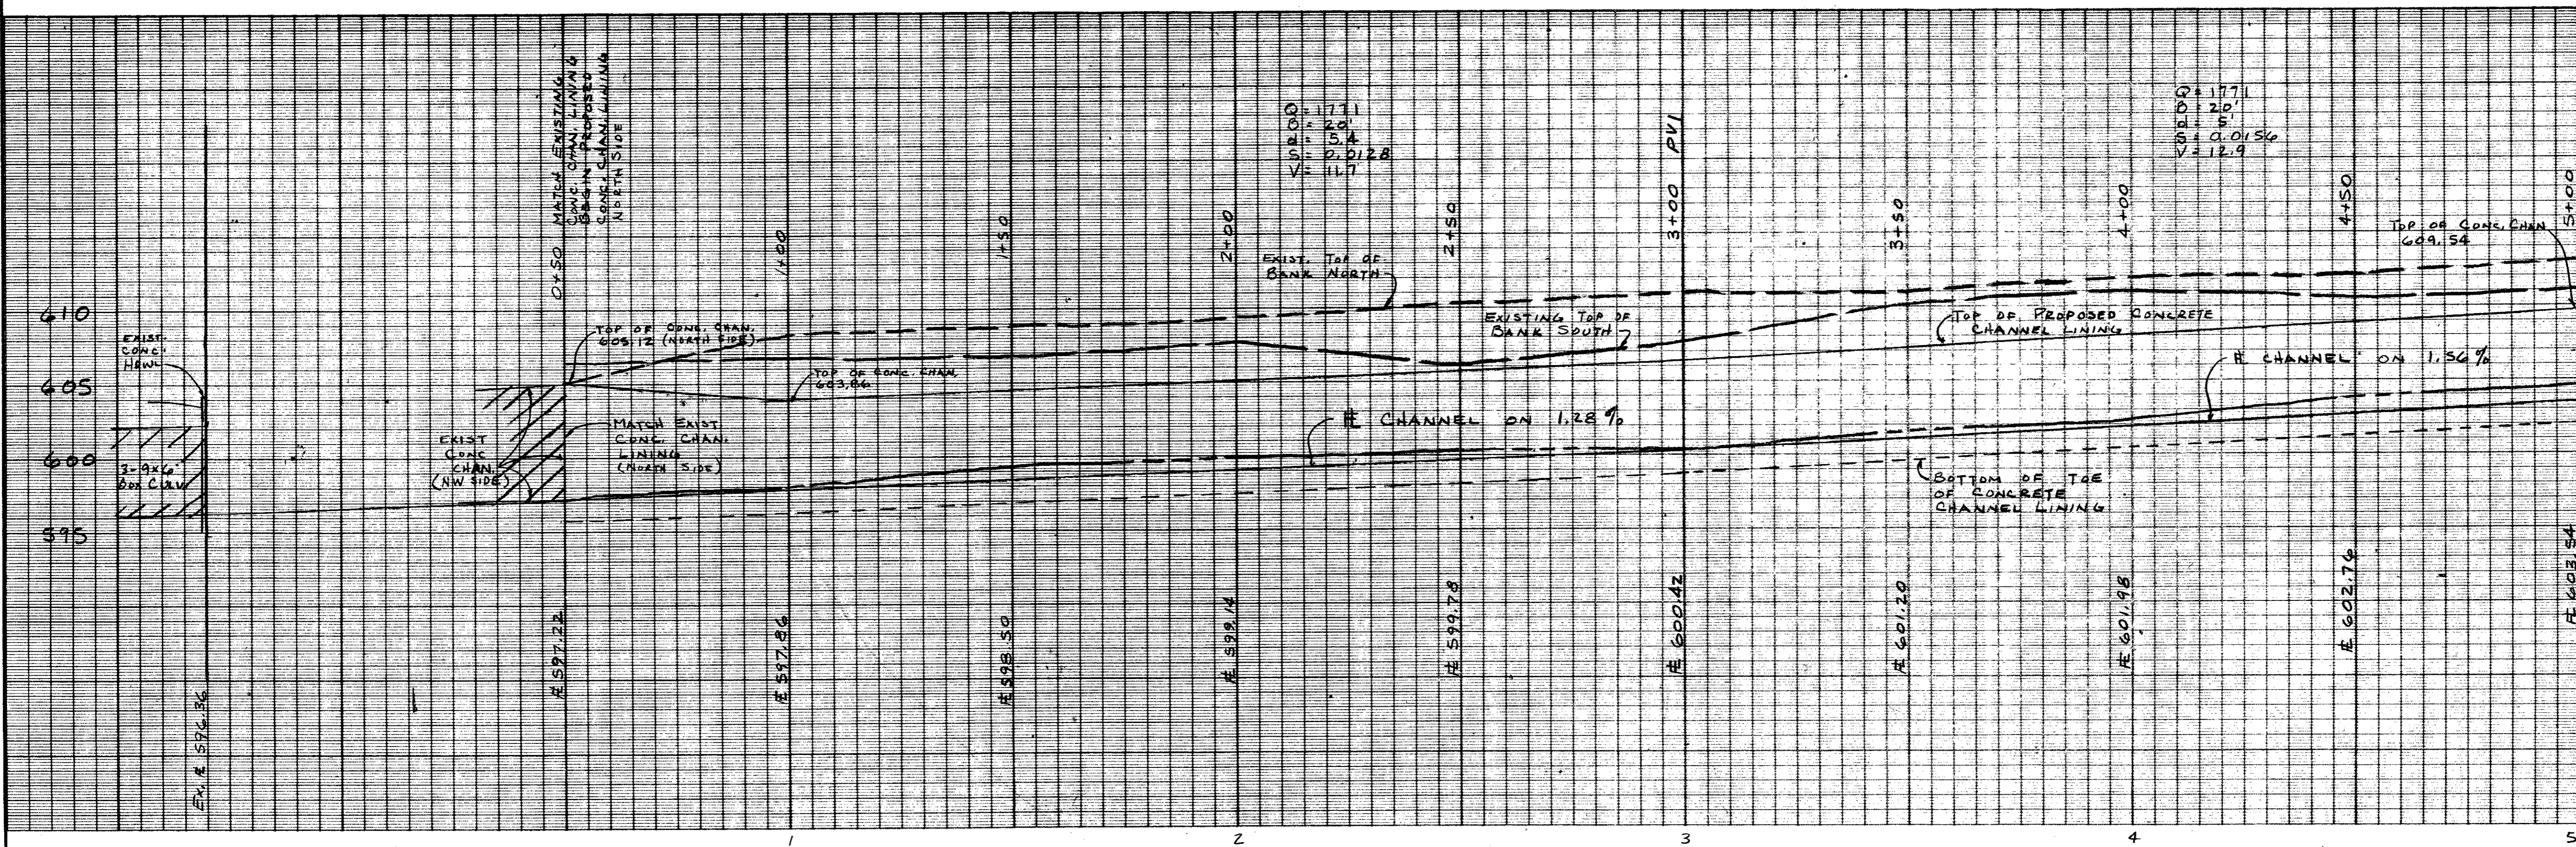

"As BUILT"
2-11-94
Plan & Profile
10.20.93

CREEK IMPROVEMENTS					
BELTWOOD NORTH AIRPORT ADDN.					
MIDWAY ROAD					
TOWN OF ADDISON, TEXAS					
DESIGN	DRAWN	DATE	SCALE	NOTES	FILE NO.
PEARCE & ASSO., INC.		Nov '93	1" = 20' H 1/2" = 6' V		04.93-003 2 OF 6