

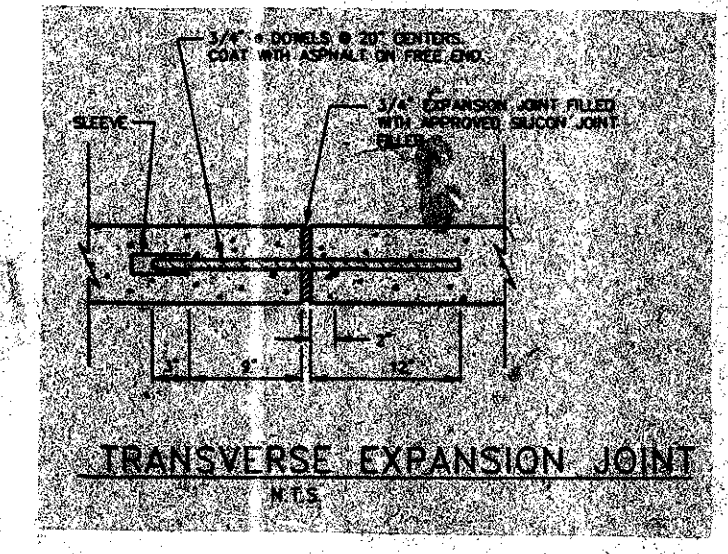
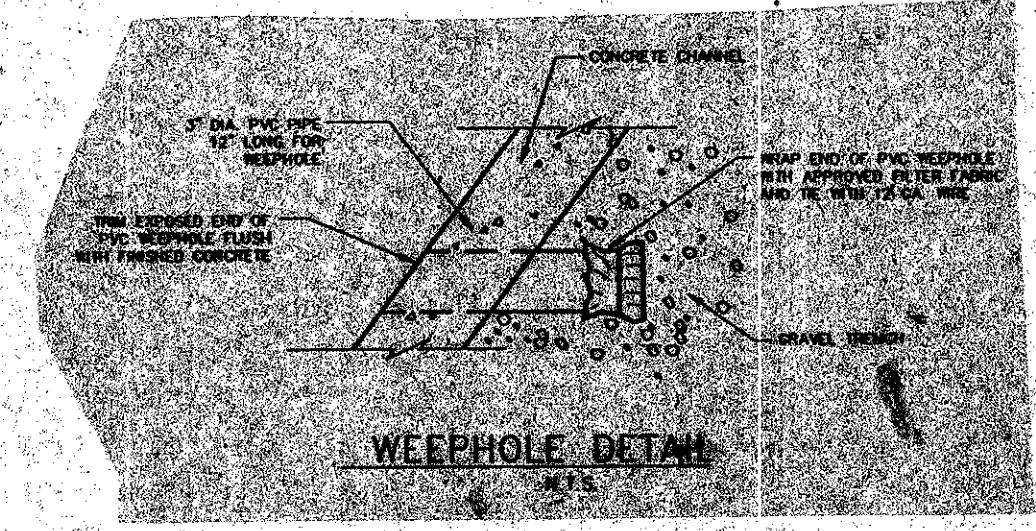
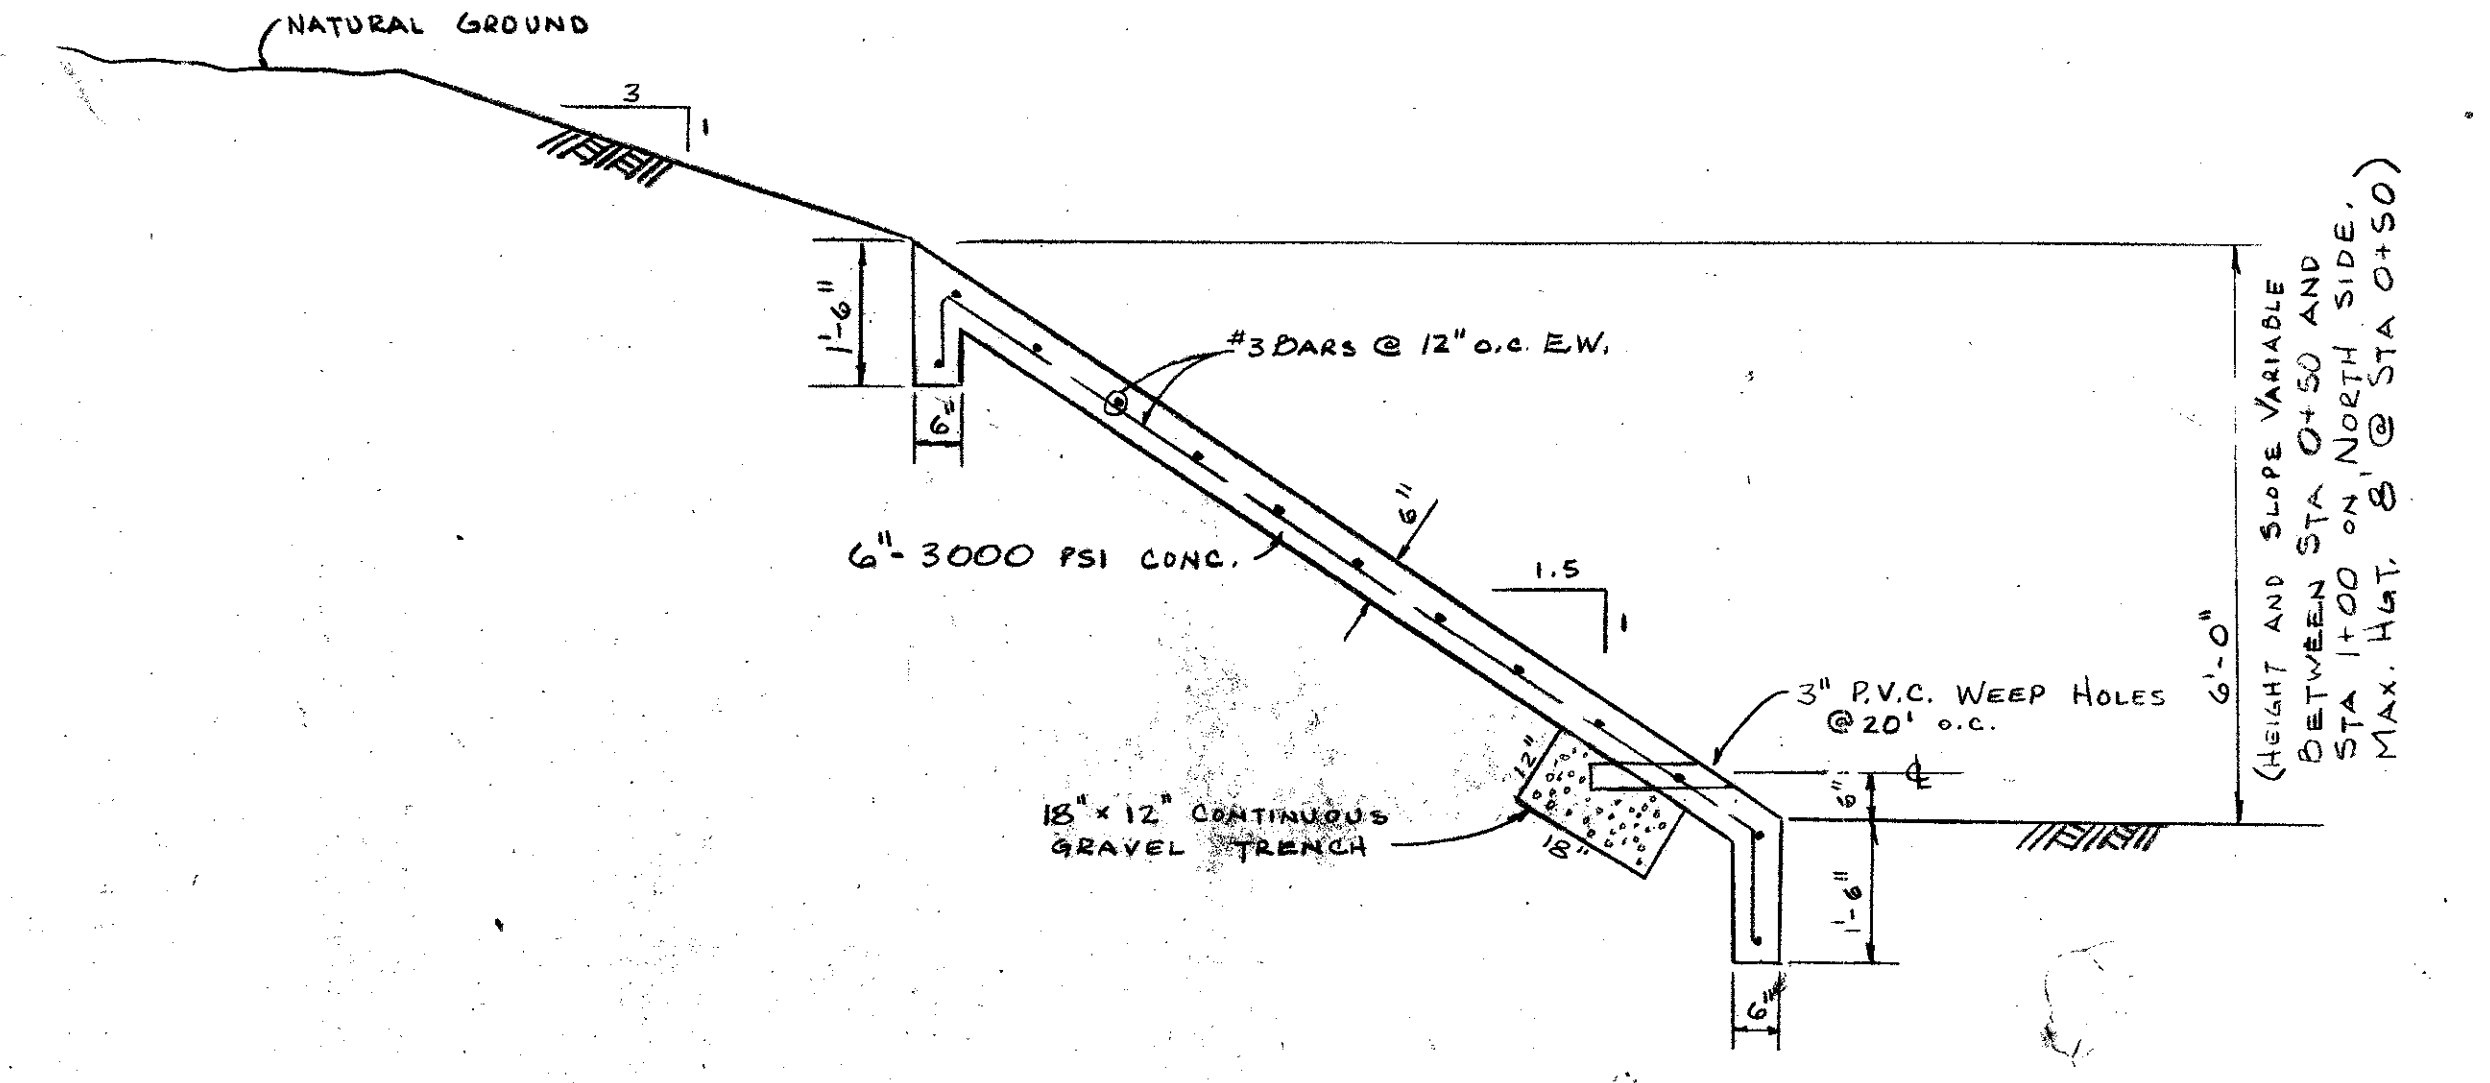
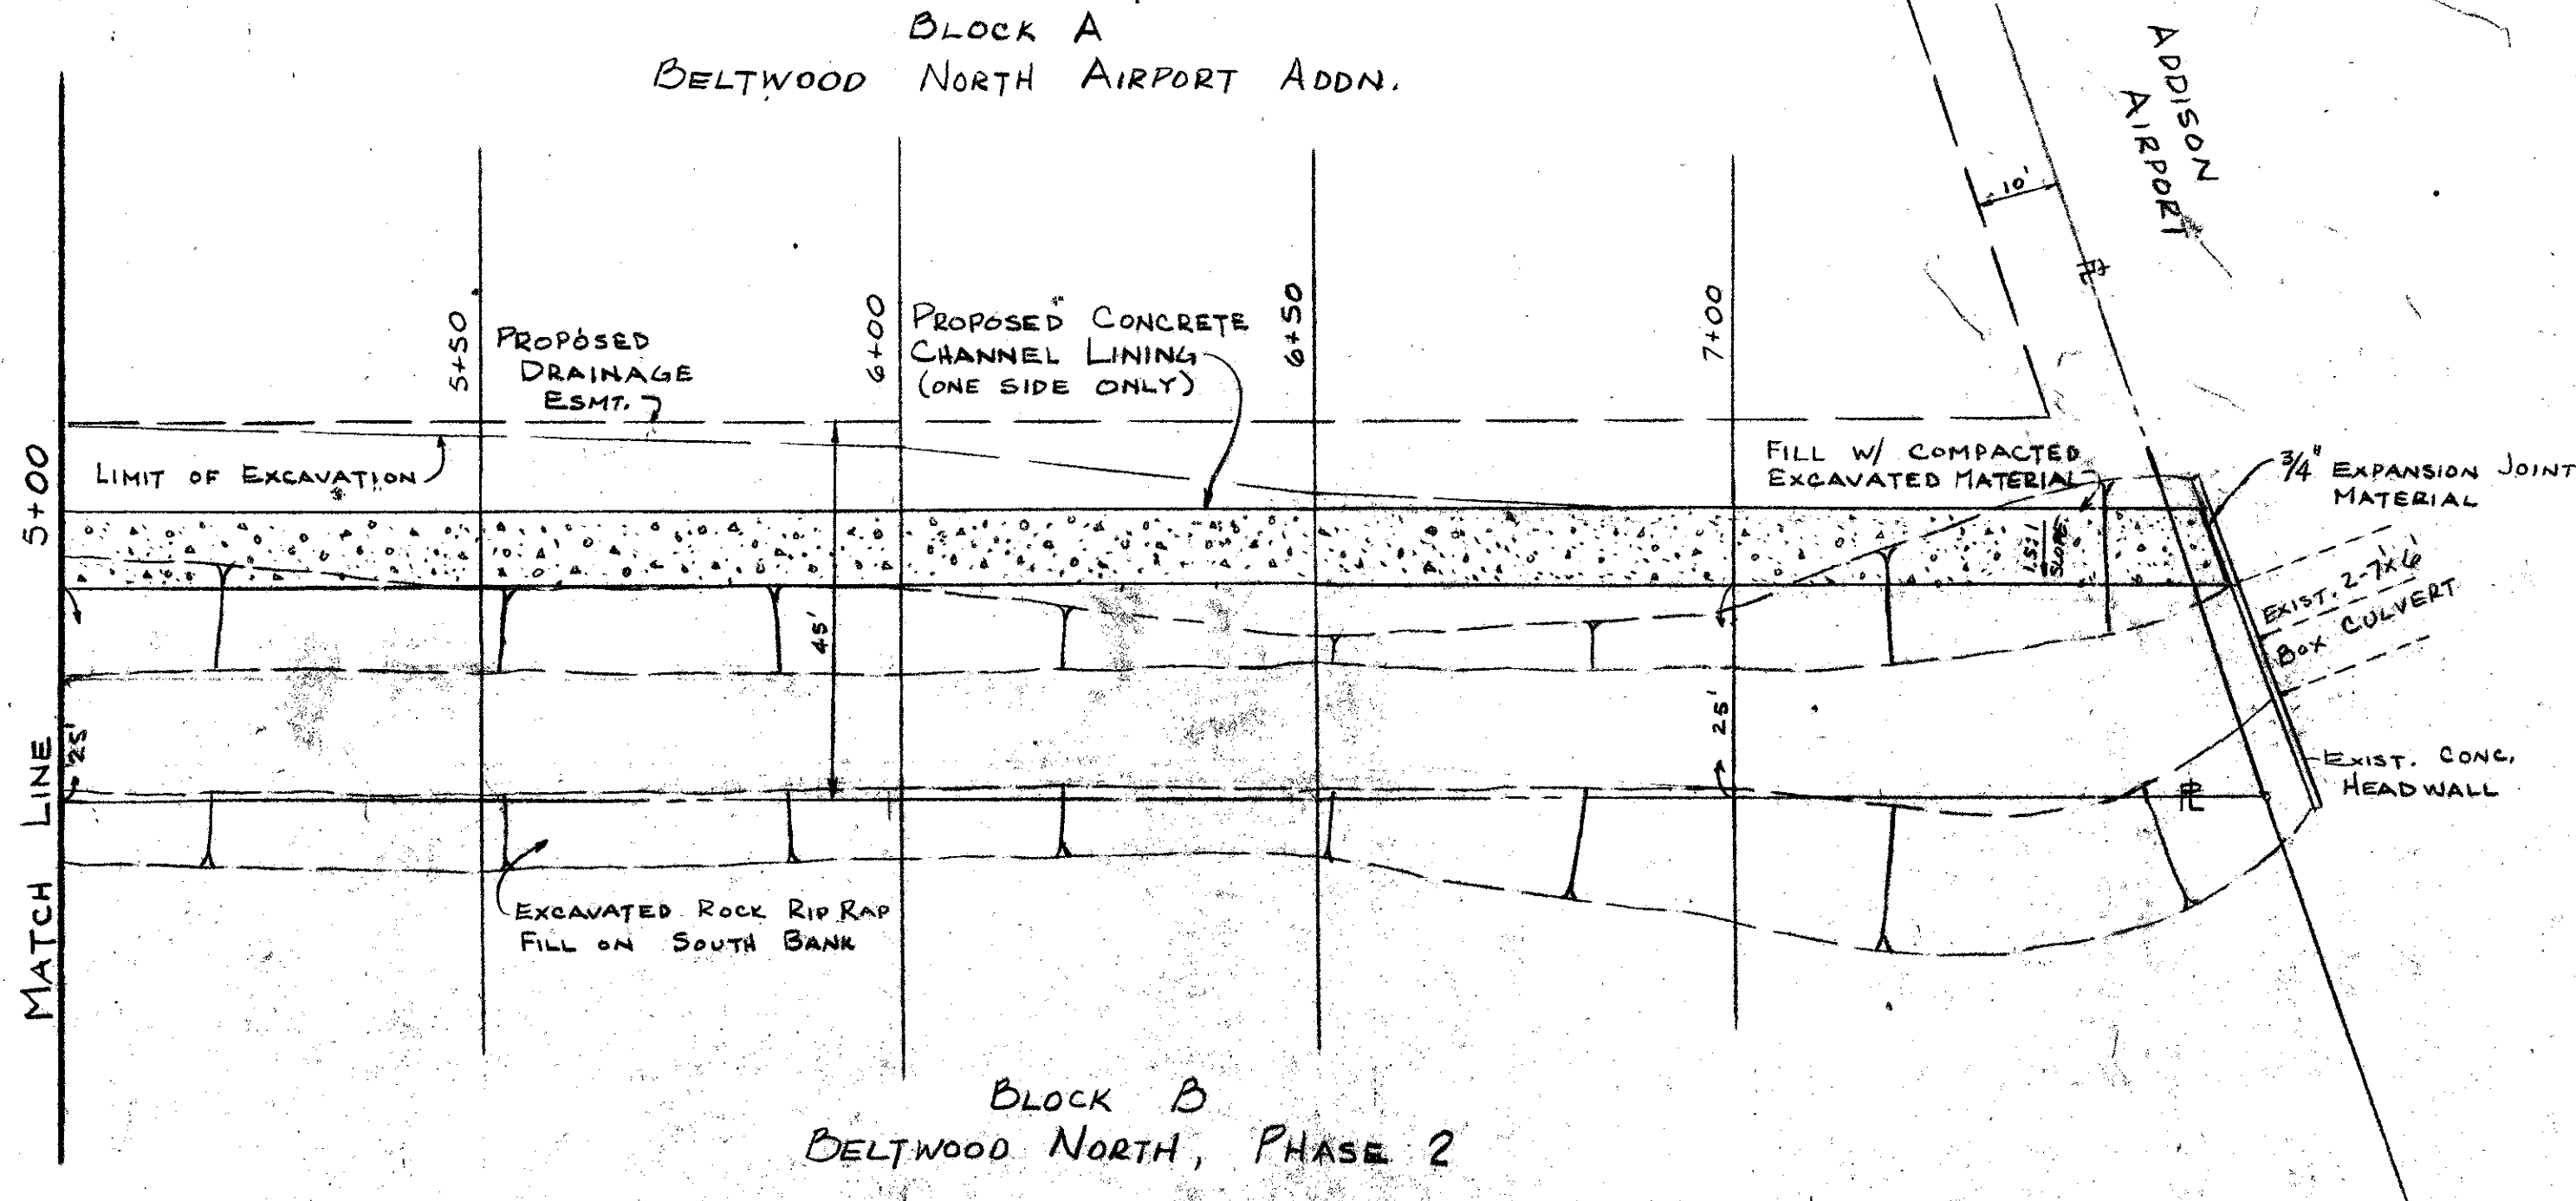


SCALE 1" = 20'

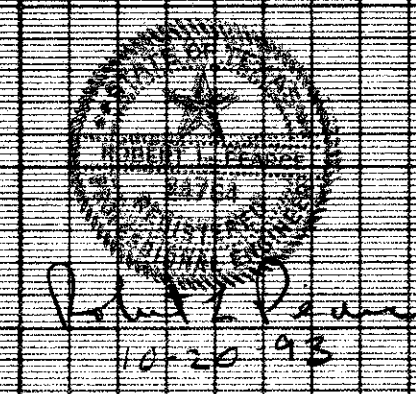

BM: OPERATING NUT. OF FIRE HYDRANT AT SW CORNER OF SITE  
ELEV. = 609.16

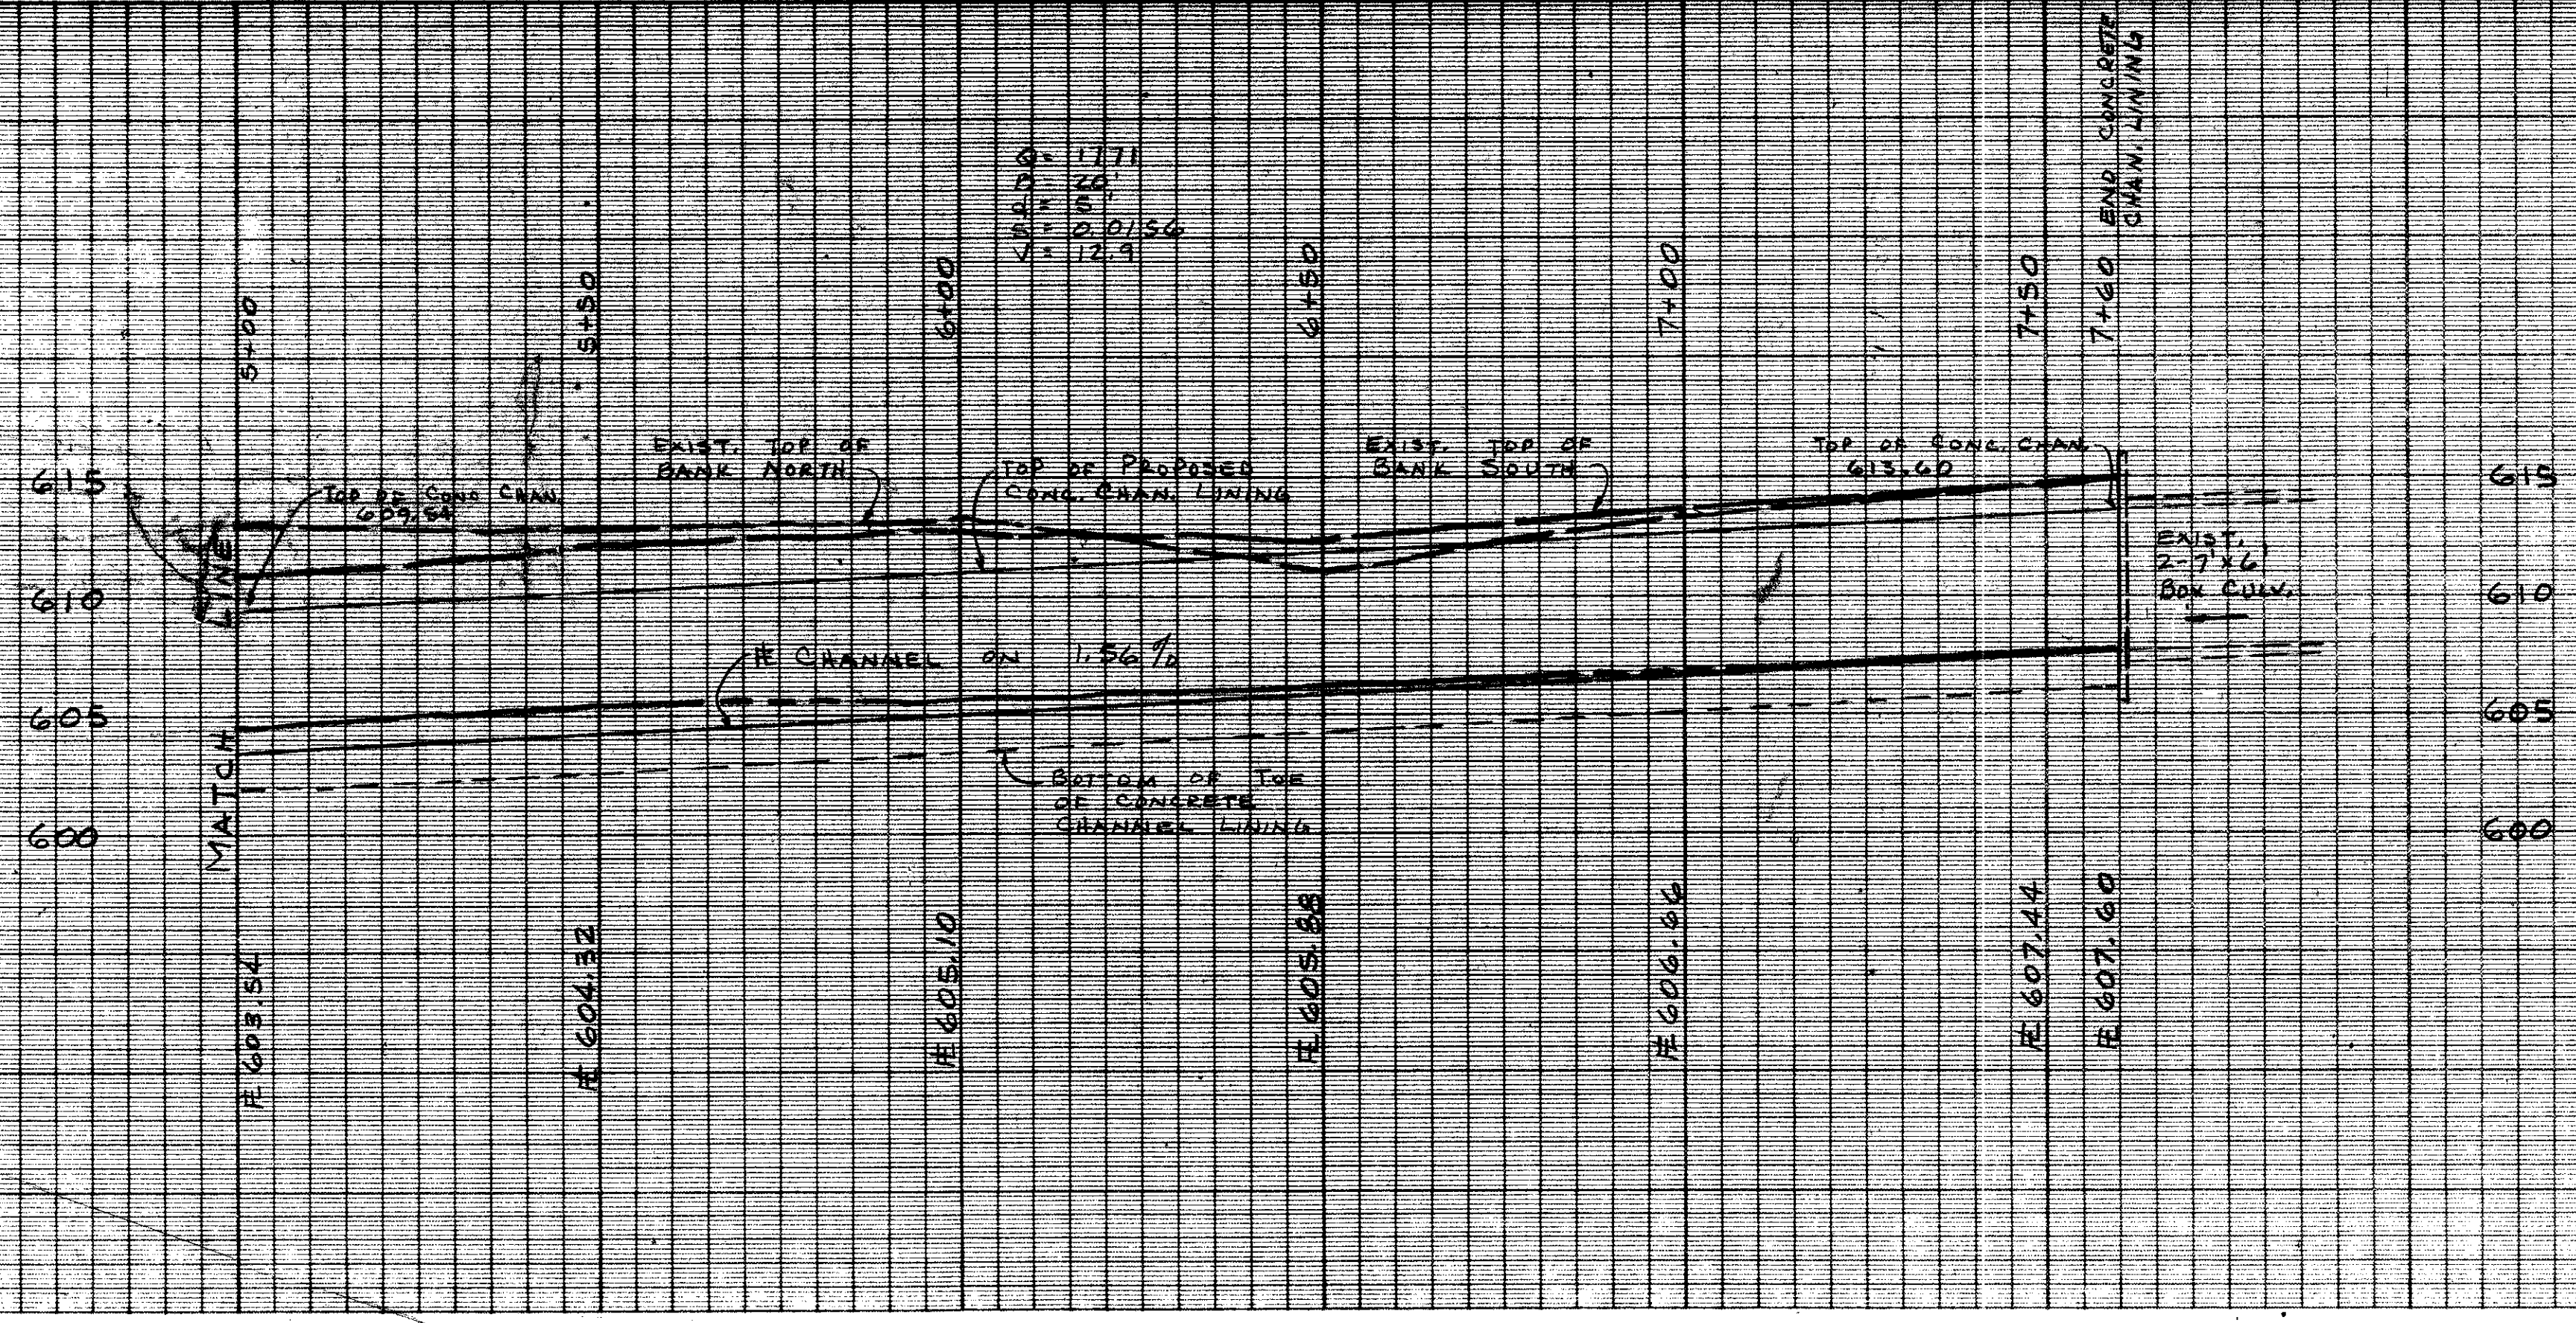

"As Built"  
2-14-94

CREEK IMPROVEMENTS						
BELTWOOD NORTH AIRPORT ADDN.						
MIDWAY ROAD						
TOWN OF ADDISON, TEXAS						
DESIGN	DRAWN	DATE	SCALE	NOTES	FILE	NO.
PA	PA	Nov '93	1" = 20' H 1" = 61 V		ON. 93-003	3 OF 6