

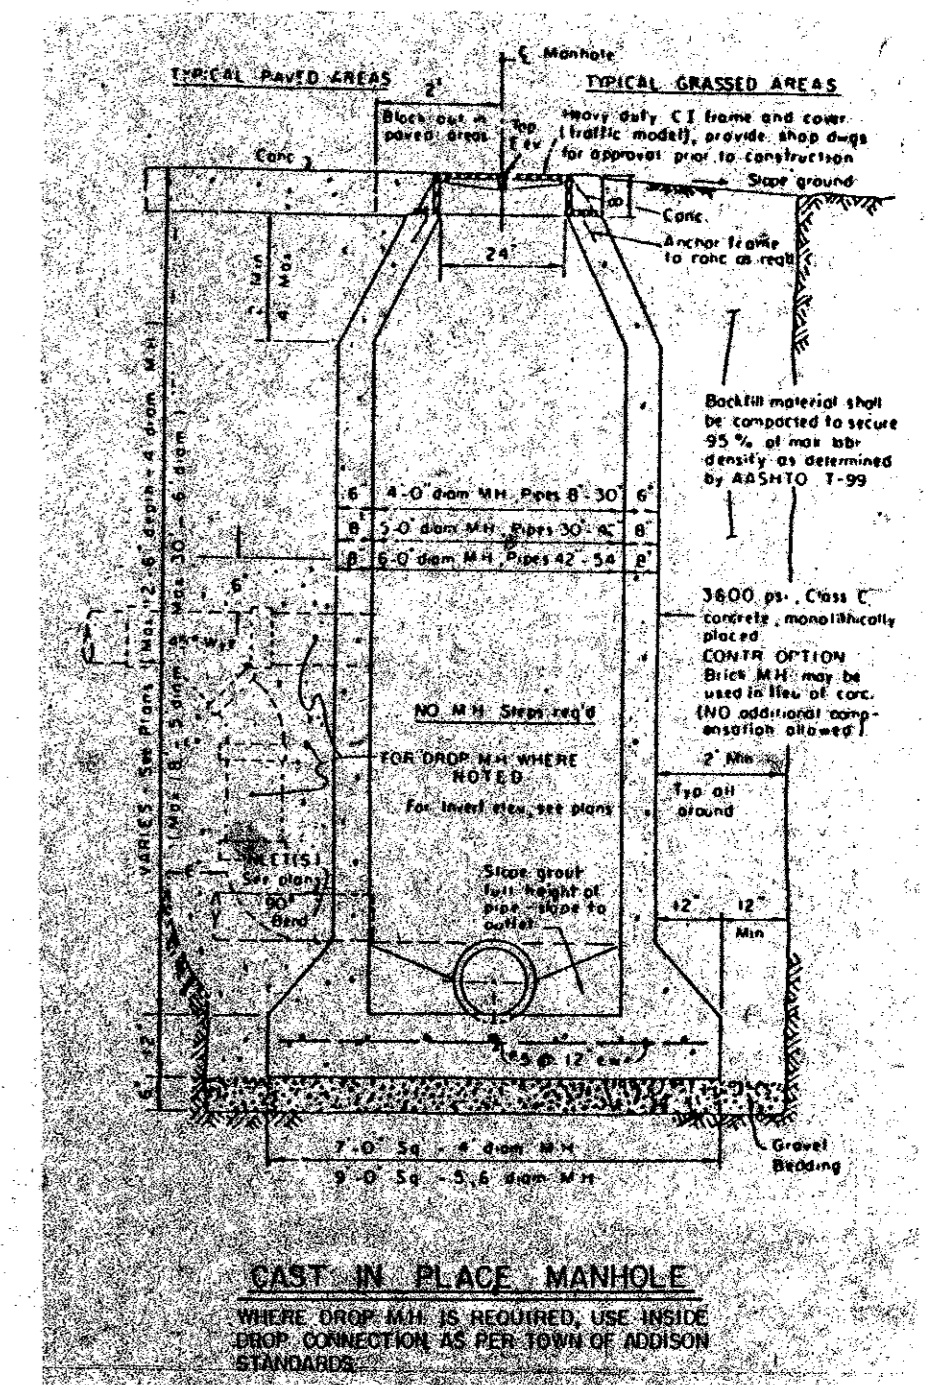
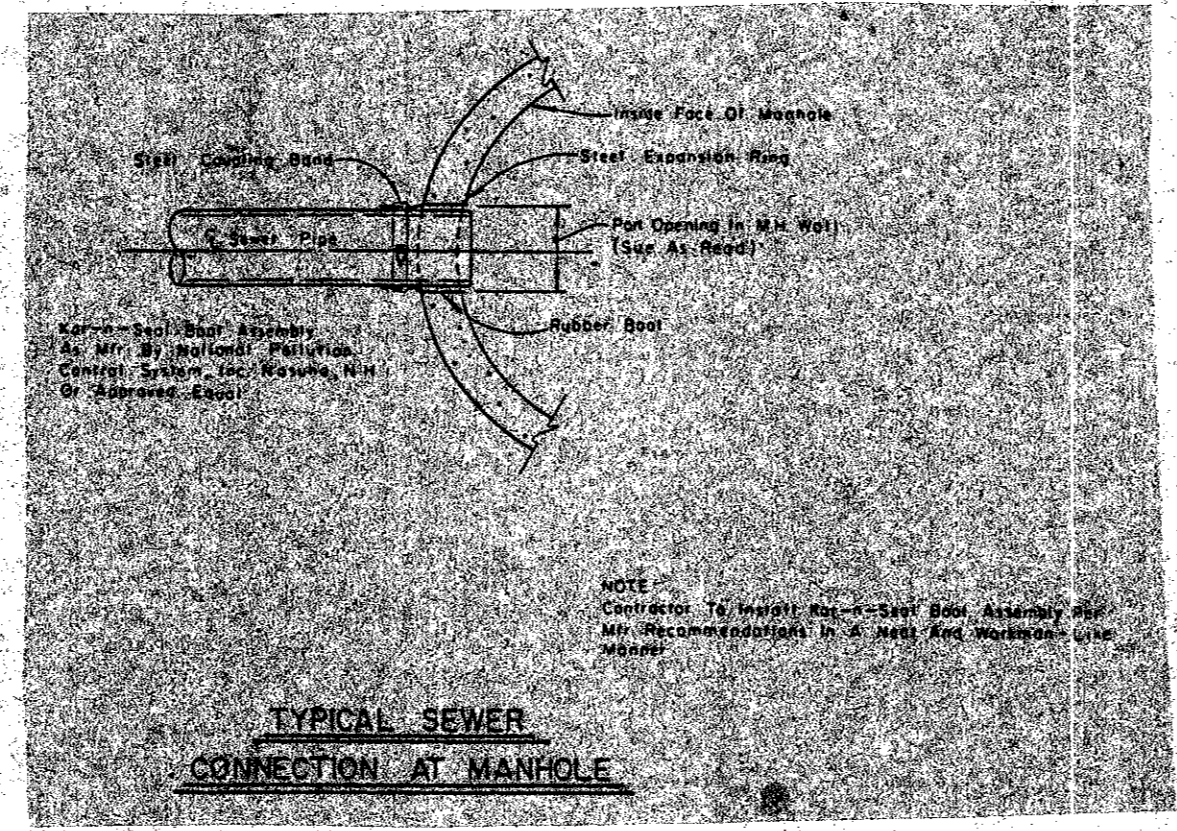


EMBEDMENT DETAIL - SANITARY SEWER
N.T.S.

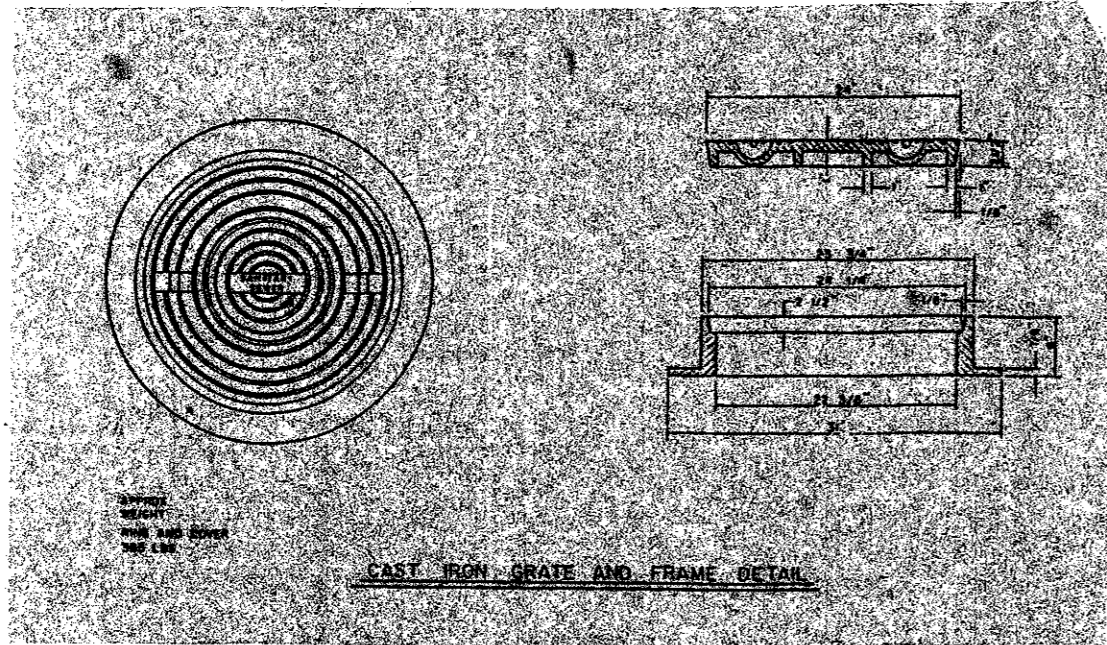

BM: OPERATING N.D.T. OF FIRE HYDRANT
AT SW CORNER OF SITE
ELEV. 609.16

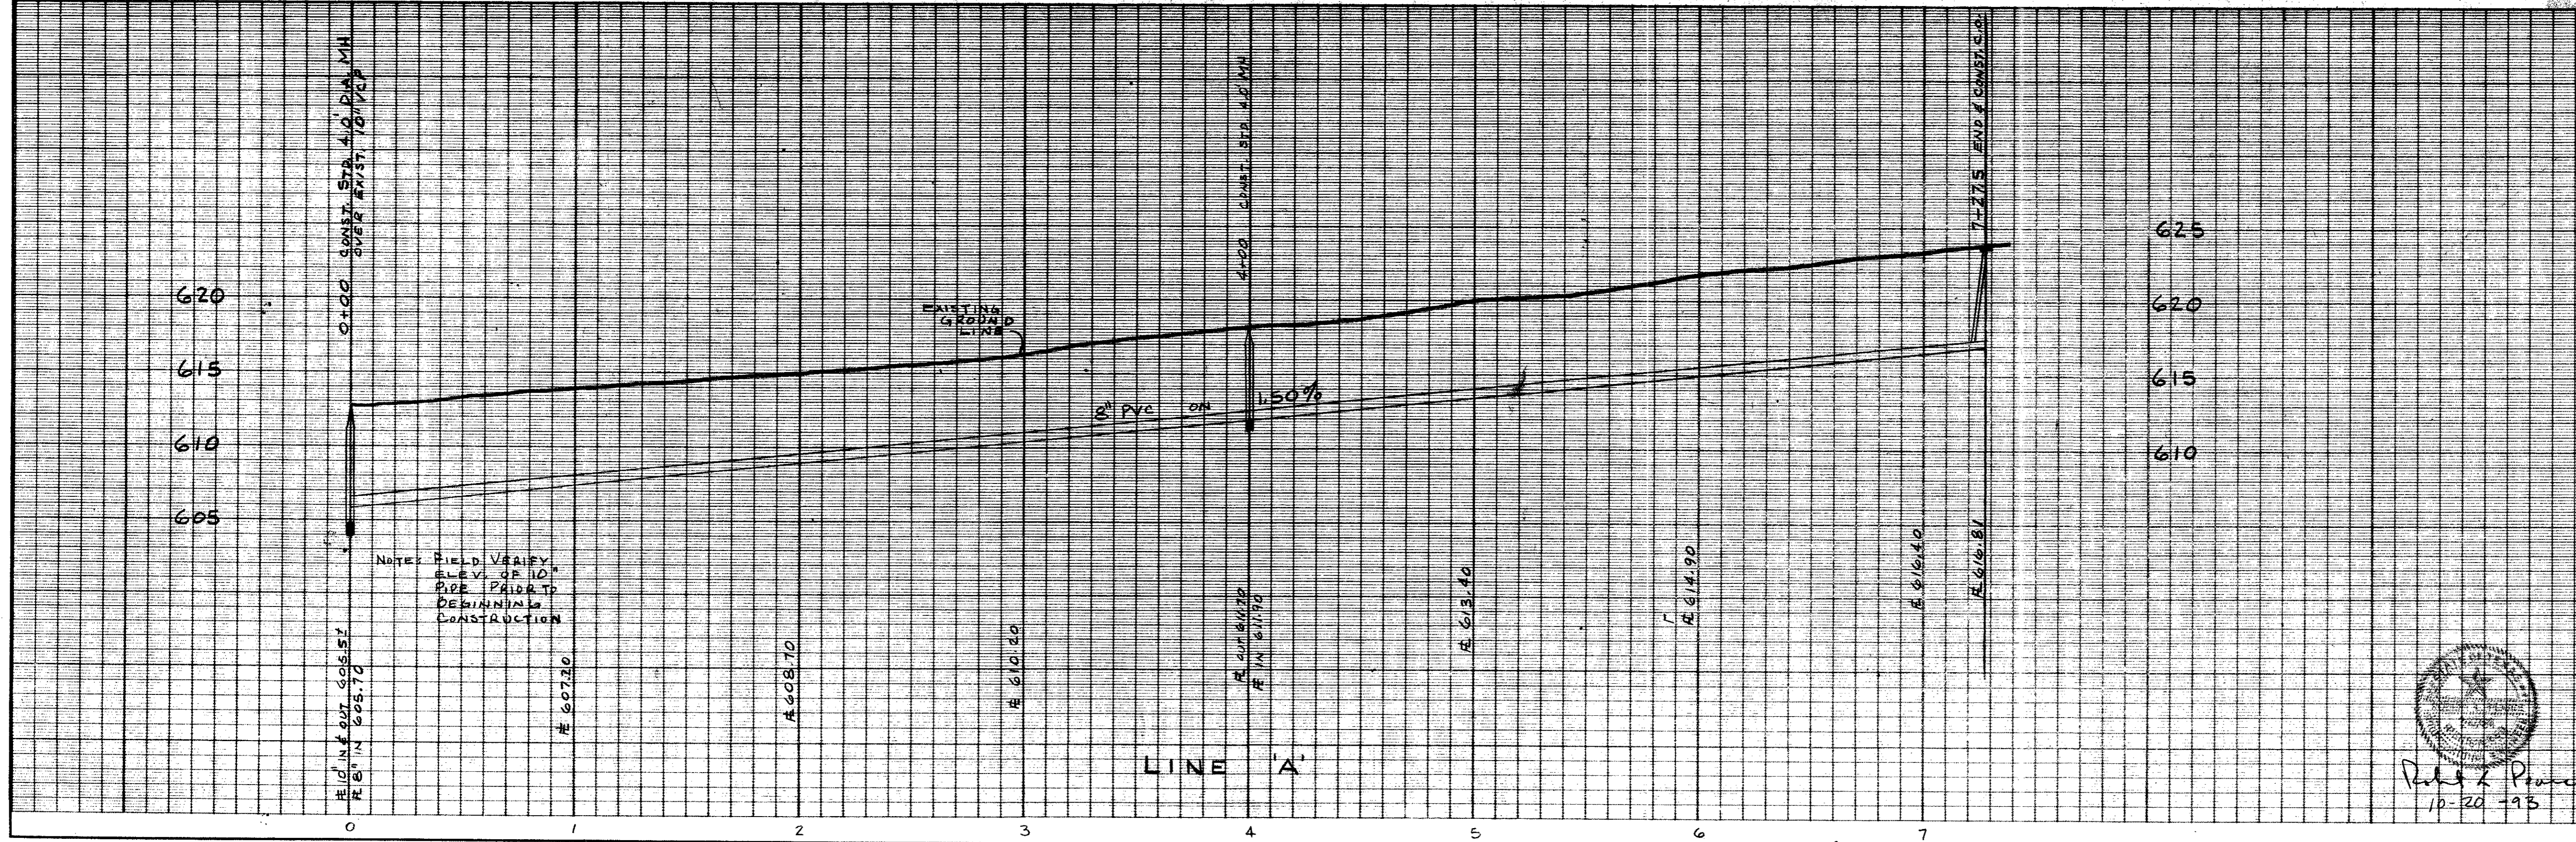

"AS BUILT"
2-14-94

SANITARY SEWER IMPROVEMENTS
BELTWOOD NORTH AIRPORT ADDN.
MIDWAY ROAD
TOWN OF ADDISON, TEXAS

DESIGN	DRAWN	DATE	SCALE	NOTES	FILE	NO.
PA	PA	Nov '93	1" = 40' H 1" = 6' V		O.N.93-003	4 OF 6

Paul & P...
10-20-93