


REVISIONS: 1. 10/20/93

"AS BUILT"  
2-14-94

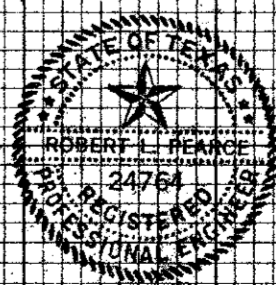

Robert J. Rouse  
10/20/93

SCALE 1"=5'

CREEK SECTIONS  
DELIWOOD NORTH AIRPORT ADDN.  
MIDWAY ROAD  
TOWN OF ADDISON, TEXAS

Nov '93

SHEET 6 OF 6