


Rosenfield Residence


Lot 5, Block 3
Bellbrook Estates
Addison, Texas

TOWN OF ADDISON
PW#2010-10

T-1	COVER SHEET
CE-1	GRADING PLAN
CE-2	DRAINAGE SYSTEM PLAN
CE-3	DIMENSION CONTROL PLAN
CE-4	WATER & STORM SEWER PLAN
DA-1	DRAINAGE AREA MAP
EC-1	EROSION CONTROL PLAN

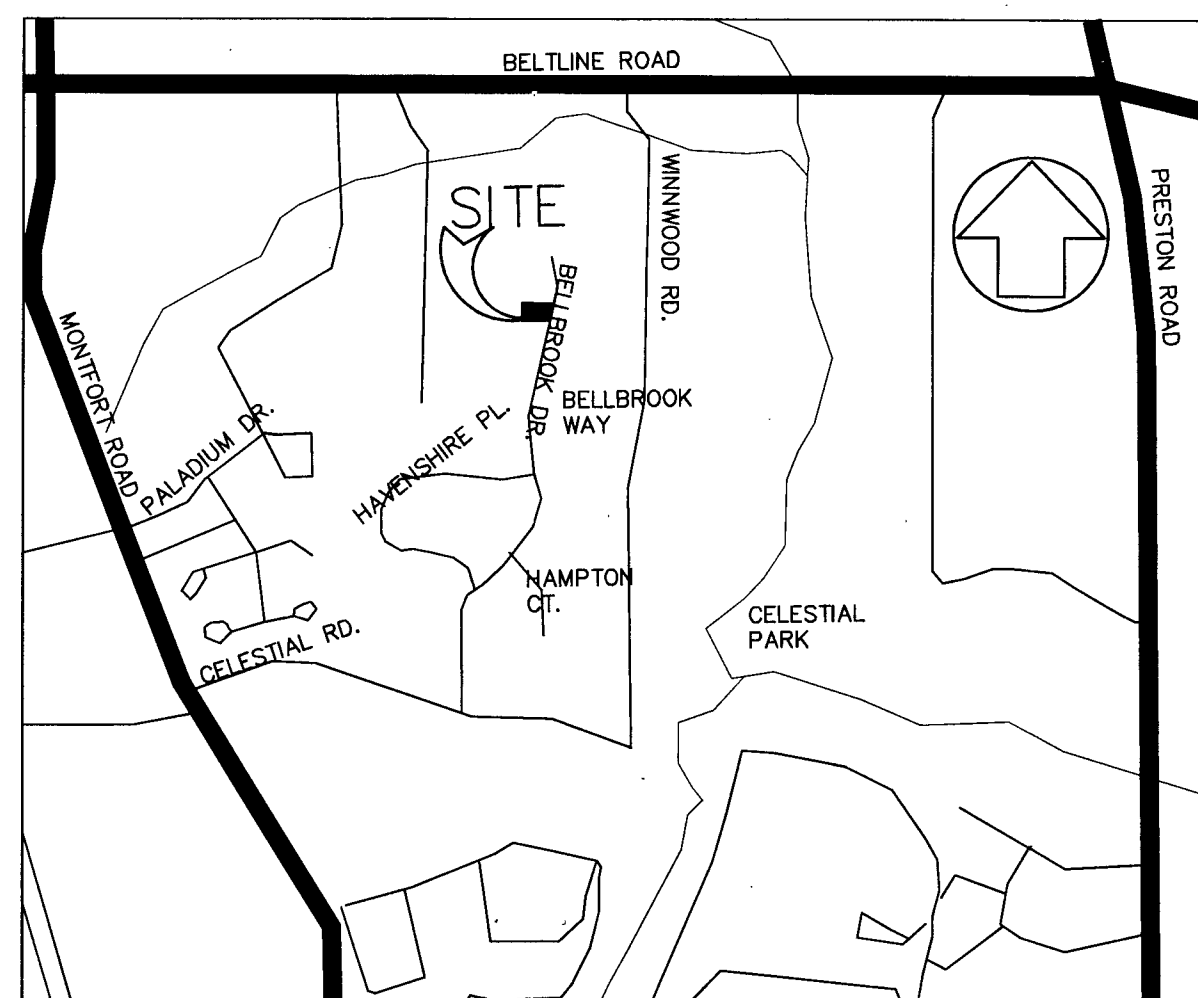

VICINITY MAP
N.T.S.

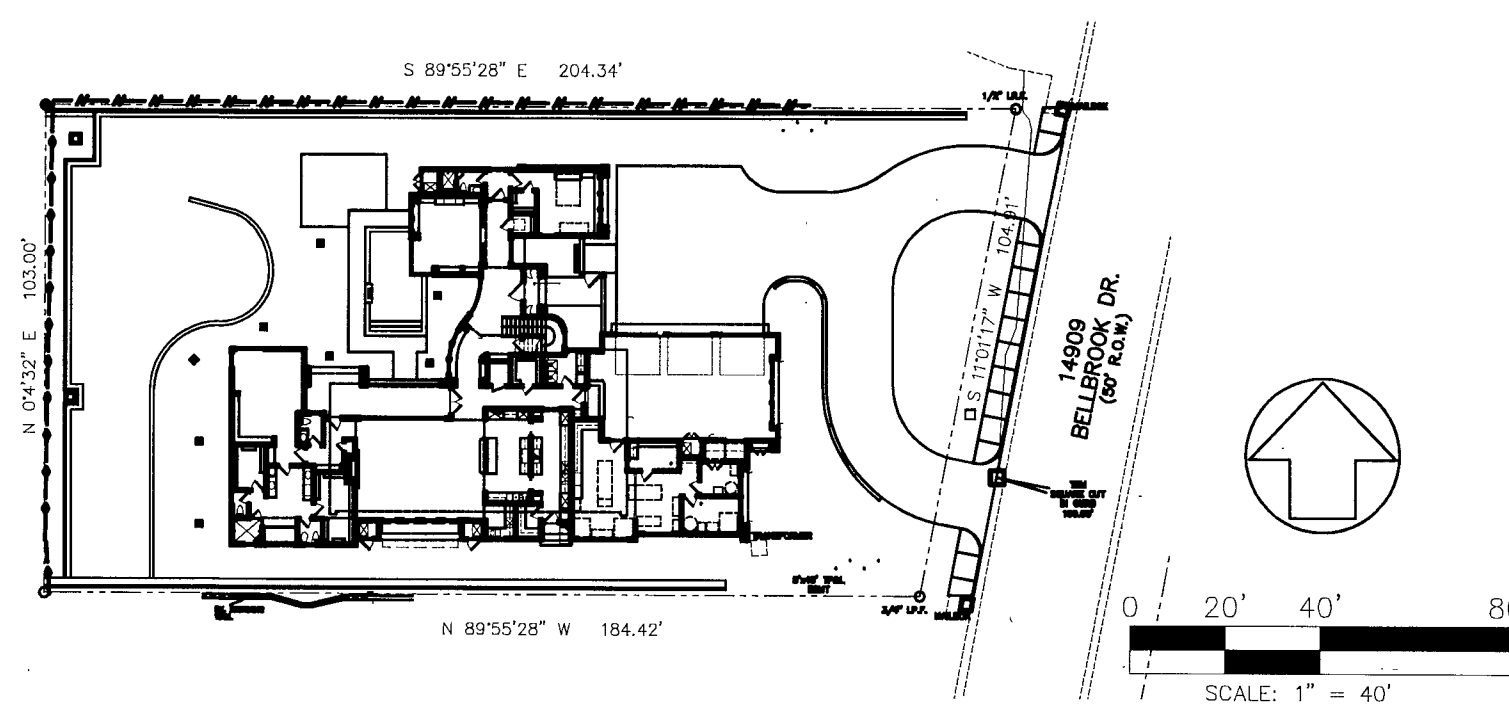



SITE PLAN

APPROVED FOR
CONSTRUCTION
Town of Addison
Public Works Department
APPROVED BY: *[Signature]*
DATE: 10/21/10

All responsibility for the adequacy of these plans remains with the Engineer who prepared them. In approving these plans, the Town of Addison makes no representation of adequacy of the work of the Design Engineer.

Dave -
Talk to clay
about 14909
Bellbrook.
They will re-install
grate in let pipe
IN THE CORNER.
as it was
(clay knows about it)
ATF

MICHAEL PEEPLES
Engineers and Planners
1930 E. ROSEMEADE #205 - CARROLLTON, TX 75007
972-416-1968 (TEL) 214-731-9949 (FAX)
ENGINEERING FIRM #3754

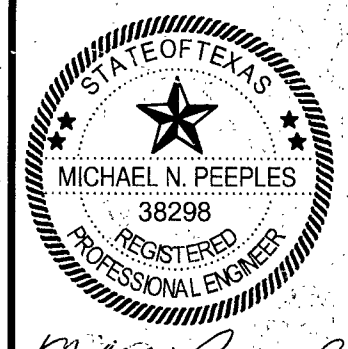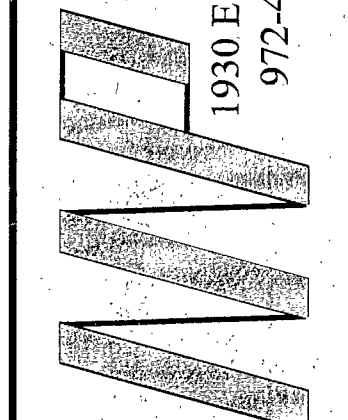

10/11/10

on, Texas

Lot 5, Block 3
David & Louise Rosenfield - Owners

SHEET
T-1
OF

PW#2010-10

PW#2010-10

DATE PLOTTED: 10/11/10

14909 BELLBROOK

14909 Bellbrook