

TOWN OF
ADDISON
 DALLAS COUNTY, TEXAS

CONSTRUCTION PLANS FOR

GREENHAVEN APTS

8" WATERLINE REPLACEMENT

MAYOR :
 D. LYNN SPRULL


COUNCIL MEMBERS :
 RICHARD RODER
 JIM DUFFY
 JOHN NOLAN
 JOHN BRANCH
 RILEY REINKER

CITY MANAGER :
 RON WHITEHEAD

DIRECTOR OF UTILITIES :
 DON PREECE

SHEET INDEX

- COVER SHEET
- 1. TITLE SHEET
- 2. STA. 0+00 TO STA. 3+25 LINE "A"
- 3. STA. 3+25 TO STA. 7+60 LINE "A"
- 4. STA. 0+00 TO STA. 3+85 LINE "C"
- 5. STA. 0+00 TO STA. 5+25 LINE "B"
- 6. STA. 5+25 TO STA. 7+25 LINE "B"
- 7. STD. WATER DETAILS SD-15
- 8. STD. WATER DETAILS SD-16
- 9. STD. WATER DETAILS SD-17

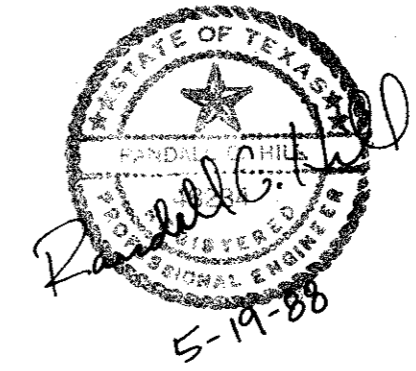

APPROVED BY: *[Signature]* DATE: _____
 D. LYNN SPRULL, MAYOR

GINN, INC.
 Consulting Engineers Dallas, Texas

RECORD DRAWING