
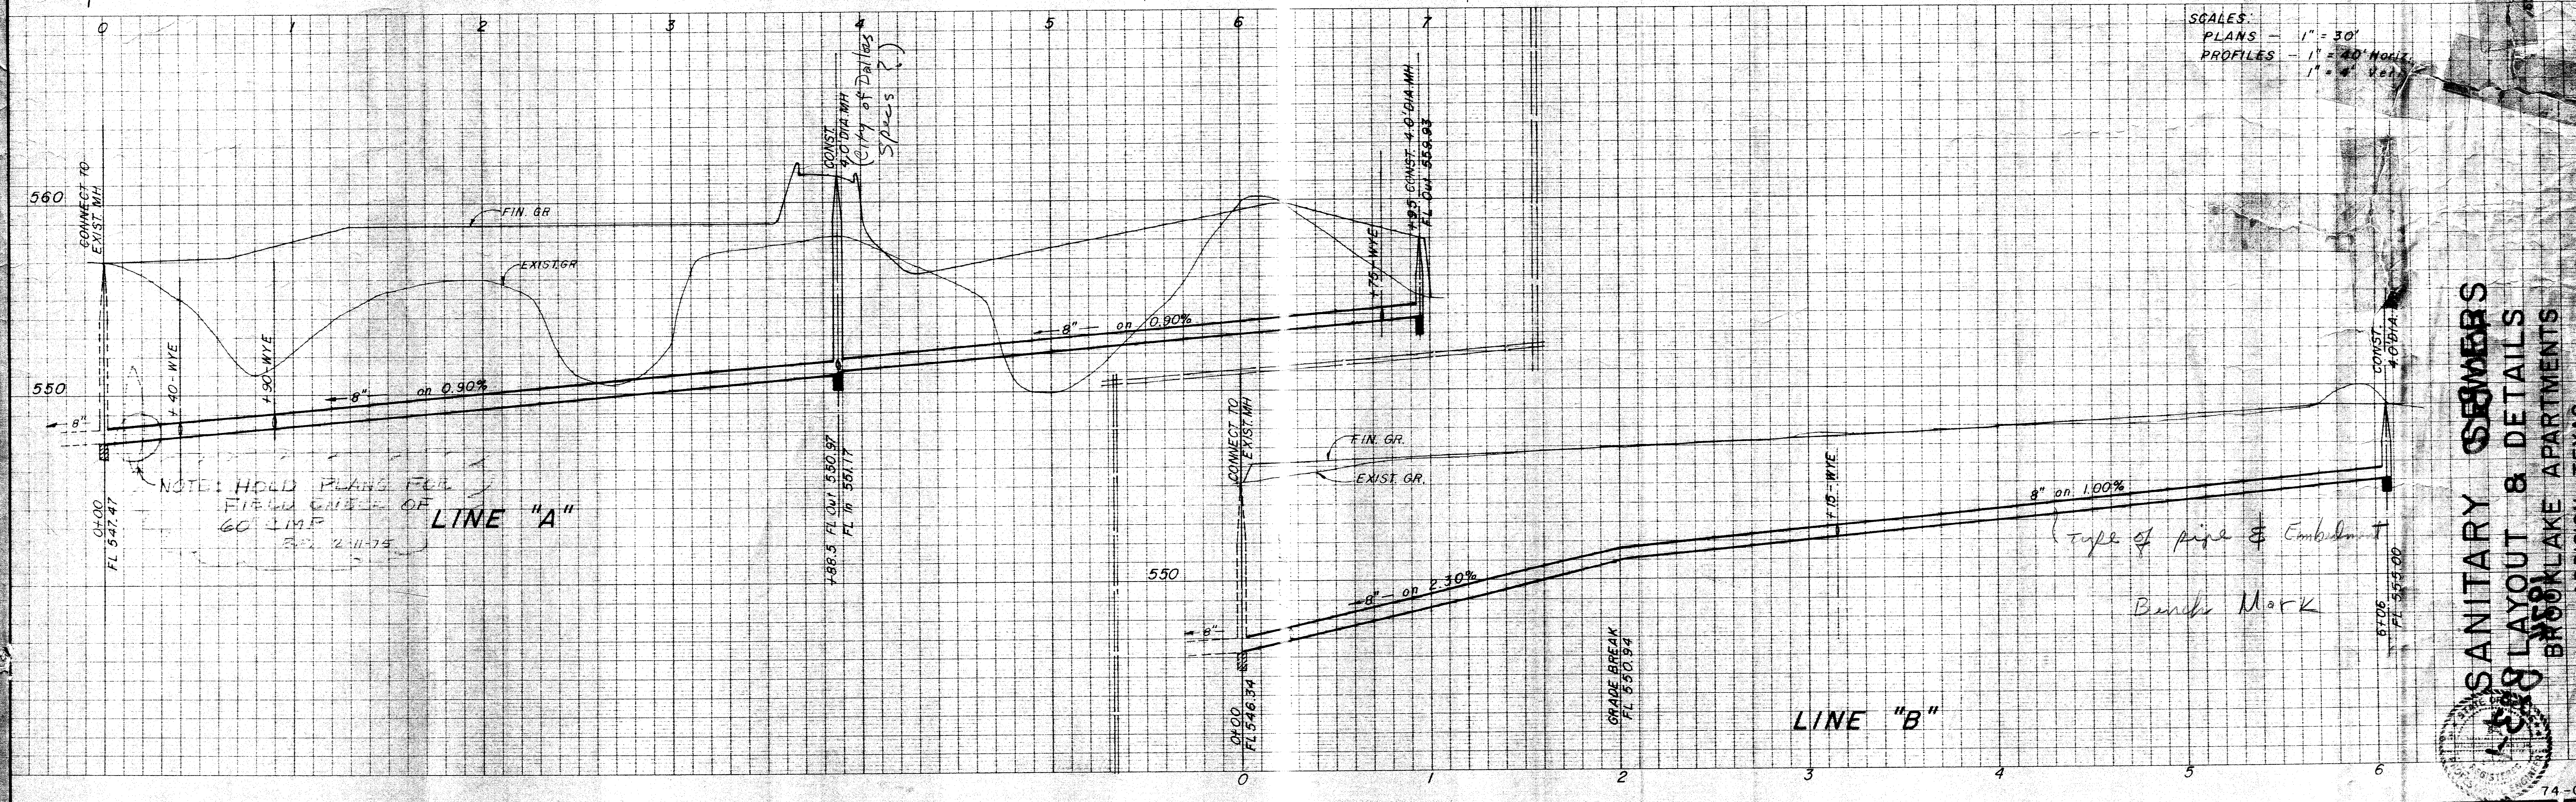


852.1

ELSEY-McCOWN-PERRY, INC.
CONSULTING ENGINEERS
 1515 W. Mockingbird Ln. Dallas, Texas
 Suite 102 214-634-9591 75235
CIVIL DEVELOPMENT MUNICIPAL

Recommended for Approval
 As Noted
 Russell L. Betts, P.E.
 2/18/75

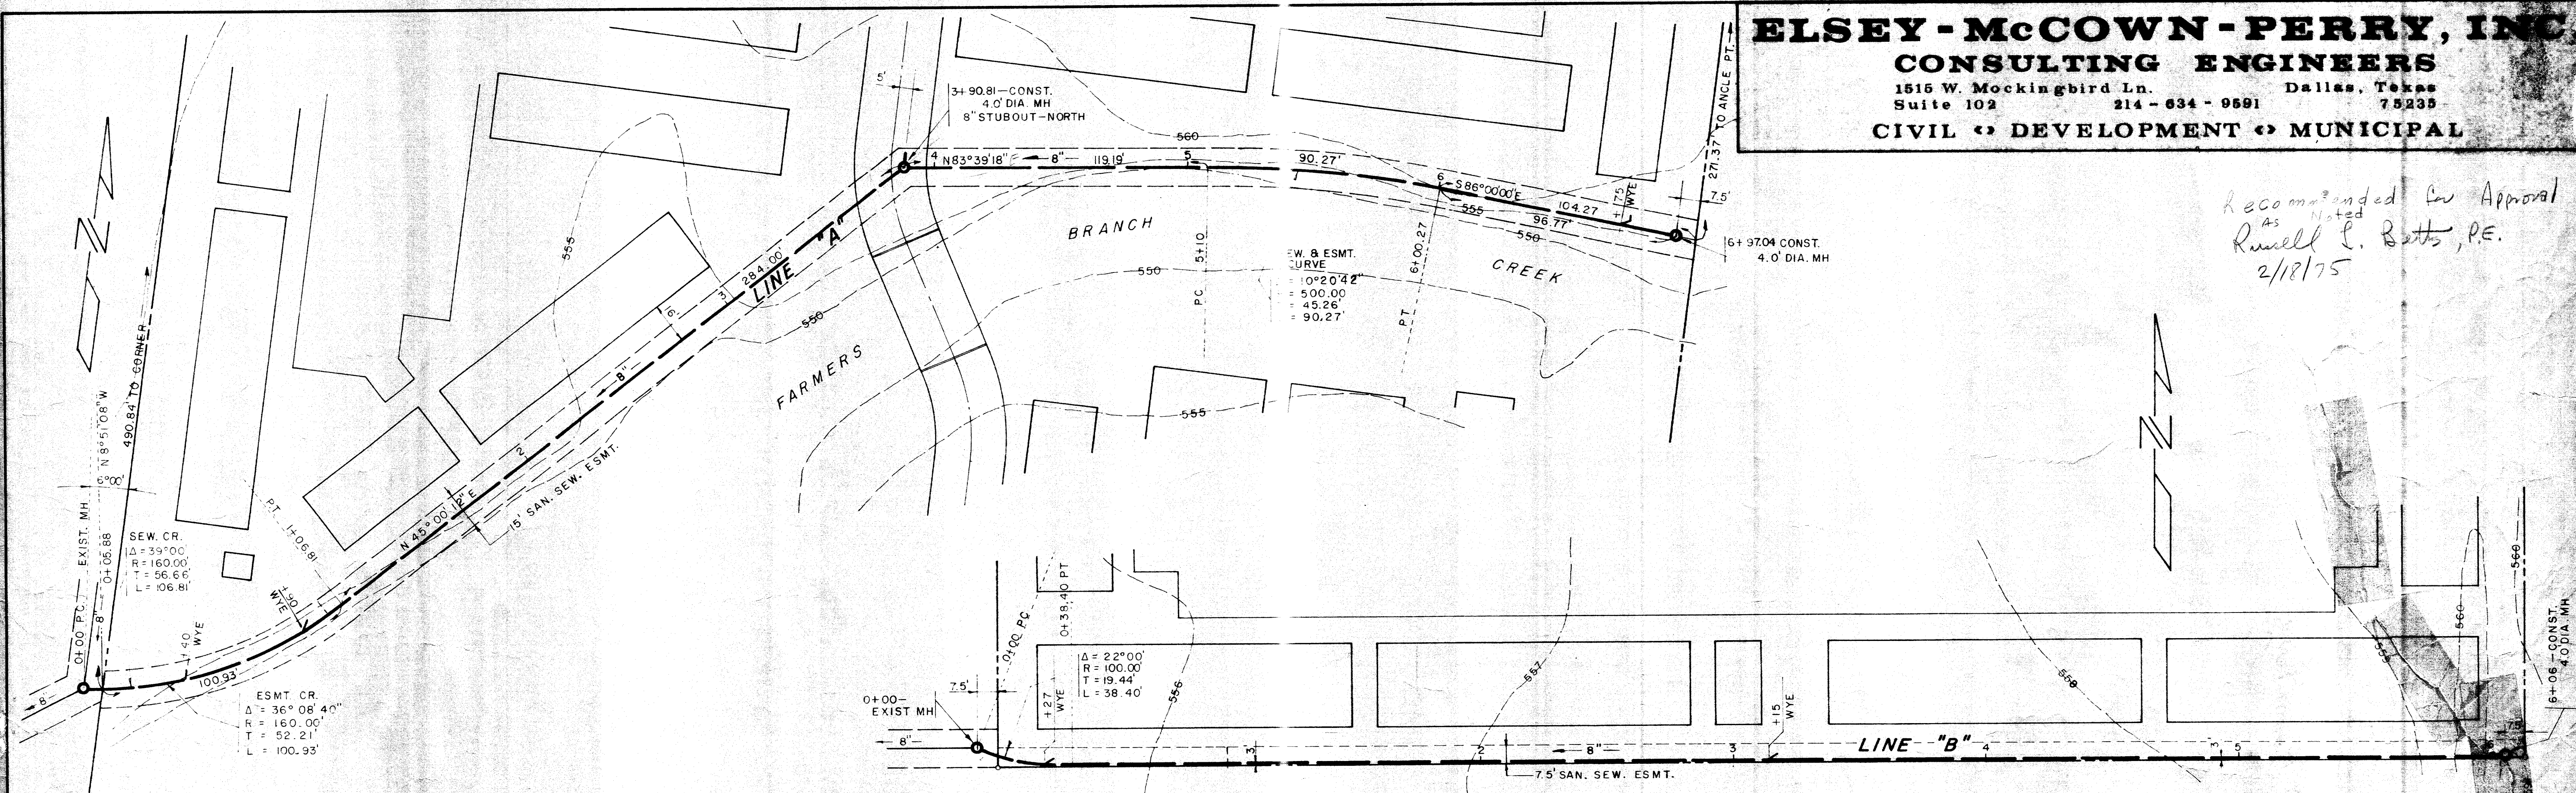

SCALES:
 PLANS - 1" = 30'
 PROFILES - 1" = 4.0' VERT.
 1" = 4' HORIZ.

NOTE: HOLD PLANS FOR FIELD CHECK OF 60' LIME BY 2/11/75
 LINE "A"

Type of pipe & Embulment
 Bench Mark

SANITARY SEWERS
LAYOUT & DETAILS
BROOKLAKE APARTMENTS
 ADDISON, TEXAS

