

SPRING VALLEY ROAD


LANE

MARSH

BROOKHAVEN DRIVE

SCALE 1" = 200'

Drawer 1
#12

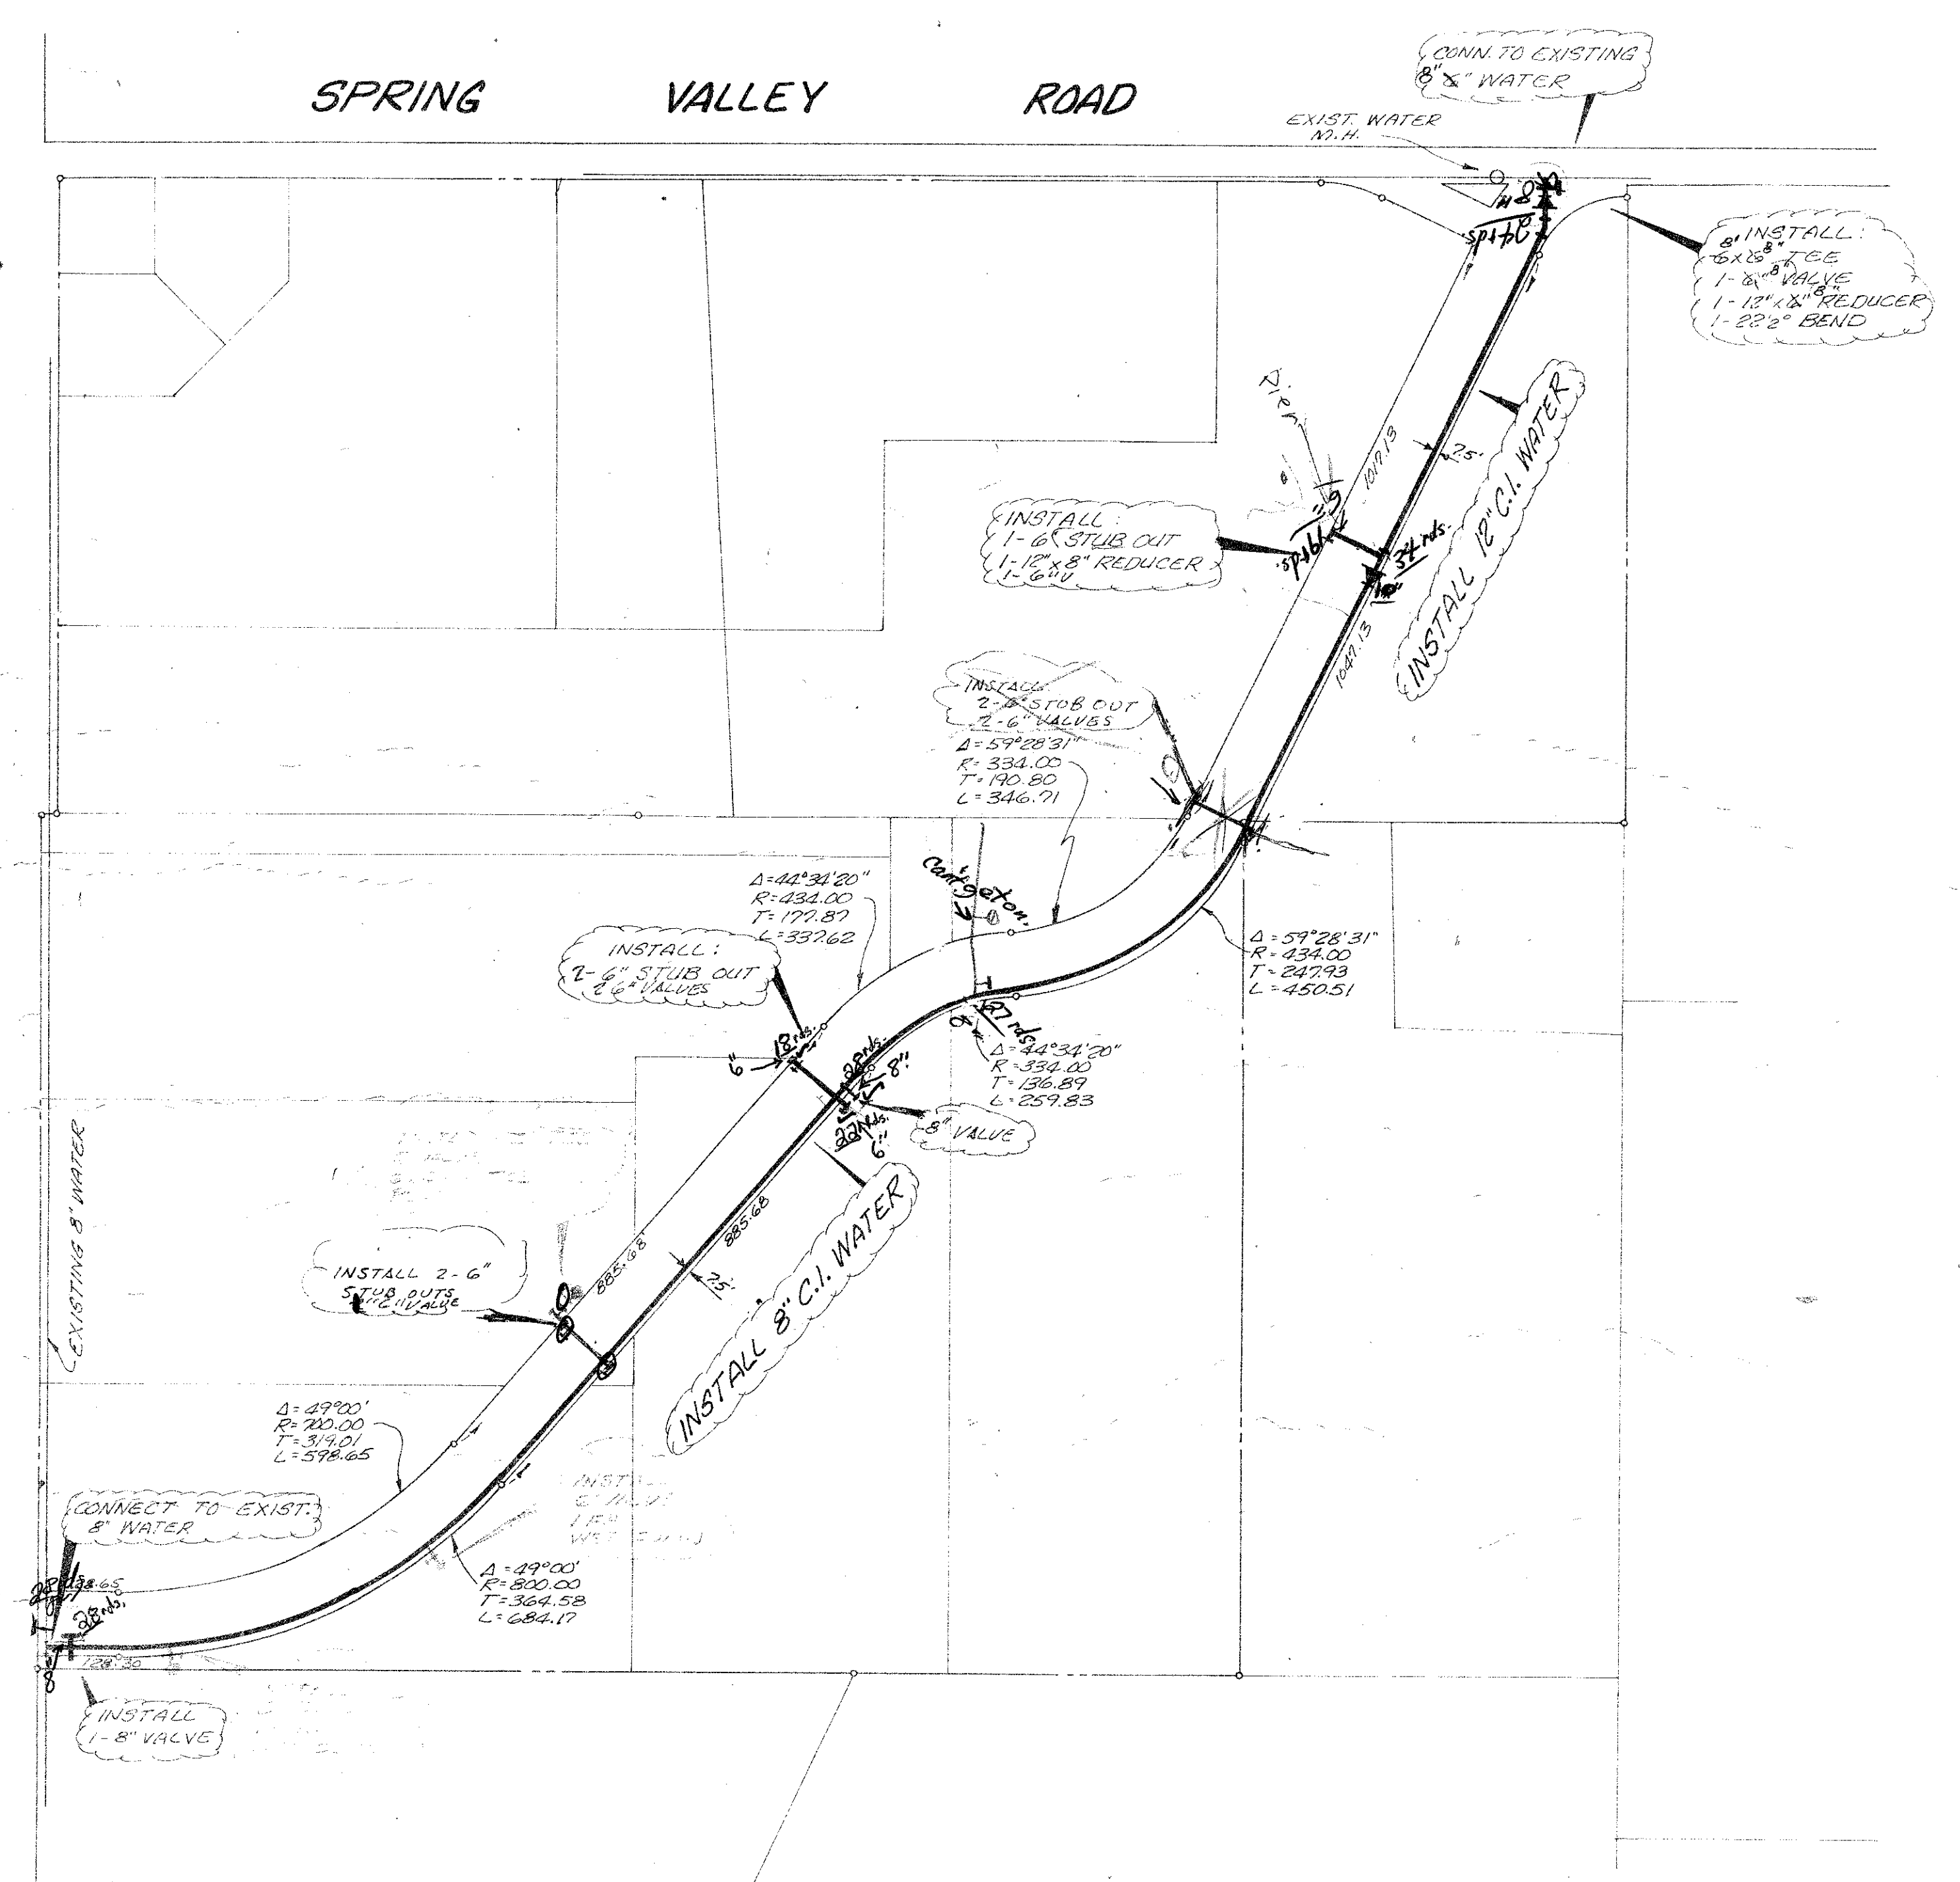

729.52
156.16
885.68

Drawer #1
#12

WATER

BILLY L. STEPHENSON			
CITY OF ADDI			
DESIGN	DRAWN	DATE	SCALE
B.L.S.	J.A.	APR 69	1" = 200'

