


LOT 1, BLOCK 1
 SPRING VALLEY / MARSH LANE CENTER
 VOL. 85241, PG. 3749

LOT 16 LOT 17 NOELL ACRES - UNRECORDED LOT 18 LOT 19 LOT 20 LOT 21

SPRING VALLEY ROAD
 (60' R.O.W.)

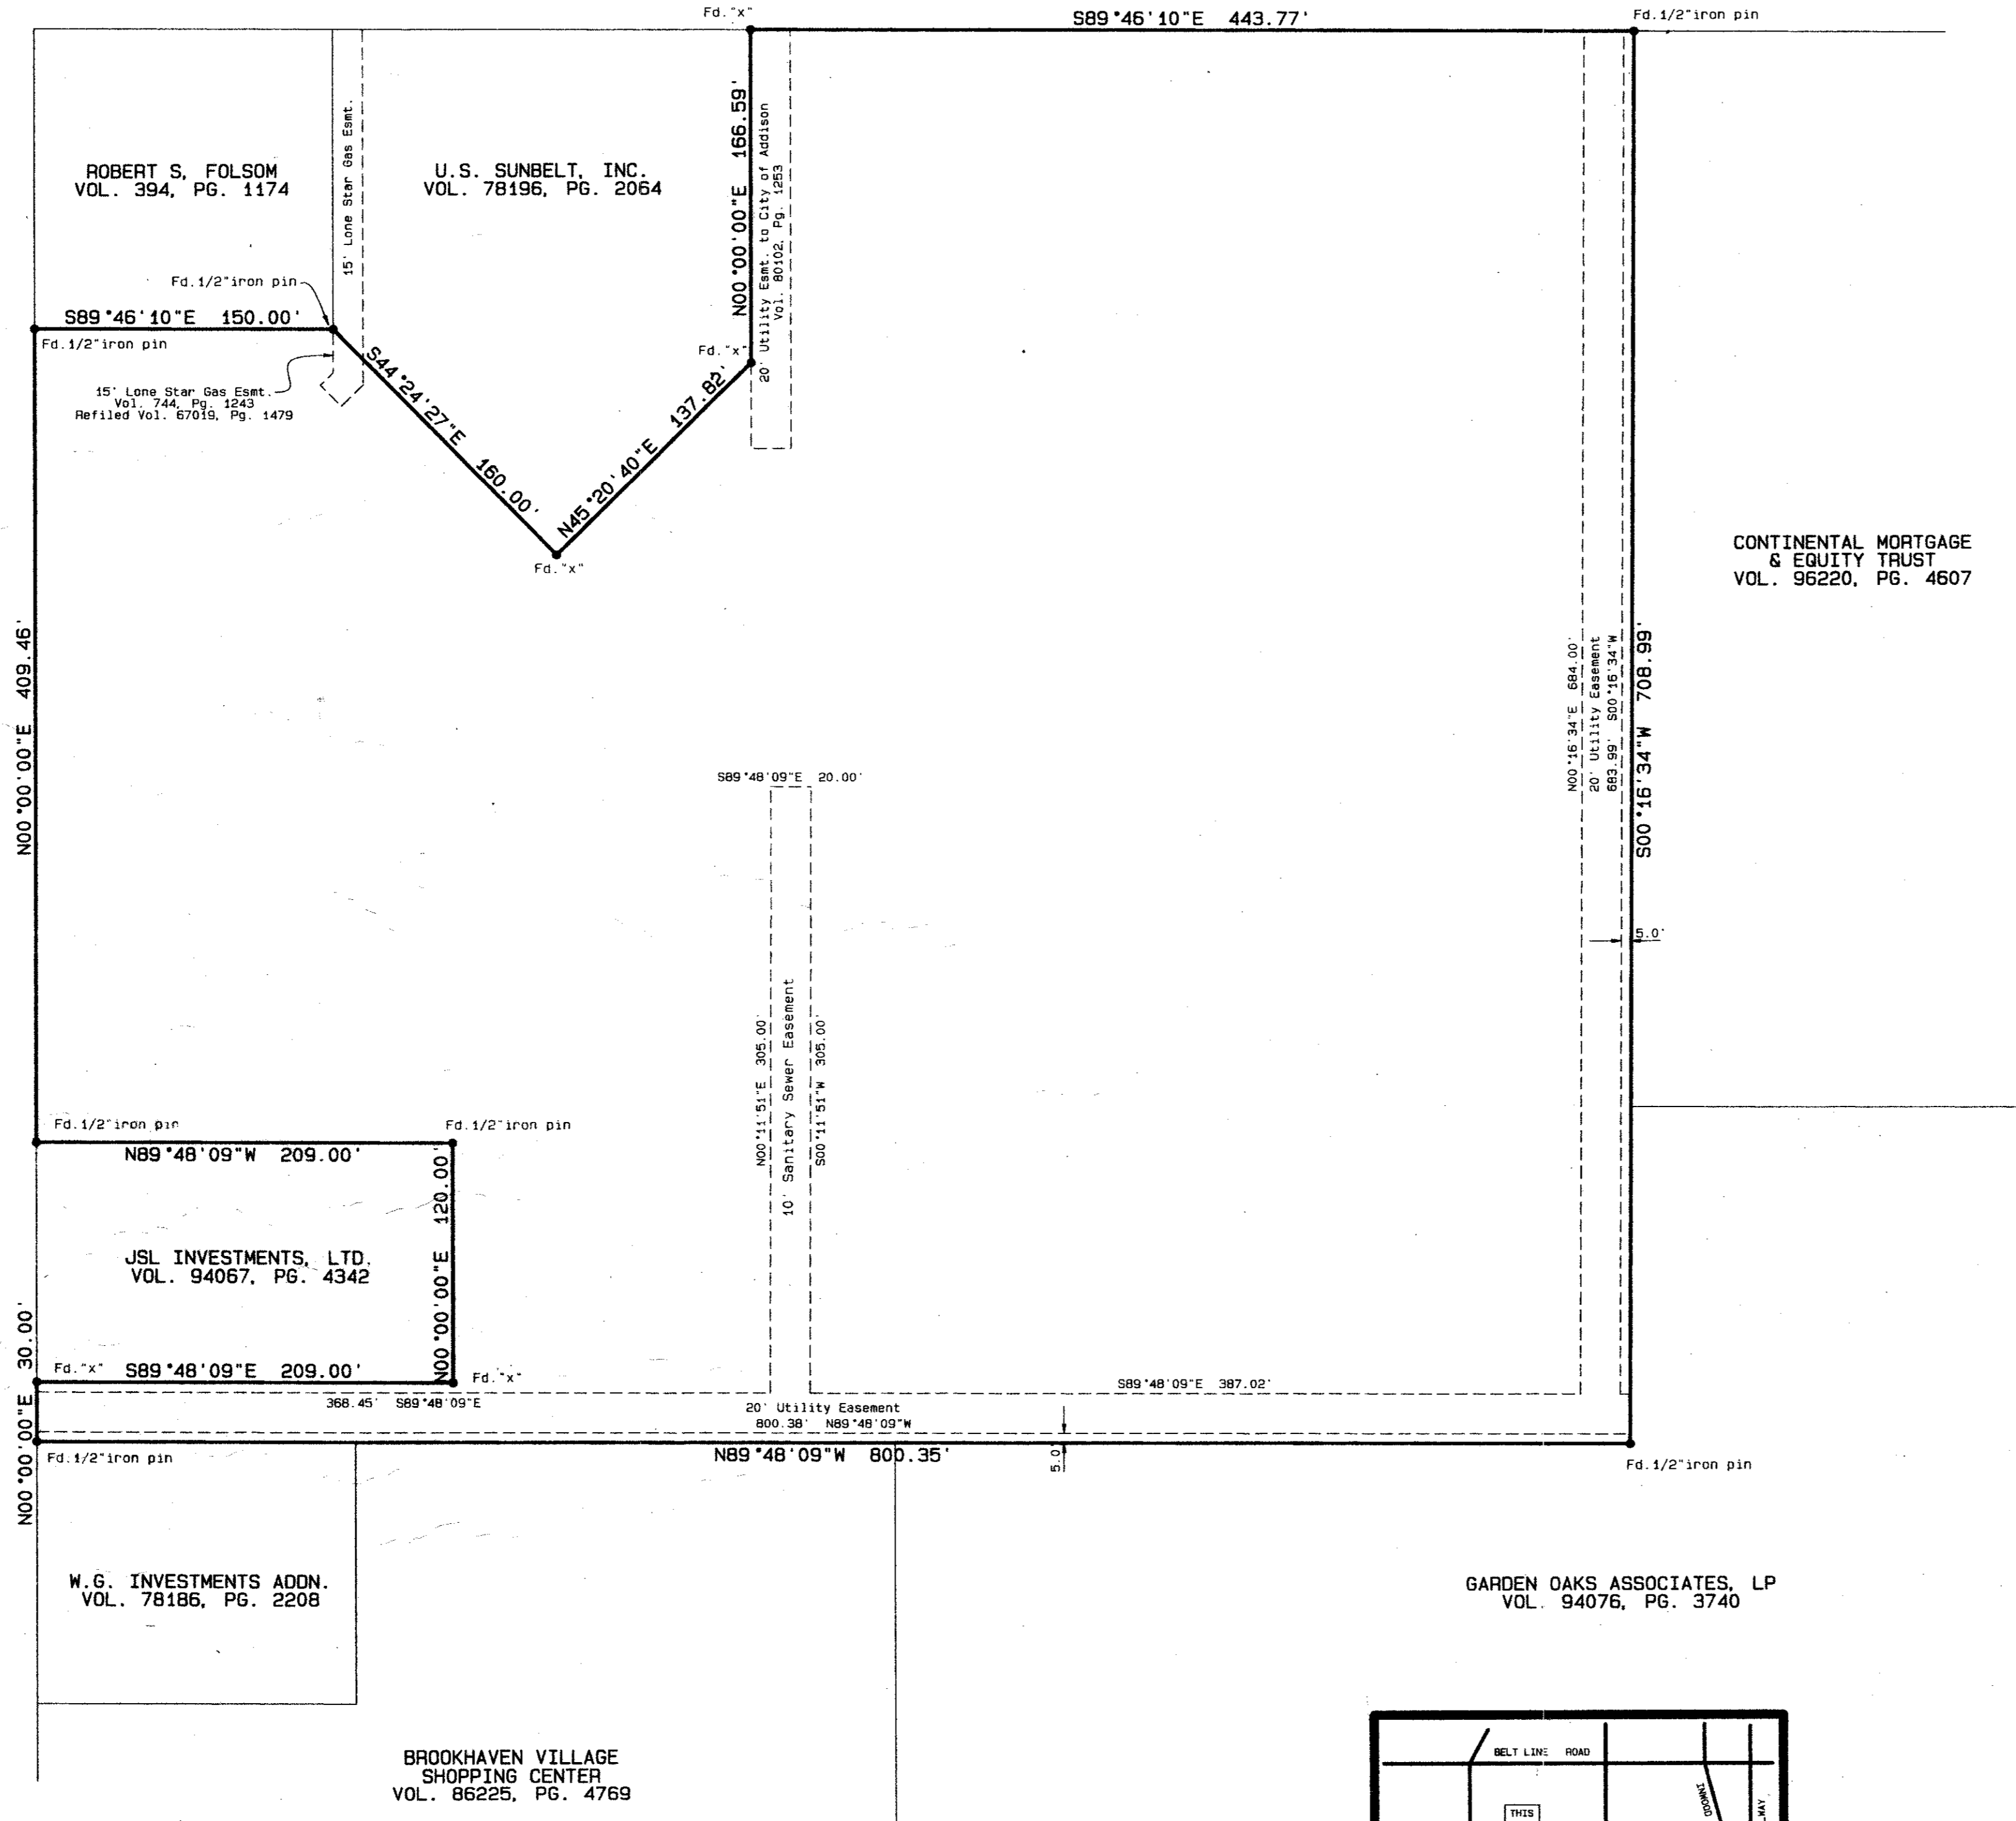

OWNERS CERTIFICATE AND DEDICATION

STATE OF TEXAS *
 COUNTY OF DALLAS *

WHEREAS FOLSOM PROPERTIES, INC. a Texas Corporation is the owner of a tract of land situated in the Noah Good Survey, Abstract No. 520, Dallas County, Texas, located in the Town of Addison, Texas, said tract being part of a 17.894 acre tract conveyed to Folsom Properties, Inc., a Texas Corporation by deed recorded in Volume 92006, Page 1797 of the Deed Records of Dallas County, Texas, and being more particularly described as follows:

BEGINNING at a point in the east line of Marsh Lane (a 100 ft. R.O.W. at this point) said point being S00 00'00"E, along said east line, 150.00 feet from its intersection with the south line of Spring Valley Road (a 60 ft. R.O.W. at this point);

THENCE S89 46'10"E, 150.00 feet to a 1/2" iron pin found for corner;
 THENCE S44 24'27"E, 160.00 feet to an "x" cut found for corner;
 THENCE N45 20'40"E, 137.82 feet to an "x" cut found for corner;
 THENCE N00 00'00"E, 166.59 feet to an "x" cut found for corner in the south line of Spring Valley Road;
 THENCE S89 46'10"E, along said south line, 443.77 feet to a 1/2" iron pin found for corner;
 THENCE S00 16'34"W, 708.99 feet to a 1/2" iron pin with red FD cap found for corner;
 THENCE N89 48'09"W, 800.35 feet to a 1/2" iron pin found for corner in the east line of Marsh Lane;
 THENCE N00 00'00"E, along said east line, 30.00 feet to an "x" cut found for corner;
 THENCE S89 48'09"E, 209.00 feet to an "x" cut found for corner;
 THENCE N00 00'00"E, 120.00 feet to a 1/2" iron pin found for corner;
 THENCE N89 48'09"W, 209.00 feet to a 1/2" iron pin found for corner in the east line of Marsh Lane;
 THENCE N00 00'00"E, along said east line, 409.46 feet to a 1/2" iron pin found for corner and the place of beginning and containing 10.950 acres (476,992 square feet) of land.

NOW, THEREFORE, KNOW ALL MEN BY THESE PRESENTS: That FOLSOM PROPERTIES, INC., a Texas Corporation does hereby adopt this plat designating the hereinabove property as BROOKHAVEN VILLAGE SHOPPING CENTER, PHASE 2, an addition to the Town of Addison, Texas, and, subject to the conditions, restrictions and reservations stated hereinafter, owner dedicates to the public use forever the streets and alleys shown thereon. The easements shown on this plat are hereby reserved for the purposes as indicated, including, but not limited to, the installation and maintenance of water, sanitary sewer, storm sewer, drainage, electric, telephone, gas and cable television. Owner shall have the right to use these easements, provided however, that it does not unreasonably interfere or impede with the provision of the services to others. Said utility easements are hereby being reserved by mutual use and accommodation of all public utilities using or desiring to use the same. An express easement of ingress and egress is hereby expressly granted on, over and across all such easements for the benefit of the provider of services for which easements are granted.

Any drainage and floodway easement shown hereon is hereby dedicated to the Public's use forever, but including the following covenants with regards to maintenance responsibilities. The existing channels or creeks traversing the drainage and floodway easement will remain as an open channel, unless required to be enclosed by ordinance, at all times and shall be maintained by the individual owners of the lot or lots that are traversed by or adjacent to the drainage and floodway easement. The city will not be responsible for the maintenance and operation of said creek or creeks or for any damage or injury of private property or person that results from the flow of water along said creek, or for the control of erosion. No obstruction to the natural flow of water run-off shall be permitted by construction of any type building, fence or any other structure within the drainage and floodway easement. Provided, however, it is understood that in the event it becomes necessary for the city to channelize or consider erecting any type of drainage structure in order to improve the storm drainage, then in such event, the city shall have the right, but not the obligation, to enter upon the drainage and floodway easement at any point, or points, with all rights of ingress and egress to investigate, survey, erect, construct or maintain any drainage facility deemed necessary by the city for maintenance or efficiency of its respective system or service. Water main and sanitary sewer easements shall also include additional area of working space for installation and maintenance of manholes, cleanouts, fire hydrants, water service and sewer services from the main to curb or pavement line, and the descriptions of such additional easements herein granted shall be determined by their locations as installed.

This plat is approved subject to all platting ordinances, rules, regulations and resolutions of the Town of Addison, Texas.
 WITNESS MY HAND AT DALLAS, TEXAS, this the ___ day of _____, 1998.

FOLSOM PROPERTIES, INC.
 a Texas Corporation

By: _____

STATE OF TEXAS *
 COUNTY OF DALLAS *

BEFORE ME, the undersigned, a Notary Public in and for said County and State on this day personally appeared _____ known to me to be the person whose name is subscribed to the foregoing instrument and acknowledged to me that he executed the same for the purpose and consideration therein expressed and in the capacity therein stated.

GIVEN UNDER MY HAND AND SEAL OF OFFICE this ___ day of _____, 1998.

Notary Public in the State of Texas
 My Appointment Expires _____

SURVEYOR CERTIFICATE
 KNOW ALL MEN BY THESE PRESENTS *

I, DON H. DEERE for FERGUSON-DEERE, INC., a Registered Professional Land Surveyor in the State of Texas, do hereby certify that I have prepared this plat from an actual on the ground survey of the land, and the monuments shown hereon were found and/or placed under my personal supervision in accordance with the platting rules and regulations of the City Plan Commission of the Town of Addison, Texas.

DON H. DEERE, Texas Registered
 Professional Land Surveyor #2233

STATE OF TEXAS *
 COUNTY OF DALLAS *

BEFORE ME, RICHARD E. SLAY, a notary public, on this day personally appeared DON H. DEERE, known to me to be the person whose name is subscribed to the foregoing instrument and acknowledged to me that he executed the same for the purposes and consideration therein expressed and in the capacity therein stated.

GIVEN UNDER MY HAND AND SEAL OF OFFICE this ___ day of _____, 1998

RICHARD E. SLAY
 Notary Public in the State of Texas
 My appointment Expires 04-14-2001

FINAL PLAT
BROOKHAVEN VILLAGE SHOPPING CENTER
PHASE 2


TOWN OF ADDISON, TEXAS
 NOAH GOOD SURVEY, ABSTRACT NO. 520
 DALLAS COUNTY, TEXAS

FOLSOM PROPERTIES, INC. * OWNER
 16475 DALLAS PARKWAY - DALLAS, TEXAS 75248
 214-931-7400


FERGUSON-DEERE, INC. * ENGINEERS
 9817 KINGSLEY ROAD - DALLAS, TEXAS 75238
 PHONE: 214-348-2821 FAX: 214-348-3644

JULY, 1998 - SCALE: 1"=60'

GRAPHIC SCALE


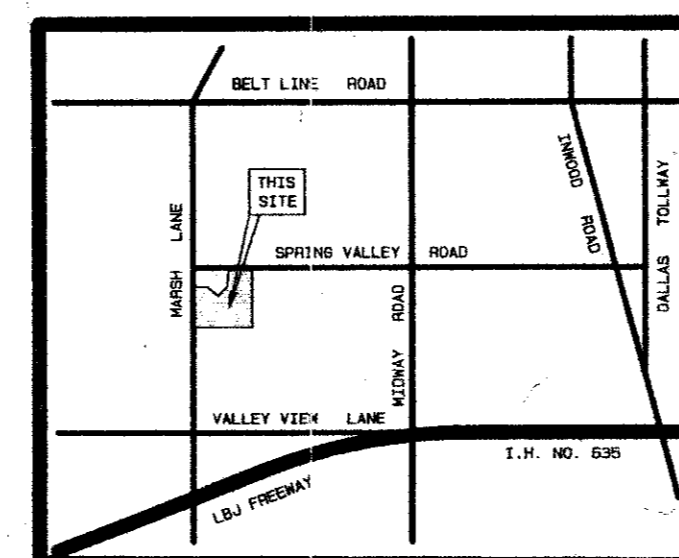


LOCATION MAP
 NO SCALE

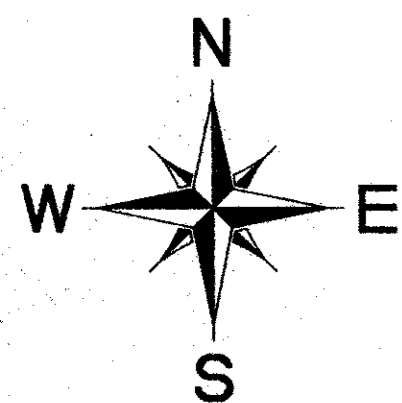

BROOKHAVEN HTLS. ADDITION NO. 2
 FARMERS BRANCH, TEXAS

MARSH LANE
 (100' R.O.W.)

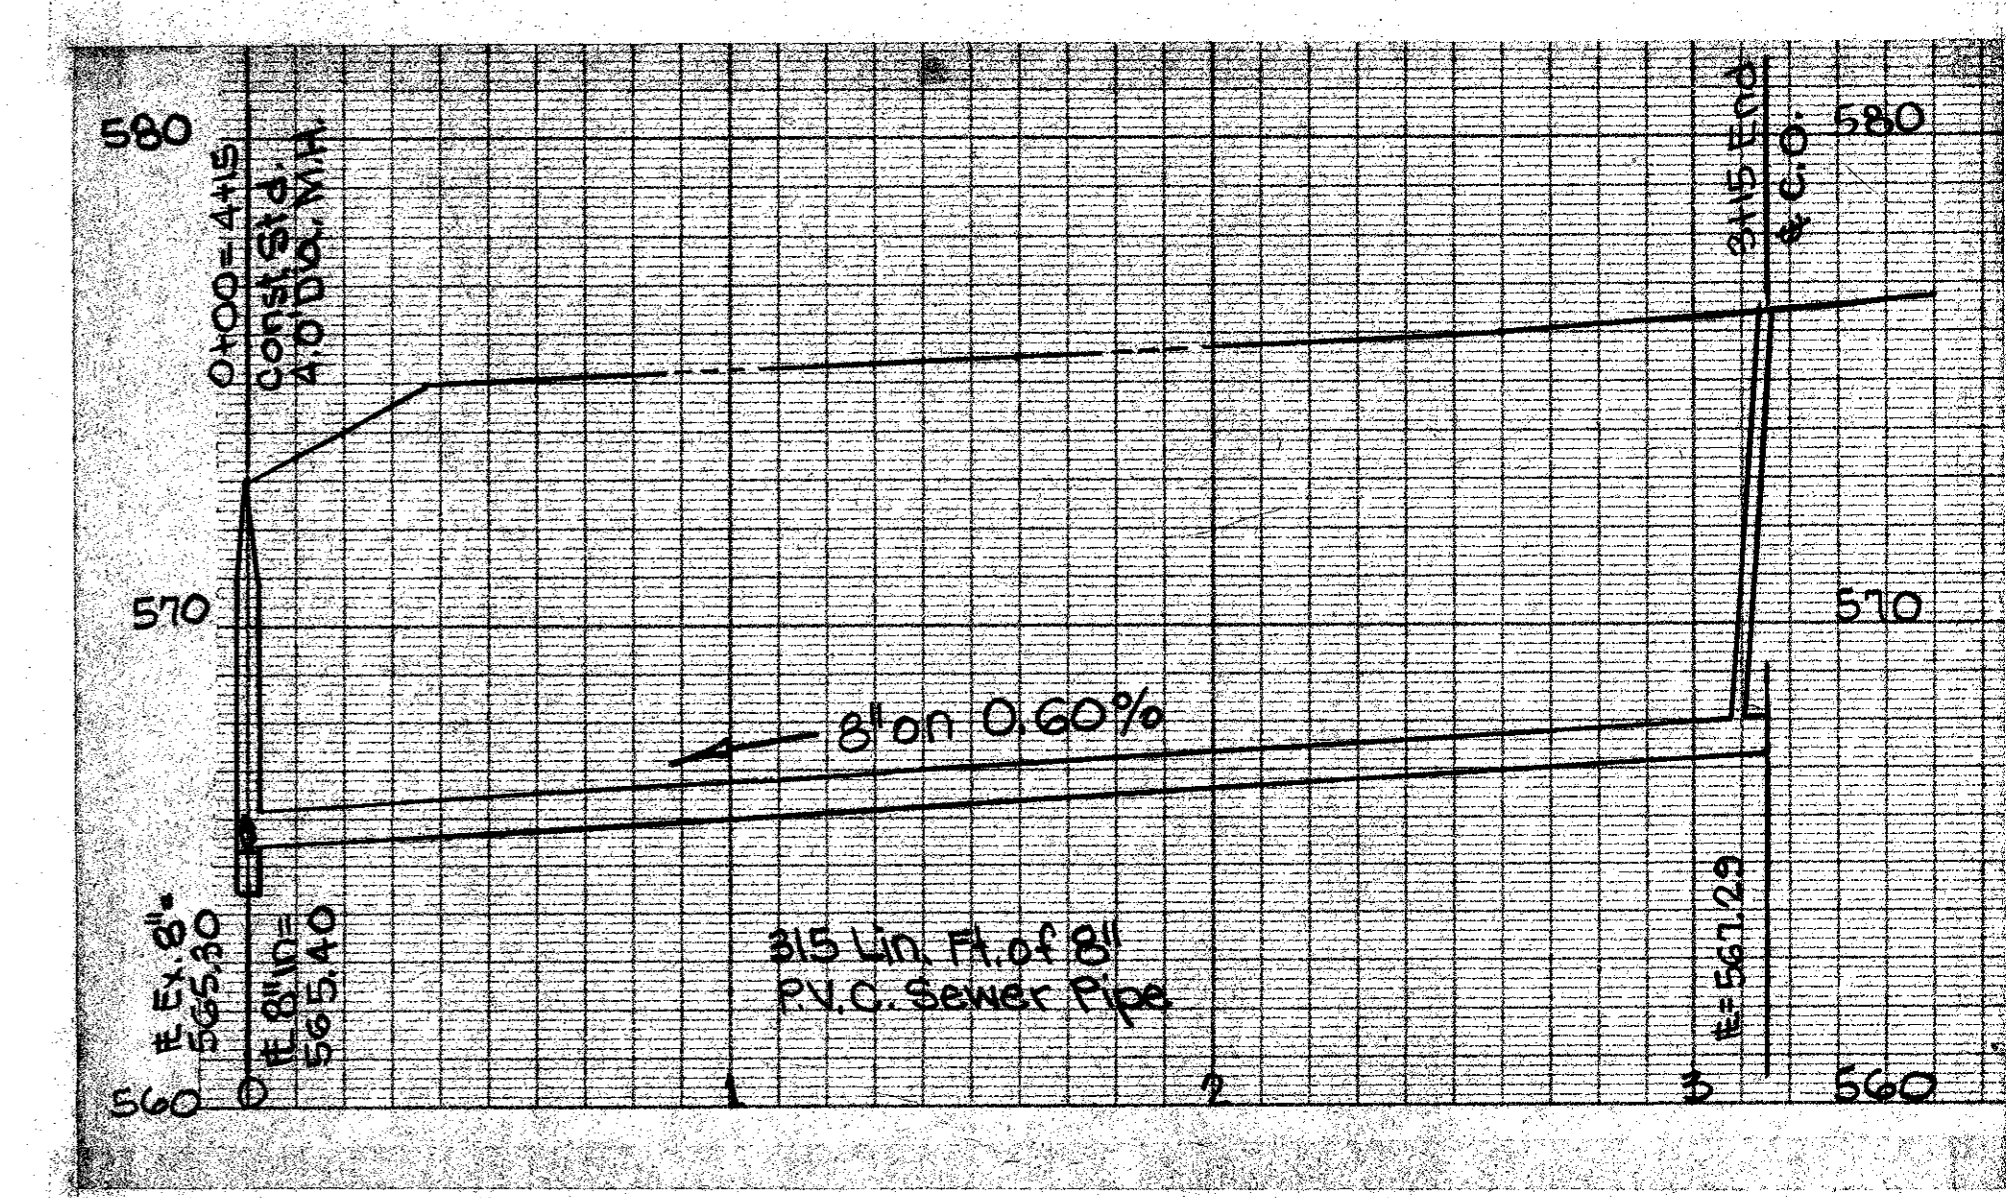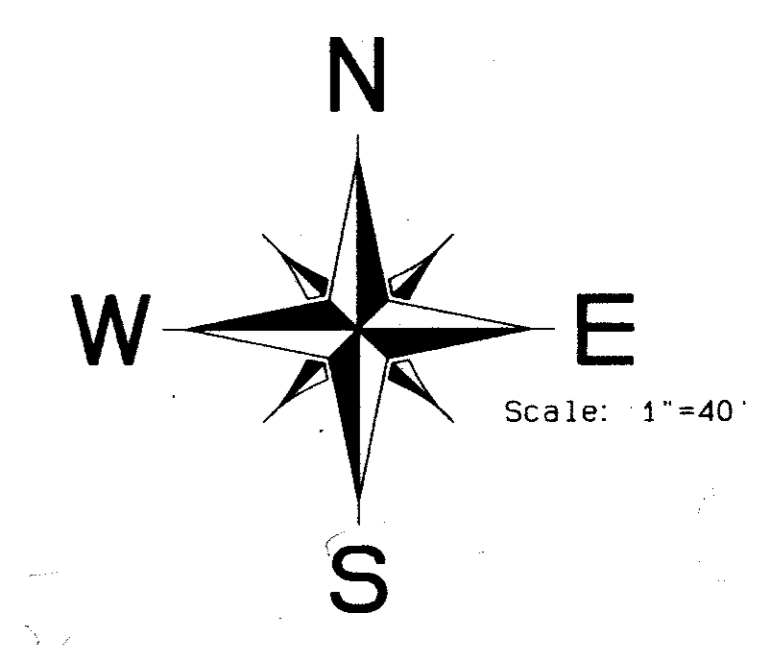


USE RESTRAINT TYPE FLANGES ON ALL HYDRANTS
 LOWERED EXIST. S.H.H.
 LOCATE EXIST. 4" SANI. LATERALS
 CUT INSTALL 4" RUBBER CAP, CONCRETE.


2" PIPS ARE 1.5' apart FROM 8" VALVE

WATER AND SANITARY SEWER MAINS
BROOKHAVEN VILLAGE SHOPPING CENTER


NOAH GOOD SURVEY, ABSTRACT NO. 520
 DALLAS COUNTY, TEXAS
 ADDISON, TEXAS
 FERGUSON-DEERE, INC. * ENGINEERS
 9817 KINGSLEY ROAD - DALLAS, TEXAS 75238
 JUNE, 1998 - SCALE: 1"=40'

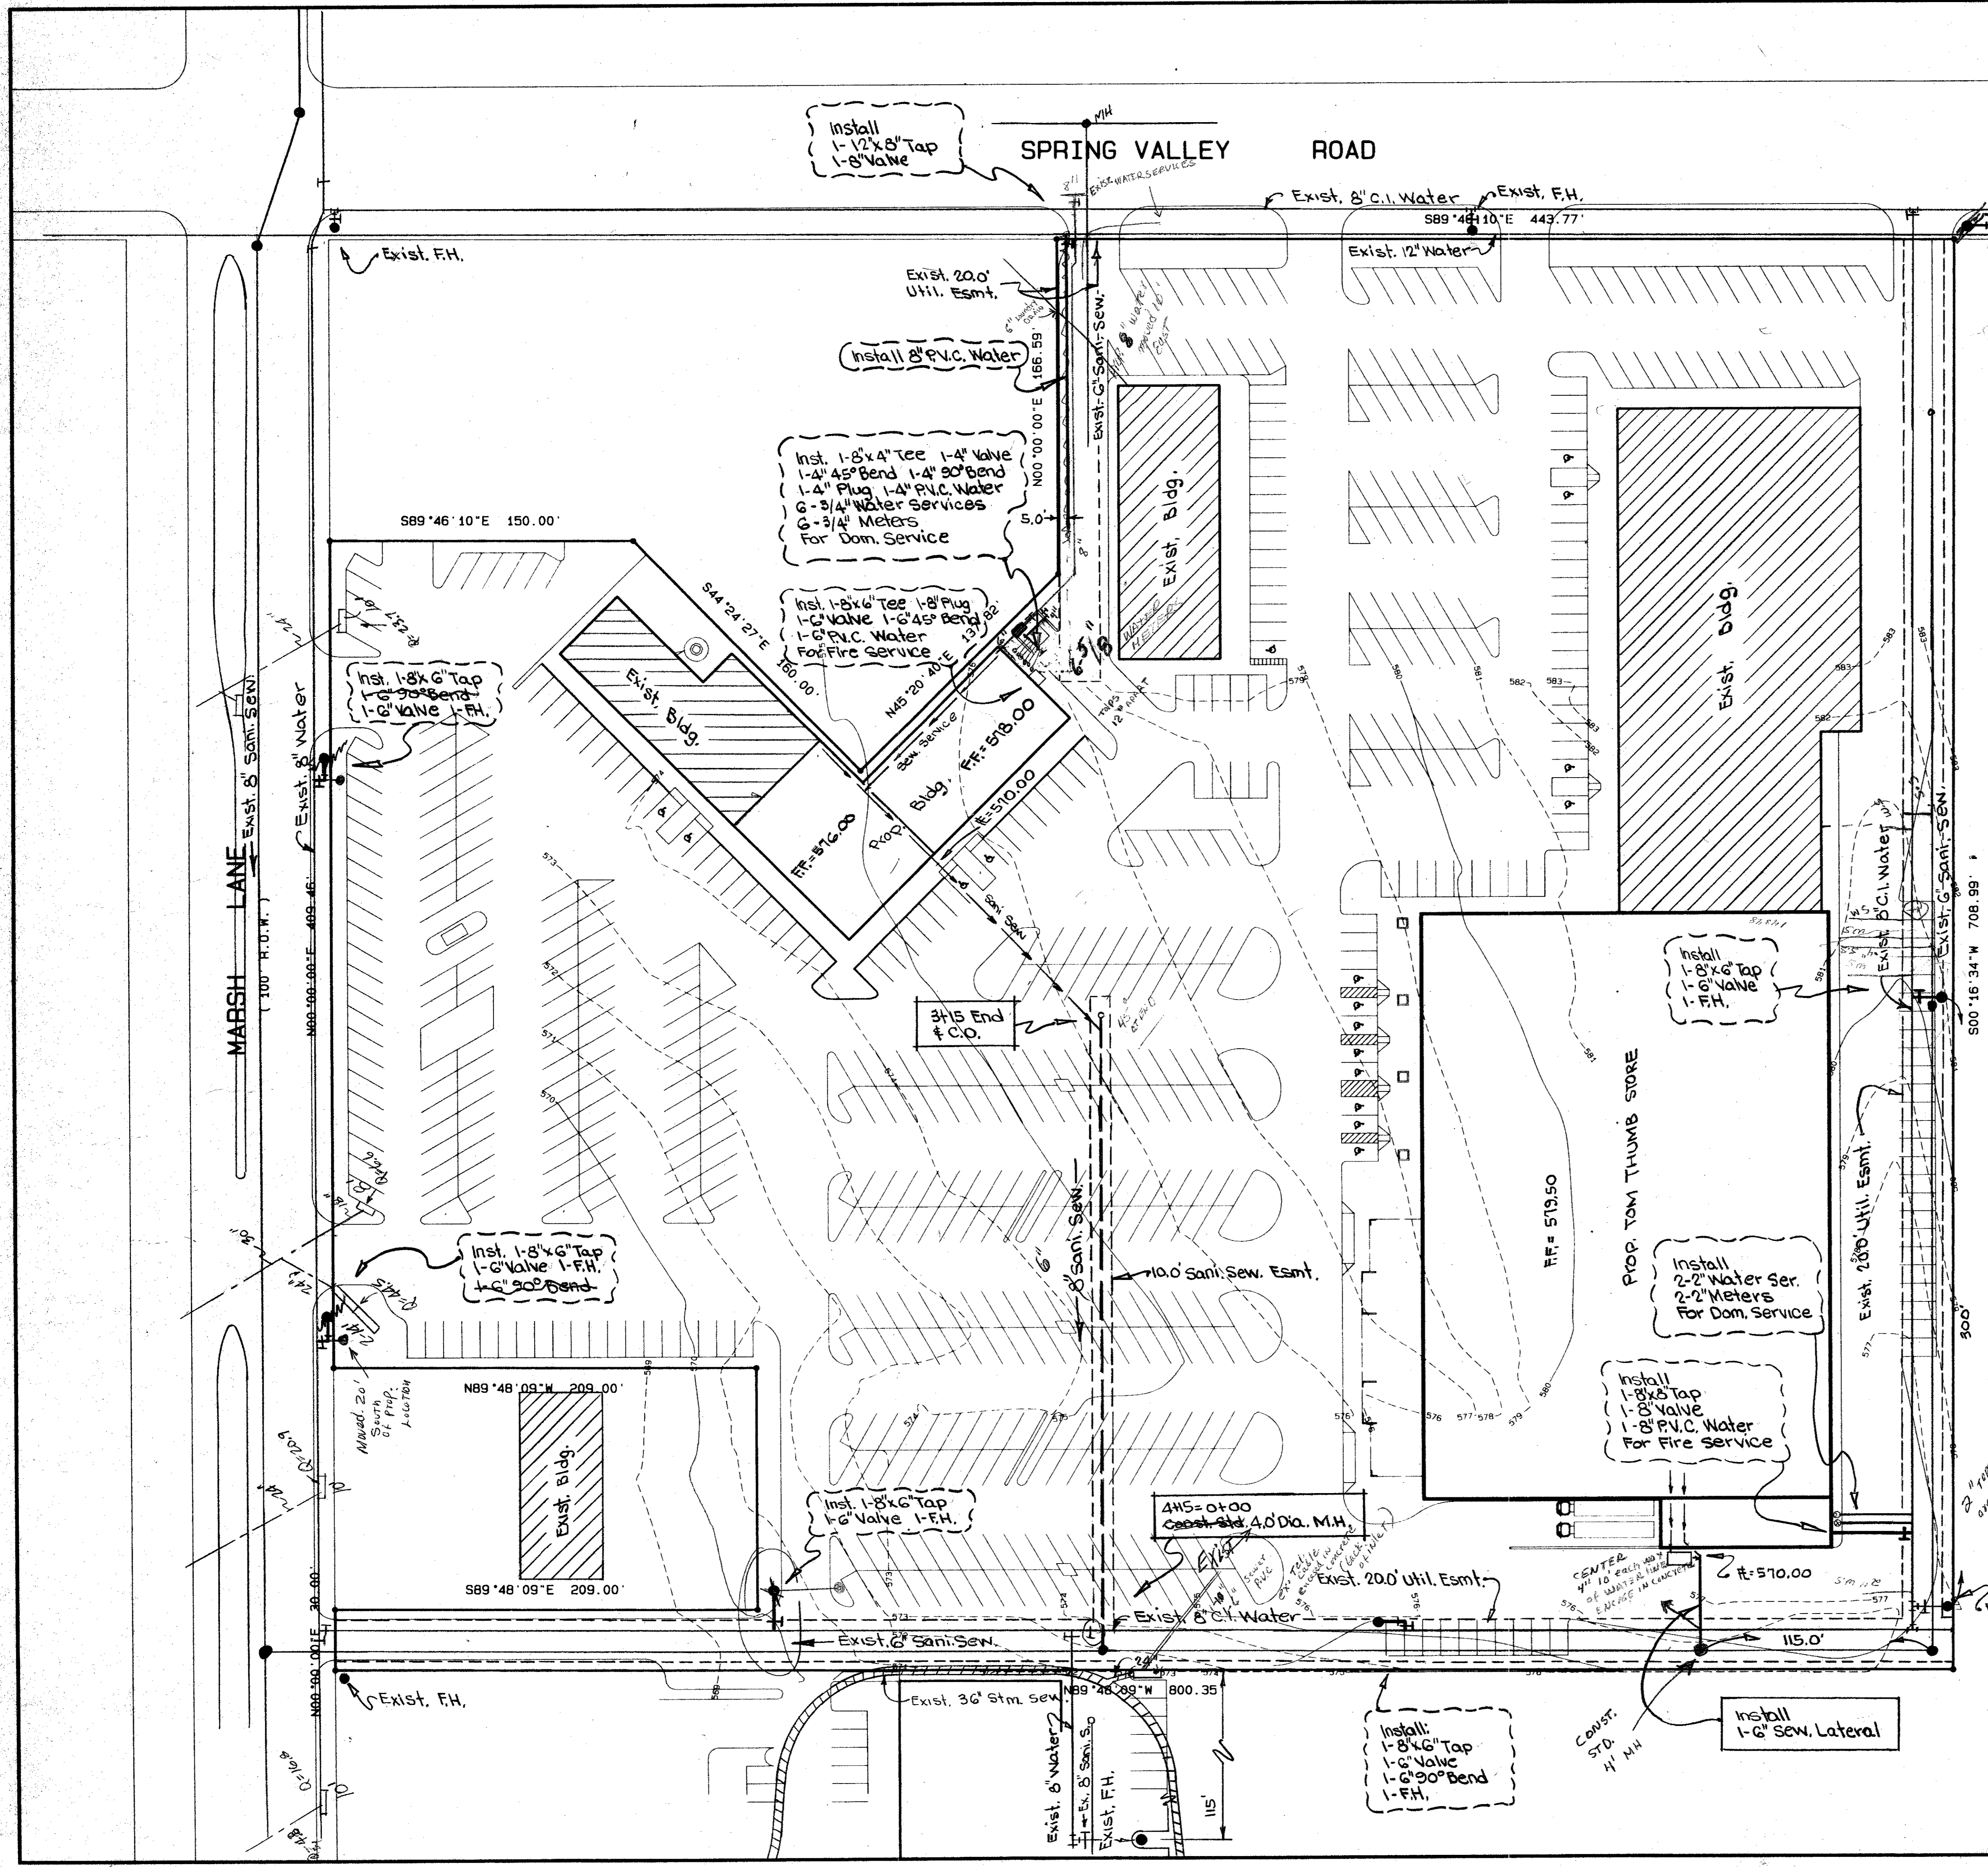

SPRING VALLEY ROAD

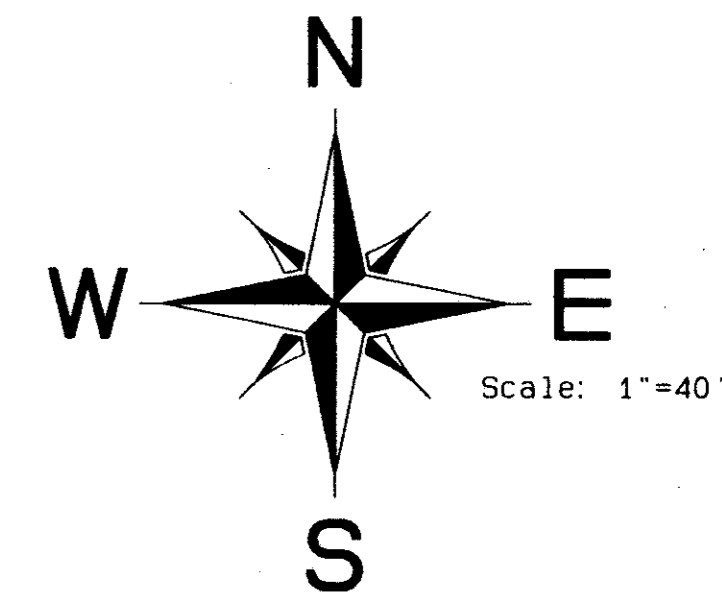

MARSH LANE
(100' R.O.M.)

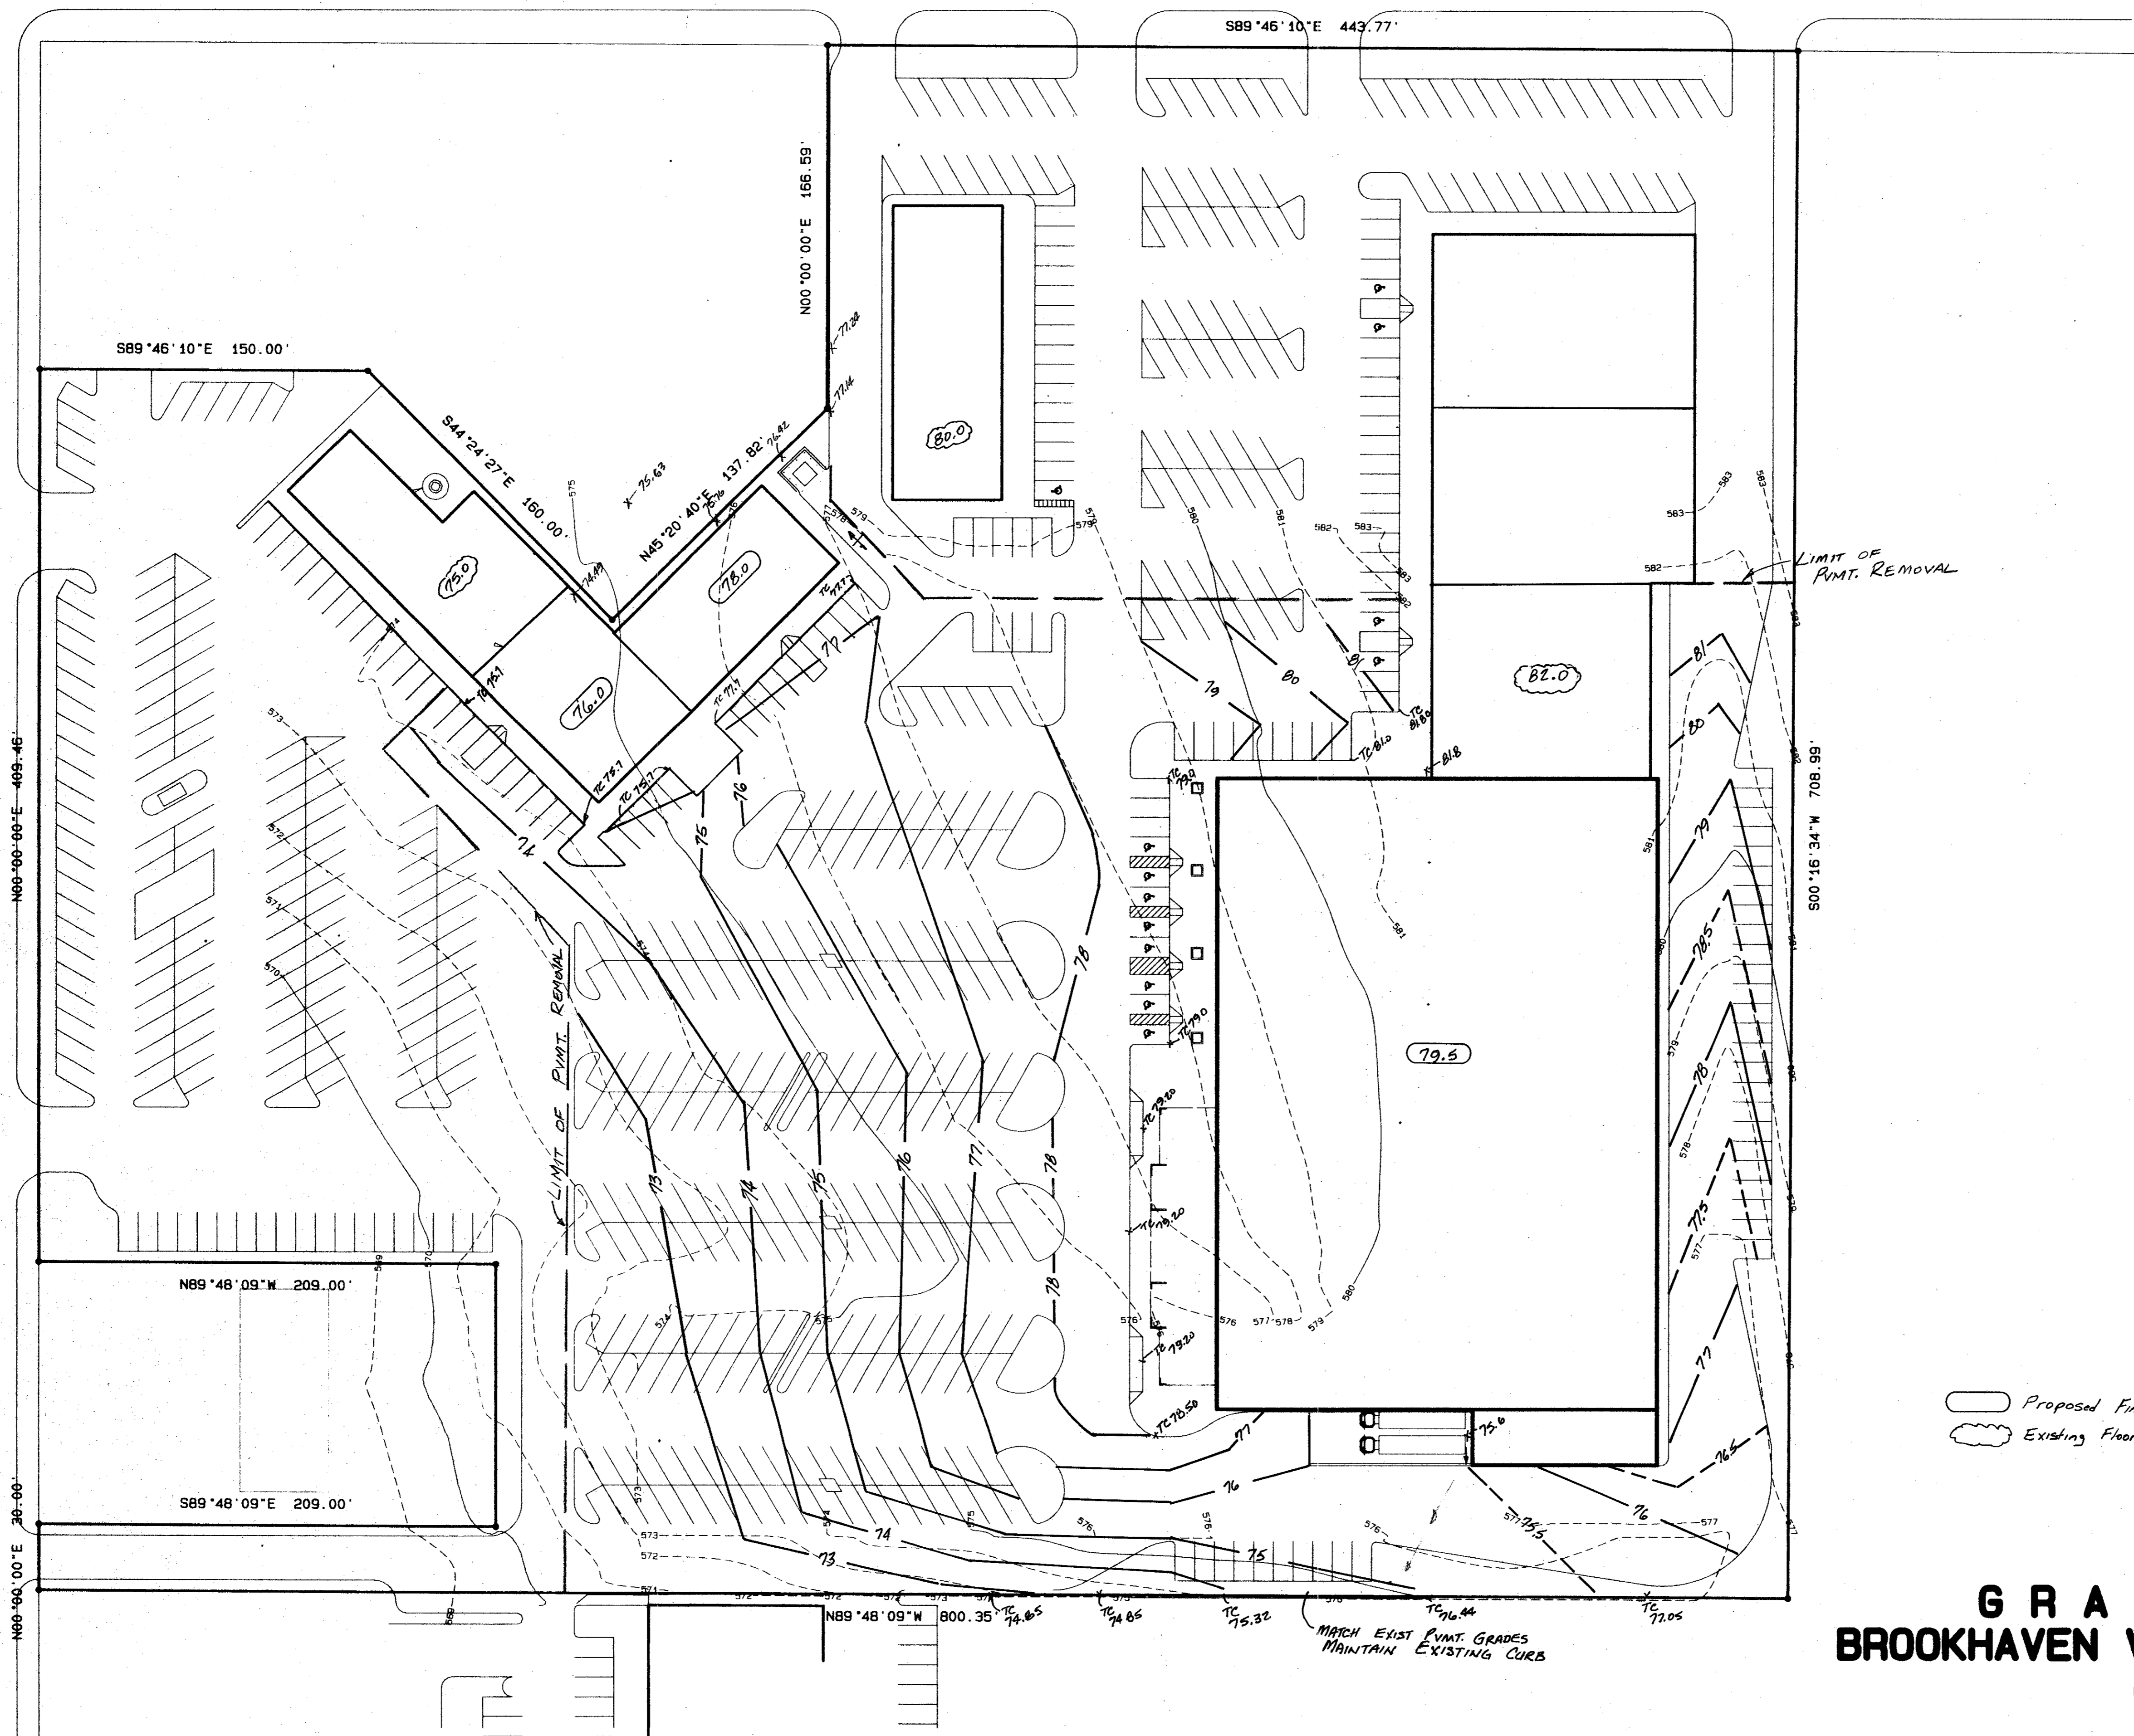

Proposed Finish Floor
Existing Floor Elev.

GRADING PLAN BROOKHAVEN VILLAGE SHOPPING CENTER

NOAH GOOD SURVEY, ABSTRACT NO. 520
DALLAS COUNTY, TEXAS
ADDISON, TEXAS
FERGUSON-DEERE, INC. * ENGINEERS
9817 KINGSLEY ROAD - DALLAS, TEXAS 75238
JUNE, 1998 - SCALE: 1"=40'

Rev 7/31/98