


PLOT PLAN, GRADING & UTILITY PLAN

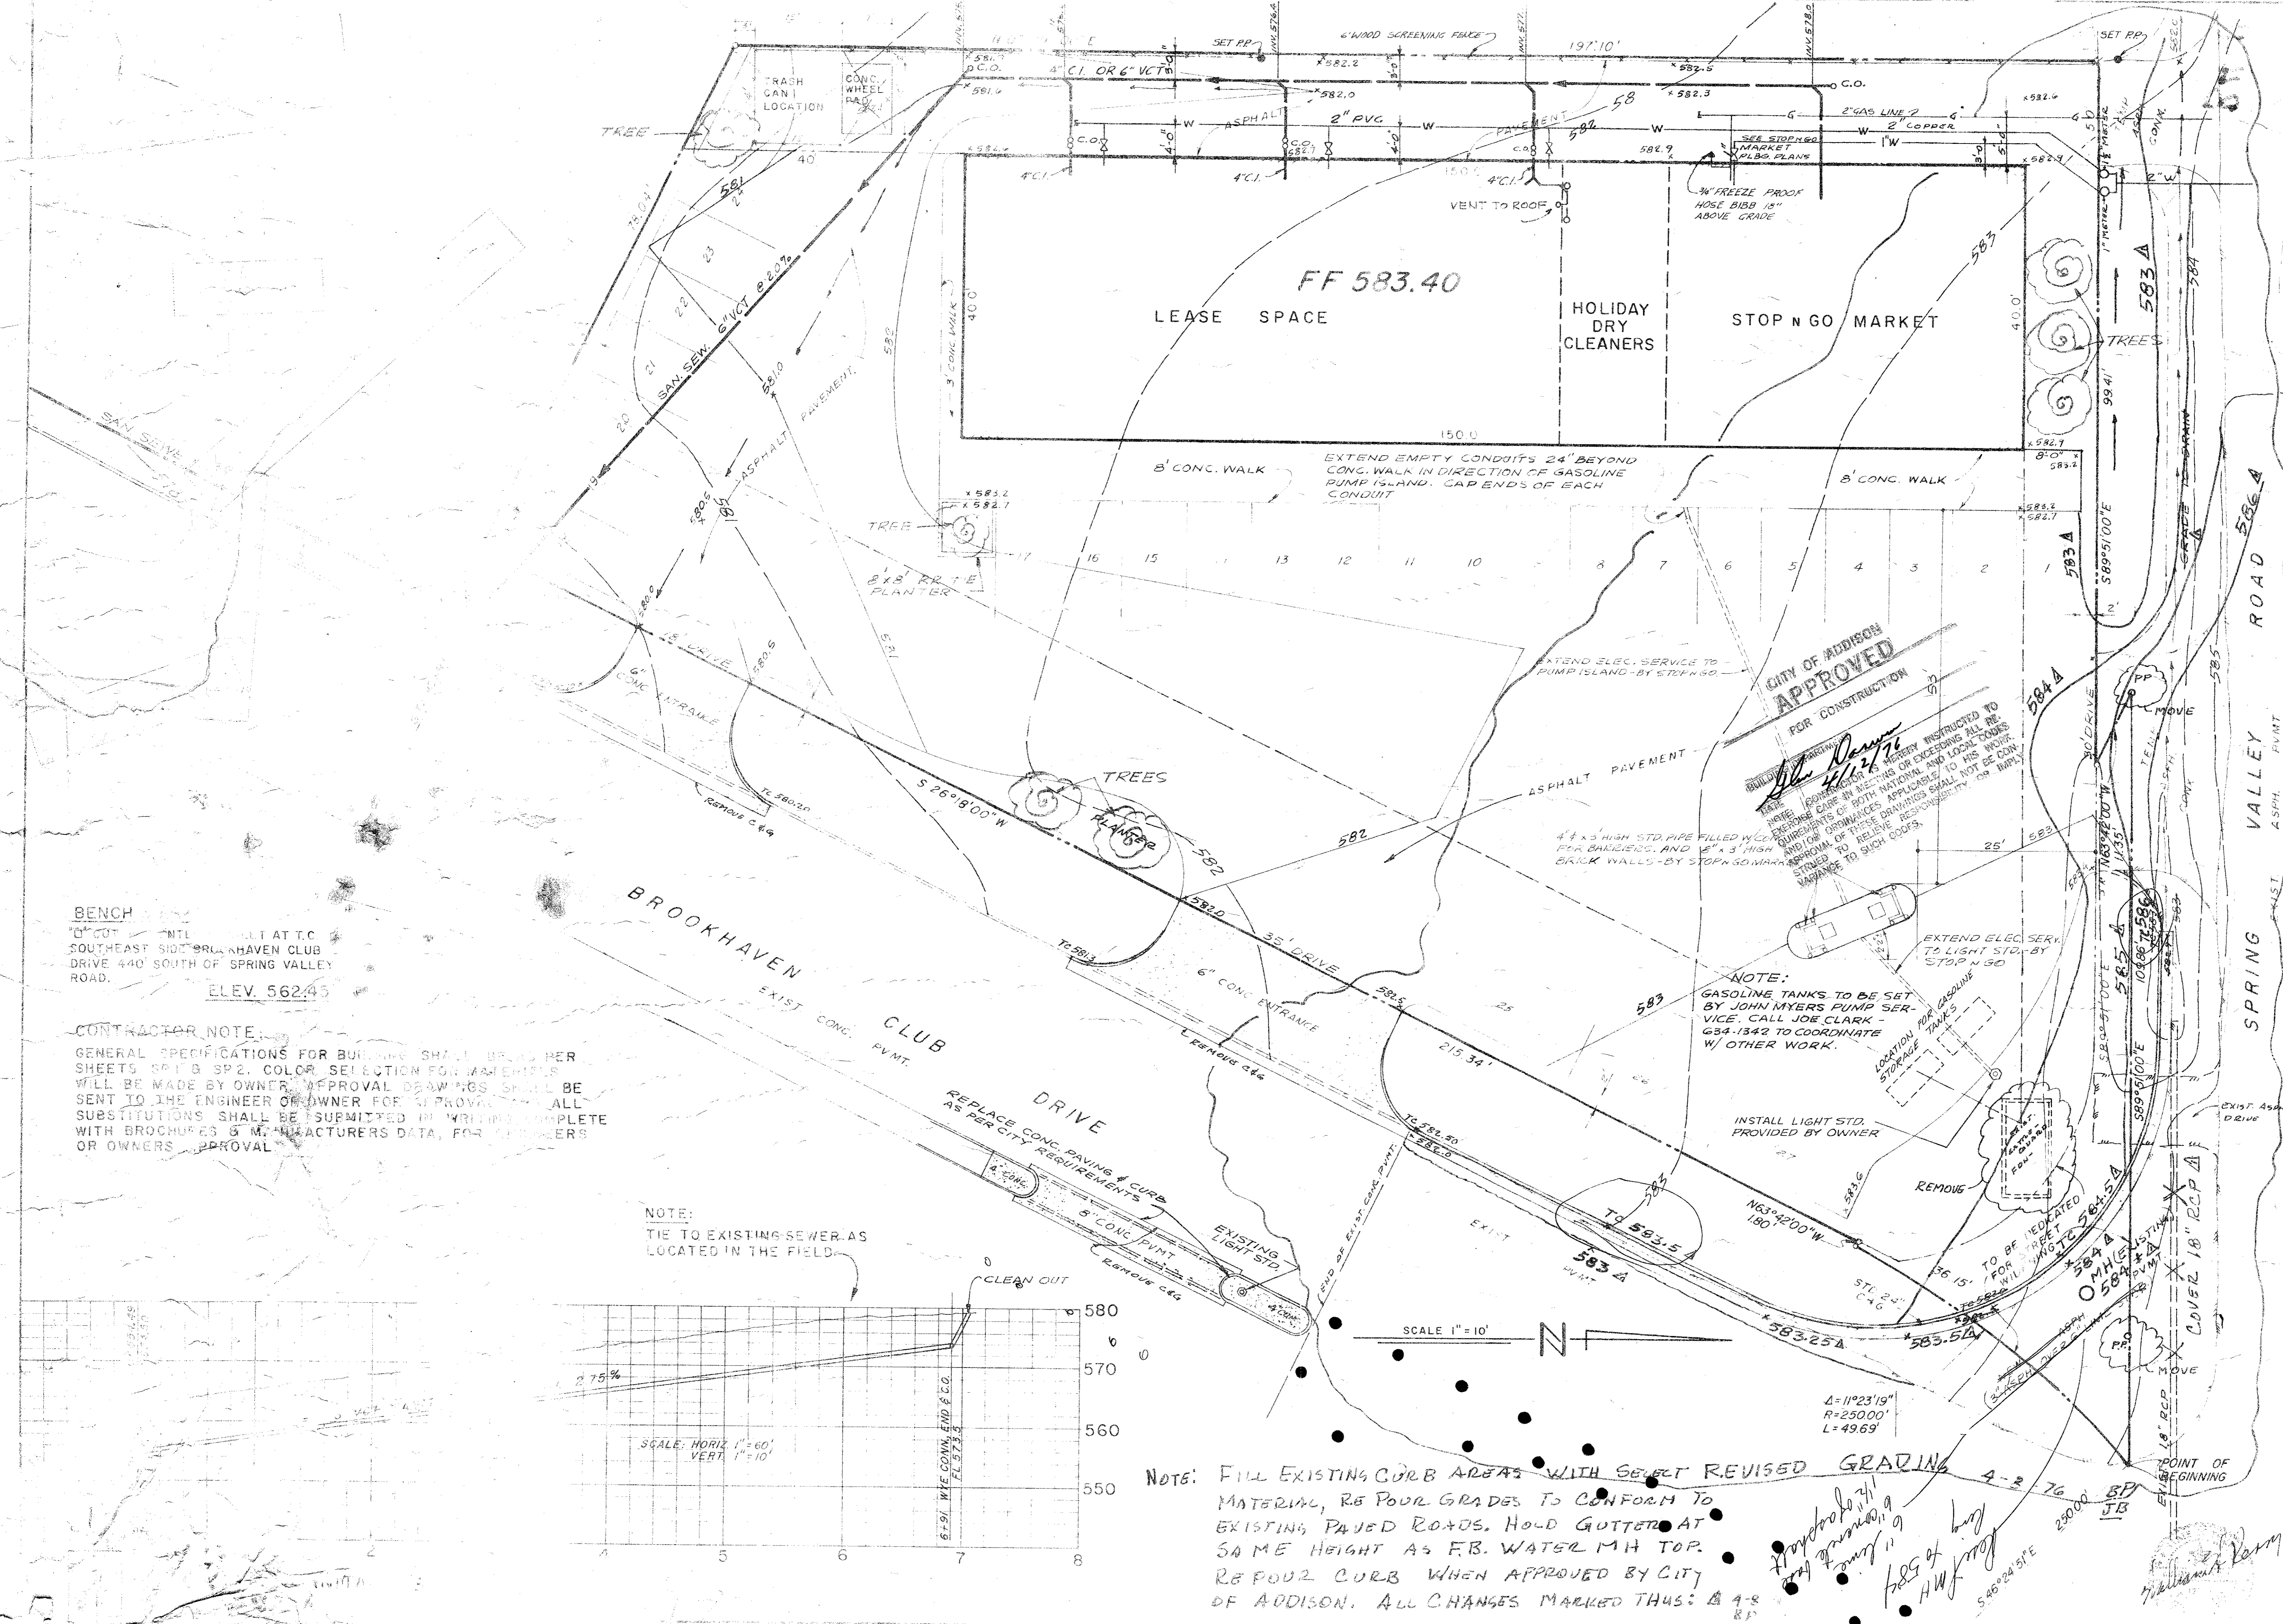

BENCH
 10' CONCRETE PILE AT T.C.
 SOUTHEAST SIDE BROOKHAVEN CLUB
 DRIVE 440' SOUTH OF SPRING VALLEY
 ROAD.
 ELEV. 562.45

CONTRACTOR NOTE:
 GENERAL SPECIFICATIONS FOR BUILDING SHALL BE AS PER SHEETS SP1 & SP2. COLOR SELECTION FOR MATERIALS WILL BE MADE BY OWNER. APPROVAL DRAWINGS SHALL BE SENT TO THE ENGINEER OR OWNER FOR APPROVAL. ALL SUBSTITUTIONS SHALL BE SUBMITTED IN WRITING COMPLETE WITH BROCHURES & MANUFACTURERS DATA, FOR ENGINEER OR OWNERS APPROVAL.

NOTE:
 TIE TO EXISTING SEWER AS LOCATED IN THE FIELD.

NOTE: FILL EXISTING CURB AREAS WITH SELECT REVISED GRADING MATERIAL, RE POUR GRADES TO CONFORM TO EXISTING PAVED ROADS. HOLD GUTTER AT SAME HEIGHT AS F.B. WATER M/T TOP. RE POUR CURB WHEN APPROVED BY CITY OF ADDISON. ALL CHANGES MARKED THUS: Δ

4-8-74 B.P.	7-7-75 B.P.
11-15-75 B.P.	
REVISIONS:	
DRAWN BY	7-23-75
DATE	OF
SHEET	1/6
JOB No	75-15