

TOWN OF ADDISON, TEXAS
 CHEMICAL ANALYZER HOUSE
 ADDISON, TEXAS

issue dates




drawn: rwm
 checked: mdg
 project #: 2009-070
 date: 08MAR10
 scale: 1/8" = 1'-0"


cover sheet/
 architectural site plan

A1.00

INDEX TO DRAWINGS	
ISSUES	SHEET NO.
08mar2010 ISSUE FOR BID AND CONSTRUCTION	
ARCHITECTURAL	
■ A1.00	cover sheet/ architectural site plan
■ A1.01	floor plan, elevations & section details
MECHANICAL	
■ M0.01	floor plan/ site plan mechanical
ELECTRICAL	
■ E0.01	floor plan/ site plan electrical
■ E0.02	electrical symbol legend and specs

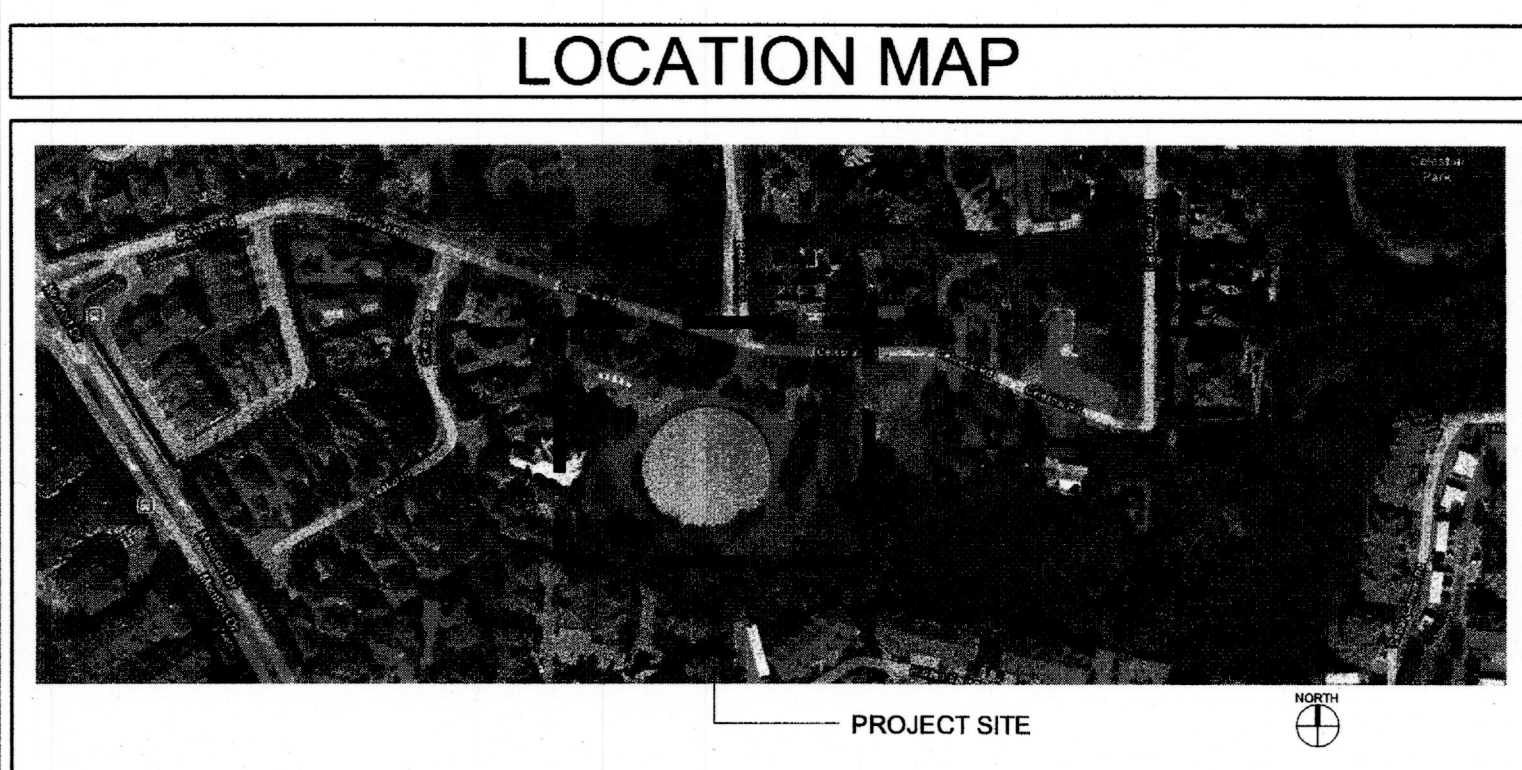

SITE PLAN SUMMARY	
Jurisdiction/ City:	Town of Addison, TX
Applicable Building Codes:	2006 International Building Code with Amendments 2006 International Mechanical Code with Amendments 2006 International Plumbing Code with Amendments 2006 National Electrical Code with Amendments 2006 International Fire Code with Amendments 2006 International Energy Code with Amendments 2006 International Fuel & Gas Code with Amendments
Category of Work (Scope):	New Construction
Proposed Use:	Chemical Analyzer Building
Zoning Category:	(P) Parks
Use and Occupancy Classification:	Group U - Utility and Miscellaneous (Shed)
Type of Construction:	Type IIB
Fire Protection System:	No
Area Calculations:	100 sf (Gross); 10' x 10' Building

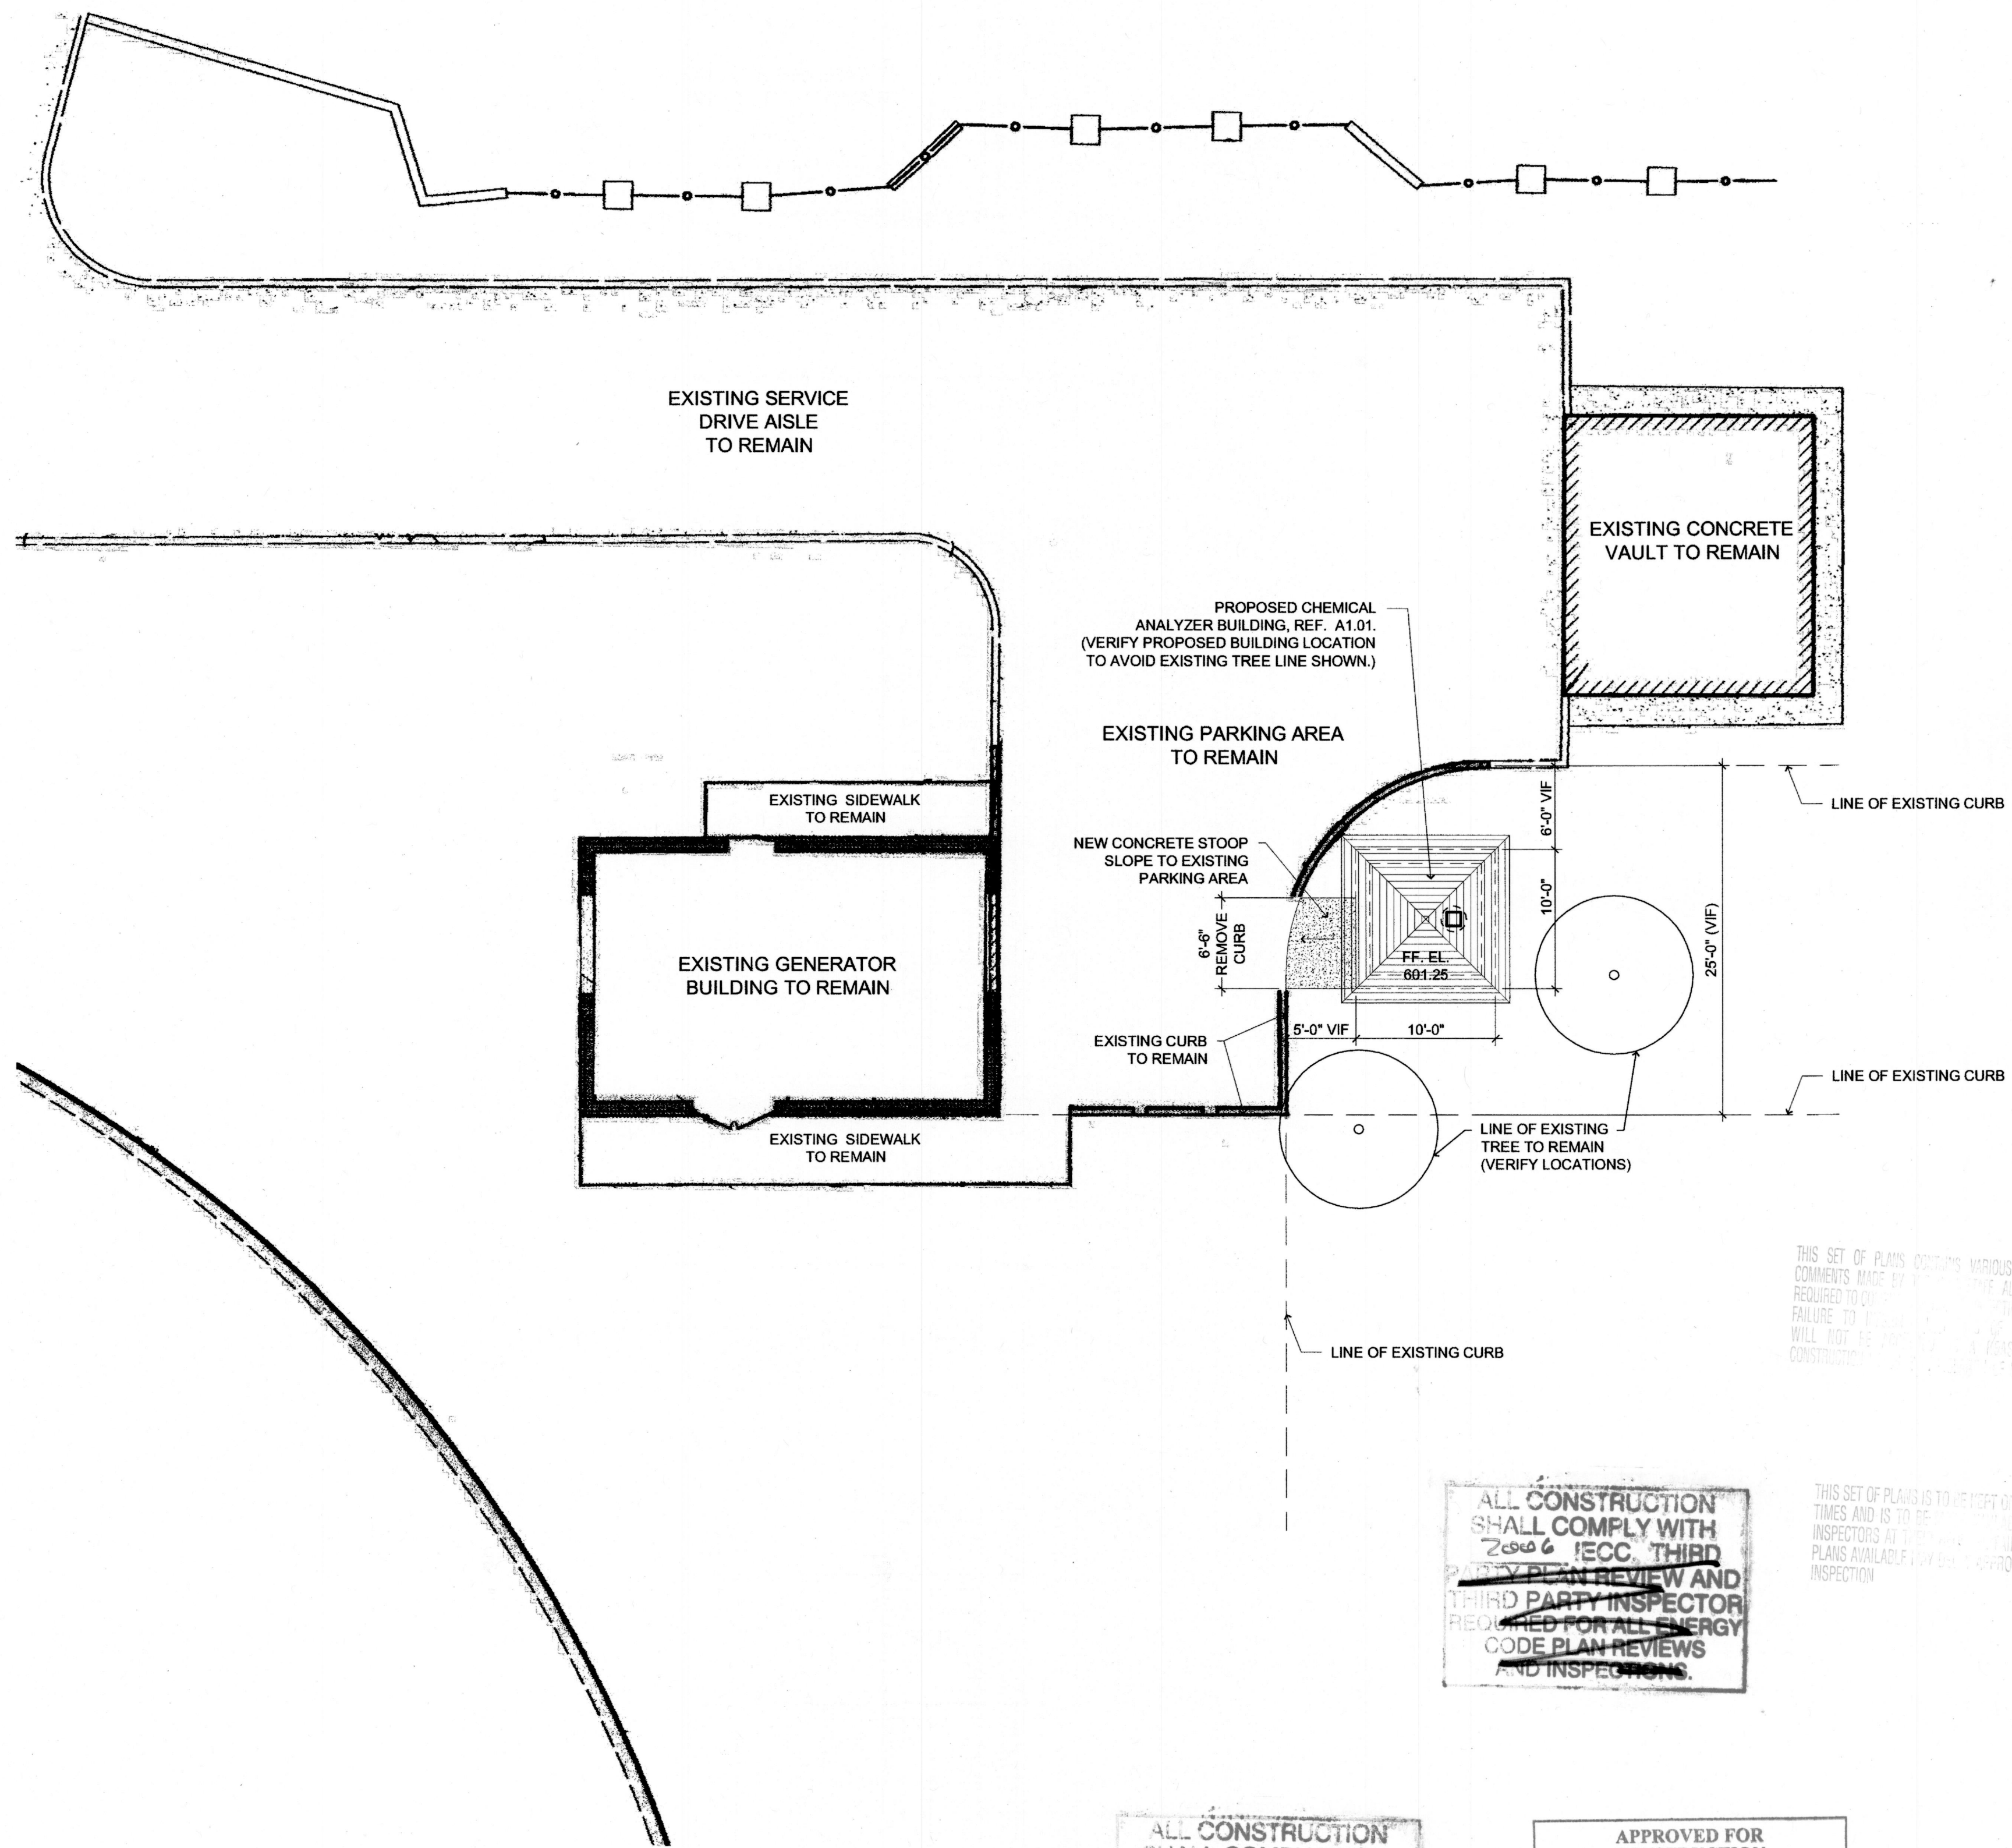

THIS SET OF PLANS CONTAINS VARIOUS CORRECTIONS AND COMMENTS MADE BY THE CITY OF ADDISON. ALL TRACES WILL BE REQUIRED TO CORRECT THESE COMMENTS AND COMMENTS FAILURE TO DO SO WILL BE CONSIDERED AS A PERSON TO APPROVE CONSTRUCTION WITHOUT THE NECESSARY PERMITS.

THIS SET OF PLANS IS TO BE KEPT BY THE JOB SITE AT ALL TIMES AND AS TO BE AVAILABLE FOR USE BY CITY INSPECTORS AT ANY TIME. FAILURE TO HAVE THESE PLANS AVAILABLE MAY BE CAUSE FOR APPROVAL OF A REQUESTED INSPECTION.

ALL CONSTRUCTION SHALL COMPLY WITH 2006 IECC, THIRD PARTY PLAN REVIEW AND THIRD PARTY INSPECTOR REQUIRED FOR ALL ENERGY CODE PLAN REVIEWS AND INSPECTIONS.

ALL CONSTRUCTION SHALL COMPLY WITH IECC, THIRD PARTY PLAN REVIEW AND THIRD PARTY INSPECTOR REQUIRED FOR ALL ENERGY CODE PLAN REVIEWS AND INSPECTIONS.

APPROVED FOR CONSTRUCTION
 Town of Addison
 Public Works Department
 APPROVED BY: CLAY BARNETT
 DATE: 8-19-2010

M:\2009\2009-070_TOWN OF ADDISON - CHEMICAL ANALYZER HOUSE\DC - DRAWINGS\SHEETS\2009-070_A1.00.DWG 3-24-2010 - 4:52:48 AM michael.gjh
 THIS DOCUMENT IS AN INSTRUMENT OF SERVICE FOR USE SOLELY WITH RESPECT TO THIS PROJECT. T. Howard + Associates, Inc. SHALL RETAIN ALL COMMON LAW, STATUTORY AND OTHER RESERVED RIGHTS, INCLUDING THE COPYRIGHT. THE CLIENT SHALL NOT REUSE, TRANSFER, OR SELL OR PERMIT THE REUSE, TRANSFER, OR SELL OF THIS DOCUMENT EXCEPT BY MUTUAL AGREEMENT IN WRITING. © COPYRIGHT 2009 T. Howard + Associates Architects, Inc.