

CONSTRUCTION PLANS FOR

# 6 MG CELESTIAL ROAD GROUND STORAGE TANK

**SHEET INDEX**

SHEET NO.	TITLE
1	SITE PLAN
2	PLAN AND SECTIONS
3	MISCELLANEOUS TANK DETAILS
4	MISCELLANEOUS TANK DETAILS
5	MISCELLANEOUS TANK DETAILS
6	BOX CULVERT PROFILE
7	TYPE "A" HEADWALL DETAILS
8	TYPE "B" HEADWALL DETAILS

**MAYOR:**  
JERRY REDDING


**CITY MANAGER:**  
RON WHITEHEAD

**COUNCIL MEMBERS:**  
STEWART BEATTY  
GREG COLE  
BARRY FINKELSTEIN  
RICHARD RODER  
LYNN SPRULL

PROJECT LOCATION

RECORD COPY

Appr ved by: Jerry Redding Date: 5-8-86  
Jerry Redding, Mayor of Addison

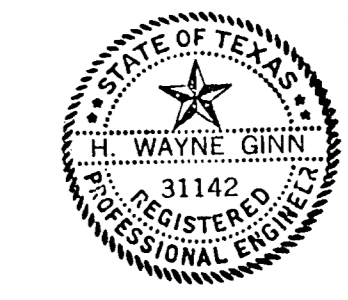

GINN, INC.  
Consulting Engineers Dallas, Texas