
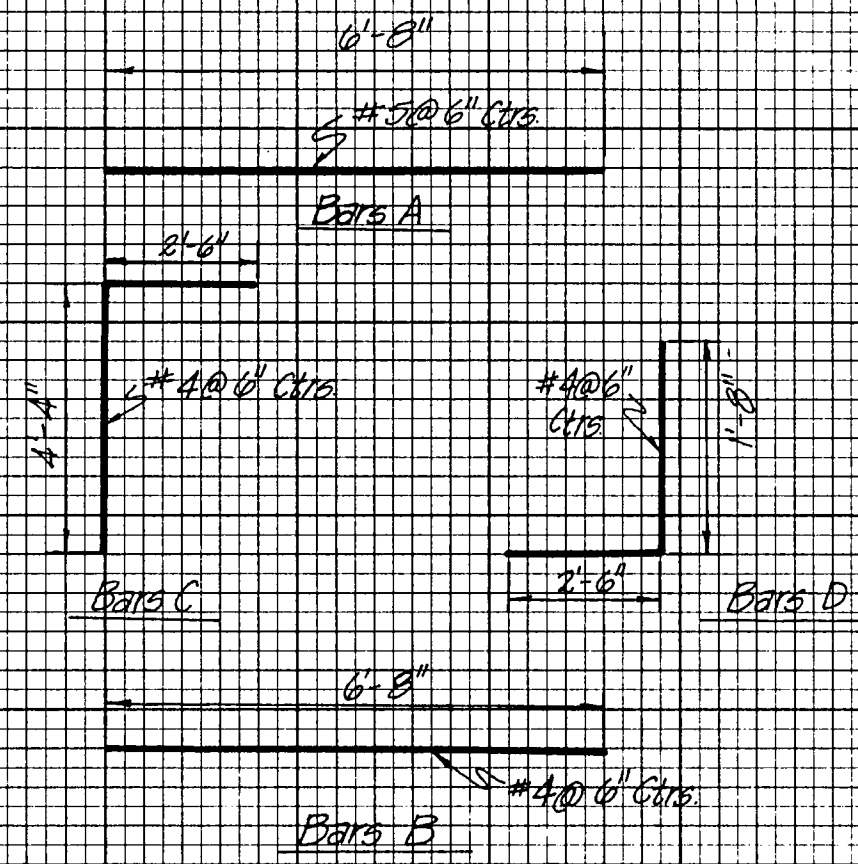


DATE _____
 BY _____
 SURVEYED _____
 PLOTTED _____
 FINAL SURVEY _____
 NOTE BOOK _____
 TEMPLATE _____
 NO. _____
 AREAS CHECKED _____

DATE _____
 BY _____
 SURVEYED _____
 PLOTTED _____
 ORIGINAL SURVEY _____
 NOTE BOOK _____
 AREAS CHECKED _____
 NO. _____

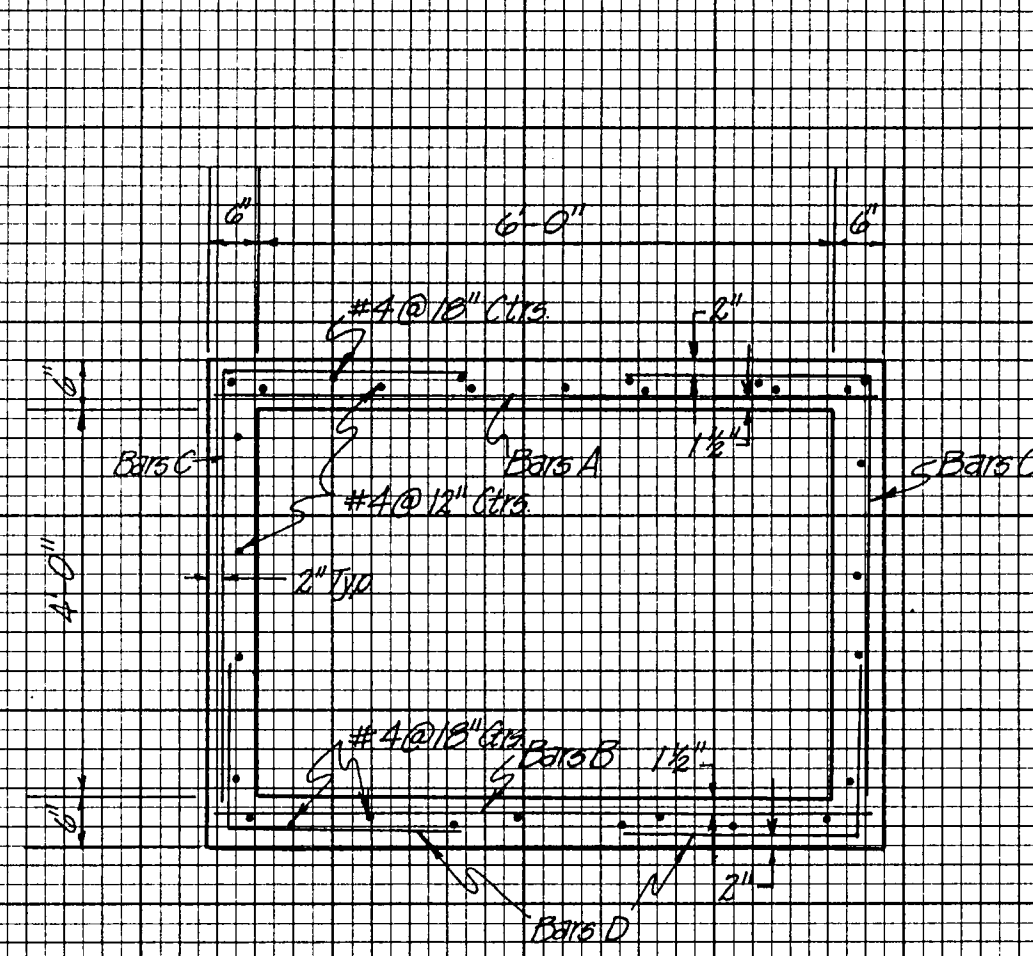

BAR DETAILS



NTS

Notes:

1. Concrete Box Culvert Construction shall conform to Section 03100 of the Contract Documents.
2. Dimensions Relating to Reinforcing Steel are to Centers of Bars.
3. Splices for Longitudinal Steel shall be 21" for #4 Bars.

6' x 4' CAST-IN-PLACE CULVERT


NTS

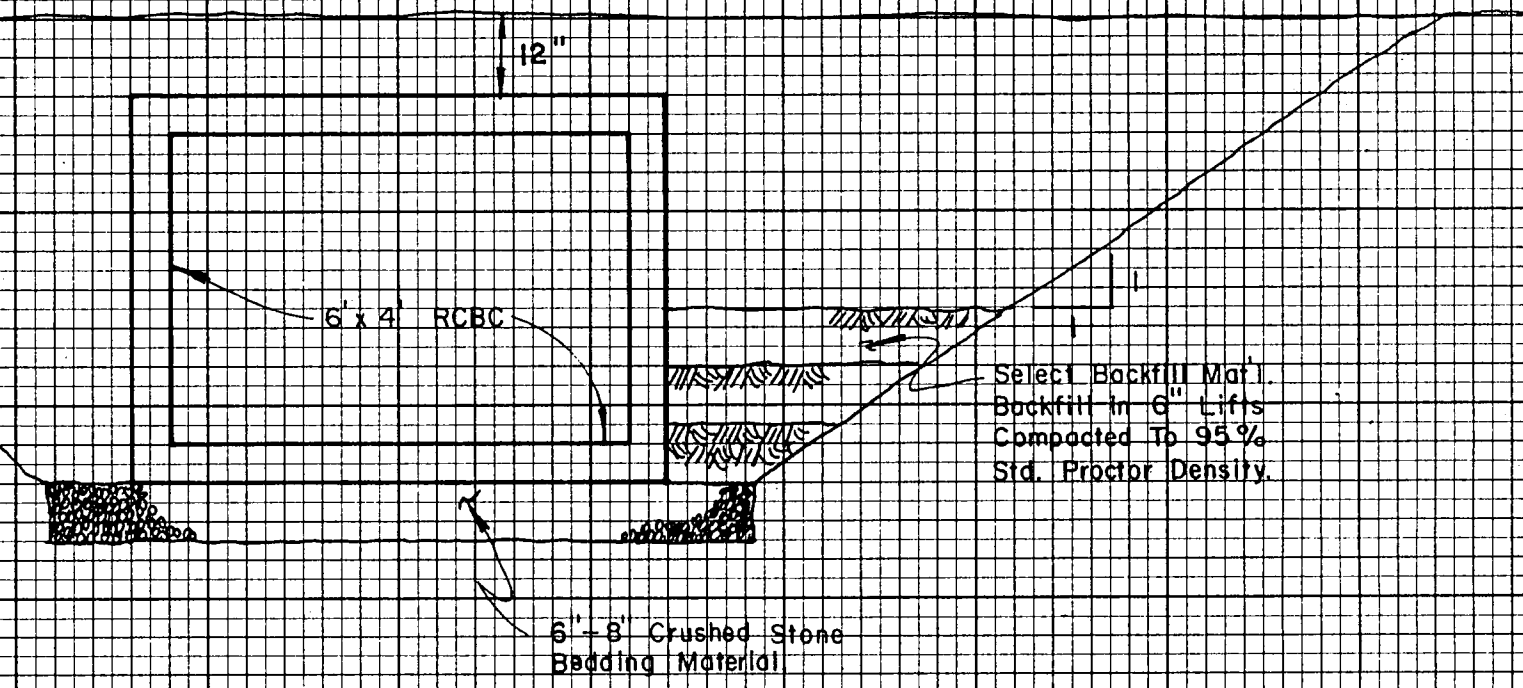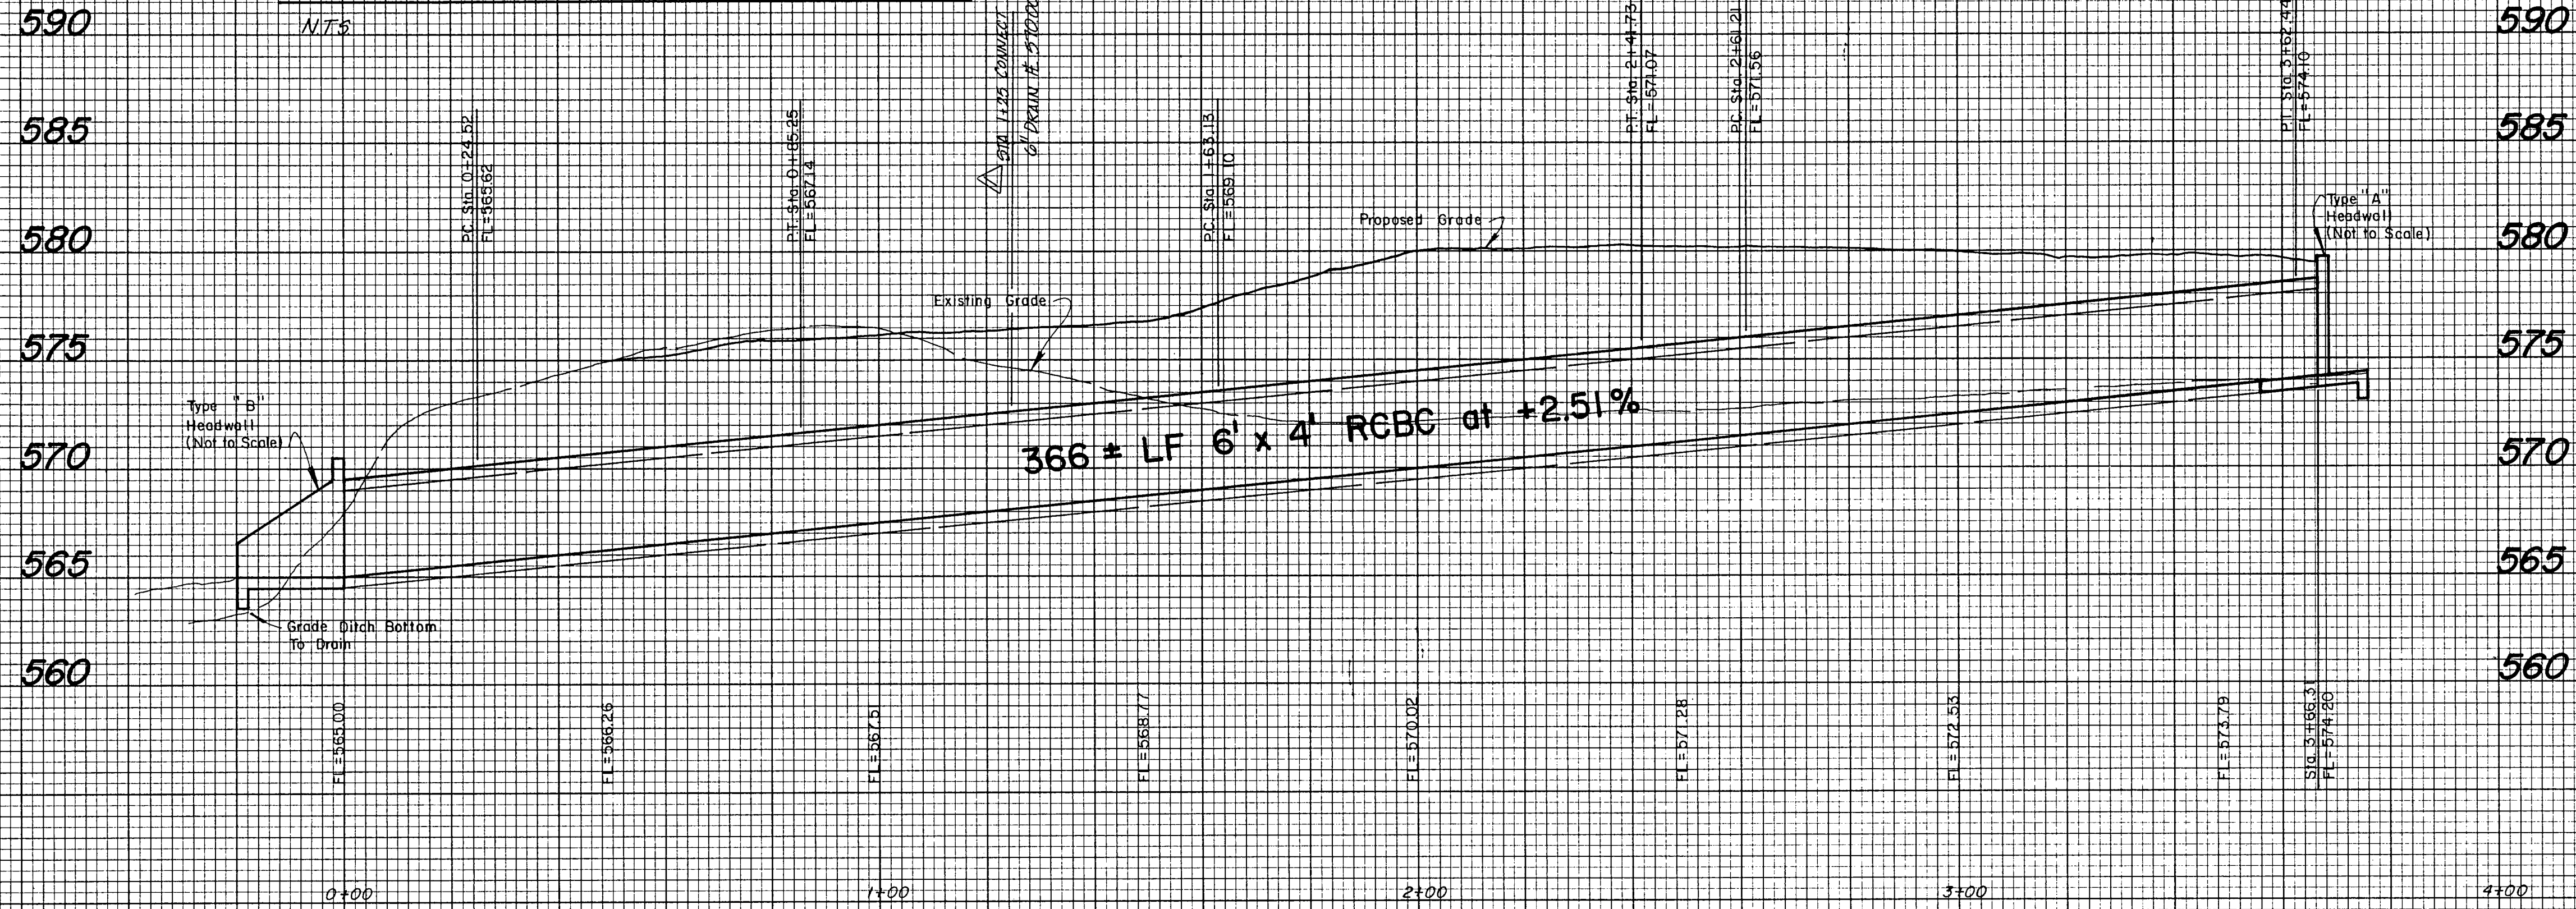

BACKFILL DETAIL

NTS

RECORD COPY

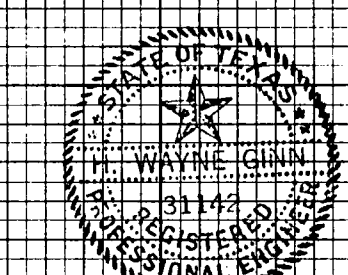

ADD 5' PVC CONNECTION		Revision	By	Date
TOWN OF ADDISON DALLAS COUNTY, TEXAS				
6 MG CELESTIAL ROAD STORAGE TANK				
BOX CULVERT PROFILE				
GINN, INC. Consulting Engineers Dallas, Texas				
Designed - RCH	Drawn - ALA	Date	Job No. - 215	
Approved - HWG	Checked - RCH	Scale - 1/8" = 1'-0"	Sheet 6	of 8