

ONE 6.0 MILLION GALLON WATER STORAGE TANK

CONTRACT NO. 86 PE 004 WITH

TOWN OF ADDISON,


COUNTY OF DALLAS, TEXAS

CONSULTING ENGINEERS:


GINN INC.

PRELOAD WORKING DRAWINGS

- TEXAS 83-007-1 GENERAL ARRANGEMENT
- TEXAS 83-007-2 TYPICAL TANK SECTION
- TEXAS 83-007-3 TEMPORARY MANHOLE PANEL AND WIREWINDING SCHEDULE
- TEXAS 83-007-4 FLOOR DETAILS
- TEXAS 83-007-5 OVERFLOW AND WEIR BOX DETAILS
- TEXAS 83-007-6 INLET AND OUTLET PIPE DETAILS
- TEXAS 83-007-7 LADDER DETAILS AND PANEL LAYOUT
- TEXAS 83-007-8 ROOF SLAB REINFORCING: LAYER NO. 1
- TEXAS 83-007-9 ROOF SLAB REINFORCING: LAYER NO. 2
- TEXAS 83-007-10 ROOF SLAB REINFORCING: LAYER NO. 3
- TEXAS 83-007-11 ROOF SLAB REINFORCING: LAYER NO. 4
- TEXAS 83-007-12 ROOF SECTIONS
- TEXAS 83-007-13 ODD AND OVERFLOW PANELS
- TEXAS 83-007-14 EXCAVATION DETAILS
- TEXAS 83-007-15 REBAR SCHEDULE

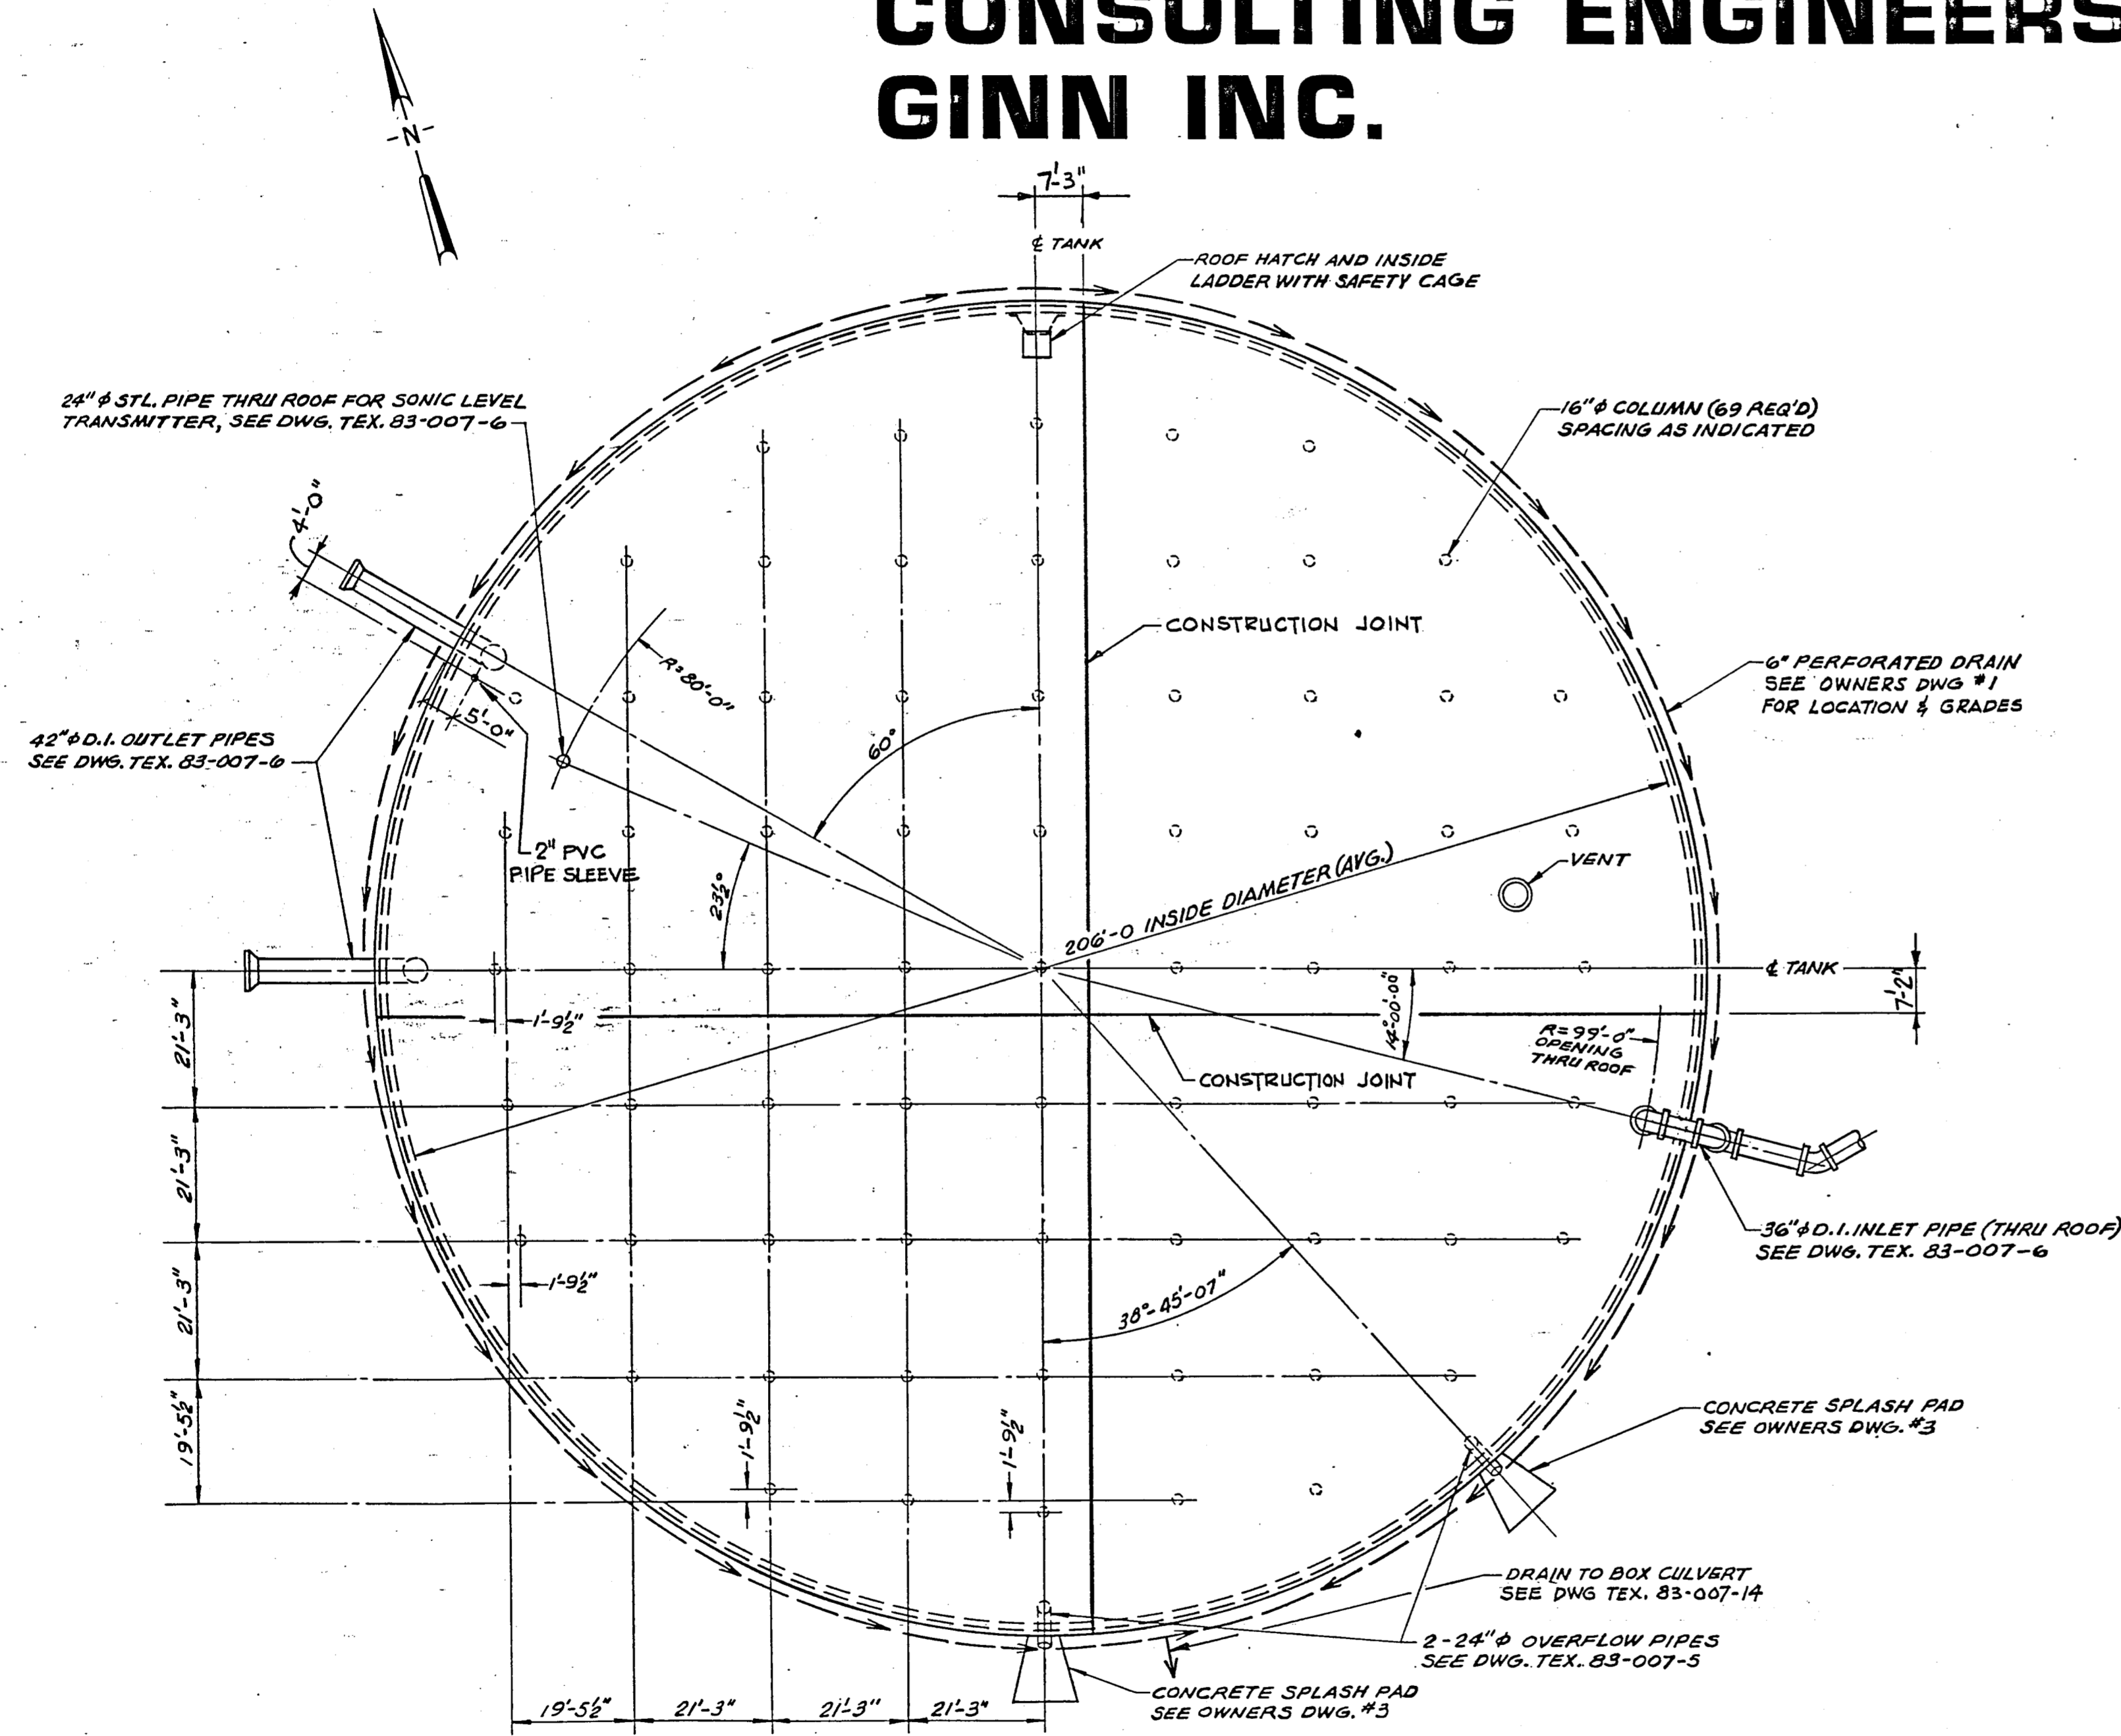

ROOF PLAN
SCALE: 1"=20'

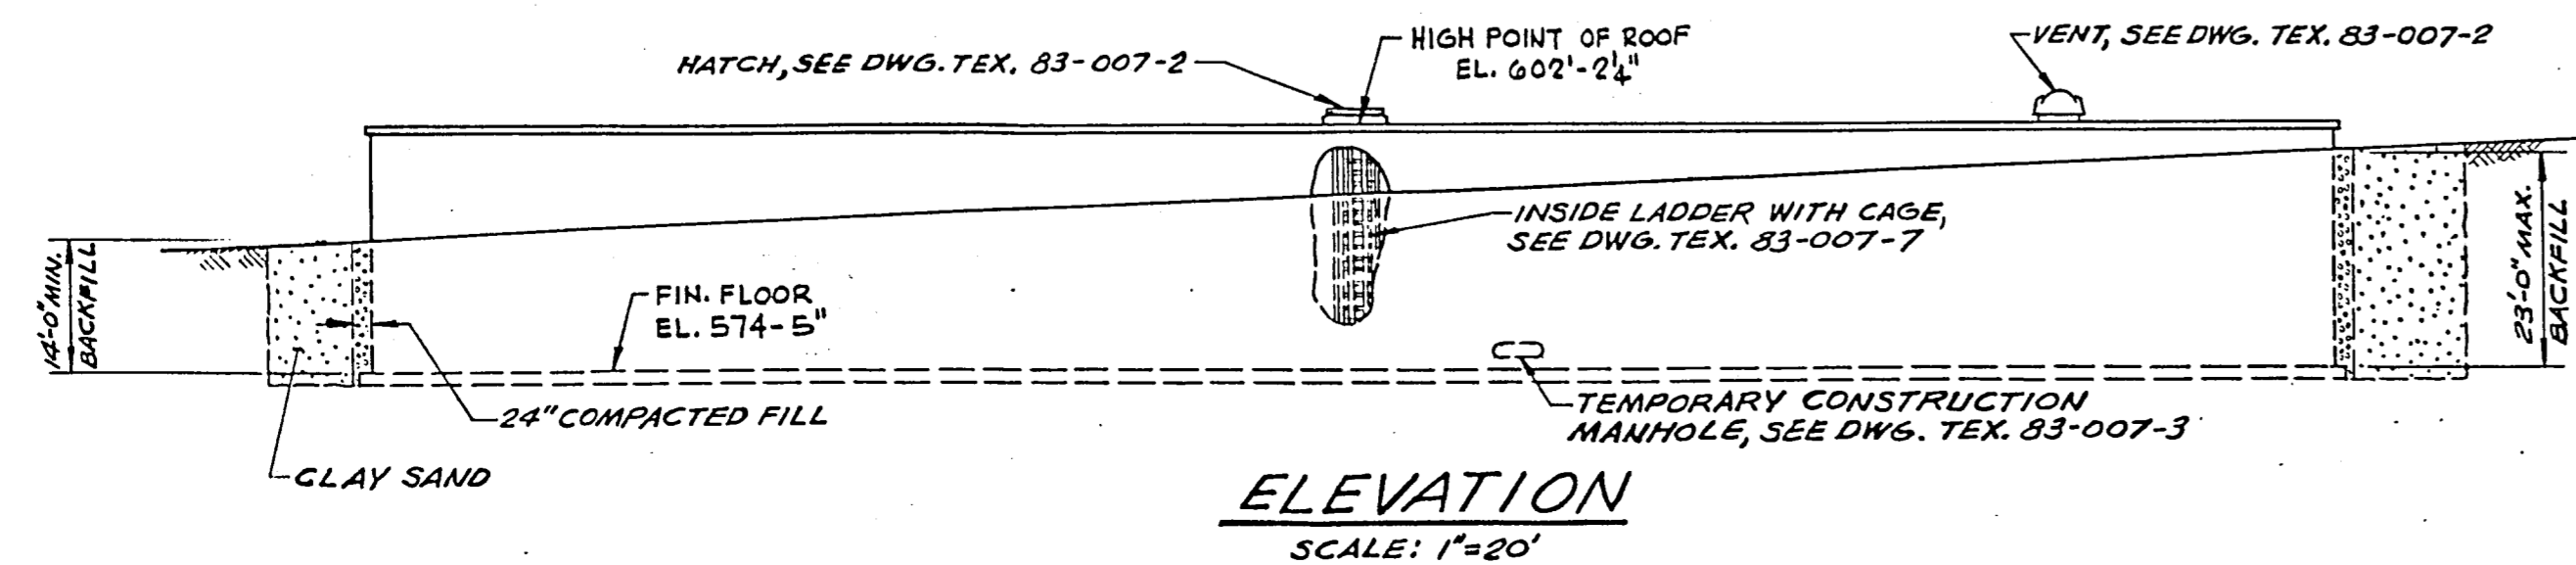

ELEVATION
SCALE: 1"=20'

THE DETAILS SHOWN ON THIS DRAWING SHALL BE PRODUCED WITHIN THE GUIDELINES AND REQUIREMENTS SPECIFIED IN PRELOAD CO. "CONSTRUCTION SPECIFICATIONS & PROCEDURES" - NO. "CS-28".

REVISIONS				
NO.	DATE	DESCRIPTION	BY	CKD
Δ	5/13/86	REV. PERF. DRAIN; ADDED ELEV.'S ON TANK ELEV.	E	RAO
A	4/13/87	AS BUILT	E	



839 STEWART AVENUE, GARDEN CITY, NEW YORK, 11530

THIS DRAWING IS THE PROPERTY OF THE PRELOAD COMPANY, INC. AND/OR PRELOAD TECHNOLOGY, INC. AND IS SUBJECT TO RETURN ON DEMAND. IT CONTAINS FEATURES OF DESIGN WHICH ARE FULLY COVERED BY PATENTS AND PATENTS PENDING AND COPYRIGHTS. IT IS SUBMITTED FOR USE ONLY IN CONNECTION WITH PROPOSALS OR CONTRACTS OF PRELOAD OR ITS LICENSEES, UPON THE EXPRESS CONDITION THAT IT MAY NOT BE USED ON ANY OTHER DIFFERENT PROJECTS WITHOUT PRIOR APPROVAL OF PRELOAD.

WORKING DRAWING			
ONE 6.0 M.G. WATER STORAGE TANK			
ADDISON, TEXAS			
GENERAL ARRANGEMENT			
DRAWN: PV	SCALE: AS NOTED	CONTRACT NUMBER: 86 PE 004	
DESIGNED: FD	APPROVED:	DRAWING NUMBER: TEX 83-007-1	
CHECKED: RAO	DATE: 4-24-86		