


EXCAVATION PLAN
SCALE: 1"=30'

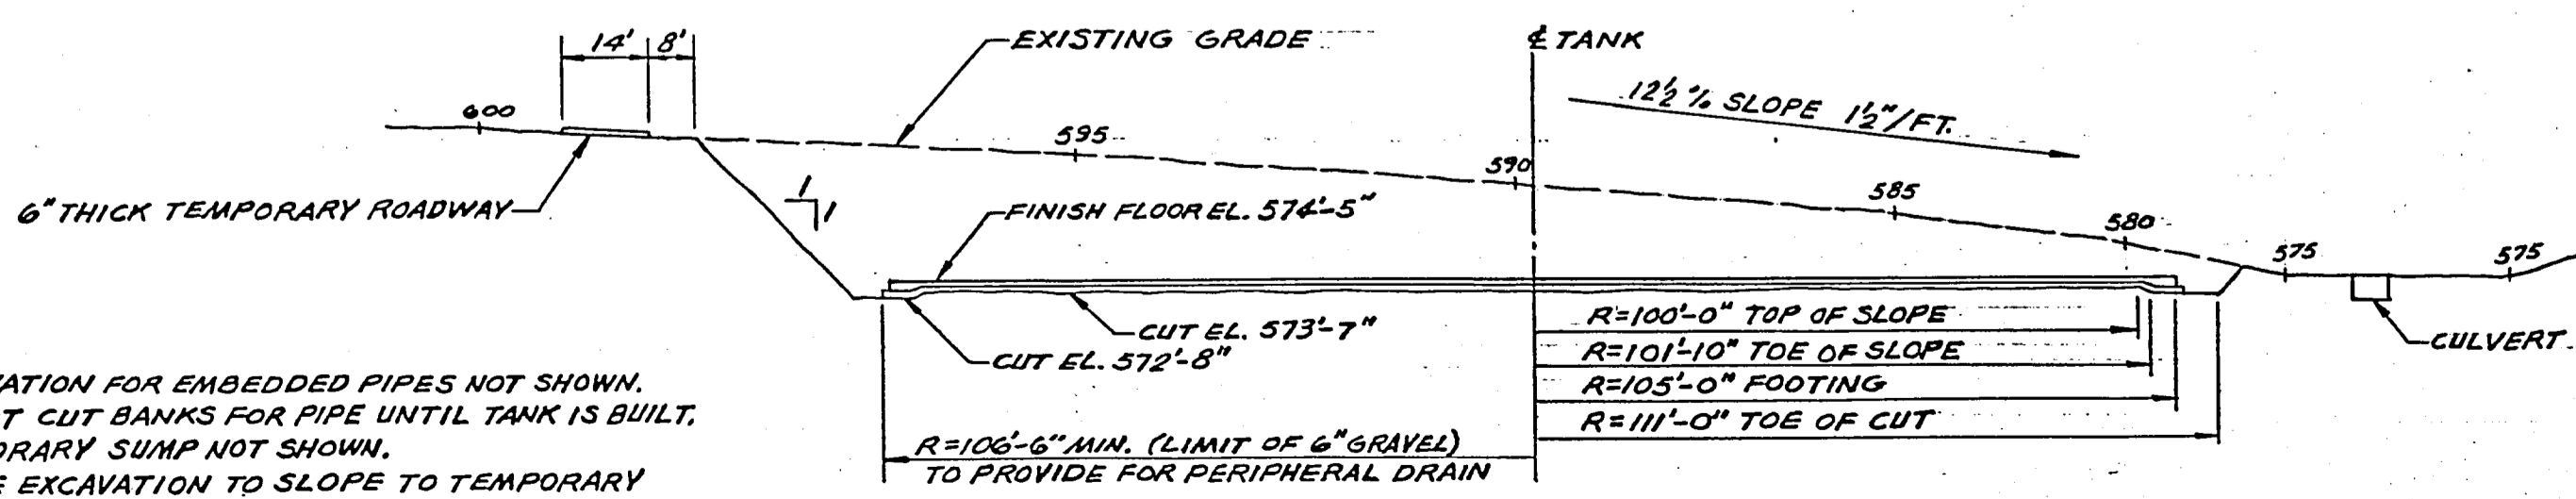

SECTION A-A
NORTH-SOUTH EXCAVATION
SCALE: 1"=30'

- NOTES:**
1. EXCAVATION FOR EMBEDDED PIPES NOT SHOWN.
 2. DO NOT CUT BANKS FOR PIPE UNTIL TANK IS BUILT.
 3. TEMPORARY SUMP NOT SHOWN.
 4. SHAPE EXCAVATION TO SLOPE TO TEMPORARY SUMP AT THE END OF EACH DAYS WORK.

THE DETAILS SHOWN ON THIS DRAWING SHALL BE PRODUCED WITHIN THE GUIDELINES AND REQUIREMENTS SPECIFIED IN PRELOAD CO. "CONSTRUCTION SPECIFICATIONS & PROCEDURES" NO. "CS-283".

REVISIONS				
NO.	DATE	DESCRIPTION	BY	CKD
1	7/13/86	ADDED PROPOSED PUMP STATION & FLOW CONTROLLER	E	RAO
2	4/12/87	AS BUILT	E	

PRELOAD

839 STEWART AVENUE, GARDEN CITY, NEW YORK, 11530

THIS DRAWING IS THE PROPERTY OF THE PRELOAD COMPANY, INC. AND/OR PRELOAD TECHNOLOGY, INC. AND IS SUBJECT TO RETURN ON DEMAND. IT CONTAINS FEATURES OF DESIGN WHICH ARE FULLY COVERED BY PATENTS AND PATENTS PENDING AND COPYRIGHTS. IT IS SUBMITTED FOR USE ONLY IN CONNECTION WITH PROPOSALS OR CONTRACTS OF PRELOAD OR ITS LICENSEES, UPON THE EXPRESS CONDITION THAT IT MAY NOT BE USED ON ANY OTHER DIFFERENT PROJECTS WITHOUT PRIOR APPROVAL OF PRELOAD.

WORKING D

ONE 6.0 M.G. WATE
ADDISON,

EXCAVATION

DRAWN: PV	SCALE: AS SHOWN
DESIGNED: BRB	APPROVED:
CHECKED: RAO	DATE: 4-24-