
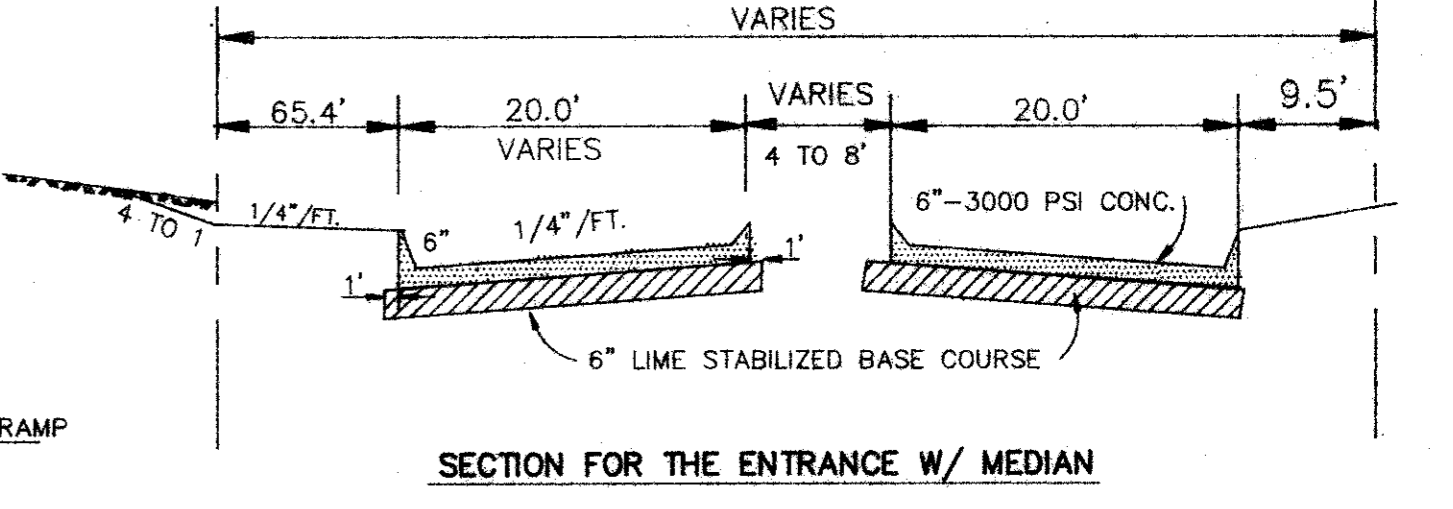
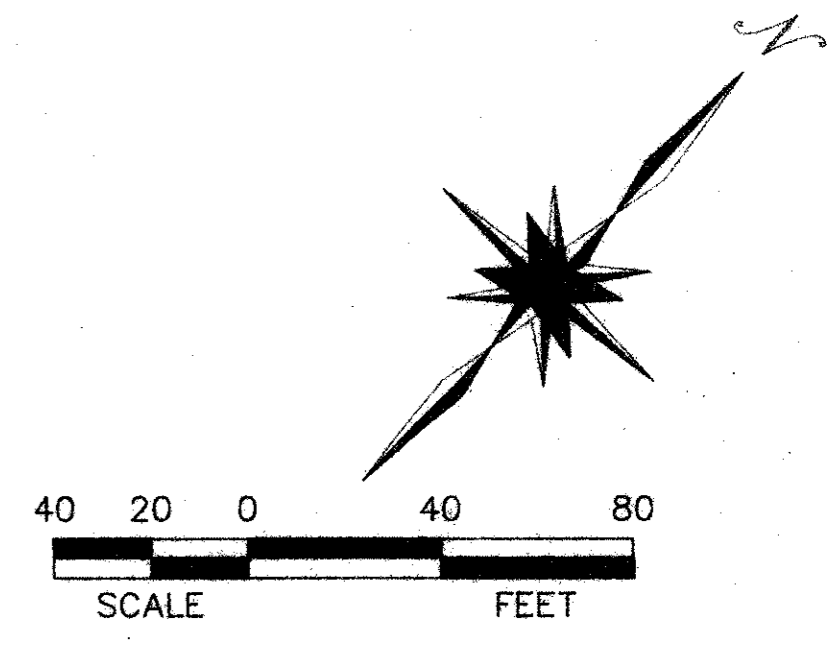




TYPICAL PAVING SECTION

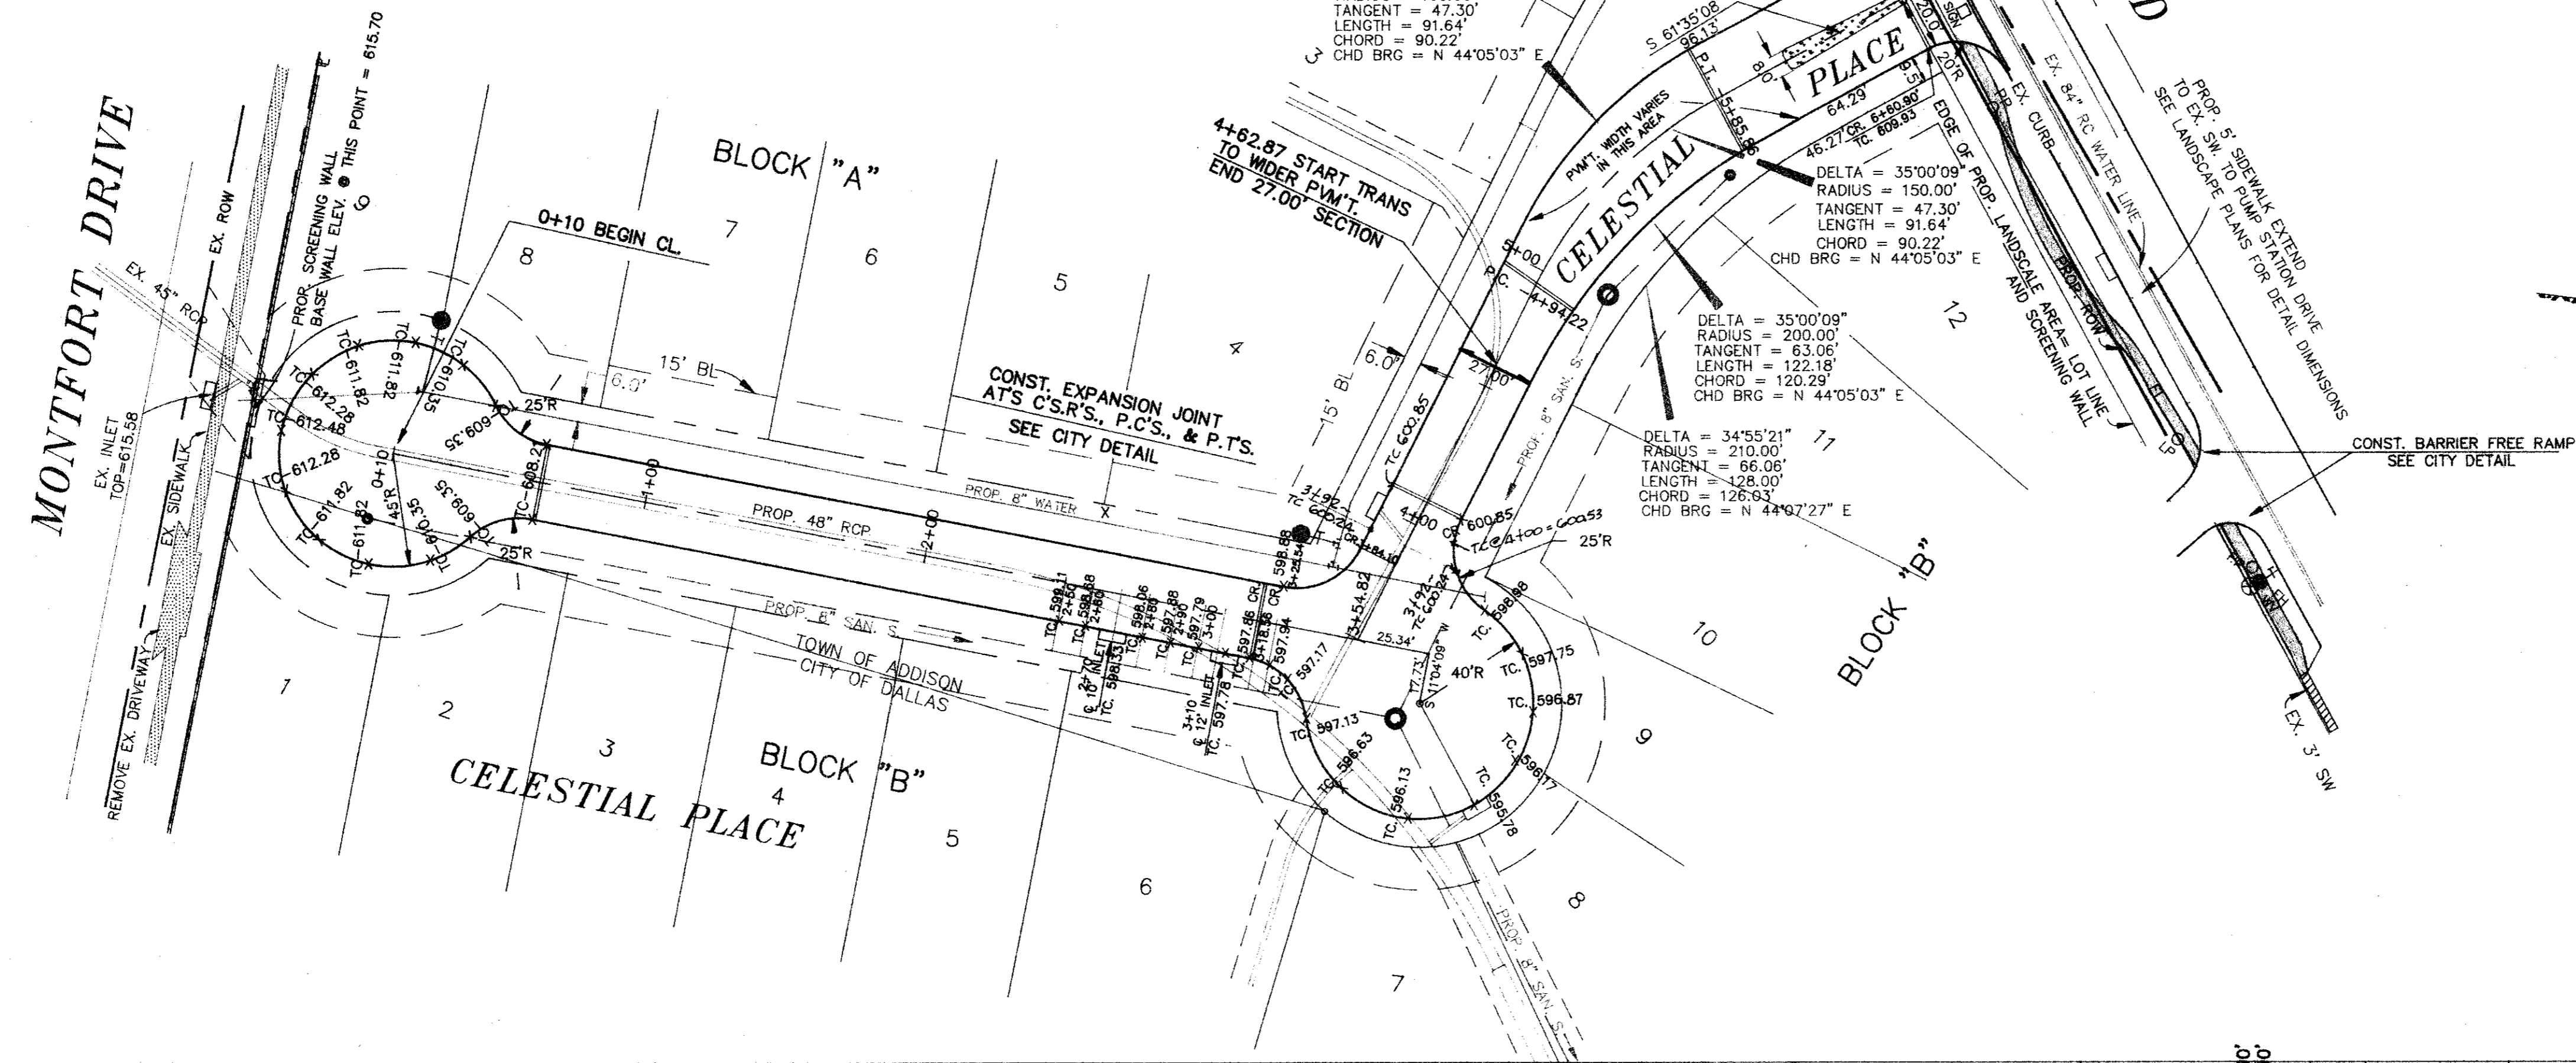

ALL CONSTRUCTION RELATED ITEM SHOULD COMPLY W/TOWN OF ADDISON STD. DETAILS AND SPECIFICATIONS.

BENCH MARK: CITY OF DALLAS WATER UTILITIES, SQUARE CUT ON CONCRETE BASE OF 6 FOOT BRICK WALL AT NORTHEAST CORNER OF CELESTIAL DRIVE AND MONTFORT, ELEVATION 526.81 FEET.

The engineer accepts no responsibility for the location, vertical or horizontal, of manholes, inlets, fire hydrants, cleanouts or valve boxes, unless inspected by the engineer prior to final placement. It shall be the responsibility of the contractor to notify the engineer when ready for inspection.

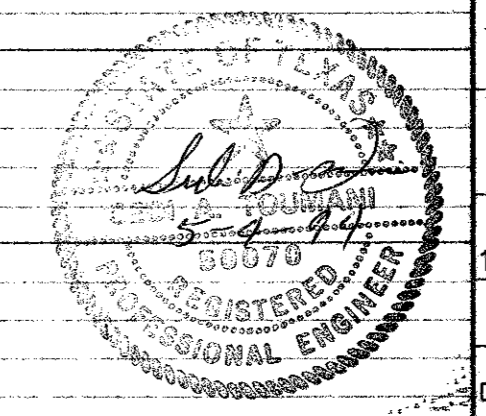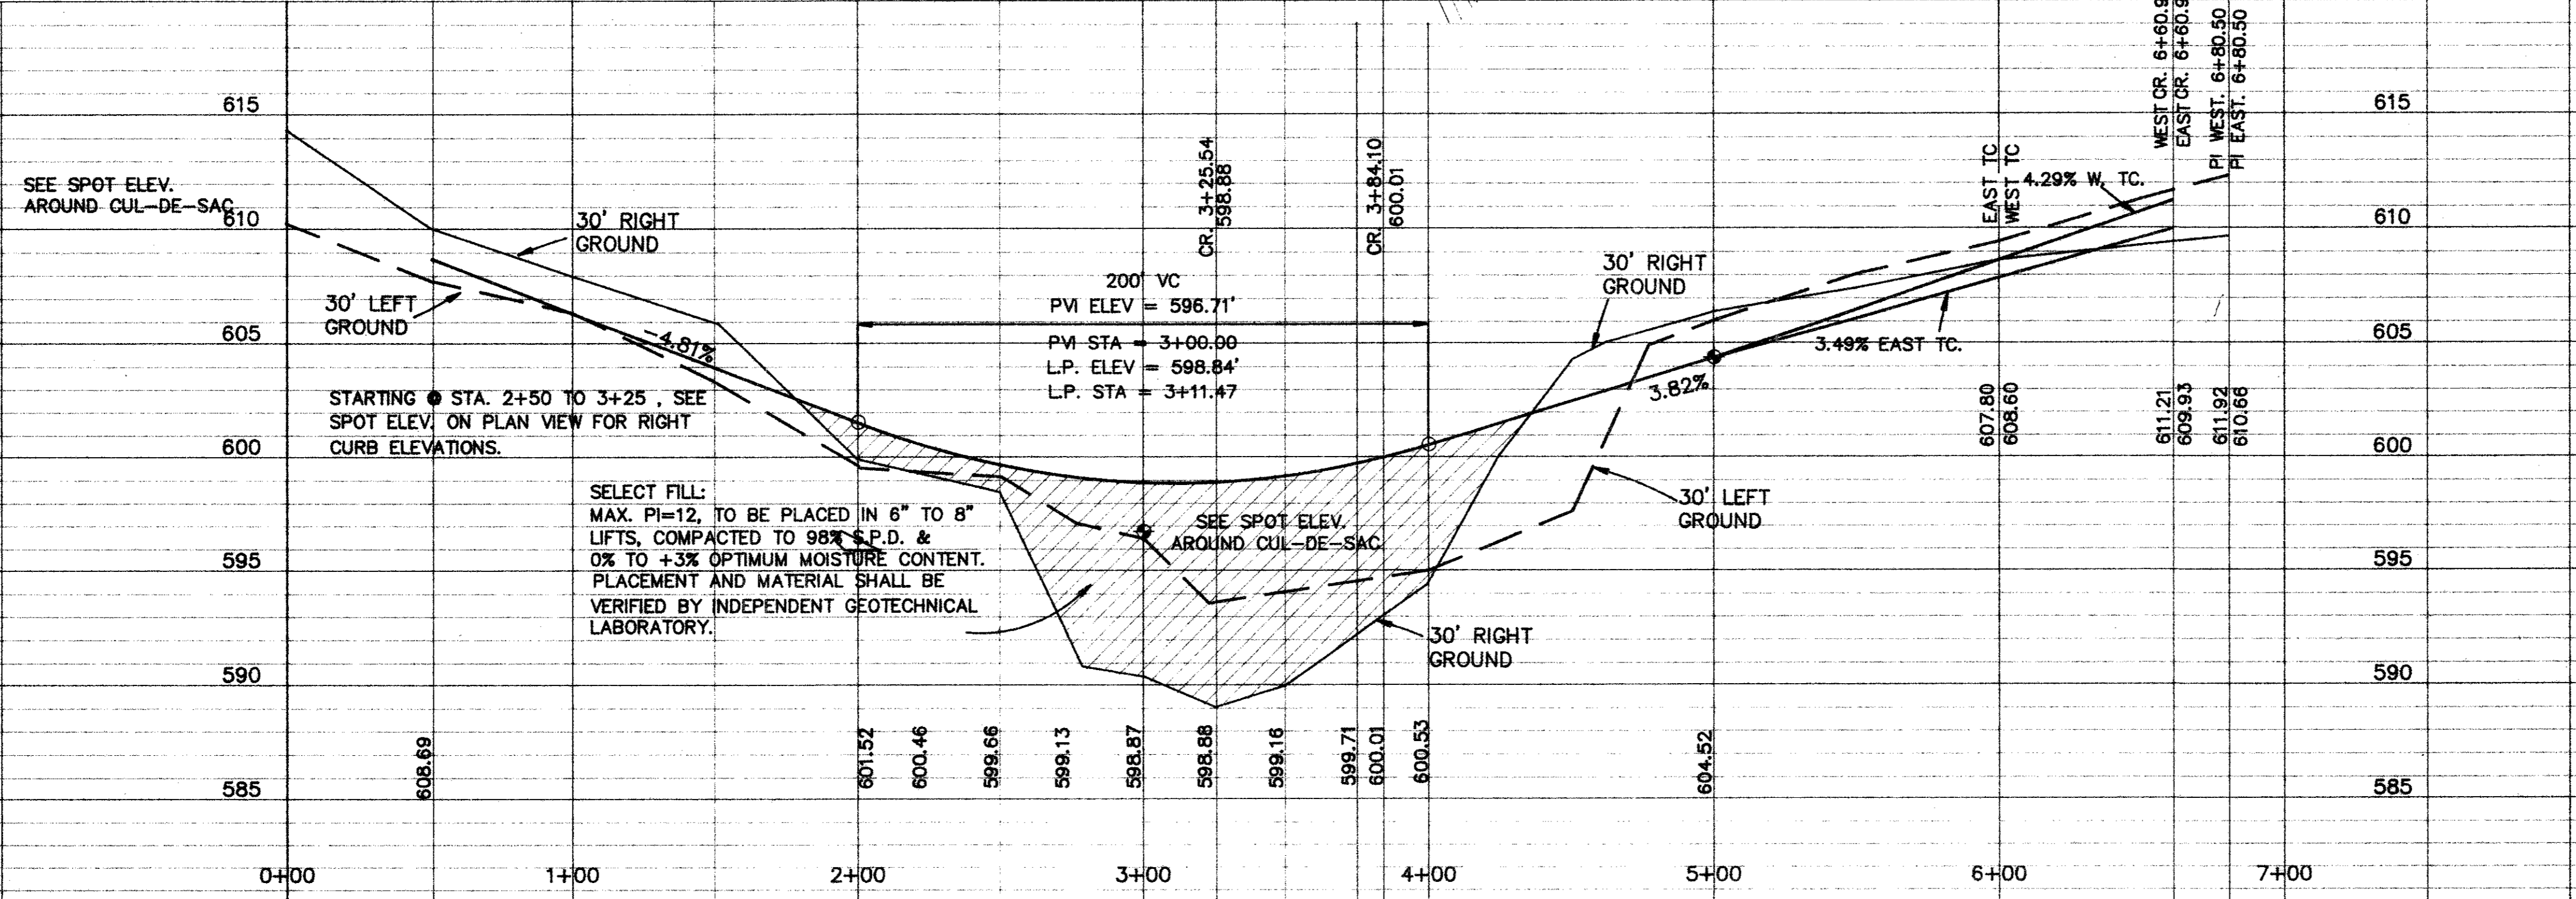

CELESTIAL PLACE
ADDISON/DALLAS, TEXAS
PAVING PLAN & PROFILE

ALLEGIANCE GROUP, INC.
8080 N. CENTRAL EXPWY., SUITE 880, DALLAS 75206

DAL-TECH ENGINEERING INC.
11020 AUDELIA RD. SUITE C207, DALLAS, TEXAS PH. 553-5500

DESIGN	DRAWN	DATE	SCALE	NOTES	SHEET
DAL-TECH	DAL-TECH	JANUARY 1994	H 1"=40' V 1"=5'	9313	3/13