

PD 50-047
WALLEN PREPATORY
SCHOOL FOUNDATION
VOL. 72054, PG. 954 D.R.D.C.T.

MONTFORT DR.


BLOCK "A"

BLOCK "B"

CELESTIAL PLACE

TOWN OF ADDISON
CITY OF DALLAS

BLOCK "B"

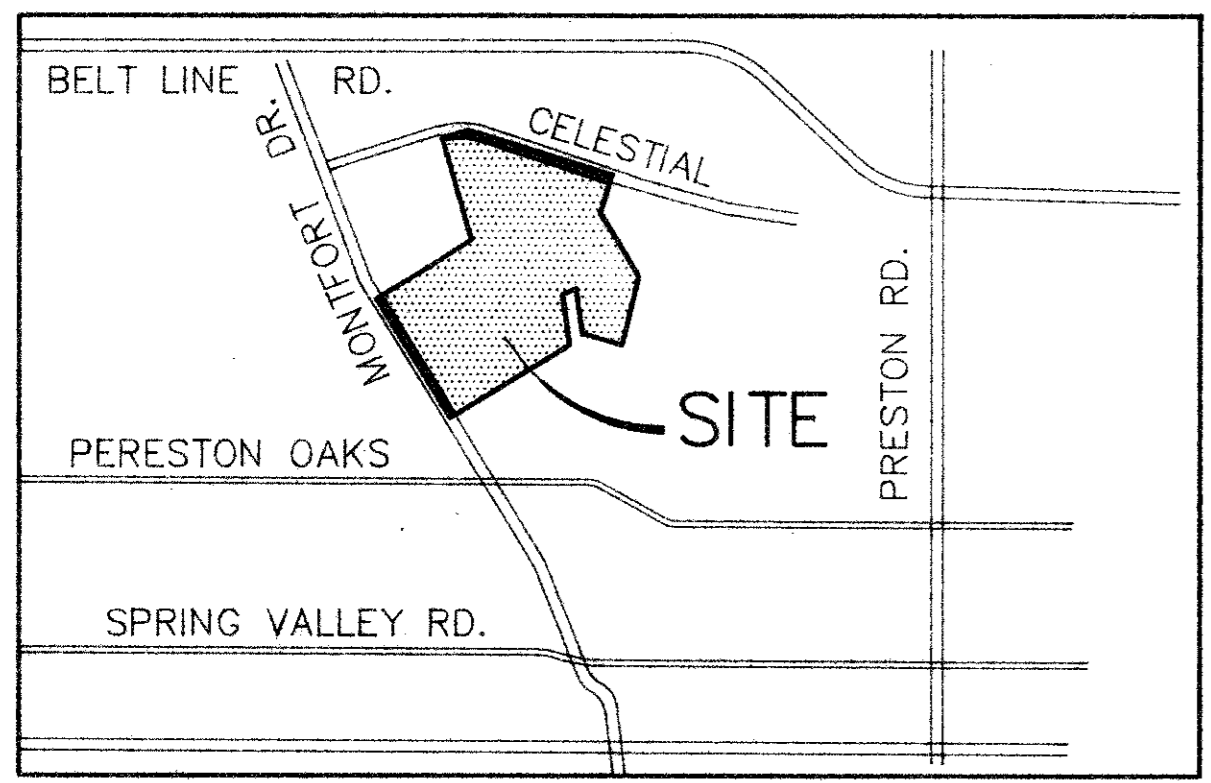


LOCATION MAP

BENCH MARK:
CITY OF DALLAS WATER UTILITIES, SQUARE CUT ON CONCRETE BASE
OF 6 FOOT BRICK WALL AT NORTHEAST CORNER OF CELESTIAL DRIVE
AND MONTFORT, ELEVATION 626.81 FEET

LOT 1, BLK. A/8168
14400 MONTFORT ADDITION
VOL. 86013, PG. 4250 D.R.D.C.T.

The engineer accepts no responsibility for the location,
vertical or horizontal, of manholes, inlets, fire hydrants,
cleanouts or valve boxes, unless inspected by the engineer
prior to final placement. It shall be the responsibility of
the contractor to notify the engineer when ready for
inspection.

WATER AND SANITARY SEWER PLAN
CELESTIAL PLACE
ADDISON/DALLAS, TEXAS

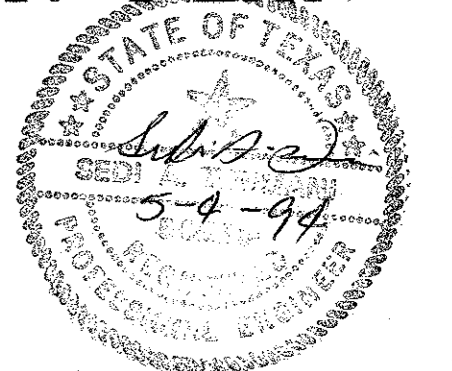

FOR :
ALLEGIANCE GROUP, INC.
8080 N. CENTRAL EXPWY.
DALLAS, TEXAS 75206
PH. (214)891-8159

BY :
DAL-TECH ENGINEERING INC
11020 AUDELIA RD., SUITE C207
DALLAS, TEXAS 75342
PH. (214)553-5500

CONTRACTOR TO COMPLY WITH THE TOWN OF
ADDISON STANDARD DETAILS AND SPECIFICATIONS
FOR CONSTRUCTION OF WATER AND SANITARY SEWER
LINES AND APPURTENANCES.
SEE DETAILS AND SPECS. SHEETS ATTACHED.

