

FINISH SCHEDULE


FLOOR DESIGNATION
1. CONCRETE, SEALED
2. VINYL COMPOSITION TILE
3. PLYWOOD FLOORING
WALL DESIGNATION
1. GYPSUM BE, ENAMEL PAINT
2. CMU, EPOXY PAINT
3. CMU, ENAMEL PAINT
4. GYPSUM SD, TAPE ONLY
CEILING DESIGNATION
1. EXPOSED STRUCTURE
2. GYPSUM SD, ENAMEL PAINT
3. GYPSUM SD, EPOXY PAINT

splat & drag finish


* 1/4" SUPER DOME NICHE & ALL 3/4" SD WALLS EXCEPT IN GARAGE & UPPER FLOOR.
 * ALUMINUM NO. 2 - GLAZED CMU & EXPOSED INTERIOR CMU SURFACES IN PUMP ROOM ONLY.

NOTES


- ALL DIMENSIONS TO FACE OF MASONRY & FACE OF WOOD FRAMING UNLESS NOTED OTHERWISE.
- ALL EXPOSED VERTICAL OUTSIDE CORNERS OF C.M.U. TO BE BULLNOSE.
- CONTRACTOR TO PROVIDE & INSTALL SPECIAL BLOCKS AS REQ'D TO CONCEAL STEEL COLS, LINTEL BLOCKS, CONTROL JOINT BLOCK, BOND BEAM BLOCK, FLASHING BLOCK, ETC.
- BENCH TO DB 2-2x2 REDWOOD SFS, MOUNTED SECURELY TO FLOOR W/ 2-3/8 GALV STEEL COLS (PAINTED). TRIM & BOLT HEAVILY 42" x 1 1/2" x 1 1/2" CENTER ON LOCKERS.
- JOIN DIFF. FLOOR MATERIALS DIRECTLY UNDER CLOSED DOORS. TRIM W/ APPROPRIATE EDGE SINKS, NOSING, ETC.
- DRDG. AREA INCLUDING GARAGE, EXCLUDING UPPER FLOOR = 5,165 SF.
- BRICK PATTERN TO MATCH FACE BRICK. 8" SAND NP @ EDGE OF PORCH. TOP PLUMB W/ LEVEL. PORCH. SQUARE PATTERNS CENTERED UNDER EACH COL. SYMMETRICAL BOTH SIDES OF PORCH. PAPER TRENDS & RISERS AS INDICATED. MINIMIZE CUTTING. RECESS FRONT FACE OF PORCH 4" TO DEFINE COL. SYMMETRICAL AS INDICATED. NO TILES IN BRICK TO SHOW.

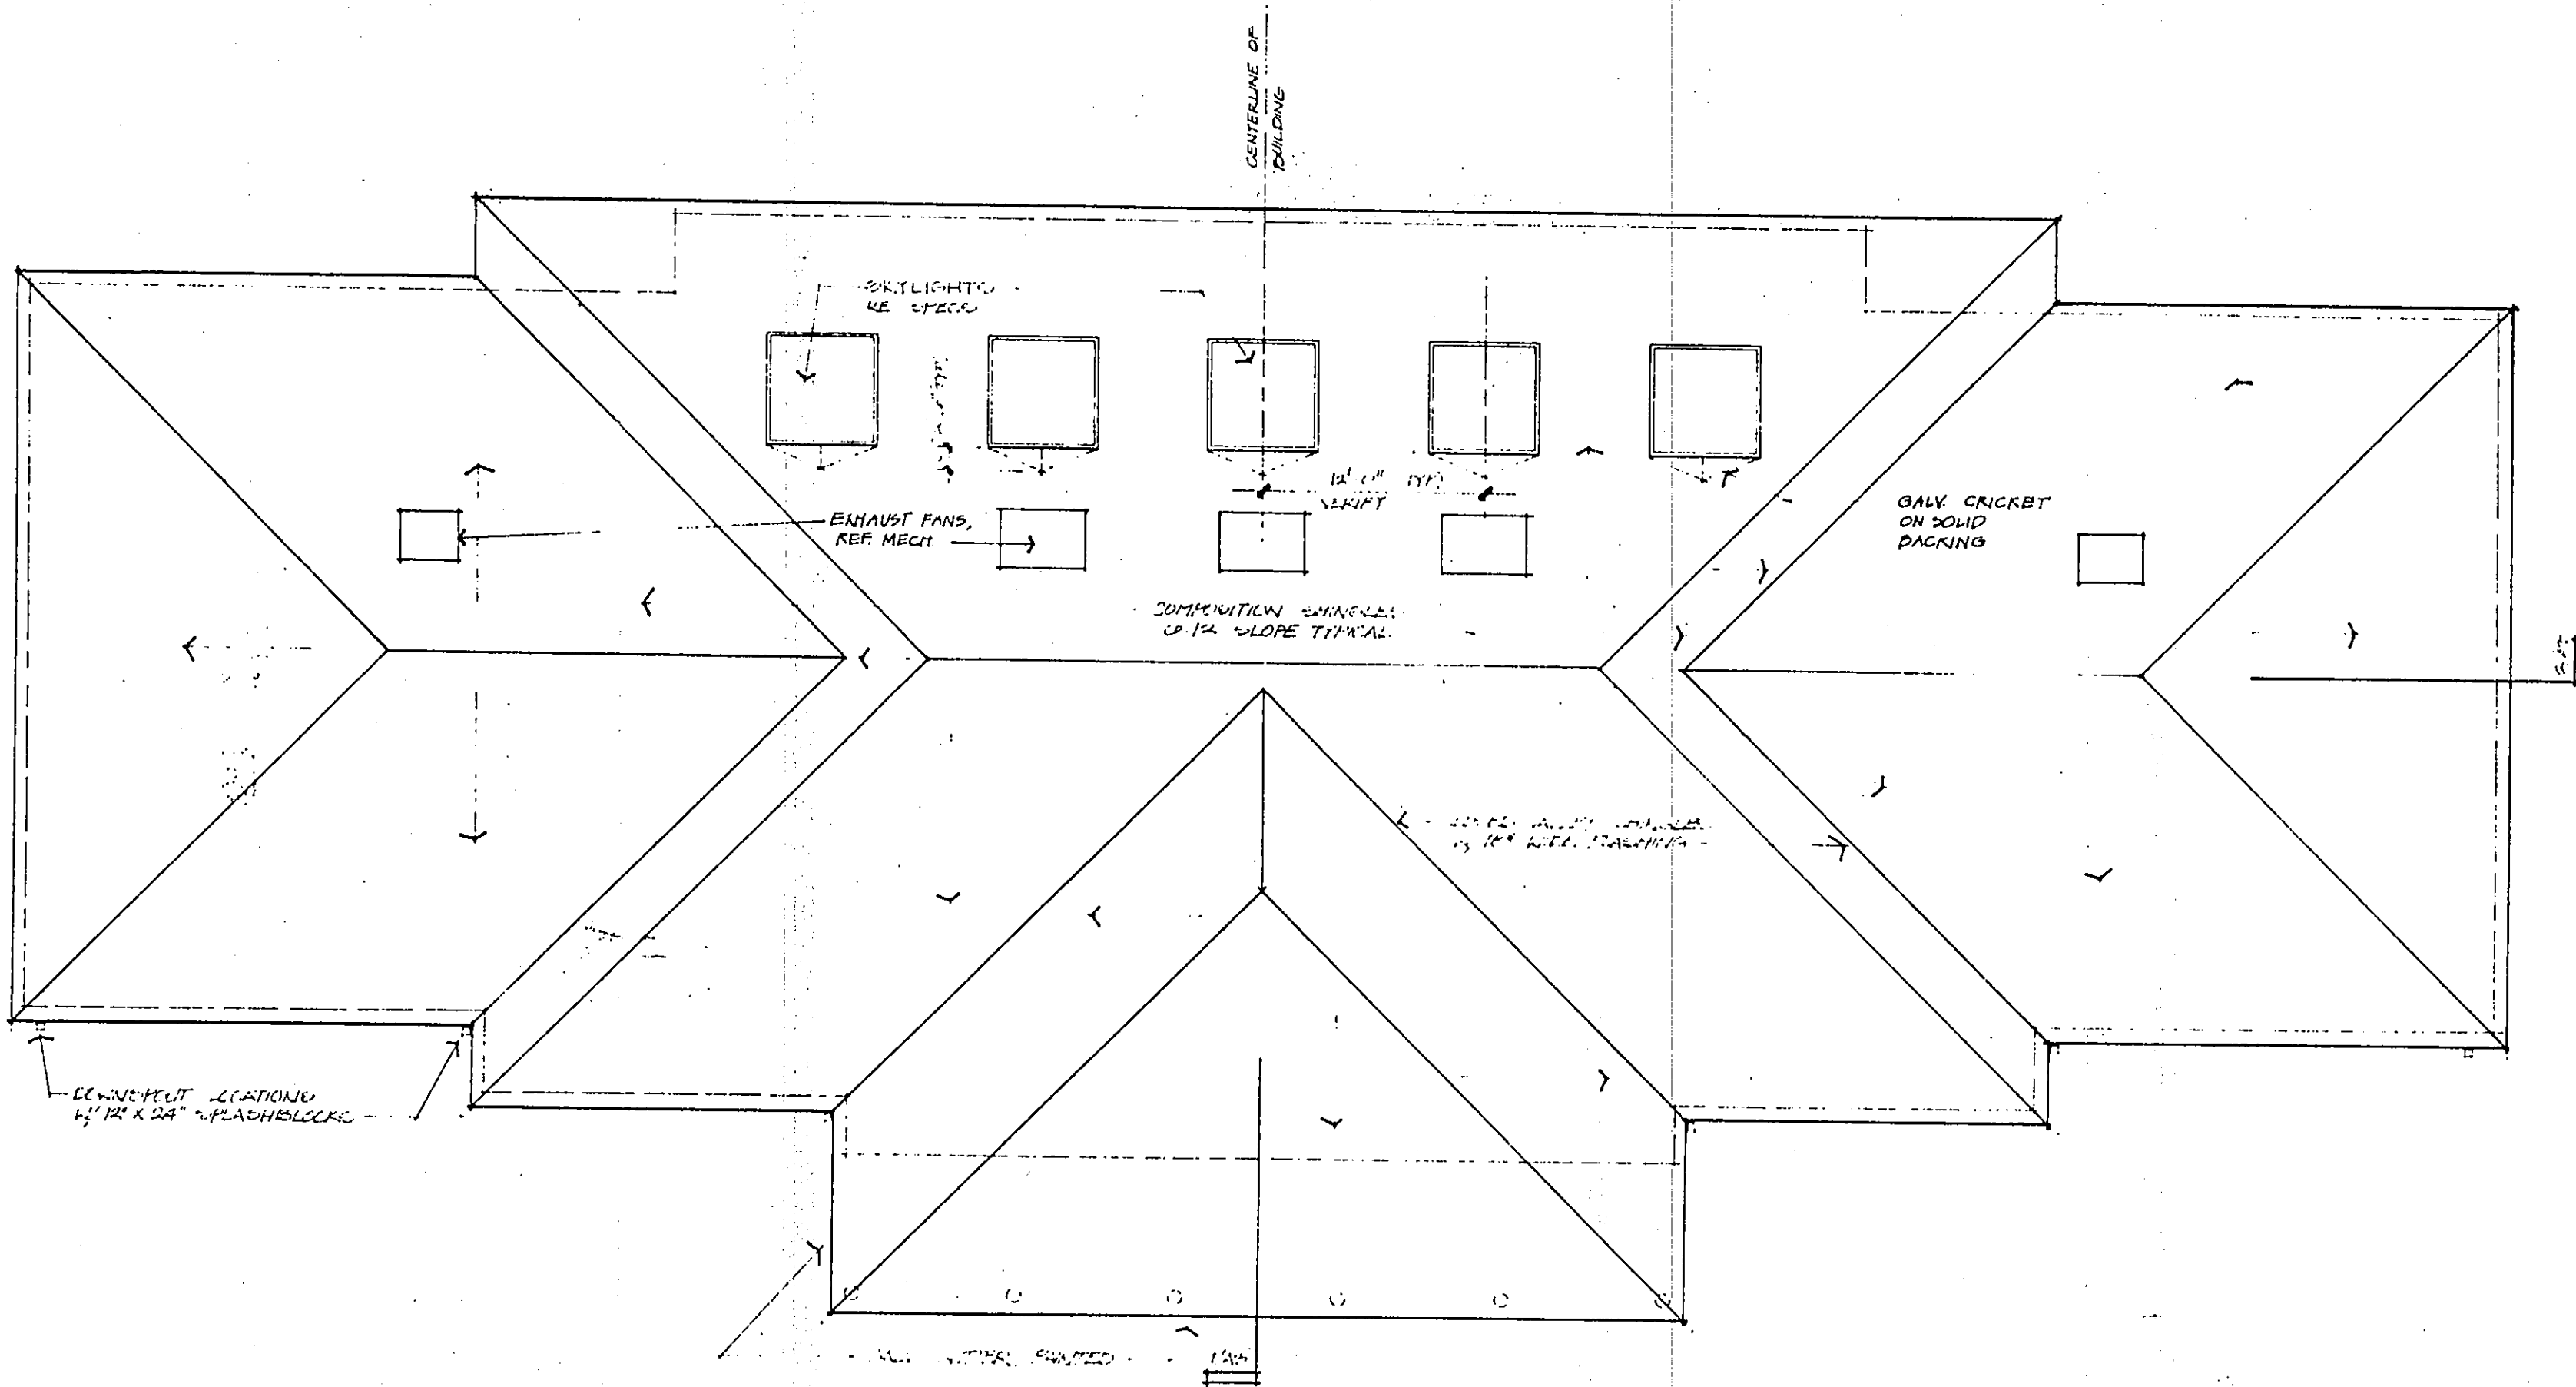


ROOF PLAN
1/8" = 1'-0"

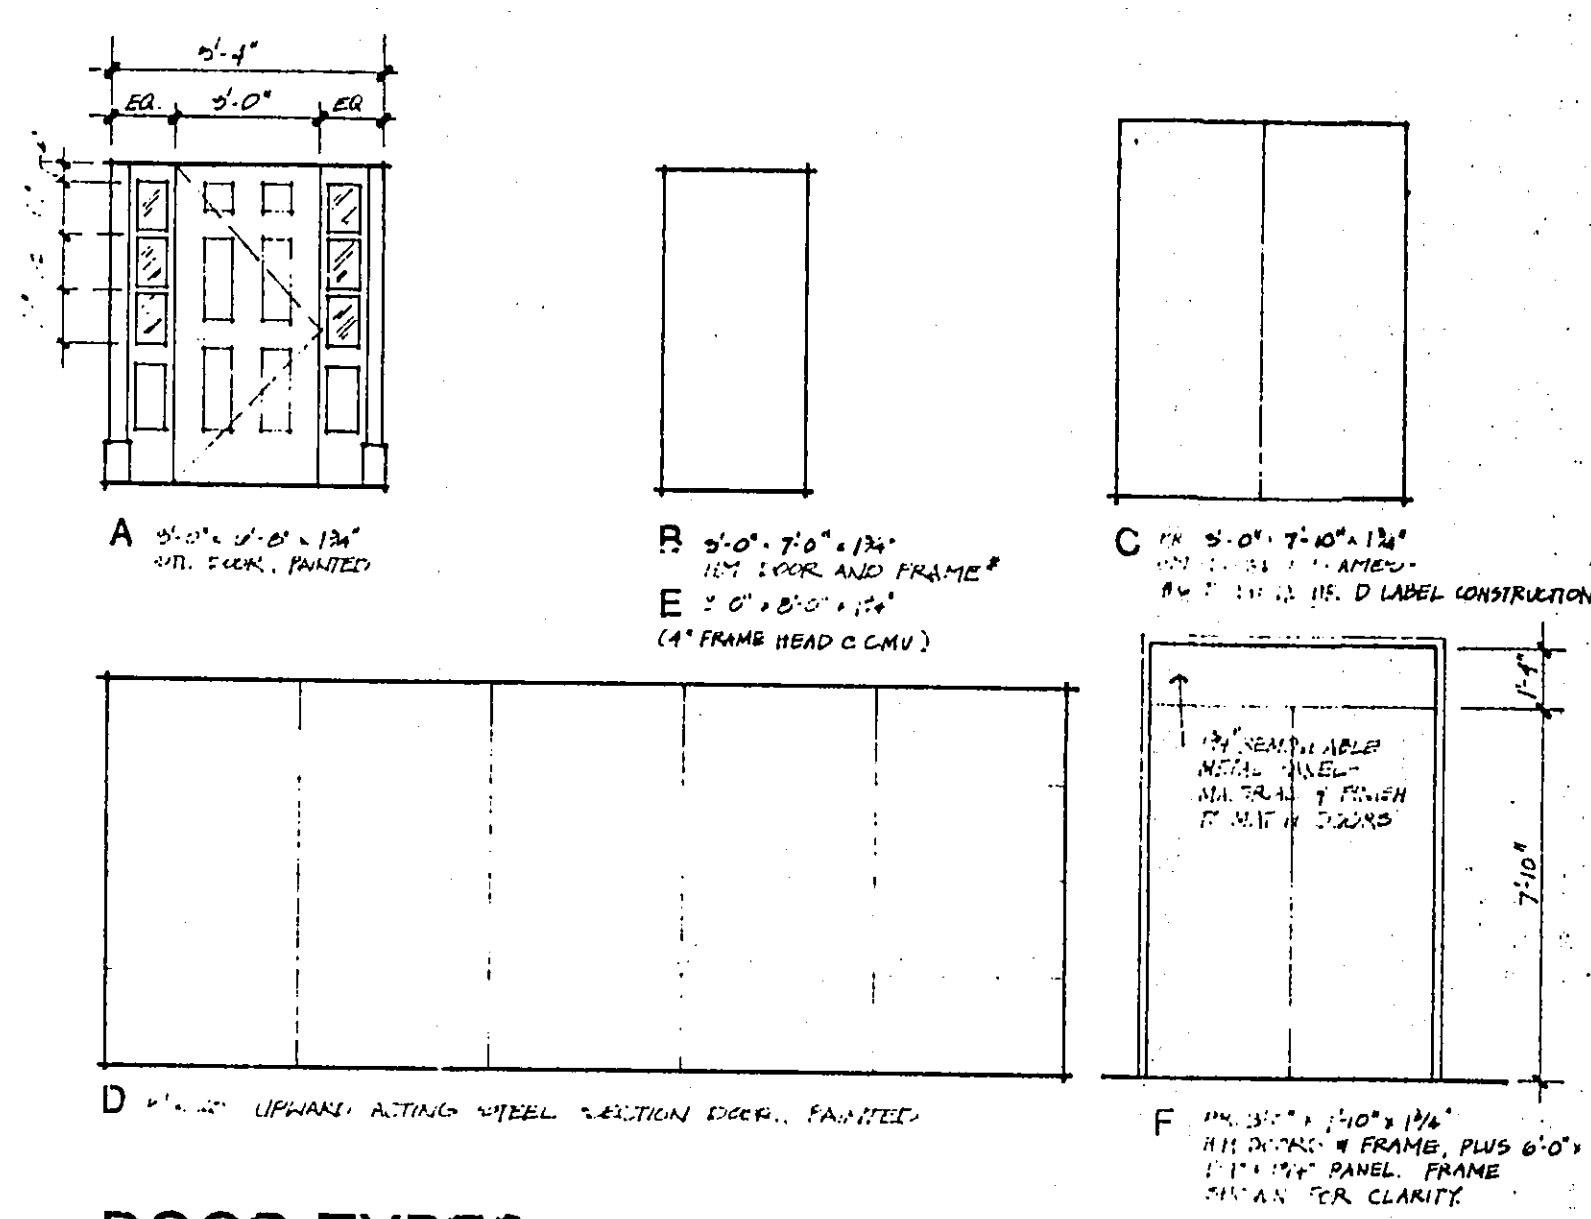


DOOR TYPES
1/4" = 1'-0"

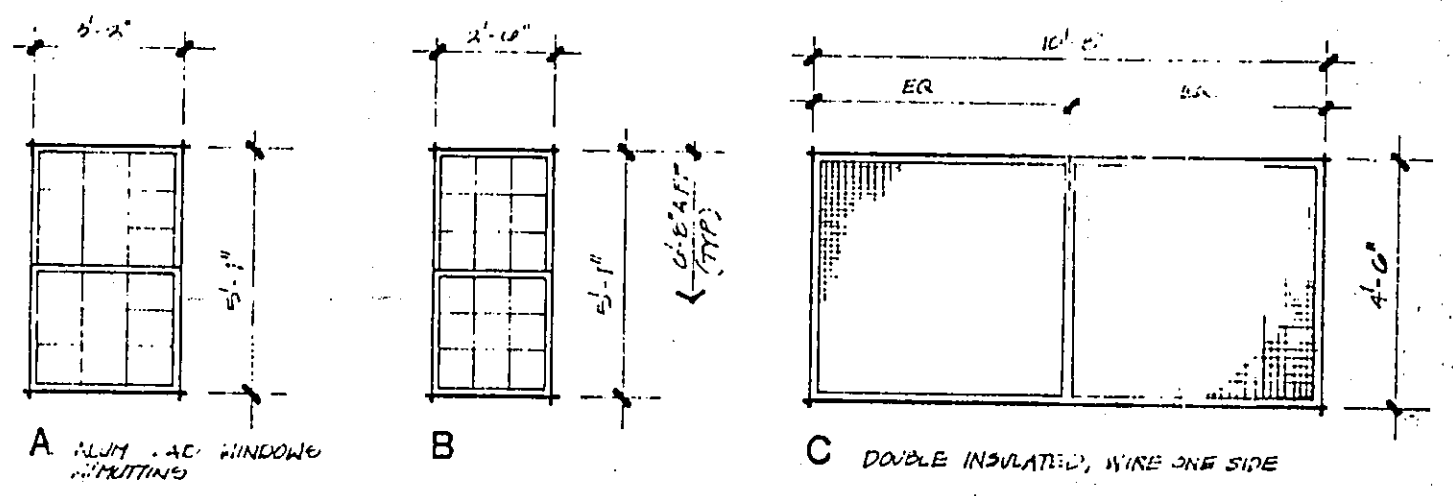


WINDOW TYPES
1/8" = 1'-0"

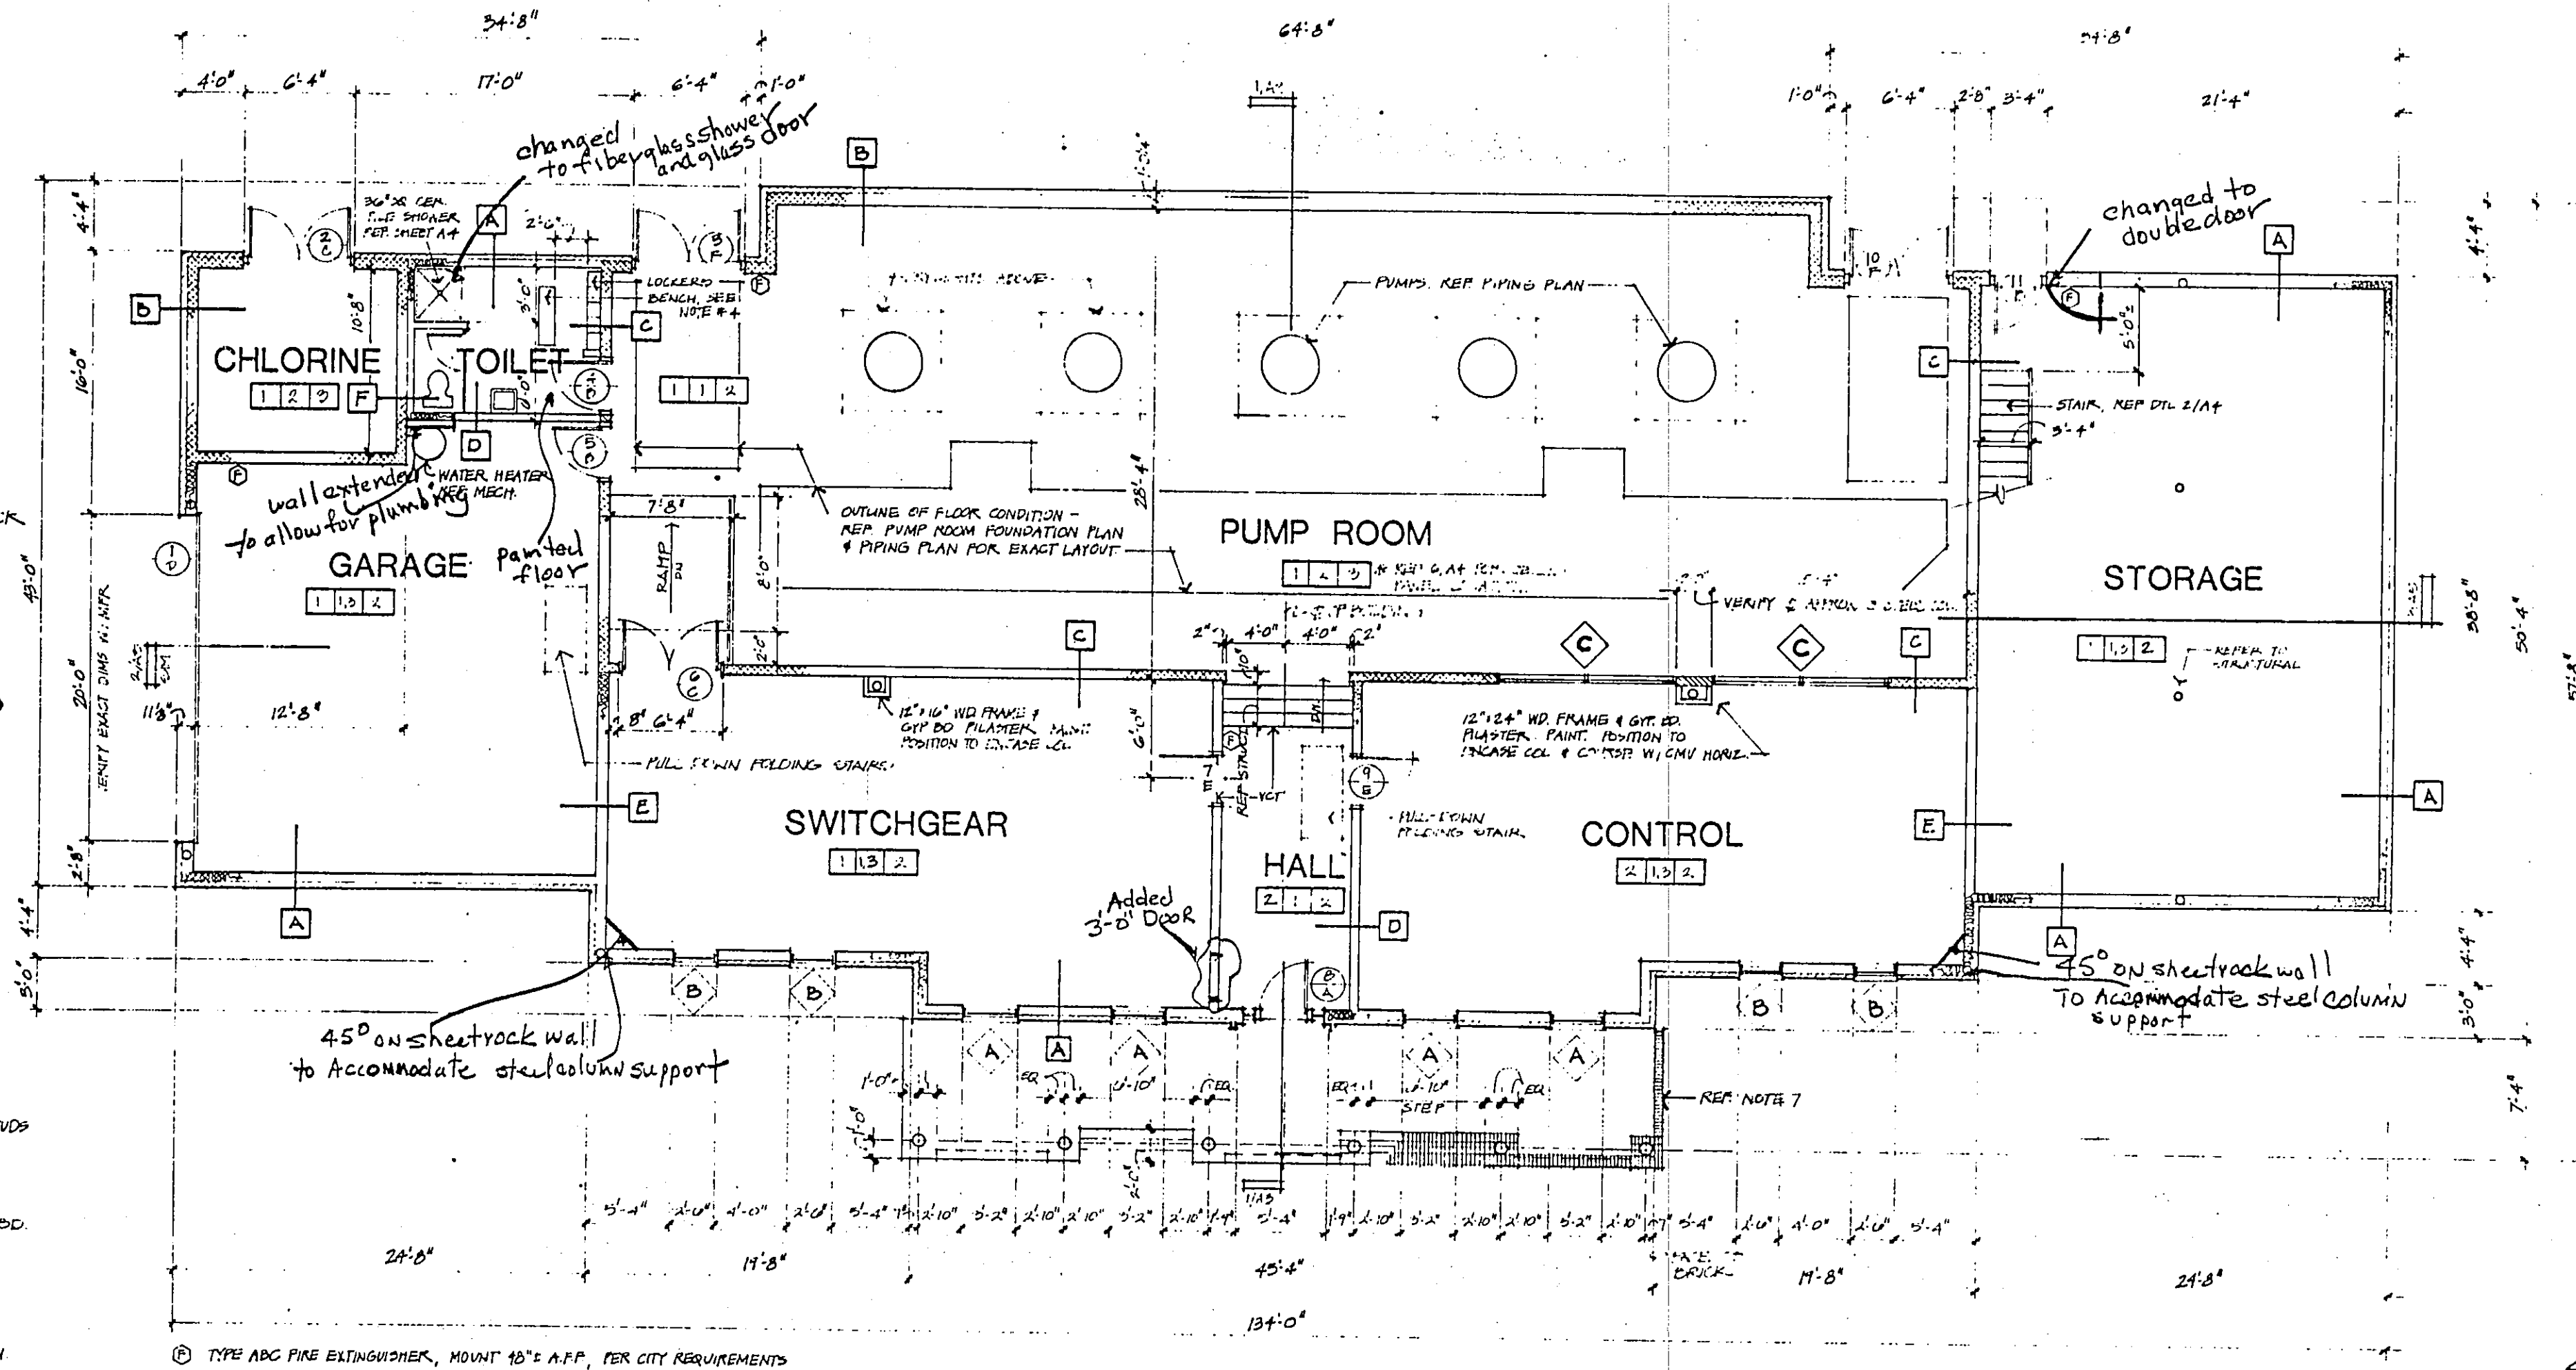

FLOOR PLAN
1/8" = 1'-0"

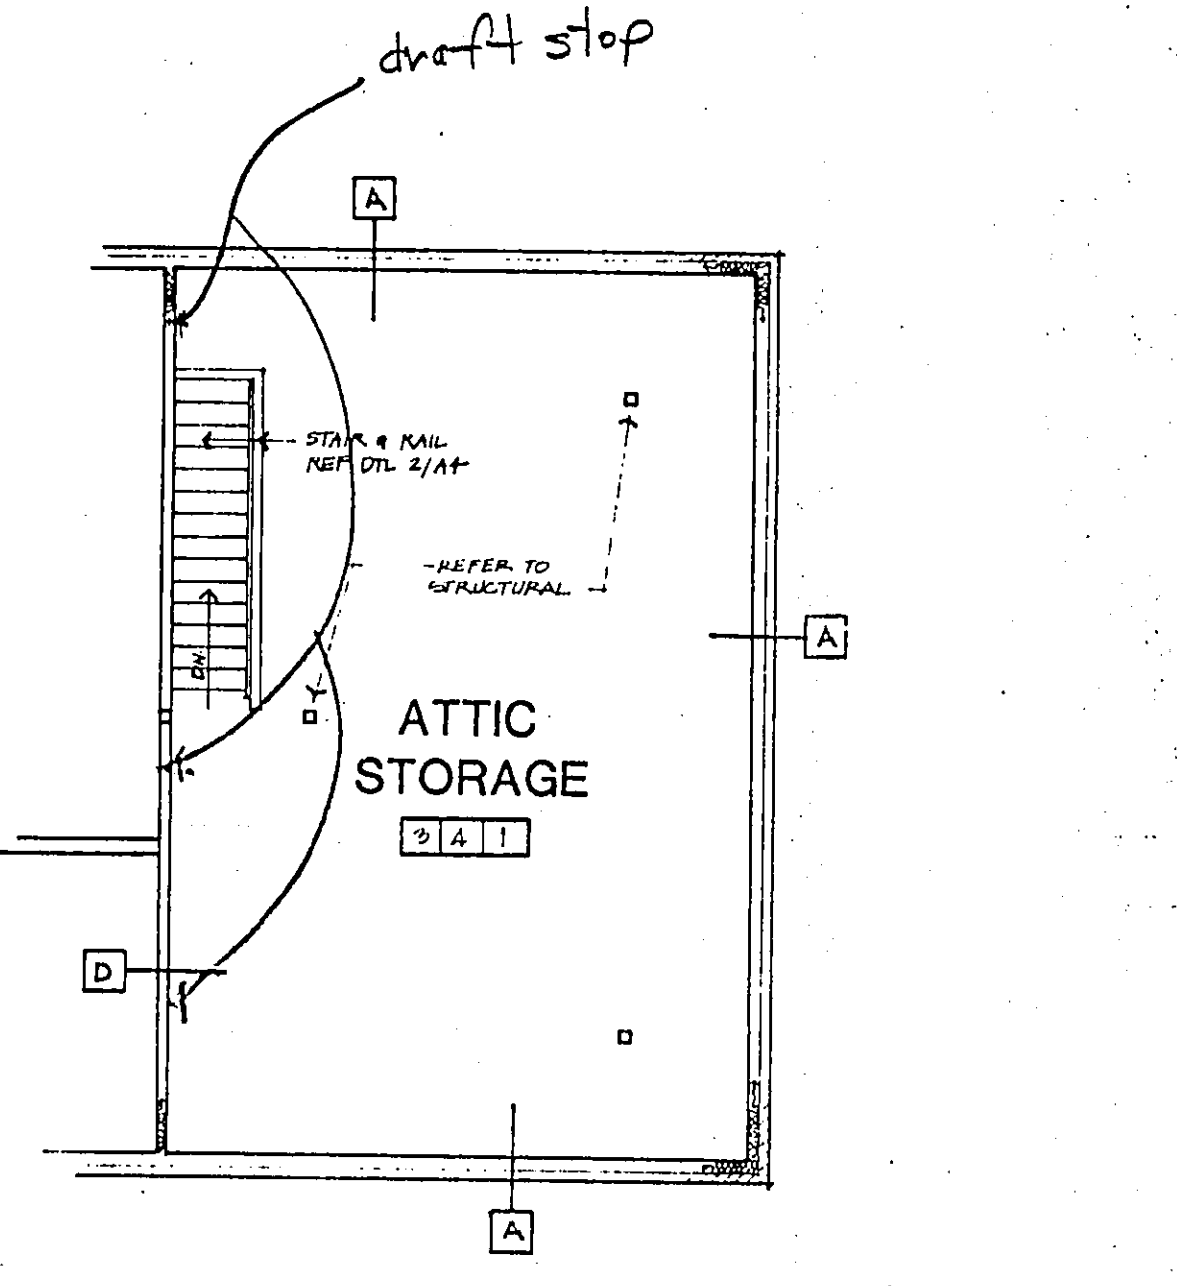

UPPER LEVEL PARTIAL PLAN
1/4" = 1'-0"

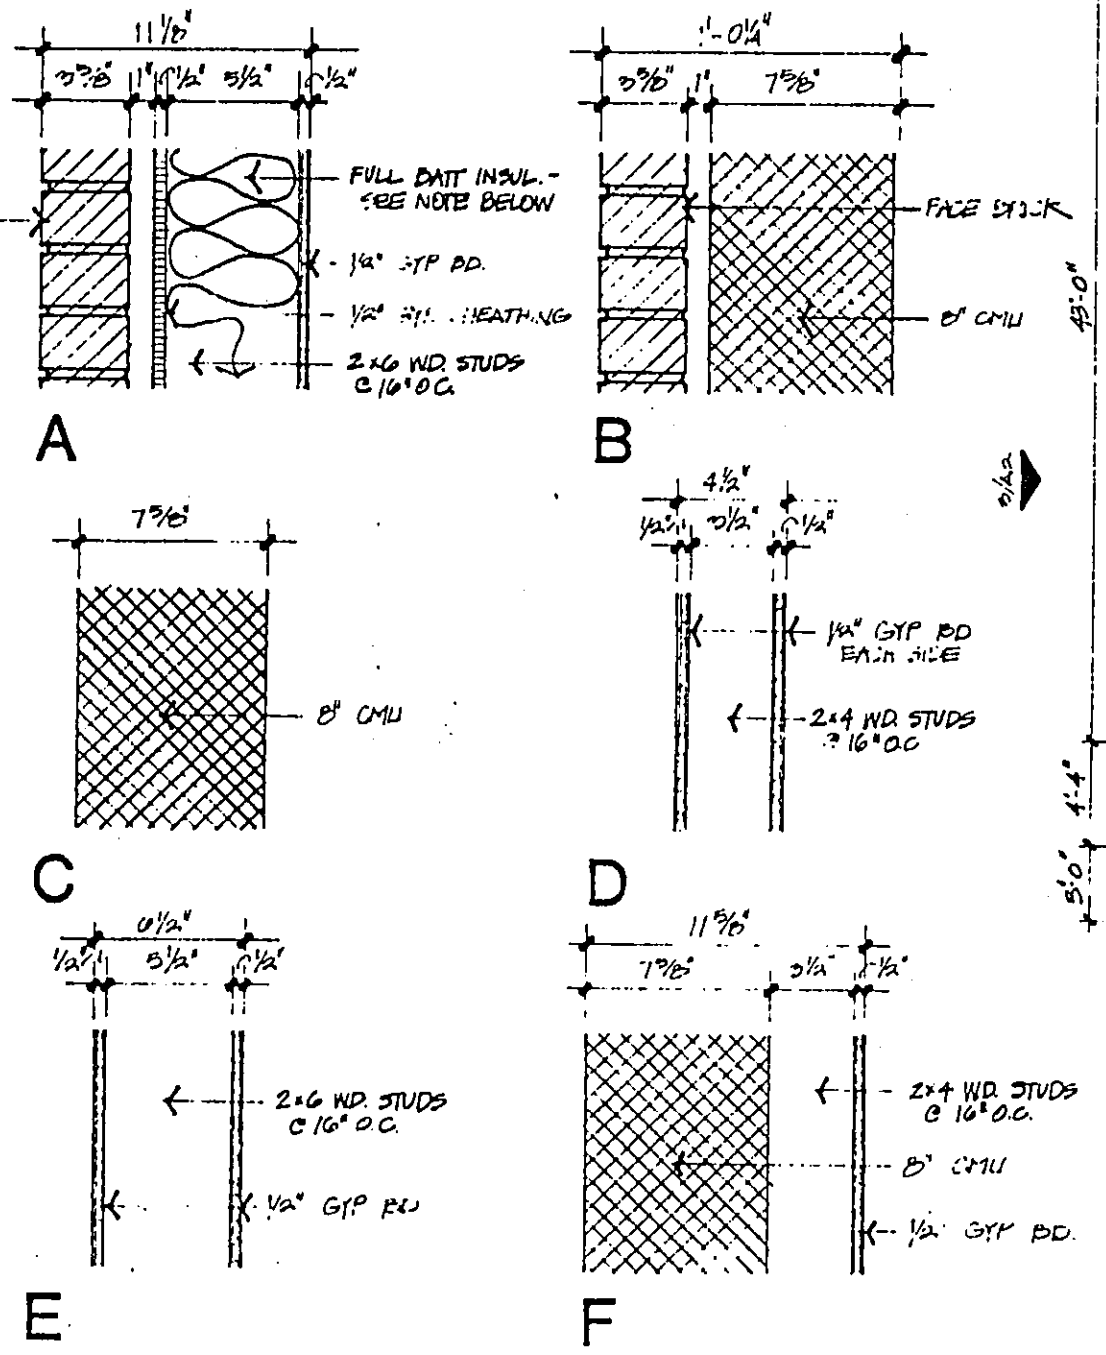

WALL TYPES
SCALE: 1/2" = 1'-0"

No	Revision	By	Date
TOWN OF ADDISON DALLAS COUNTY, TEXAS CELESTIAL ROAD PUMP STATION			
Architectural Consultants: DILLARD ARCHITECTS INC.		FLOOR PLAN DOORS, WINDOWS, PARTITIONS ROOF PLAN	
GINN, INC. Consulting Engineers Dallas, Texas			
Designed -	Drawn - D.A.D.	Date - JANUARY, 1987	Job No. - 217
Approved -	Checked -	Scale -	Sheet A1 of

