


STORM DRAINAGE

STORM DRAINAGE LINE 2

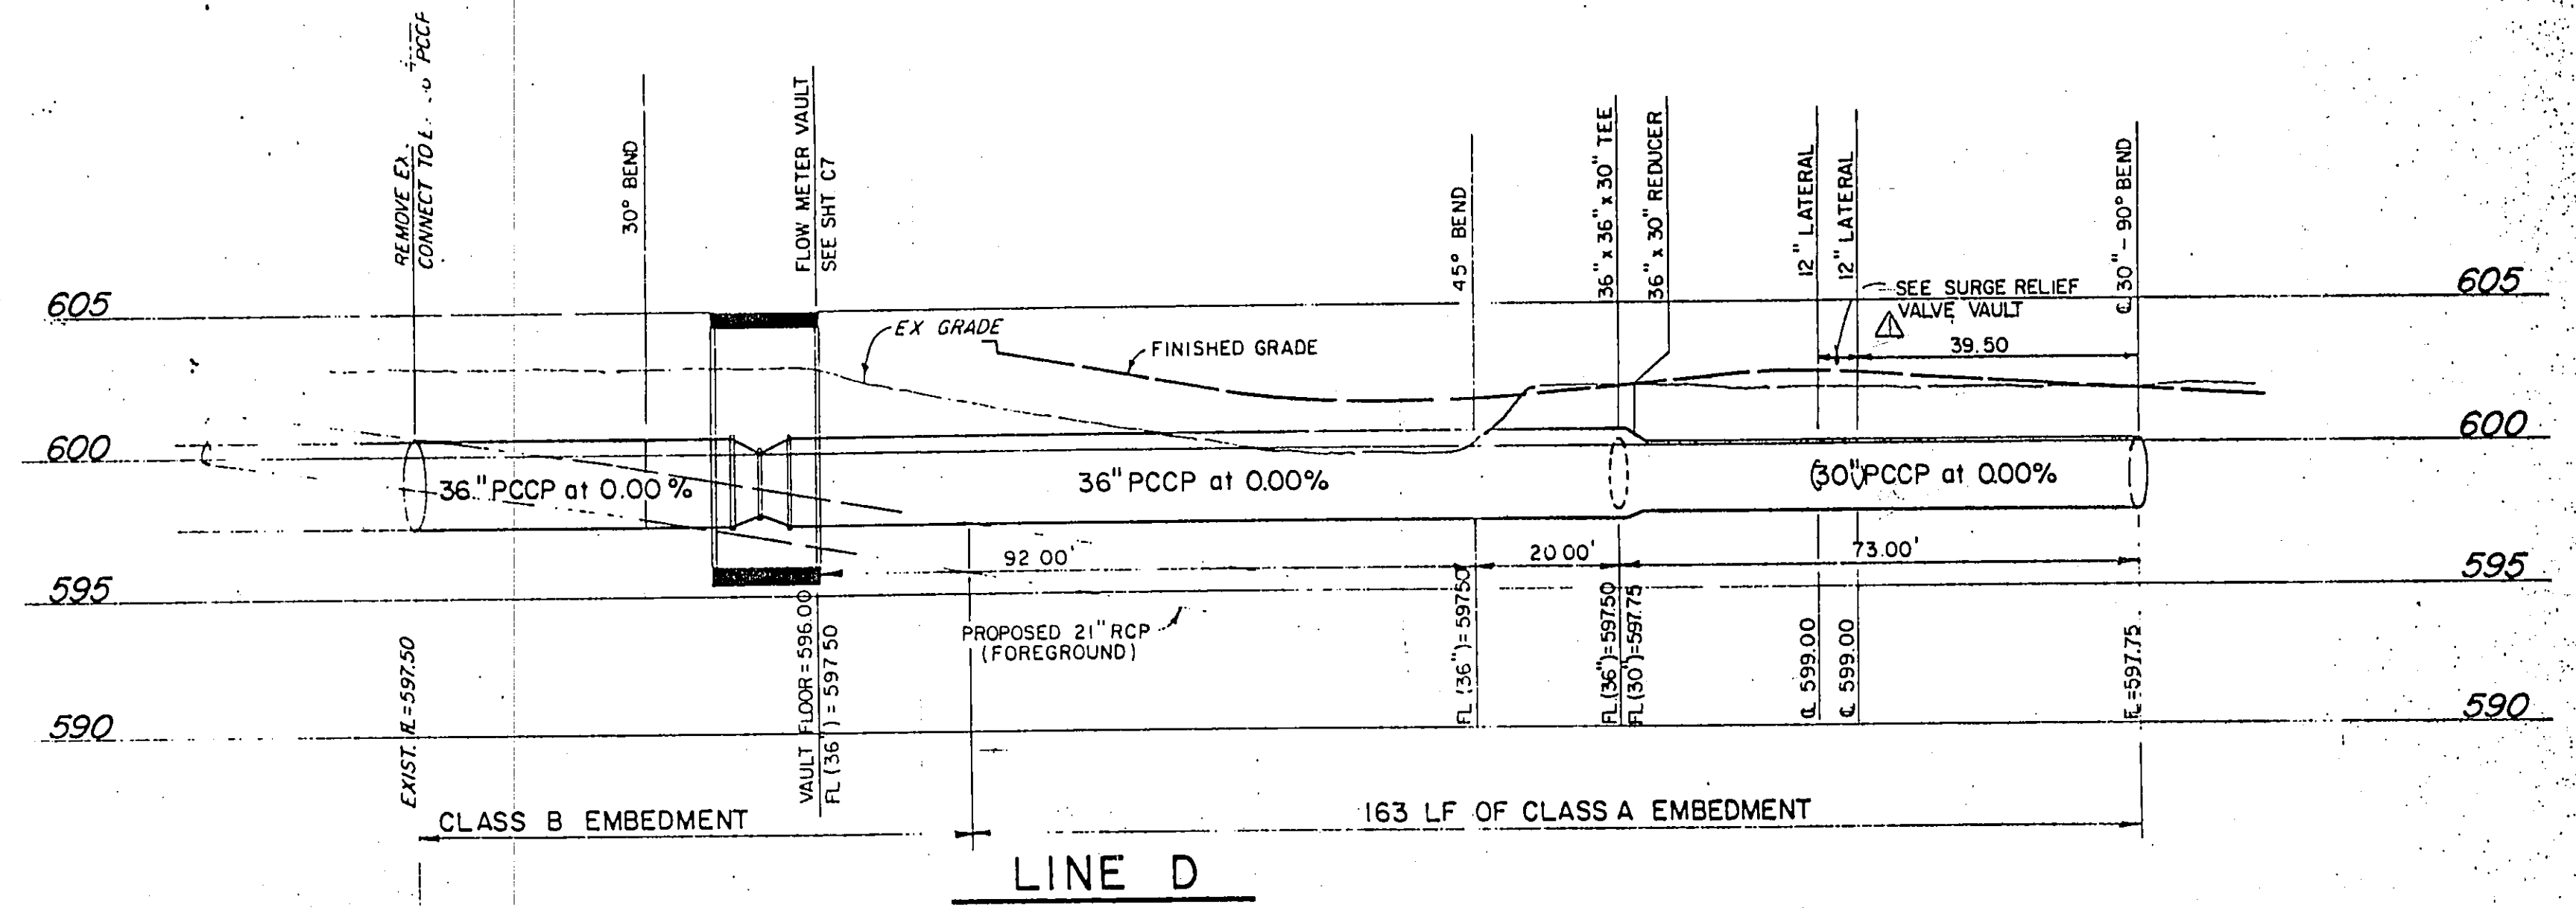

LINE D

ADDENDUM #1		Revision		R.C.H.	3-20-87
No.		By	Date		
TOWN OF ADDISON DALLAS COUNTY, TEXAS					
CELESTIAL ROAD PUMP STATION					
YARD PIPING PROFILES					
GINN, INC. Consulting Engineers Dallas, Texas					
Designed - RCH	Drawn - GAP	Date - JAN., 1987	Job No. - 217		
Approved - HWG	Checked - GAF	Scale - 1" = 20'H/1" = 5'V	Sheet - C-4 of		

Randall C. Hill
2-19-87