


INDEX TO DRAWINGS

SHT.	DESCRIPTION
Cover Sheet	
C-1	Site Layout
C-2	Grading and Yard Piping Plan
C-3	Yard Piping Profiles
C-4	Yard Piping Profiles
C-5	Sanitary Sewer
C-6	Piping Plan
C-7	Flow Meter Vault and Details
C-8	Miscellaneous Details - Paving
C-9	Miscellaneous Details - Drainage
C-10	Miscellaneous Details - Water
C-11	Miscellaneous Details - Site Work
A-1	Floor and Roof Plan
A-2	Elevations
A-3	Sections and Details
A-4	Details
S-1	Foundation Plan
S-2	Roof Framing Plan & Framing Details
S-3	Foundation Details
S-4	Typical Details & General Notes
S-5	Pump Room Floor Sections & Details
M-1	Mechanical - HVAC
E-1	Legend
E-2	Site Plan
E-3	110V One Line Diagram
E-4	208V One Line Diagram
E-5	Control Schematics
E-6	Control Schematics
E-7	Schedules
E-8	Plan view - Power & Control
E-9	Plan view - Lighting & HVAC
E-10	Details
E-11	Details
E-12	Details
I-1	Instrumentation Diagram
I-2	Instrumentation Schedules
I-3	Instrumentation Details
I-4	Control Panel Schematics

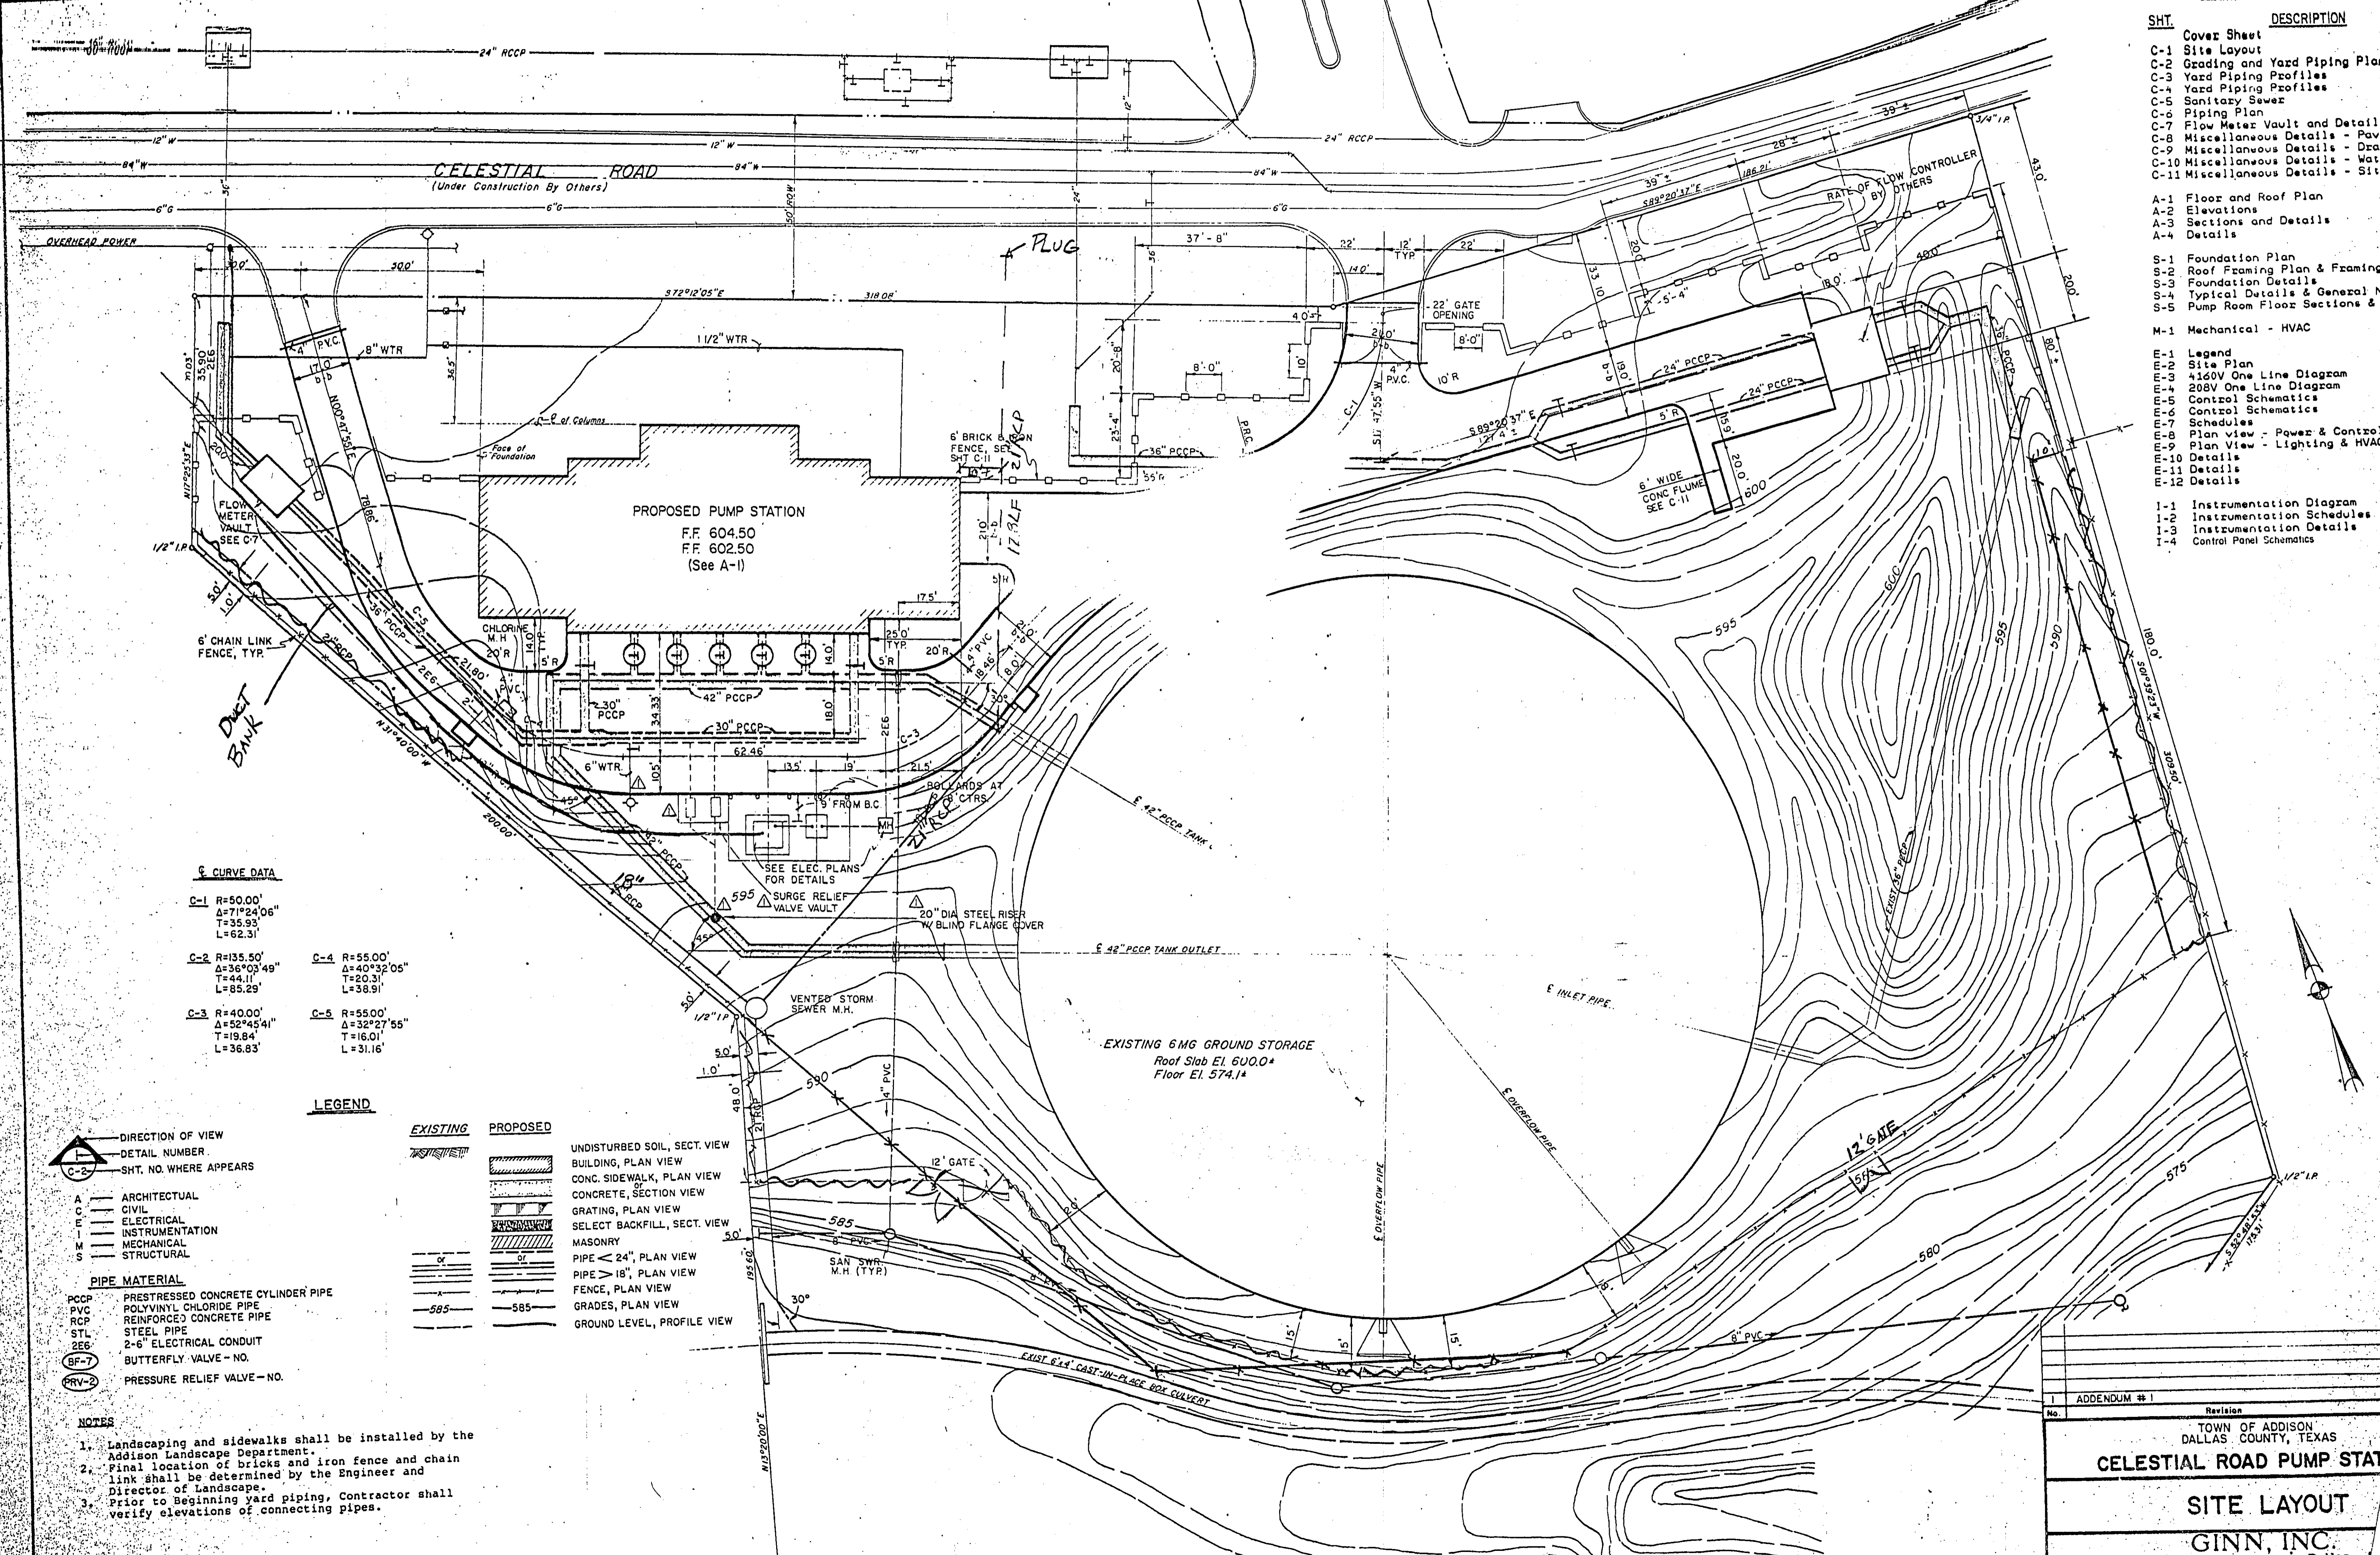

6 CURVE DATA

C-1	R=50.00' Δ=71°24'06" T=35.93' L=62.31'	C-4	R=55.00' Δ=40°32'05" T=20.31' L=38.91'
C-2	R=135.50' Δ=36°03'49" T=44.11' L=85.29'	C-5	R=55.00' Δ=32°27'55" T=16.01' L=31.16'
C-3	R=40.00' Δ=52°45'41" T=19.84' L=36.83'		

LEGEND

EXISTING	PROPOSED	DESCRIPTION
(Symbol)	(Symbol)	UNDISTURBED SOIL, SECT. VIEW
(Symbol)	(Symbol)	BUILDING, PLAN VIEW
(Symbol)	(Symbol)	CONC. SIDEWALK, PLAN VIEW
(Symbol)	(Symbol)	CONCRETE, SECTION VIEW
(Symbol)	(Symbol)	GRATING, PLAN VIEW
(Symbol)	(Symbol)	SELECT BACKFILL, SECT. VIEW
(Symbol)	(Symbol)	MASONRY
(Symbol)	(Symbol)	PIPE > 24", PLAN VIEW
(Symbol)	(Symbol)	PIPE > 18", PLAN VIEW
(Symbol)	(Symbol)	FENCE, PLAN VIEW
(Symbol)	(Symbol)	GRADES, PLAN VIEW
(Symbol)	(Symbol)	GROUND LEVEL, PROFILE VIEW

PIPE MATERIAL	DESCRIPTION
PCCP	PRESTRESSED CONCRETE CYLINDER PIPE
PVC	POLYVINYL CHLORIDE PIPE
RCP	REINFORCED CONCRETE PIPE
STL	STEEL PIPE
2EG	2-6" ELECTRICAL CONDUIT
BF-7	BUTTERFLY VALVE - NO.
PRV-2	PRESSURE RELIEF VALVE - NO.

- NOTES**
- Landscaping and sidewalks shall be installed by the Addison Landscape Department.
 - Final location of bricks and chain link shall be determined by the Engineer and Director of Landscape.
 - Prior to beginning yard piping, Contractor shall verify elevations of connecting pipes.

ADDENDUM #1		Revision	
TOWN OF ADDISON DALLAS COUNTY, TEXAS			
CELESTIAL ROAD PUMP STAT			
SITE LAYOUT			
GINN, INC.			
Consulting Engineers Dallas			
Designed - RCH	Drawn - GAP	Date - JAN, 1987	Jr
Approved - HWG	Checked - GAF	Scale - 1"=20'	Sr

Randall C. Hill
2-19-1987