


STORM DRAINAGE LINE 2

STORM DRAINAGE LINE 2

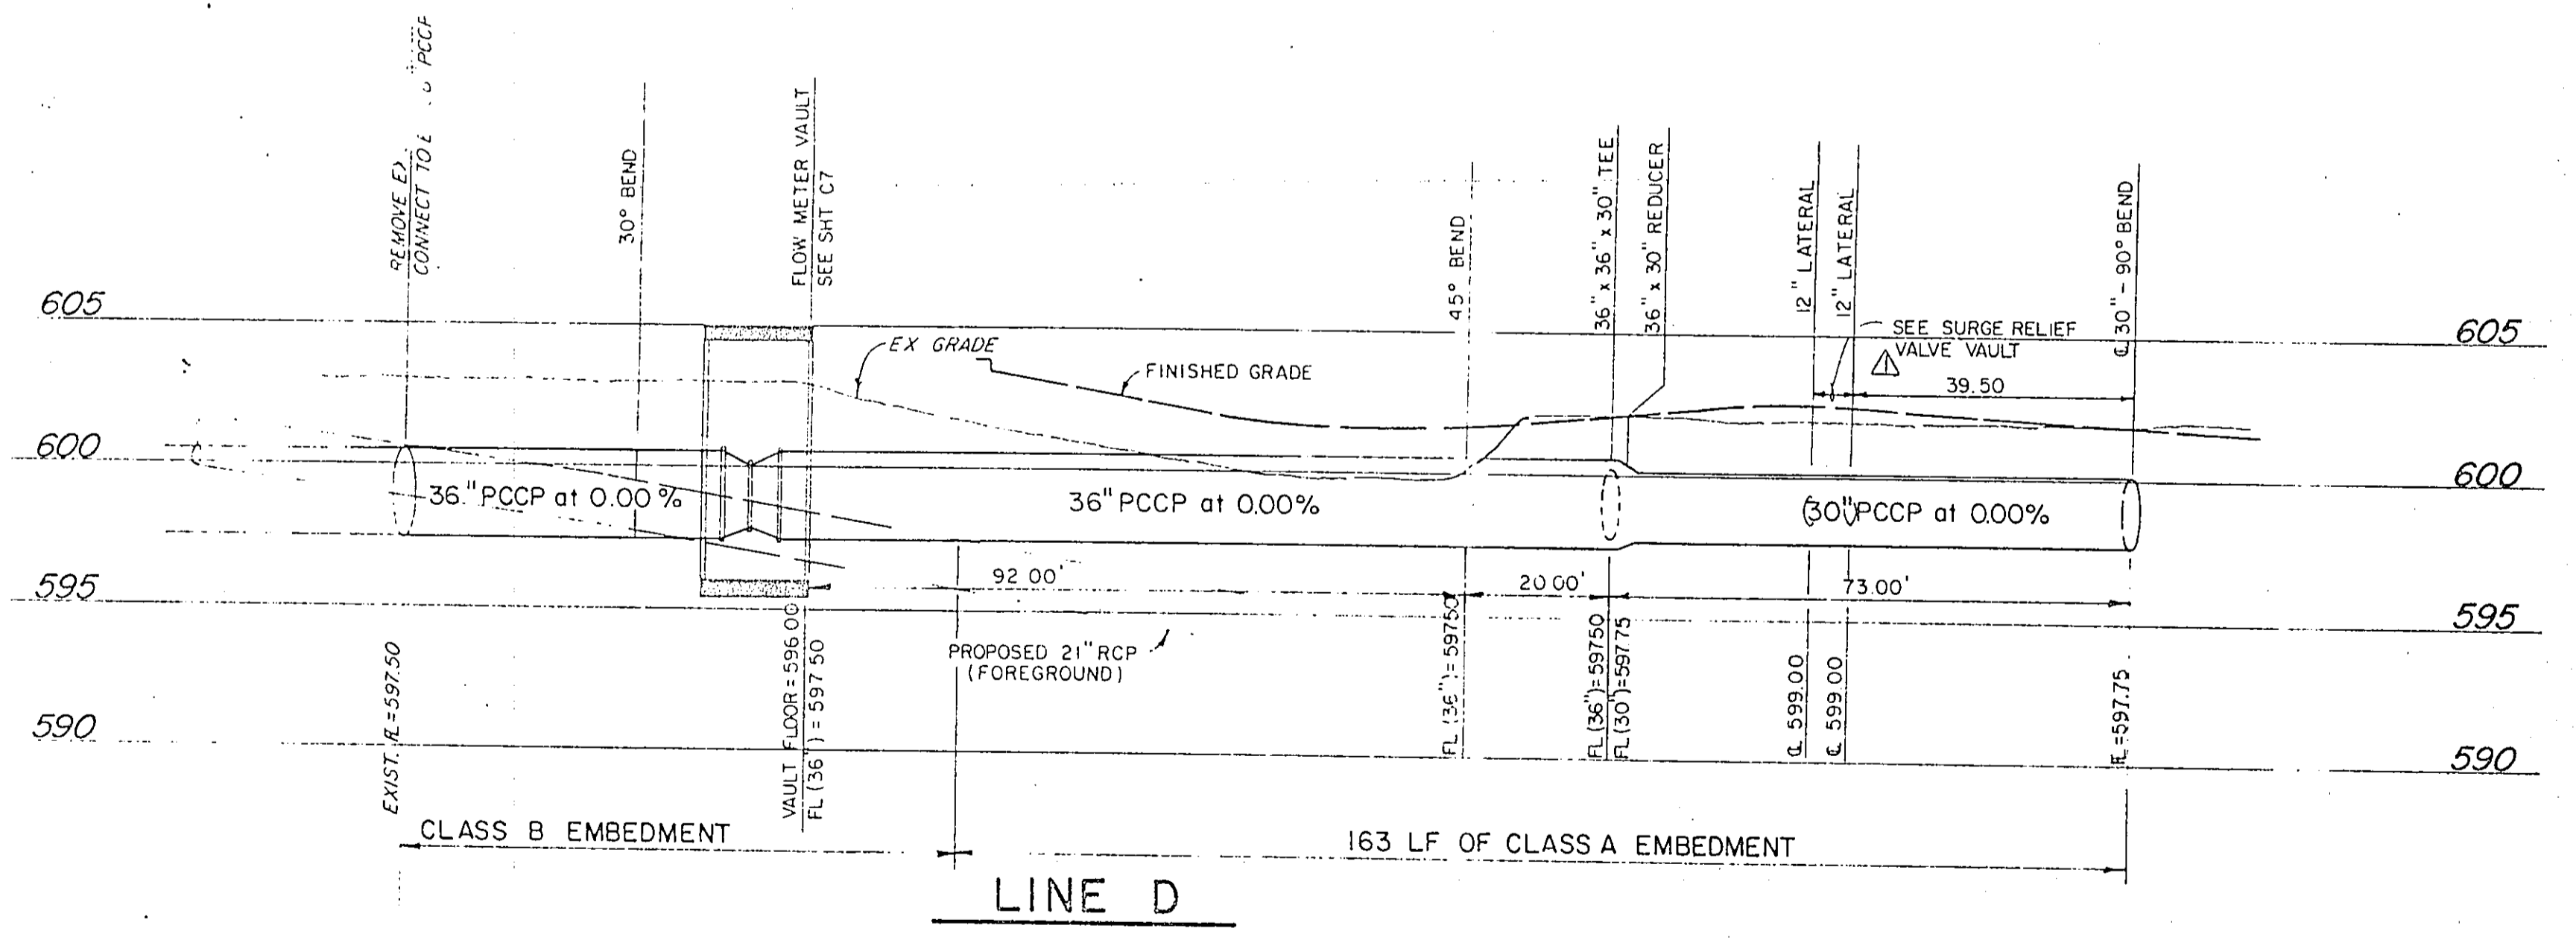

No.	Revision	By	Date
1	ADDENDUM #1	RCH	3-20-87
TOWN OF ADDISON DALLAS COUNTY, TEXAS			
CELESTIAL ROAD PUMP STATION			
YARD PIPING PROFILES			
GINN, INC. Consulting Engineers Dallas, Texas			