



PAY ITEM	DESCRIPTION	UNIT	QTY
465.5	8" PVC SEWER PIPE SDR-35	LF	240
465.8	4' DIAMETER M.H.	EA	3

B.M. "O" CUT ON HEADWALL, EAST SIDE OF WINWOOD, 180' SOUTH OF BELT LINE ROAD. ELEV. 555.79 (M.S.L.)


B.M. "Q" CUT CENTER FRONT PORCH 5555 CELESTIAL ROAD. ELEV. 577.95 (M.S.L.)

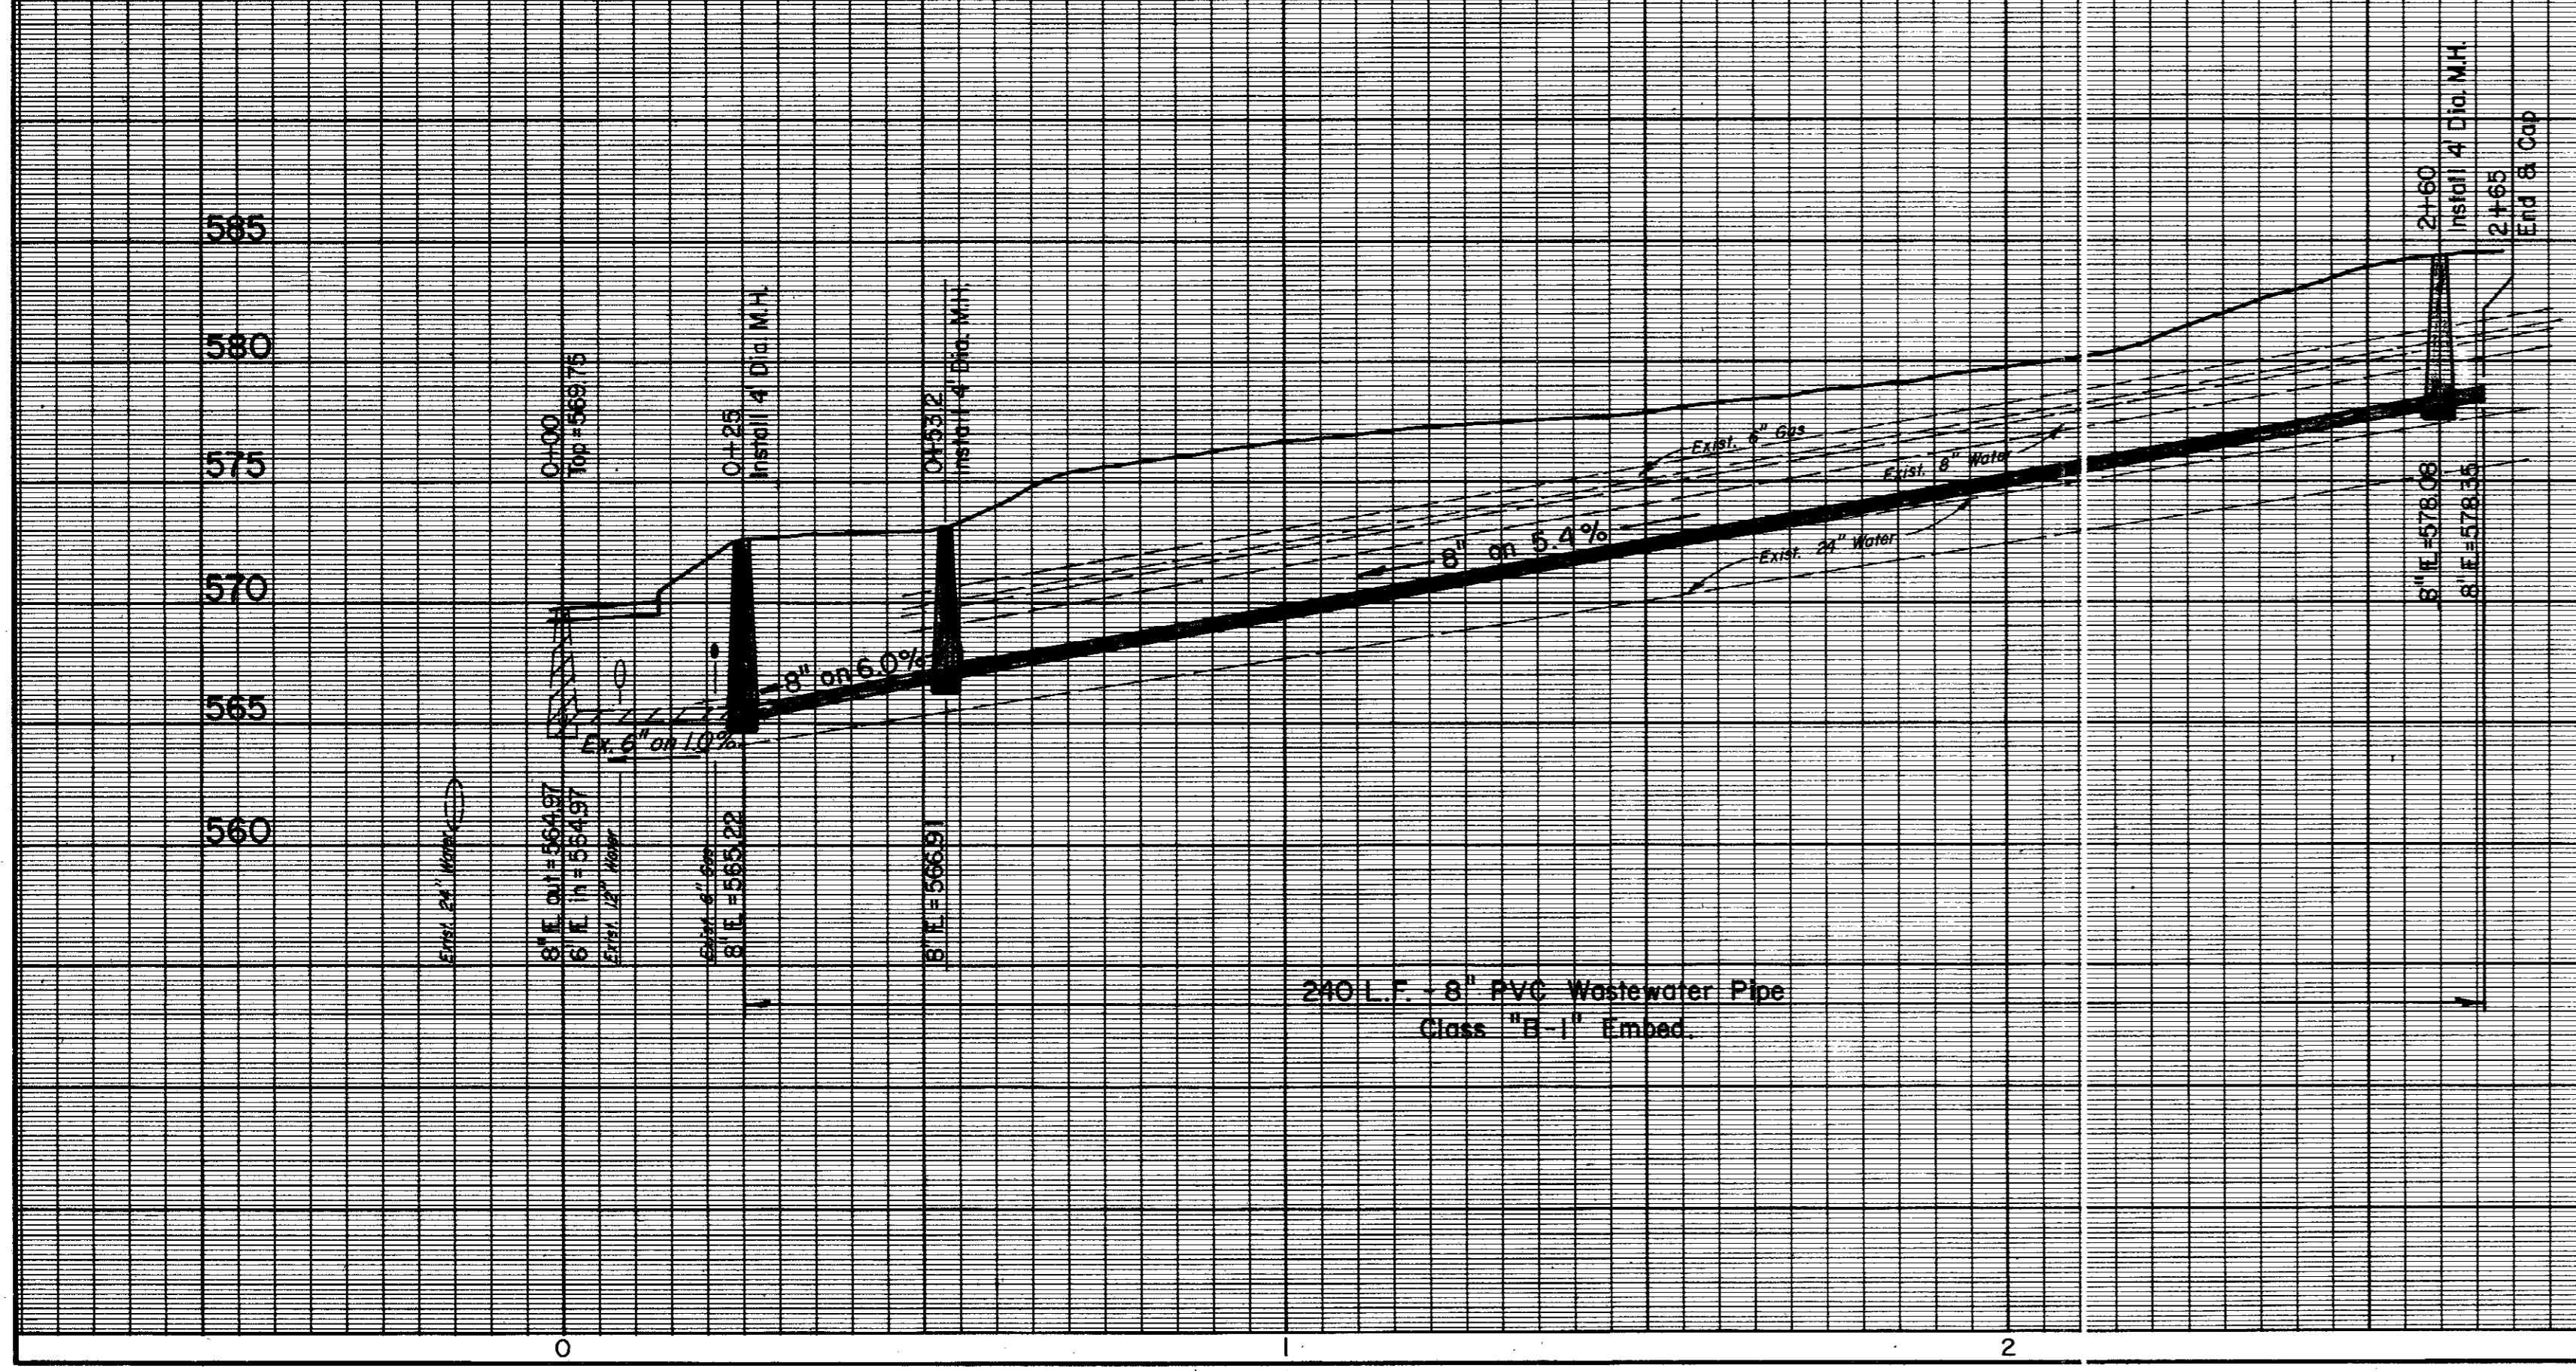

RECORD DRAWING 110

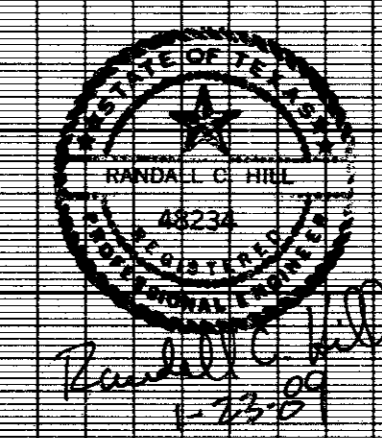

WATER & SANITARY SEWER						
WINWOOD RD. SAN. SWR. IMPROVEMENTS						
PLAN & PROFILE						
WATER UTILITIES DEPARTMENT						
CITY OF DALLAS, TEXAS						
DESIGN	DRAWN	DATE	SCALE	NOTES	FILE	NO.
TEC	TEC	DEC. 1988	1" = 20' H 1" = 6' V		411Q	1960

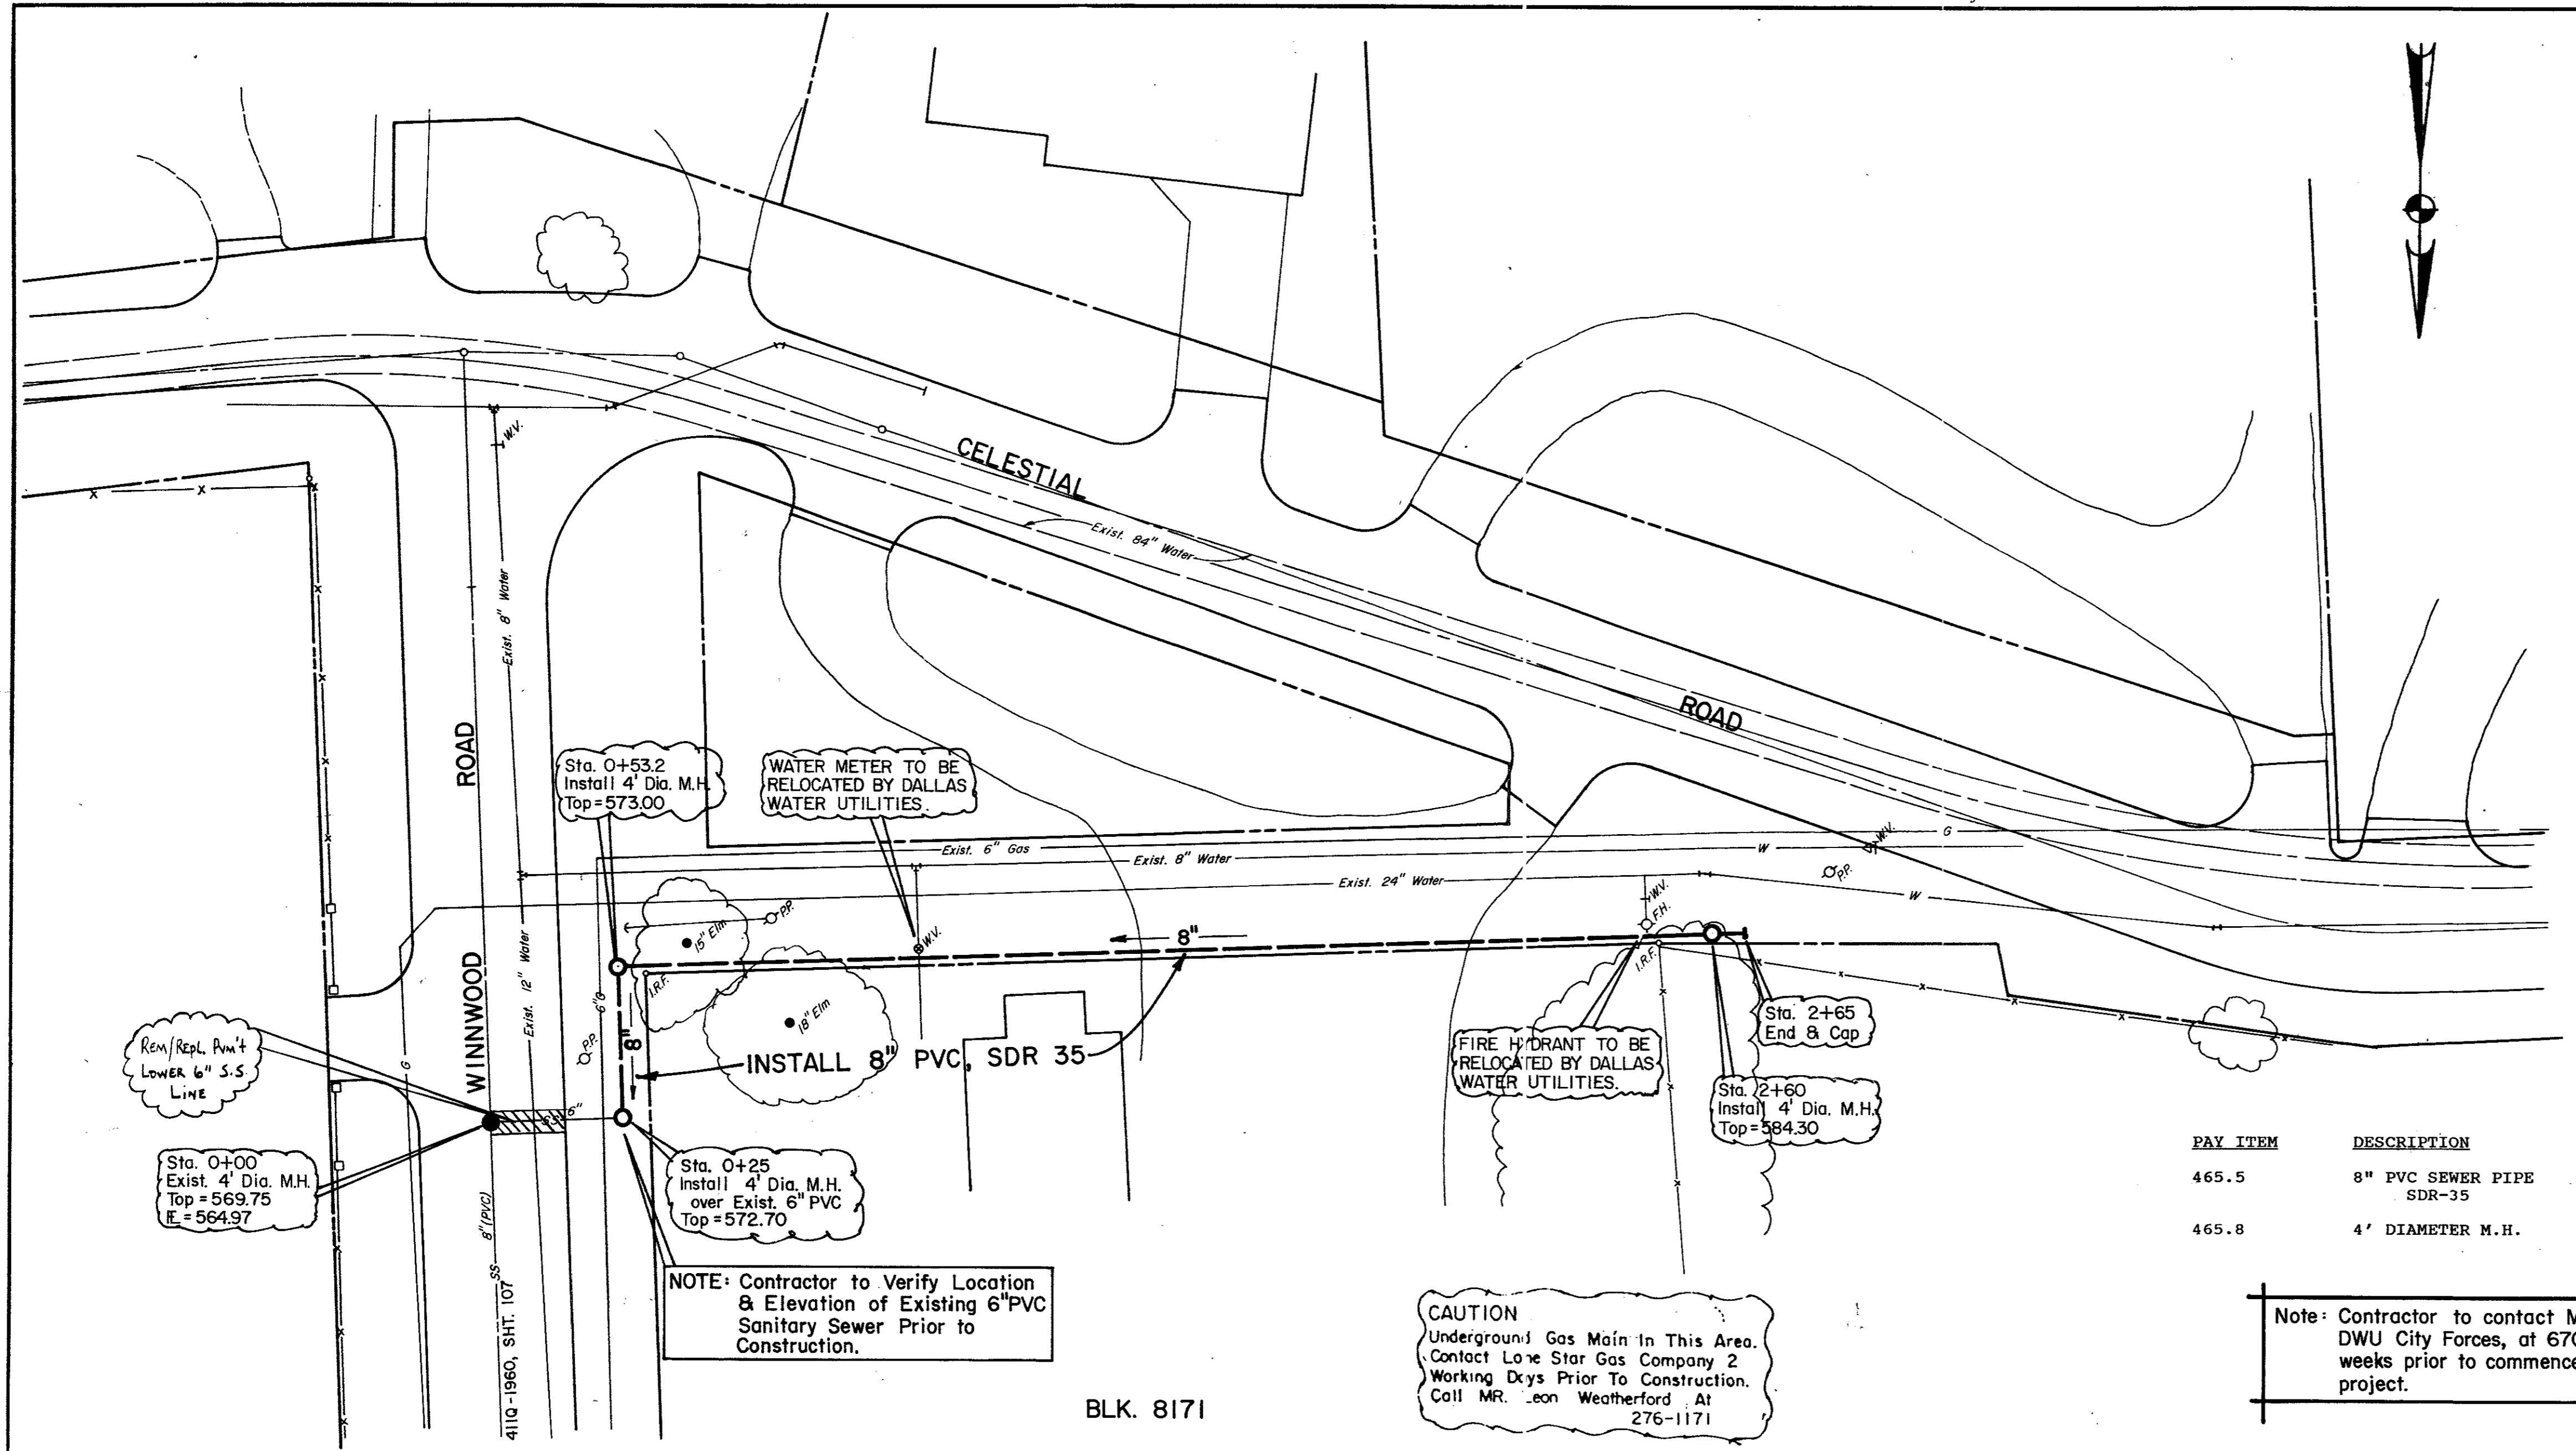


PAY ITEM	DESCRIPTION	UNIT	QTY
465.5	8" PVC SEWER PIPE SDR-35	LF	240
465.8	4' DIAMETER M.H.	EA	3


CAUTION
 Underground Gas Main In This Area.
 Contact Lone Star Gas Company 2
 Working Days Prior To Construction.
 Call MR. Leon Weatherford At
 276-1171

Note: Contractor to contact M. Parsley, Manager of DWU City Forces, at 670-8692, at least two weeks prior to commencement of work on this project.


B.M. "D" CUT ON HEADWALL, EAST SIDE OF WINNWOOD, 180' SOUTH OF BELT LINE ROAD. ELEV. 555.79 (M.S.L.)
 B.M. "I" CUT CENTER FRONT PORCH 5555 CELESTIAL ROAD. ELEV. 577.95 (M.S.L.)

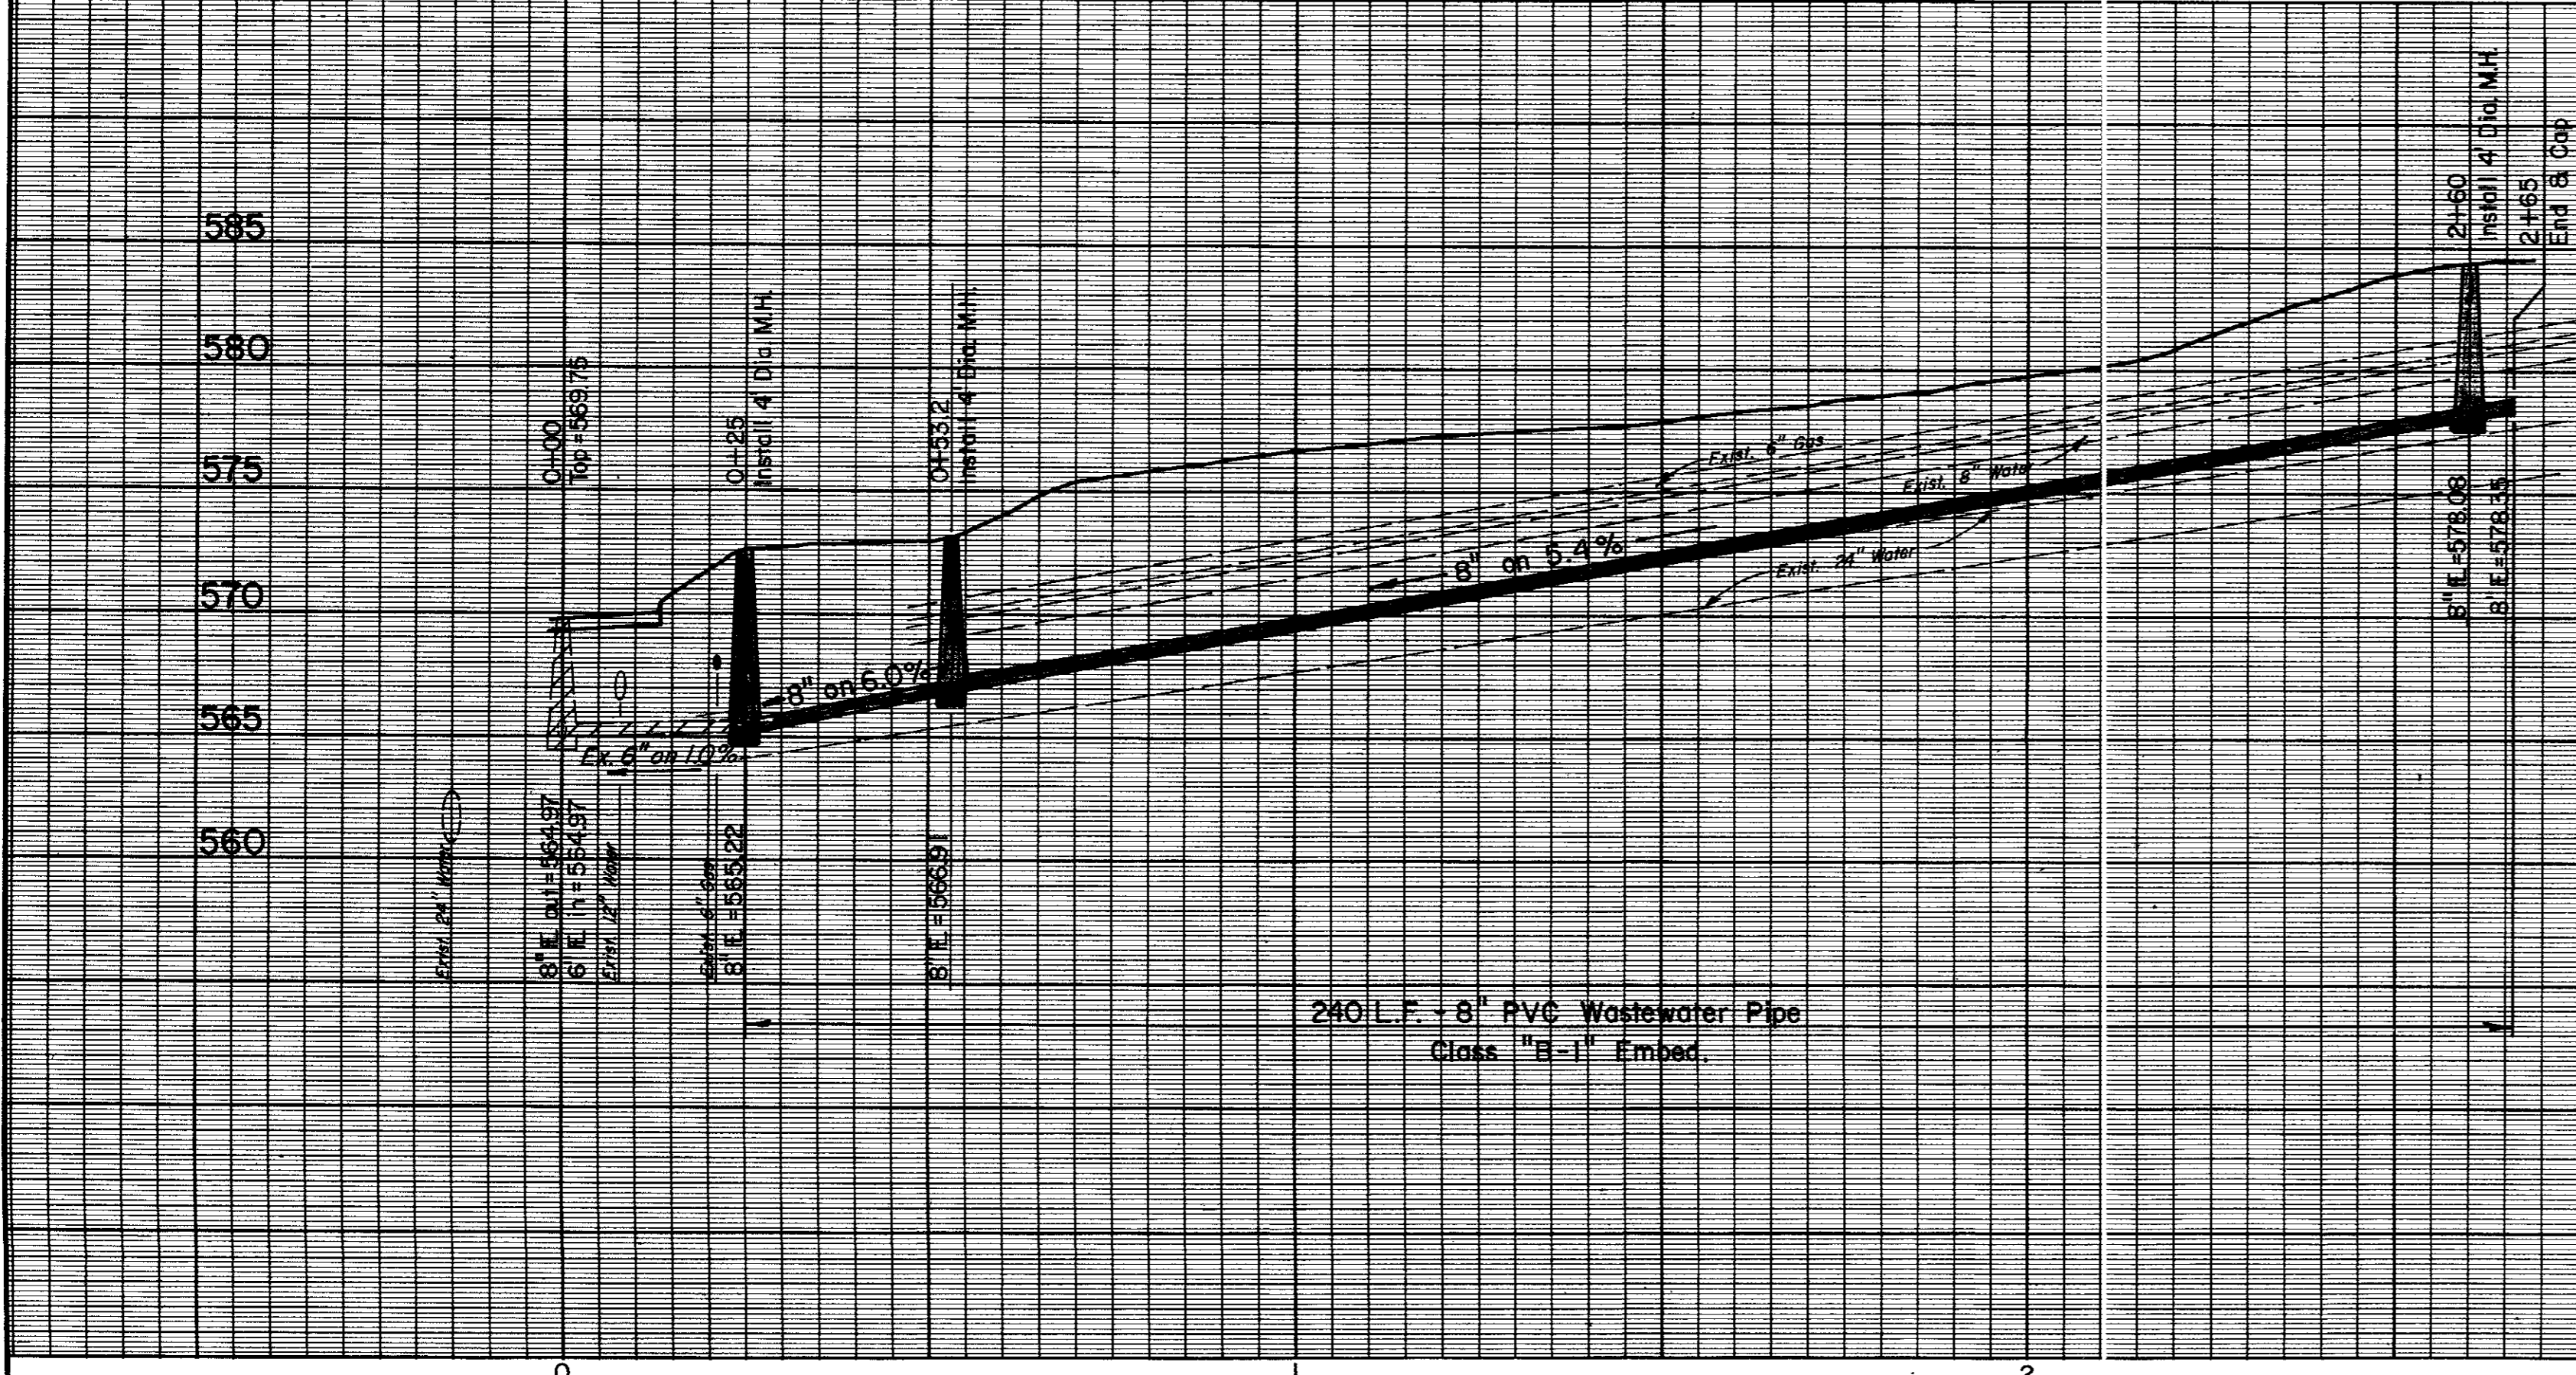

RECORD DRAWING 110

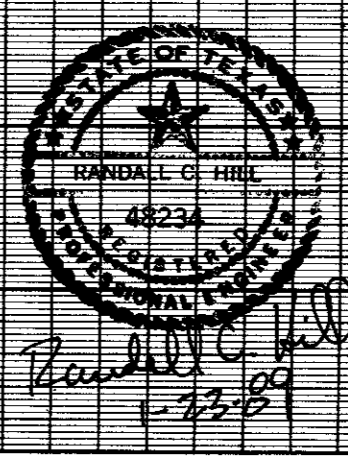

WATER & SANITARY SEWER						
WINNWOOD RD. SAN. SWR. IMPROVEMENTS						
PLAN & PROFILE						
WATER UTILITIES DEPARTMENT						
CITY OF DALLAS, TEXAS						
DESIGN	DRAWN	DATE	SCALE	NOTES	FILE	NO.
TEC	TEC	DEC. 1988	1" = 20' H 1" = 6' V		411Q	1960

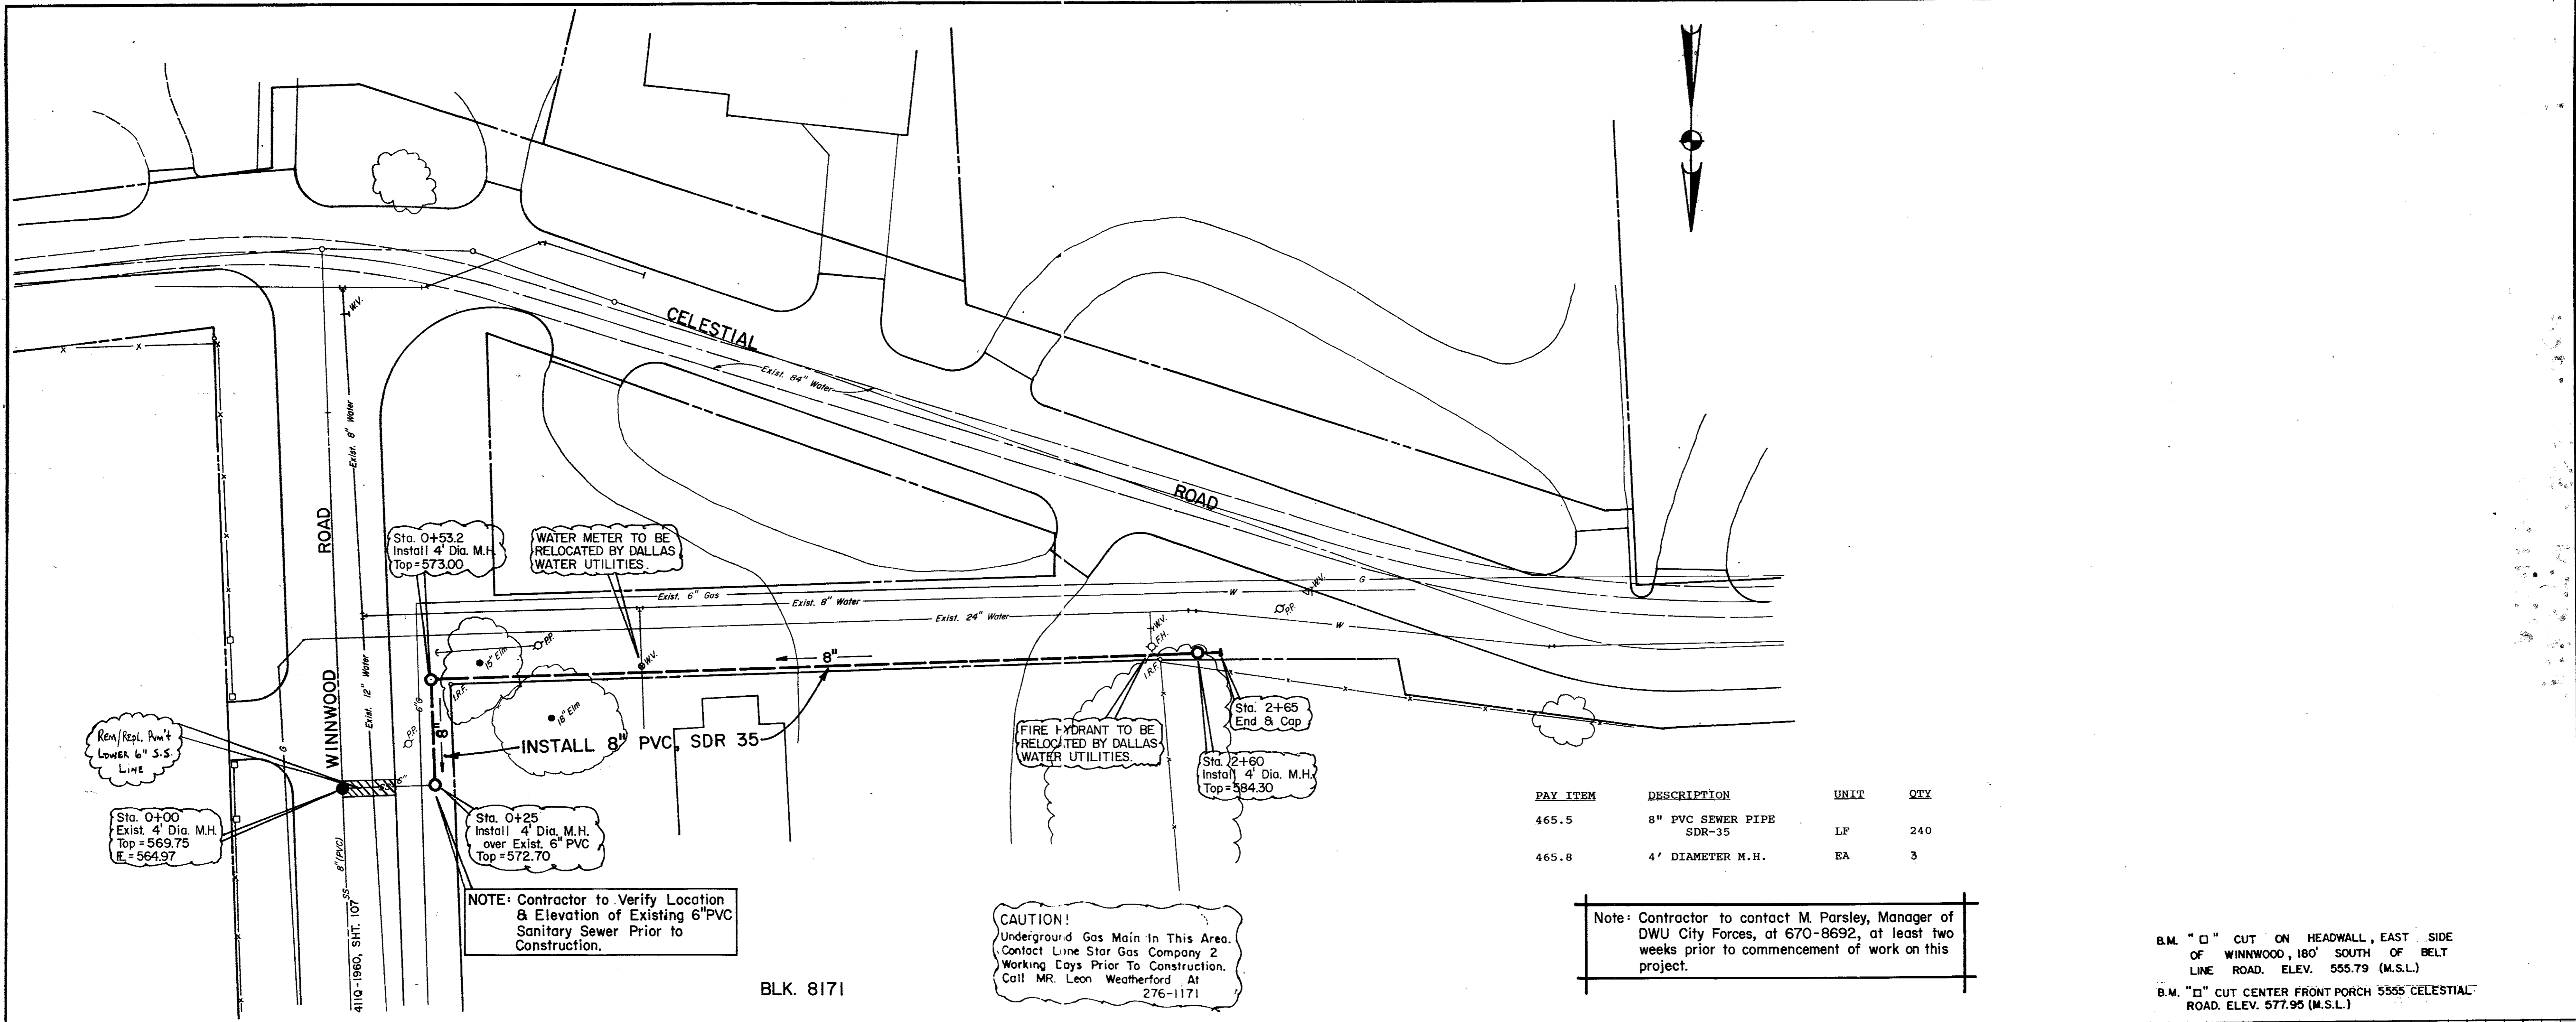

PAY ITEM	DESCRIPTION	UNIT	QTY
465.5	8" PVC SEWER PIPE SDR-35	LF	240
465.8	4' DIAMETER M.H.	EA	3


NOTE: Contractor to Verify Location & Elevation of Existing 6" PVC Sanitary Sewer Prior to Construction.

CAUTION!
Underground Gas Main in This Area. Contact Line Star Gas Company 2 Working Days Prior To Construction. Call MR. Leon Weatherford At 276-1171

Note: Contractor to contact M. Parsley, Manager of DWU City Forces, at 670-8692, at least two weeks prior to commencement of work on this project.


B.M. "□" CUT ON HEADWALL, EAST SIDE OF WINNWOOD, 180' SOUTH OF BELT LINE ROAD. ELEV. 555.79 (M.S.L.)
B.M. "□" CUT CENTER FRONT PORCH 5555' CELESTIAL ROAD. ELEV. 577.95 (M.S.L.)

BLK. 8171

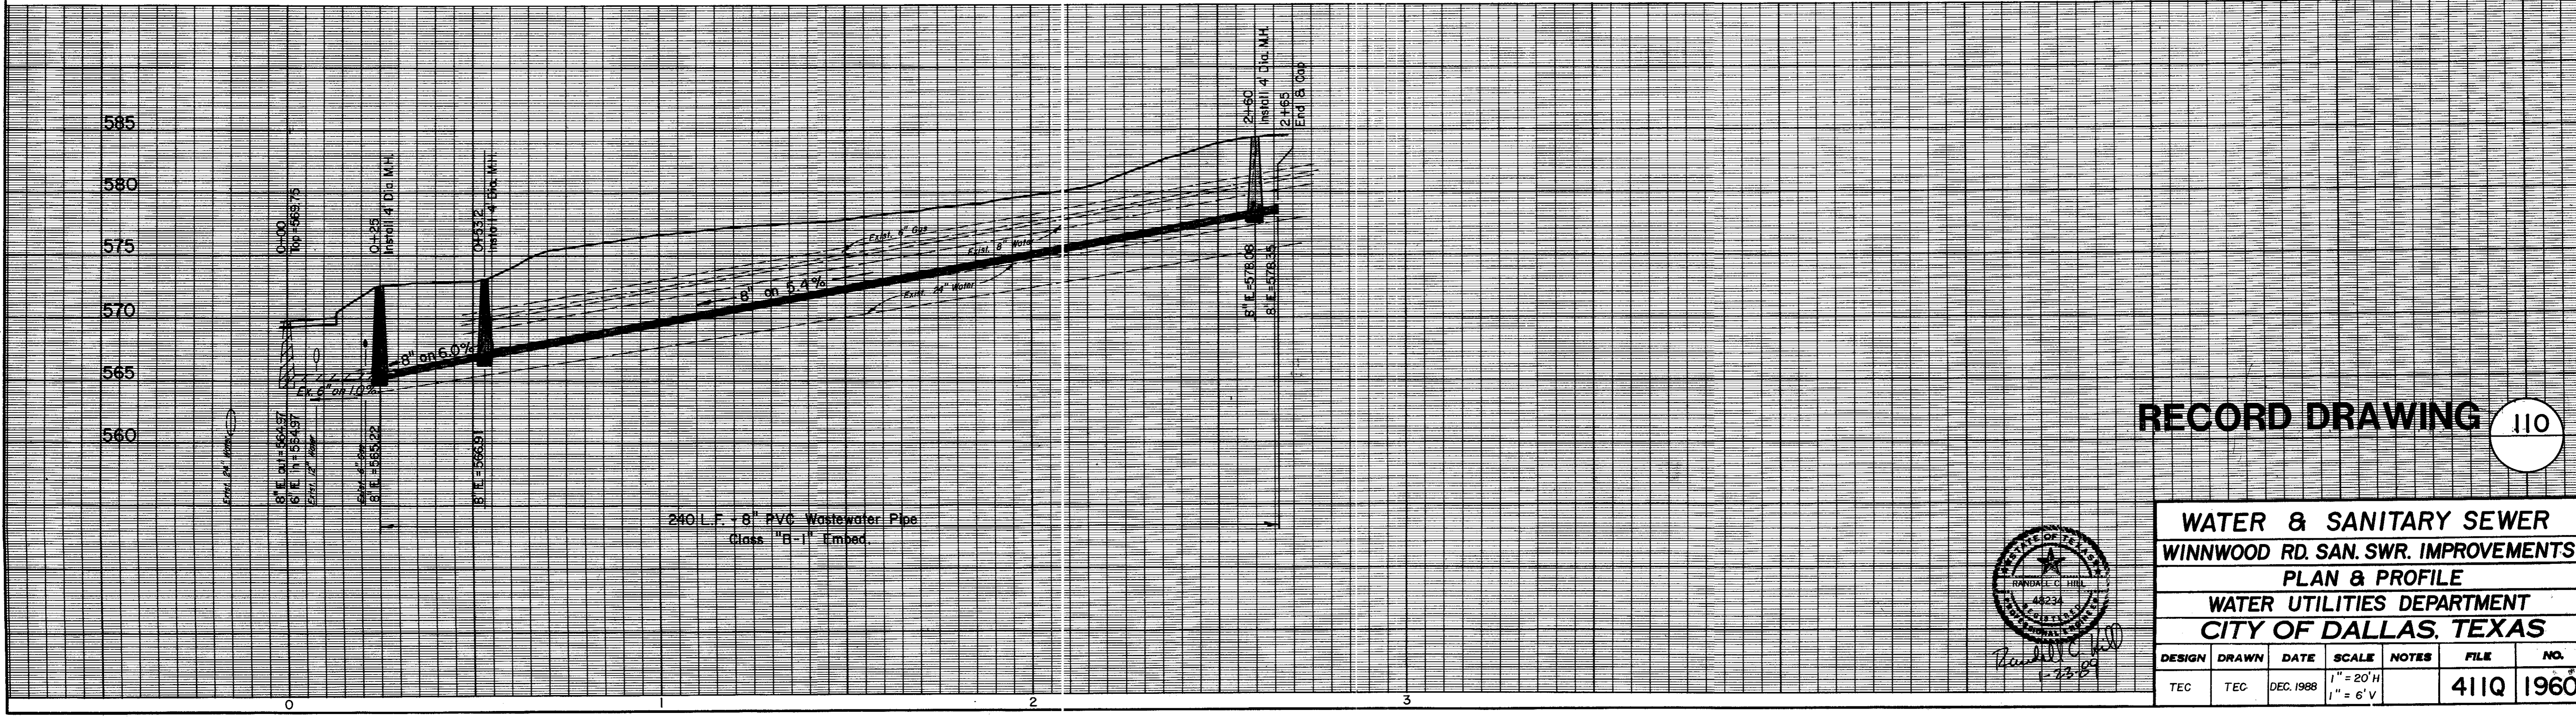


240 LF - 8" PVC Wastewater Pipe Class "B-1" Embed.

RECORD DRAWING 110

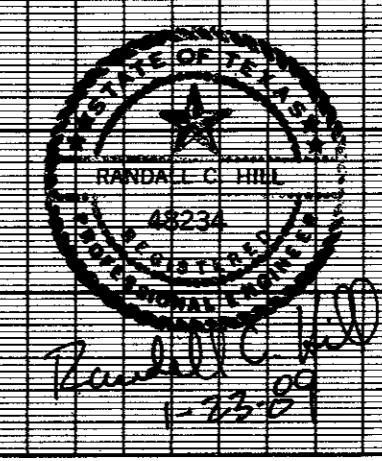

WATER & SANITARY SEWER
WINNWOOD RD. SAN. SWR. IMPROVEMENTS
PLAN & PROFILE
WATER UTILITIES DEPARTMENT
CITY OF DALLAS, TEXAS

DESIGN	DRAWN	DATE	SCALE	NOTES	FILE	NO.
TEC	TEC	DEC. 1988	1" = 20' H 1" = 6' V		411Q	1960

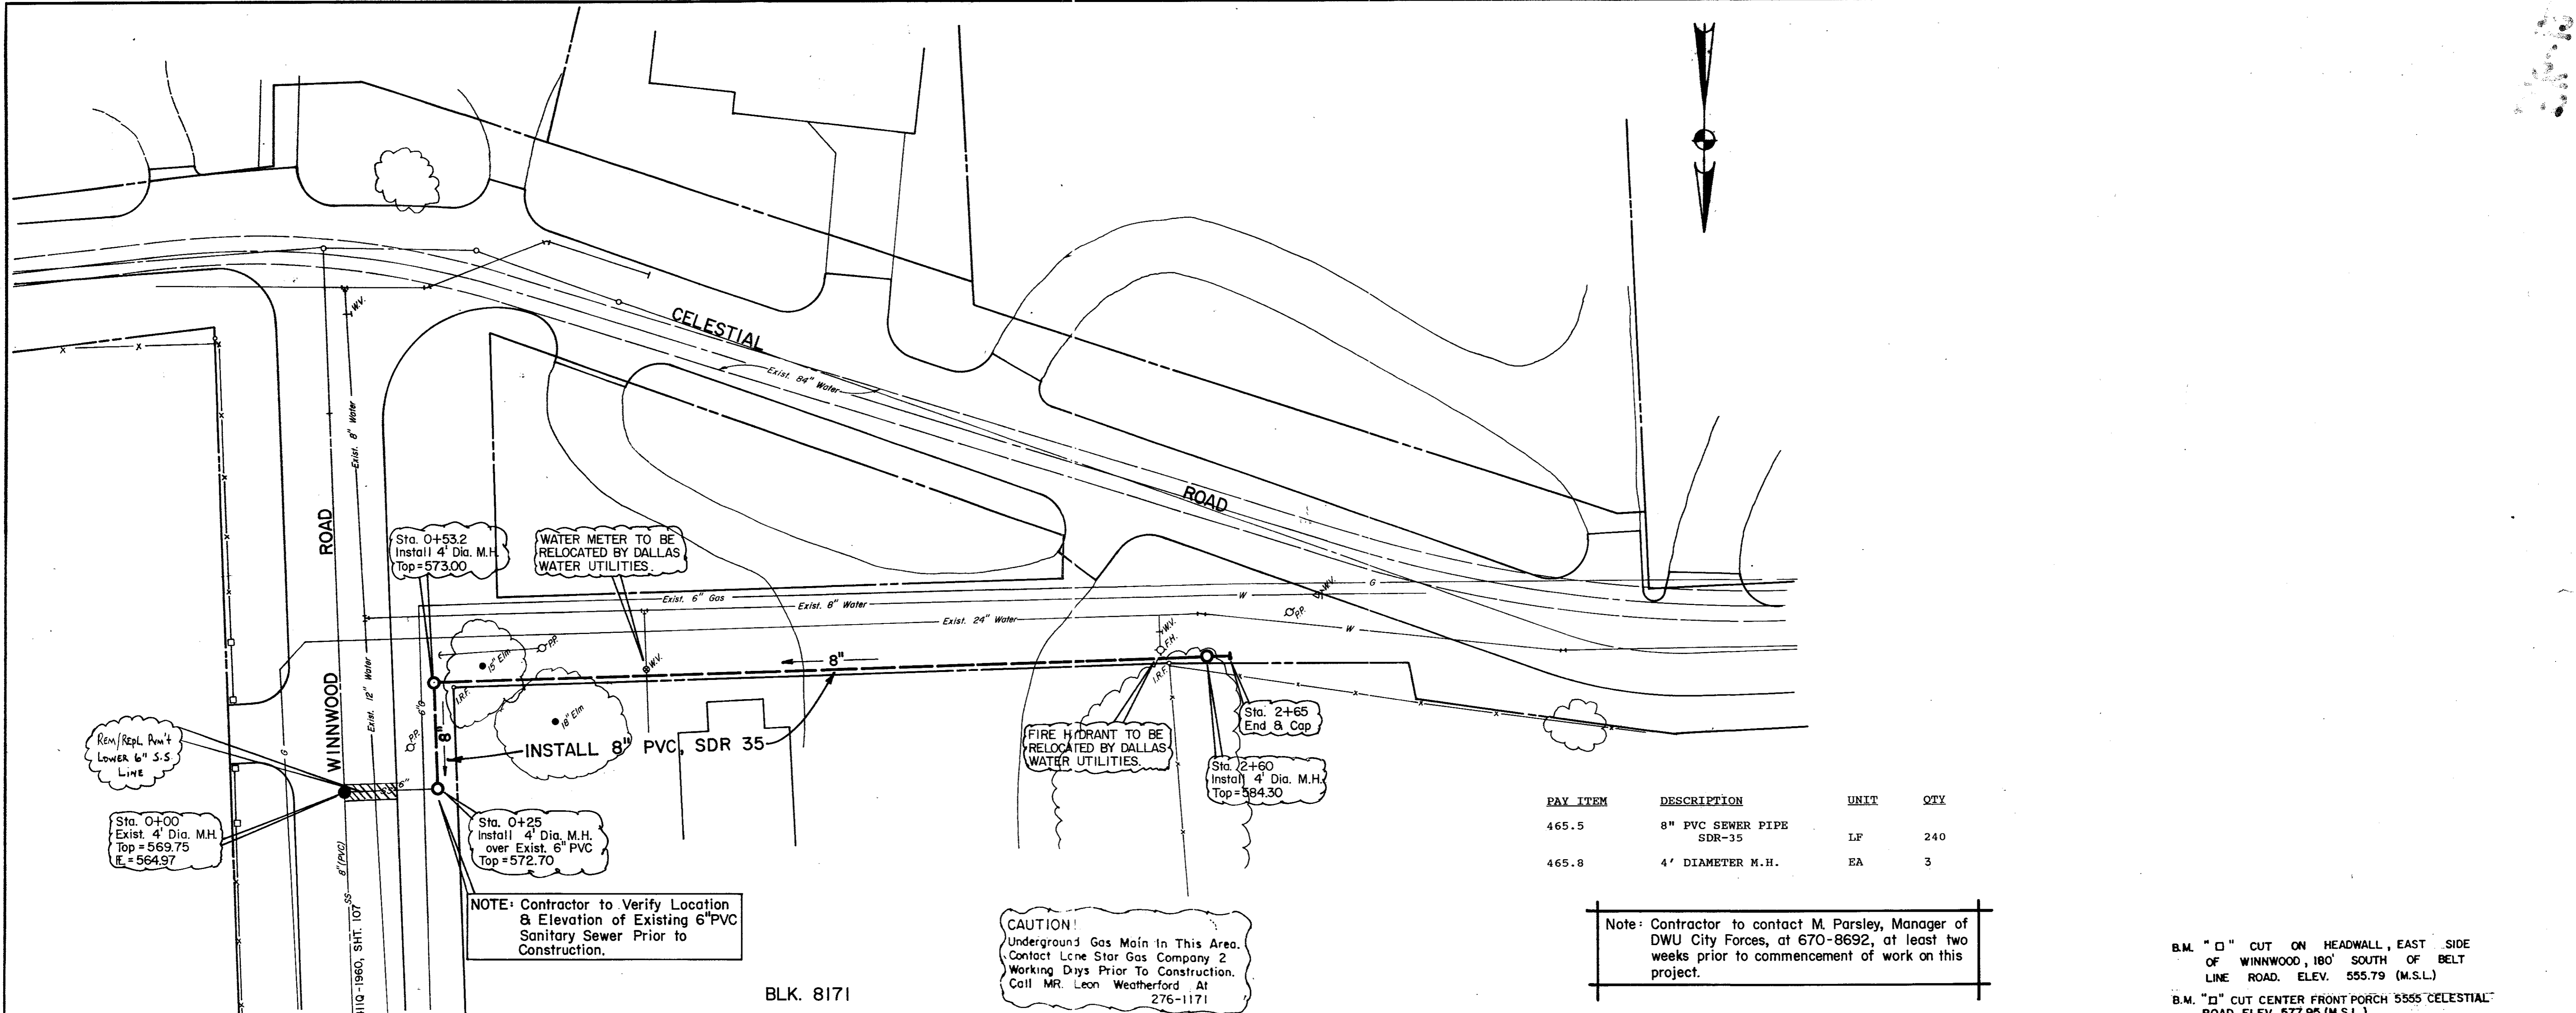

PAY ITEM	DESCRIPTION	UNIT	QTY
465.5	8" PVC SEWER PIPE SDR-35	LF	240
465.8	4' DIAMETER M.H.	EA	3


NOTE: Contractor to Verify Location & Elevation of Existing 6" PVC Sanitary Sewer Prior to Construction.

CAUTION!
Underground Gas Main in This Area.
Contact Lone Star Gas Company 2
Working Days Prior To Construction.
Call MR. Leon Weatherford At
276-1171

Note: Contractor to contact M. Parsley, Manager of DWU City Forces, at 670-8692, at least two weeks prior to commencement of work on this project.

B.M. "O" CUT ON HEADWALL, EAST SIDE OF WINNWOOD, 180' SOUTH OF BELT LINE ROAD. ELEV. 555.79 (M.S.L.)
B.M. "D" CUT CENTER FRONT PORCH 5555 CELESTIAL ROAD. ELEV. 577.95 (M.S.L.)


BLK. 8171

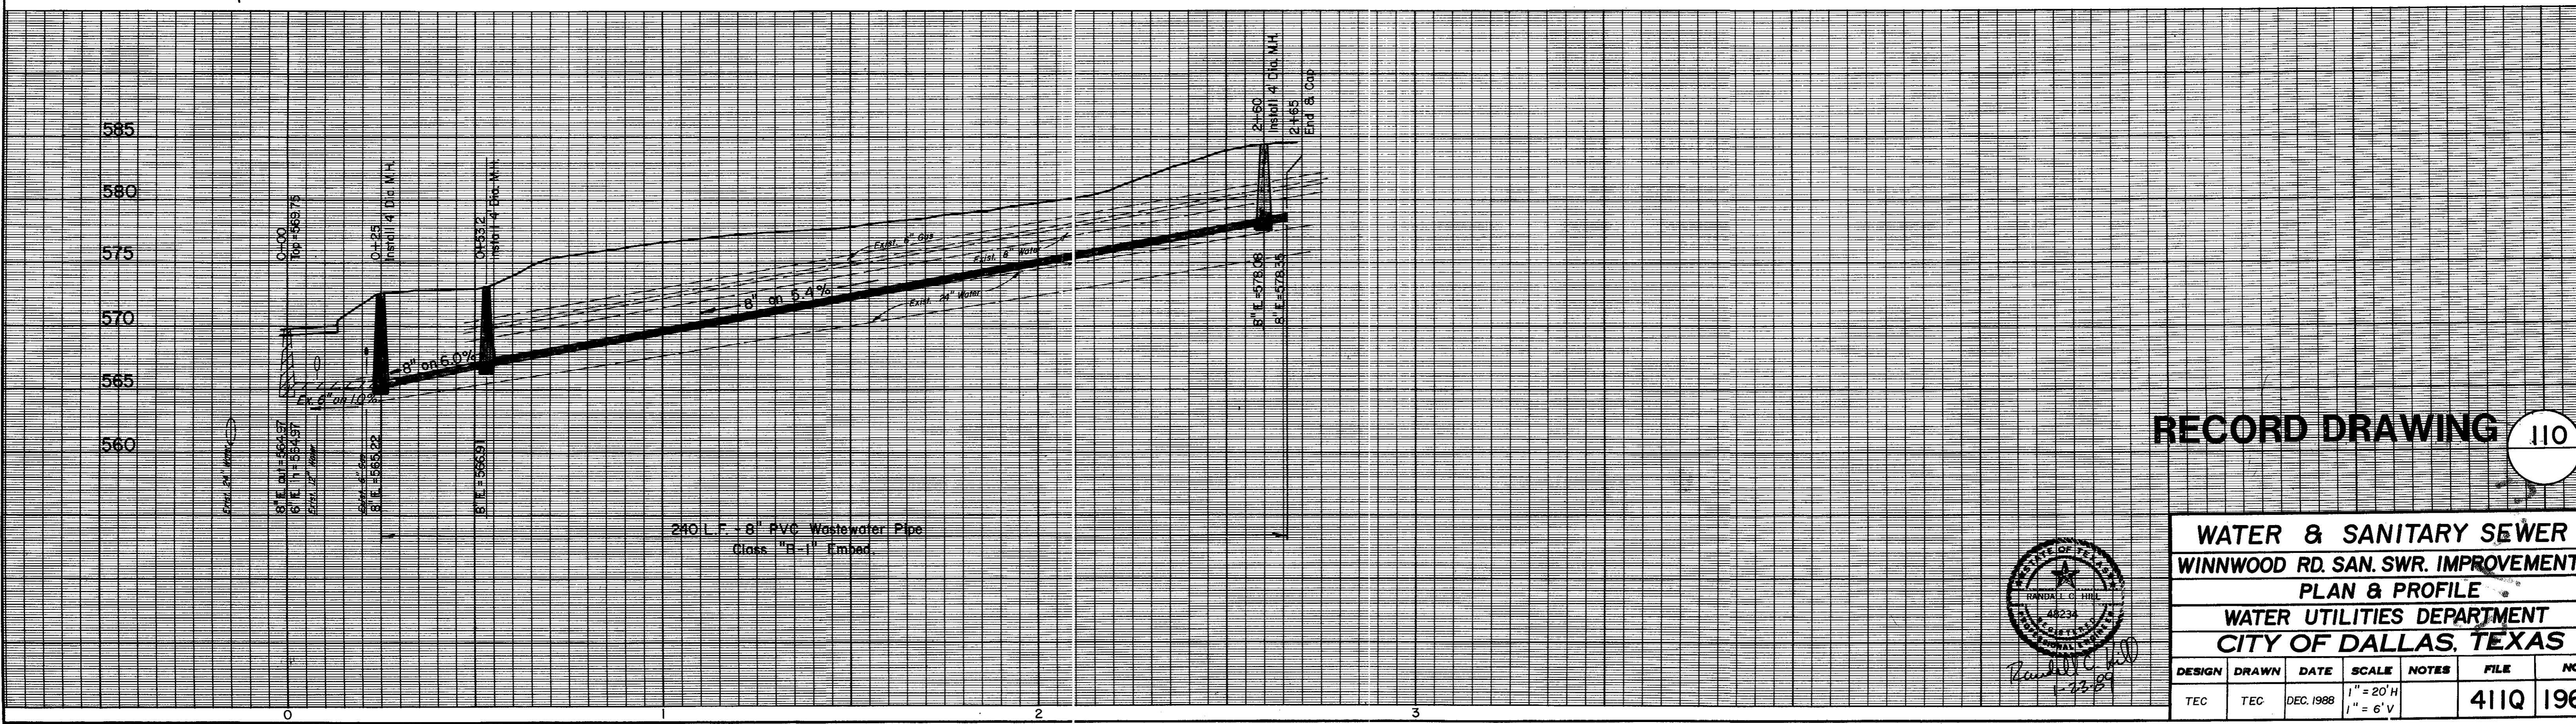


RECORD DRAWING 110

WATER & SANITARY SEWER
WINNWOOD RD. SAN. SWR. IMPROVEMENTS
PLAN & PROFILE
WATER UTILITIES DEPARTMENT
CITY OF DALLAS, TEXAS

DESIGN	DRAWN	DATE	SCALE	NOTES	FILE	NO.
TEC	TEC	DEC. 1988	1" = 20' H 1" = 6' V		411Q	1960

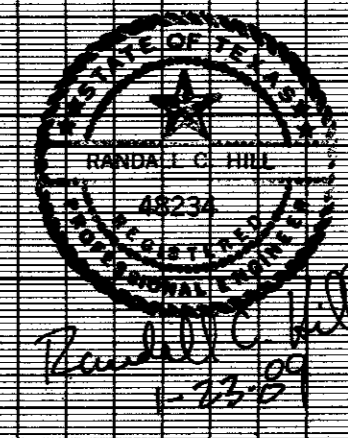

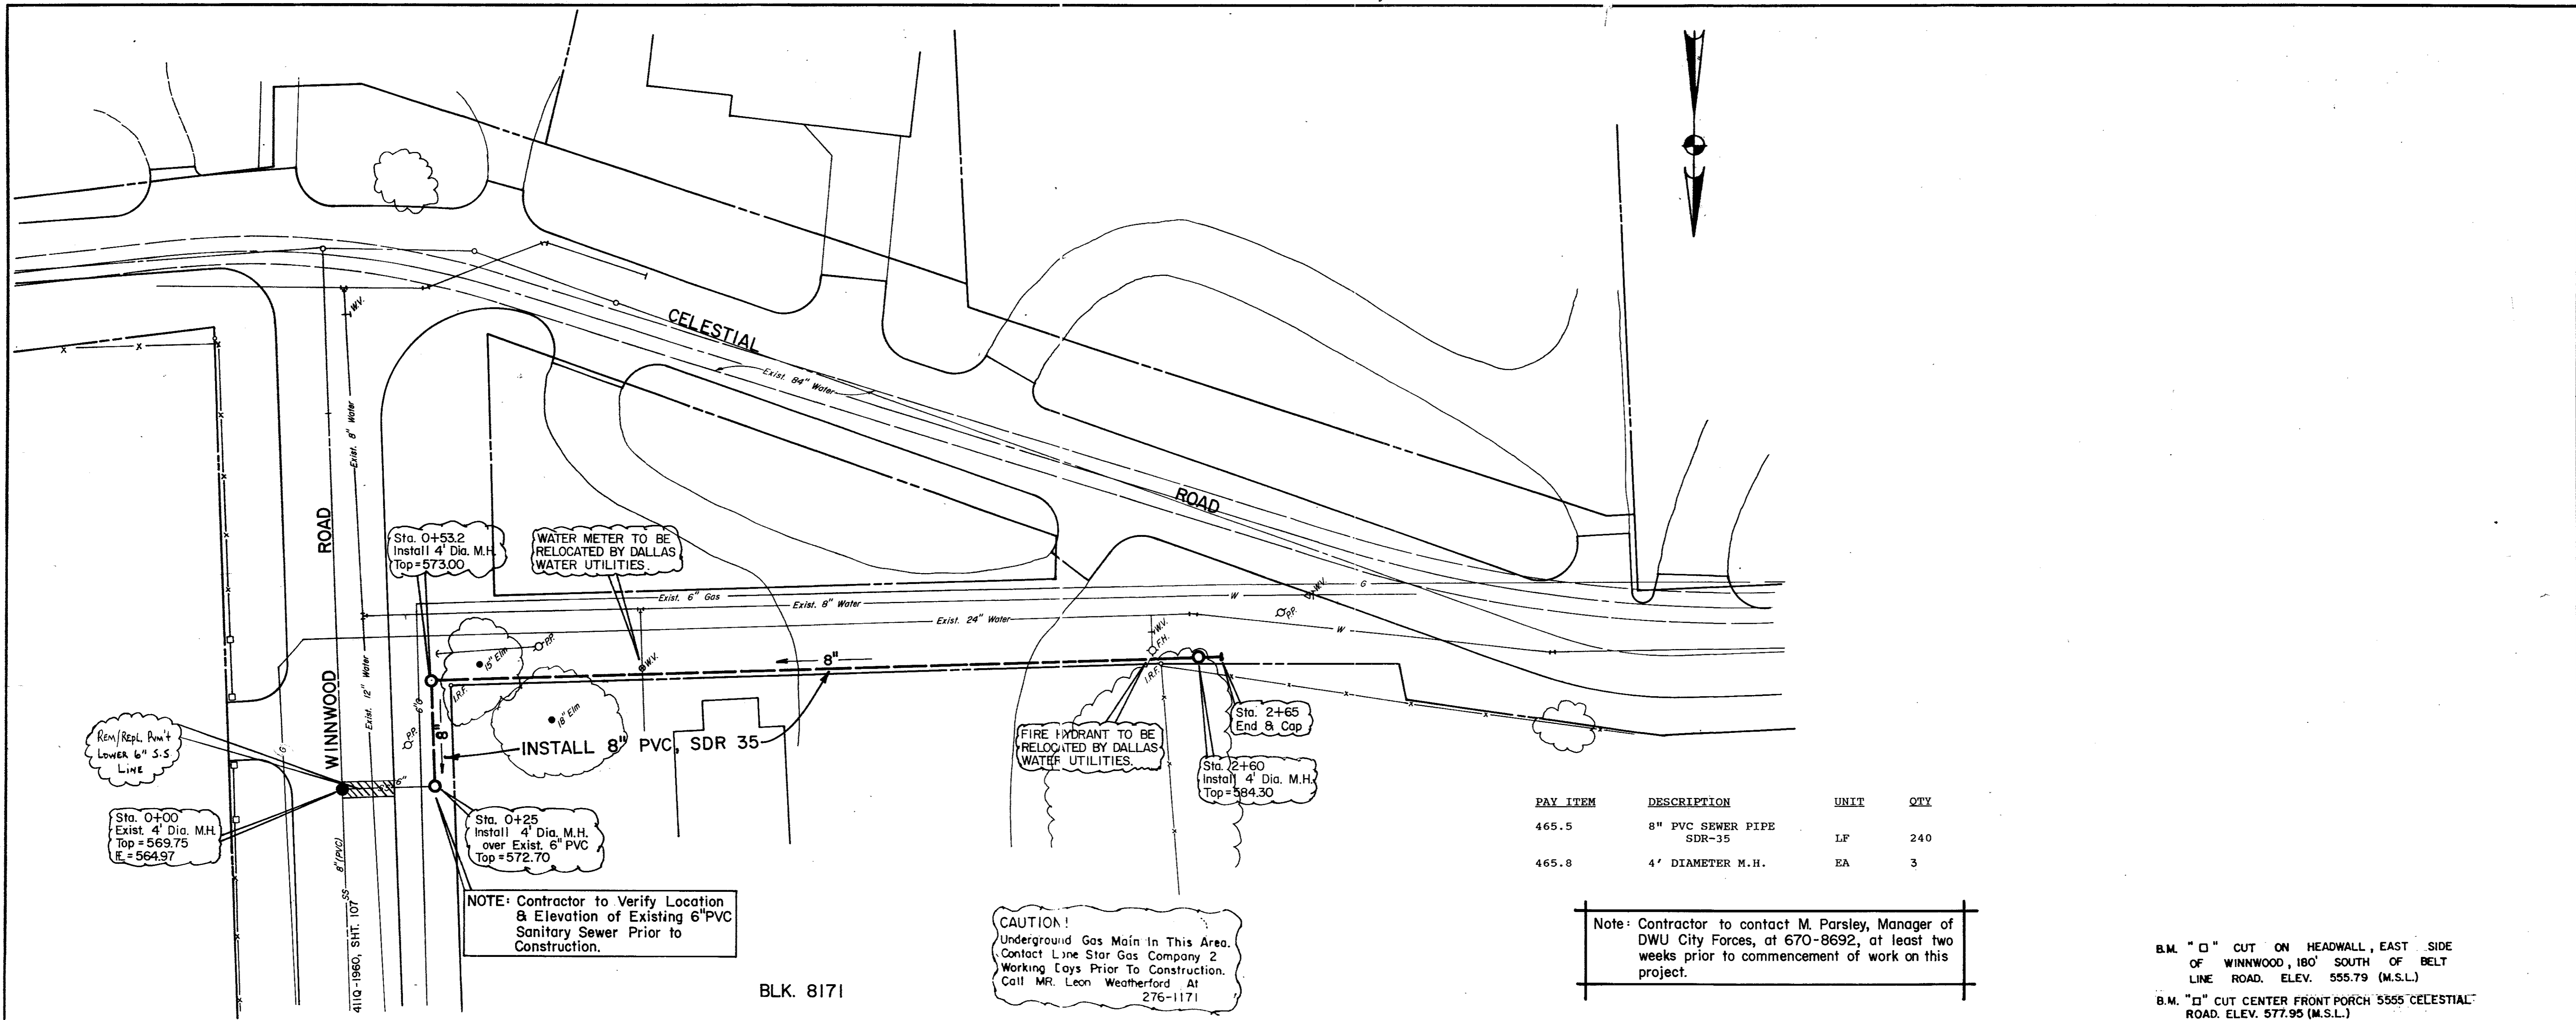

PAY ITEM	DESCRIPTION	UNIT	QTY
465.5	8" PVC SEWER PIPE SDR-35	LF	240
465.8	4' DIAMETER M.H.	EA	3


NOTE: Contractor to Verify Location & Elevation of Existing 6" PVC Sanitary Sewer Prior to Construction.

CAUTION!
Underground Gas Main in This Area.
Contact Lone Star Gas Company 2
Working Days Prior To Construction.
Call MR. Leon Weatherford At
276-1171

Note: Contractor to contact M. Parsley, Manager of DWU City Forces, at 670-8692, at least two weeks prior to commencement of work on this project.

B.M. "□" CUT ON HEADWALL, EAST SIDE OF WINNWOOD, 180' SOUTH OF BELT LINE ROAD. ELEV. 555.79 (M.S.L.)
B.M. "□" CUT CENTER FRONT PORCH 5555 CELESTIAL ROAD. ELEV. 577.95 (M.S.L.)

BLK. 8171

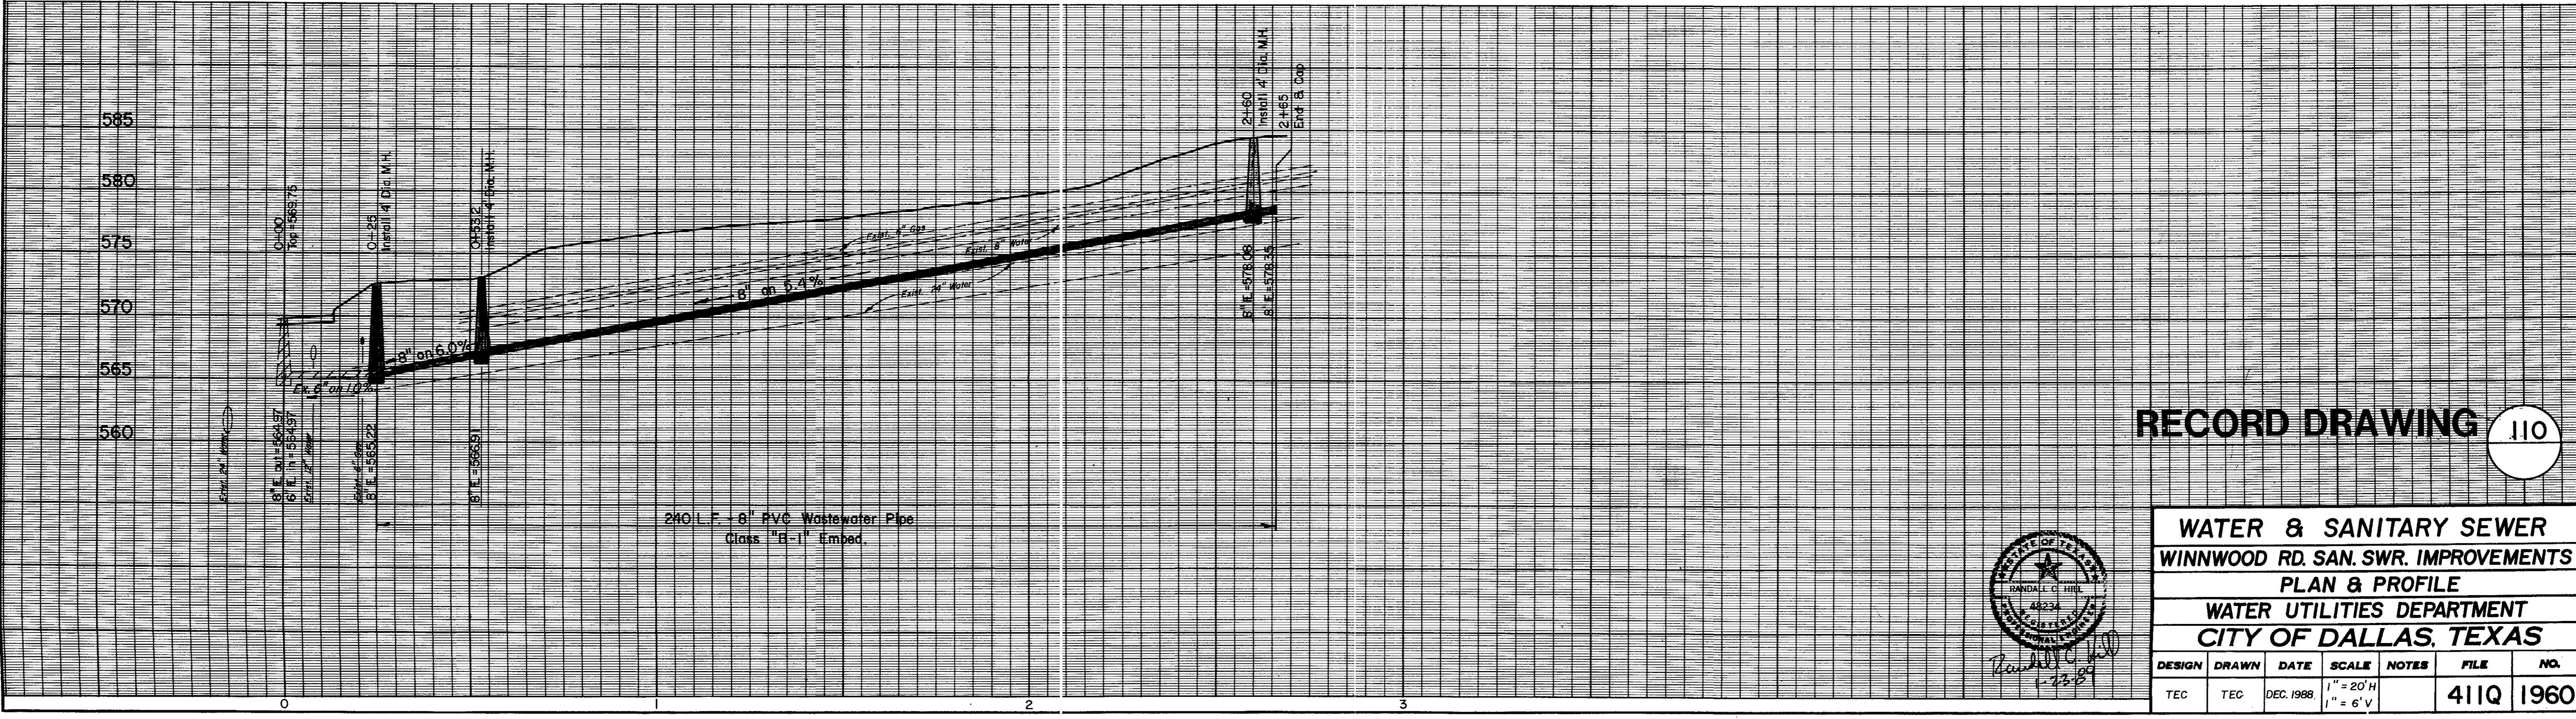


240 L.F. - 8" PVC Wastewater Pipe
Class "B-1" Embed.

RECORD DRAWING 110

WATER & SANITARY SEWER
WINNWOOD RD. SAN. SWR. IMPROVEMENTS
PLAN & PROFILE
WATER UTILITIES DEPARTMENT
CITY OF DALLAS, TEXAS

DESIGN	DRAWN	DATE	SCALE	NOTES	FILE	NO.
TEC	TEC	DEC. 1988	1" = 20' H 1" = 6' V		411Q	1960

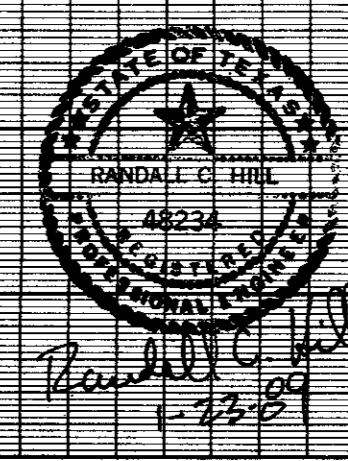

TELETYPE UNIT