


REVISIONS  
 REVISION 6/20/88  
 REVISED DATE  
 AT 1000' SCALE AND  
 ADDED PARTS AREA  
 DELETED PARTS  
 ELEVATION

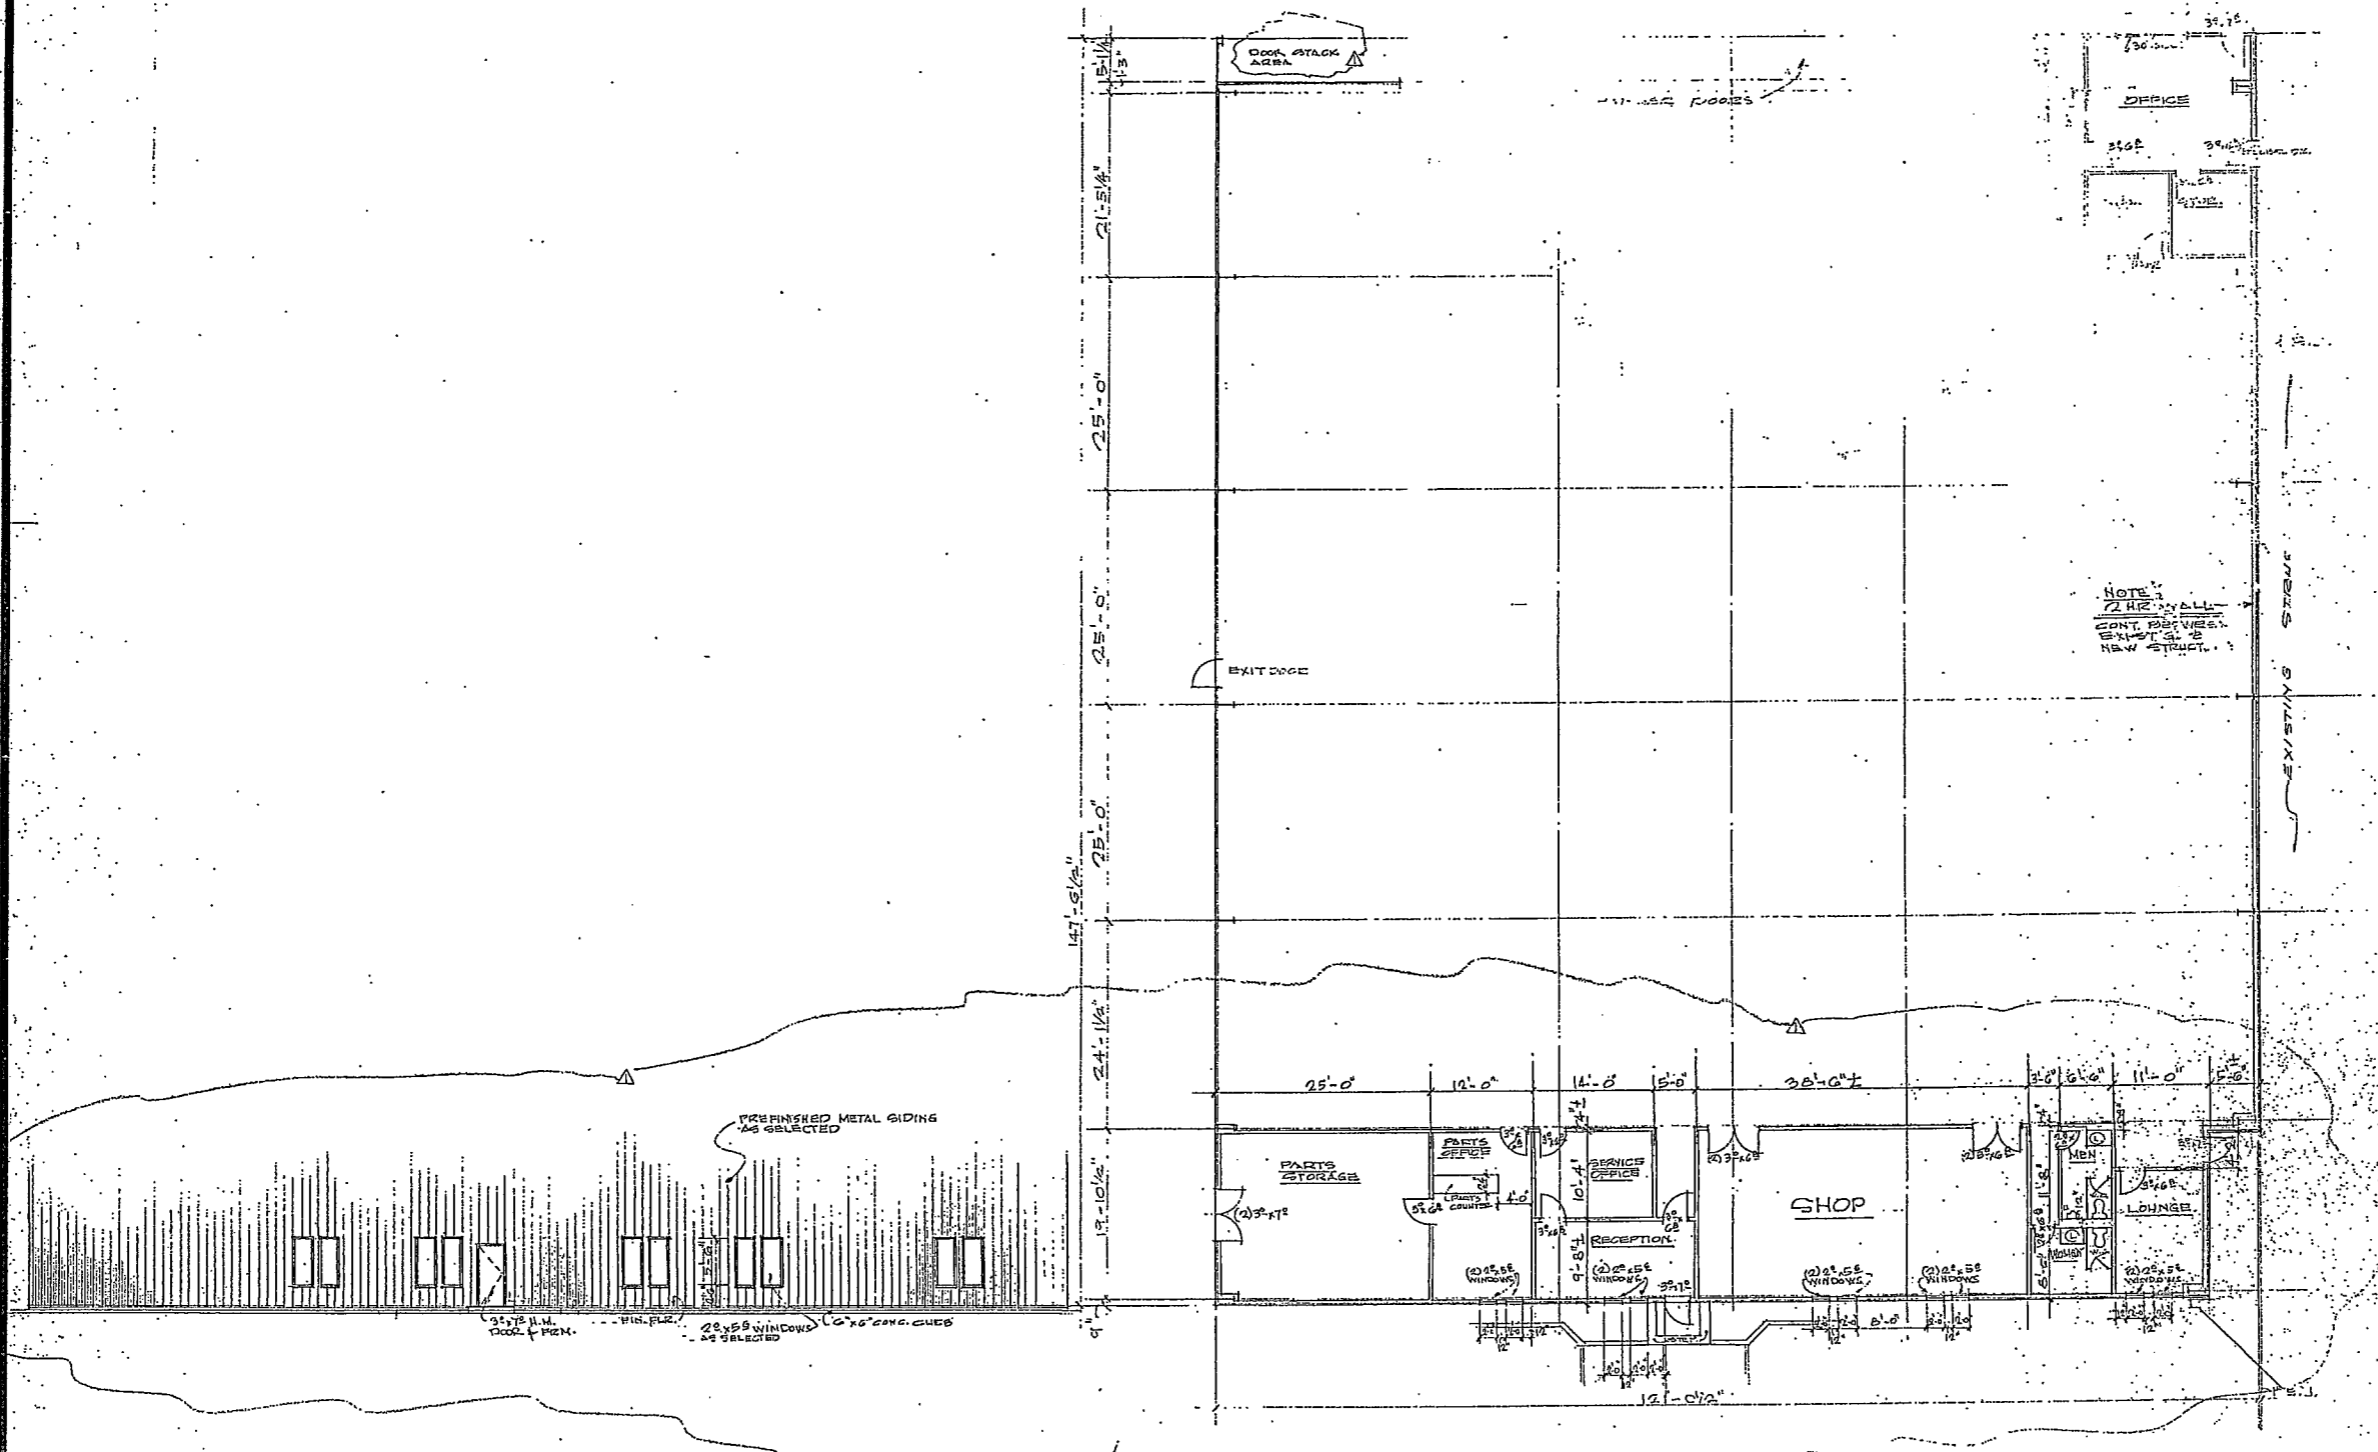

**PARTIAL ELEVATION**  
 SCALE: 1/8" = 1'-0"

**FLOOR PLAN**  
 SCALE: 1/8" = 1'-0"

NOTE:  
 7 HR. WALL  
 CONT. SERVICES  
 EXIST. & NEW STRUCT.

MISSION AIRE  
 ADDISON AIRPORT  
 ADDISON, TEXAS

**McULLAH-LEGGETT-MANNING**  
 Interior Designers  
 Architects

JOB NUMBER  
 68811

SHEET NUMBER  
 A-2  
 OF SHEETS  
 DATE OF ORIGINAL ISSUE