

HANGAR SPACE - FIRST FLOOR
 OFFICE SPACE - SECOND FLOOR
 TOTAL

13,200 SF.
 2,200 S.F.
 15,400 S.F.

PARKING PROVIDED


0

PARKING REQUIRED

6 Sp.

PAVING

37,844 S.F.

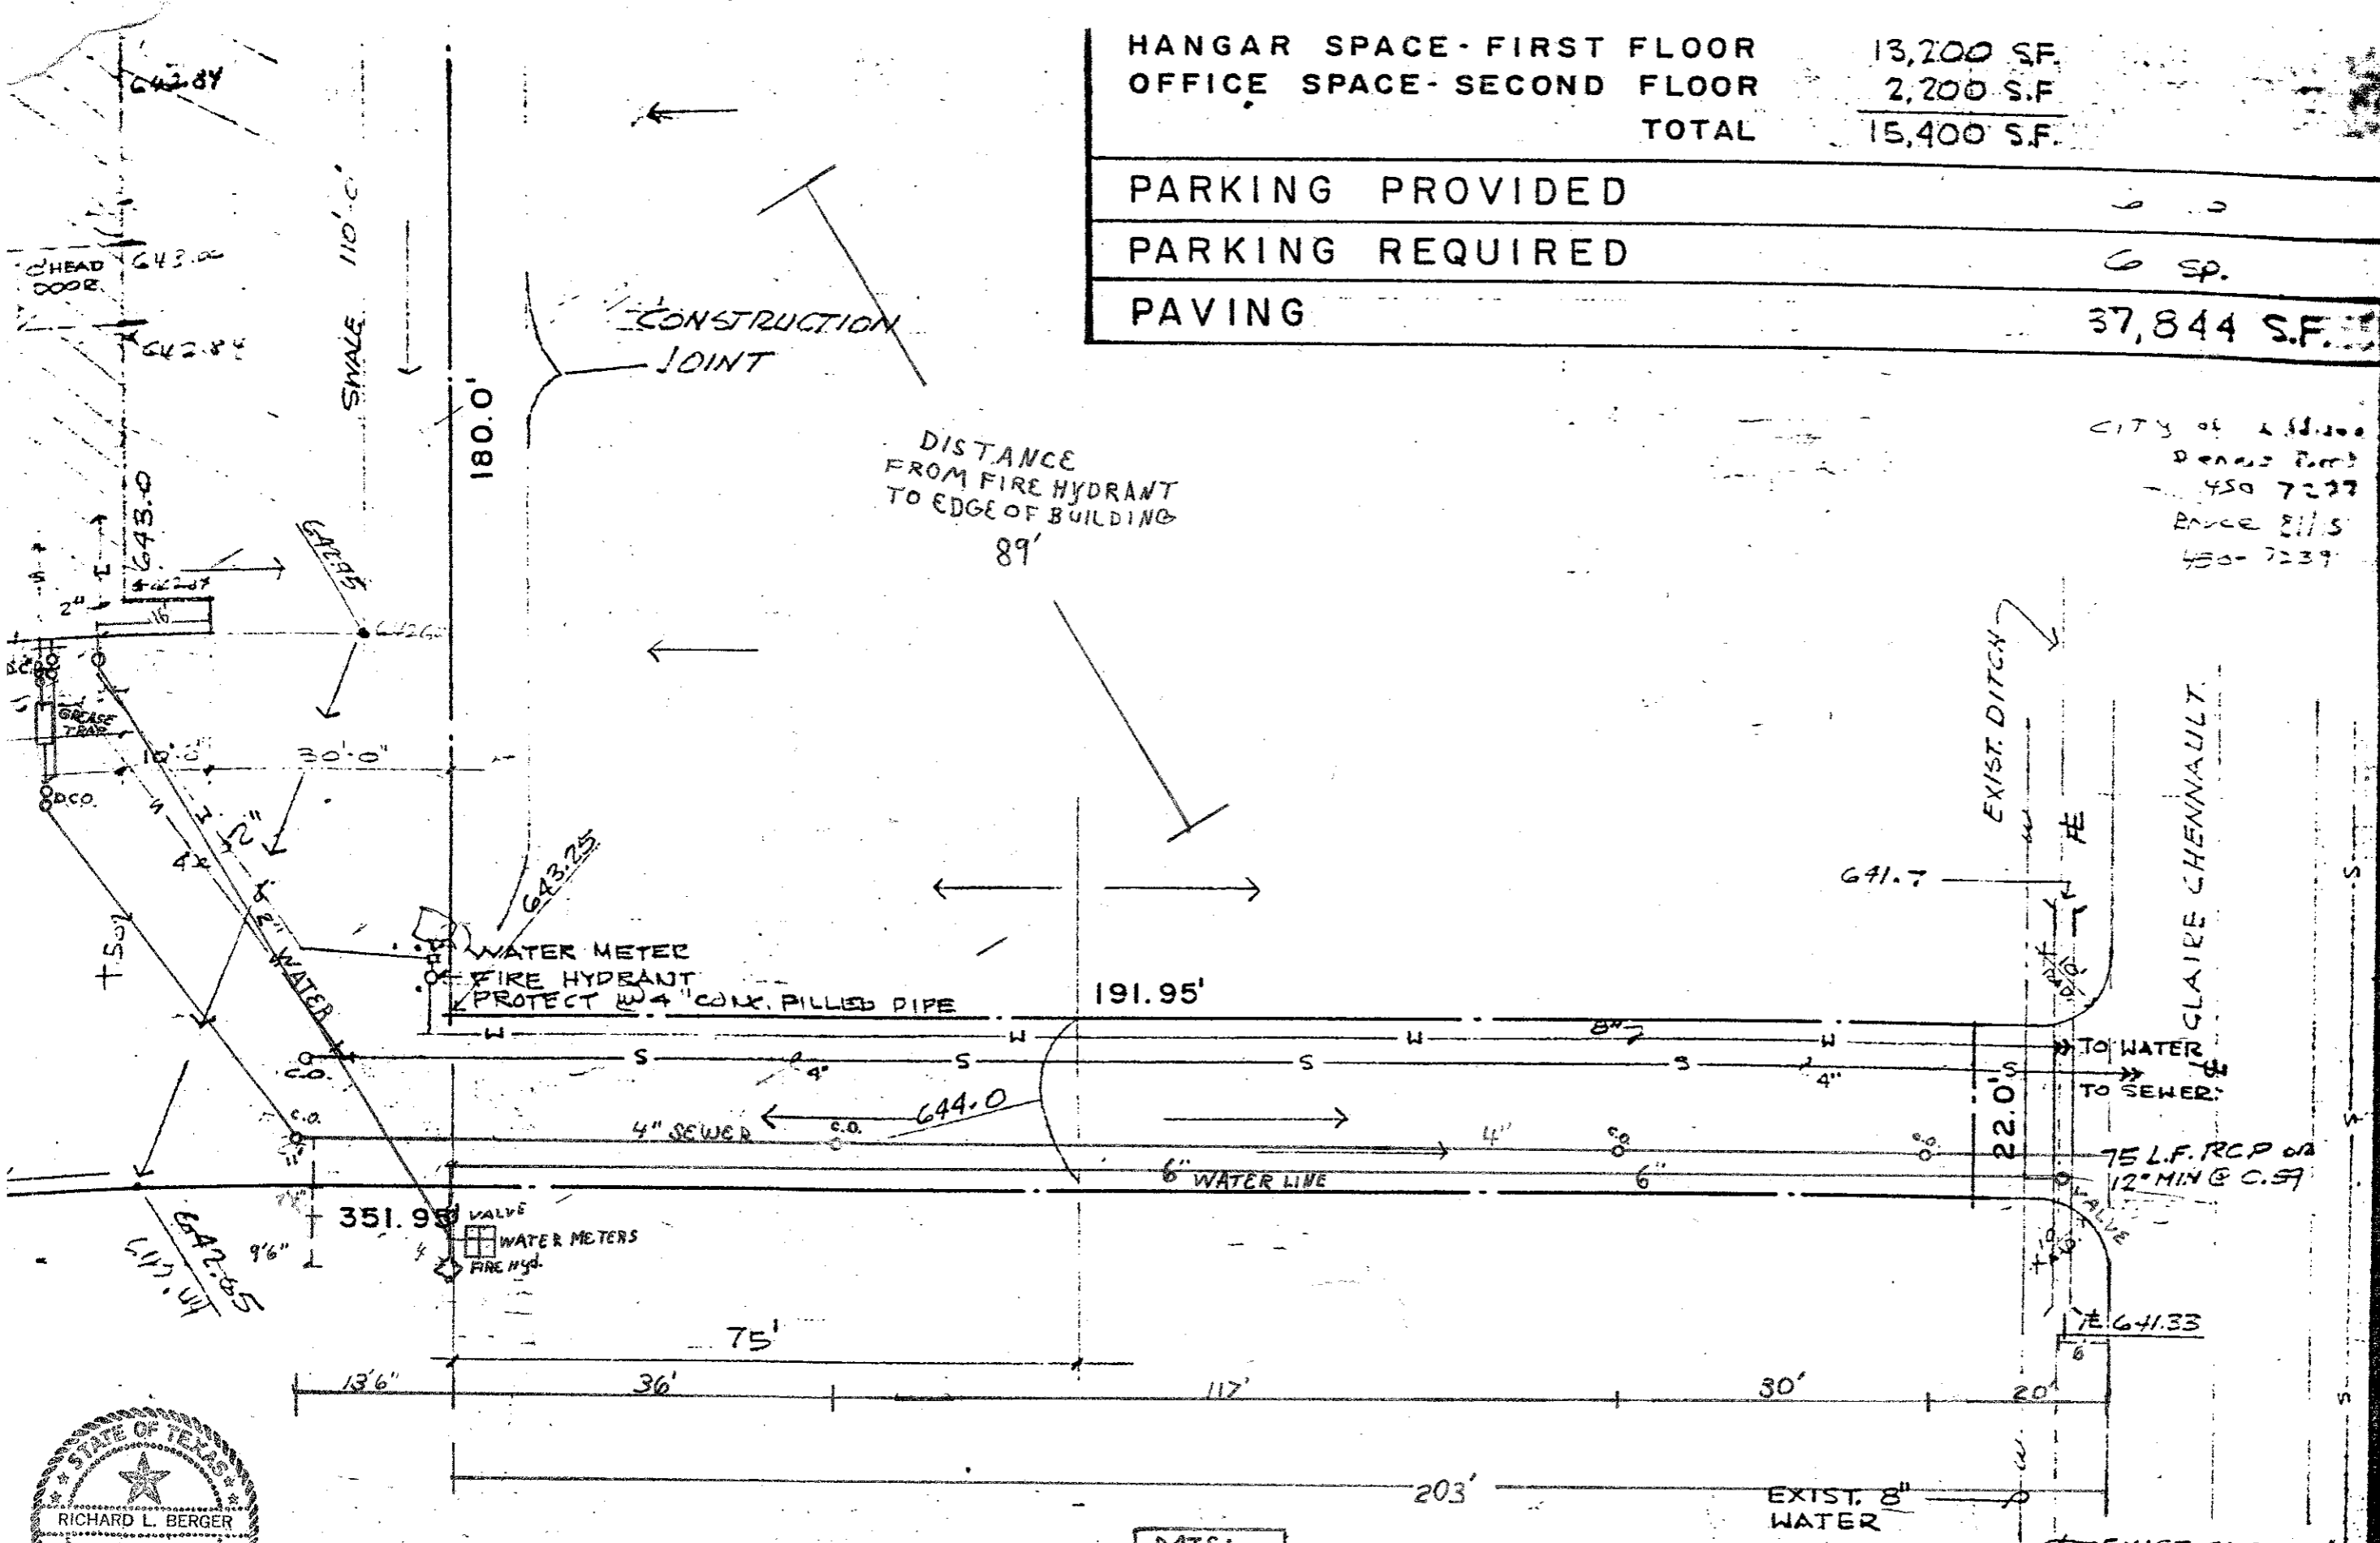

CITY of Dallas
 Dennis Ford
 450 7237
 Bruce Ellis
 450-7239


JAMES H. ARNOLD



JOB
 84105

DATE:
 2-13-84

SHEET
 P-1

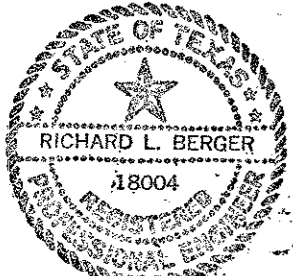

AS-BUILT UTILITY PLAN

DATE:
 3-21-85

4575 CLAIRE CHENNAULT

SCALE: 1"=20'