

HANGAR SPACE - FIRST FLOOR
 OFFICE SPACE - SECOND FLOOR
 TOTAL

13,200 SF.
 2,200 S.F.
 15,400 S.F.

PARKING PROVIDED

6



PARKING REQUIRED

6 Sp.

PAVING

37,844 S.F.

CITY of Houston
 Dennis Ford
 450 7237
 Bruce Ellis
 450-7239

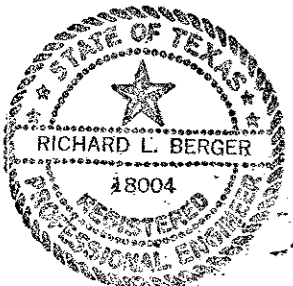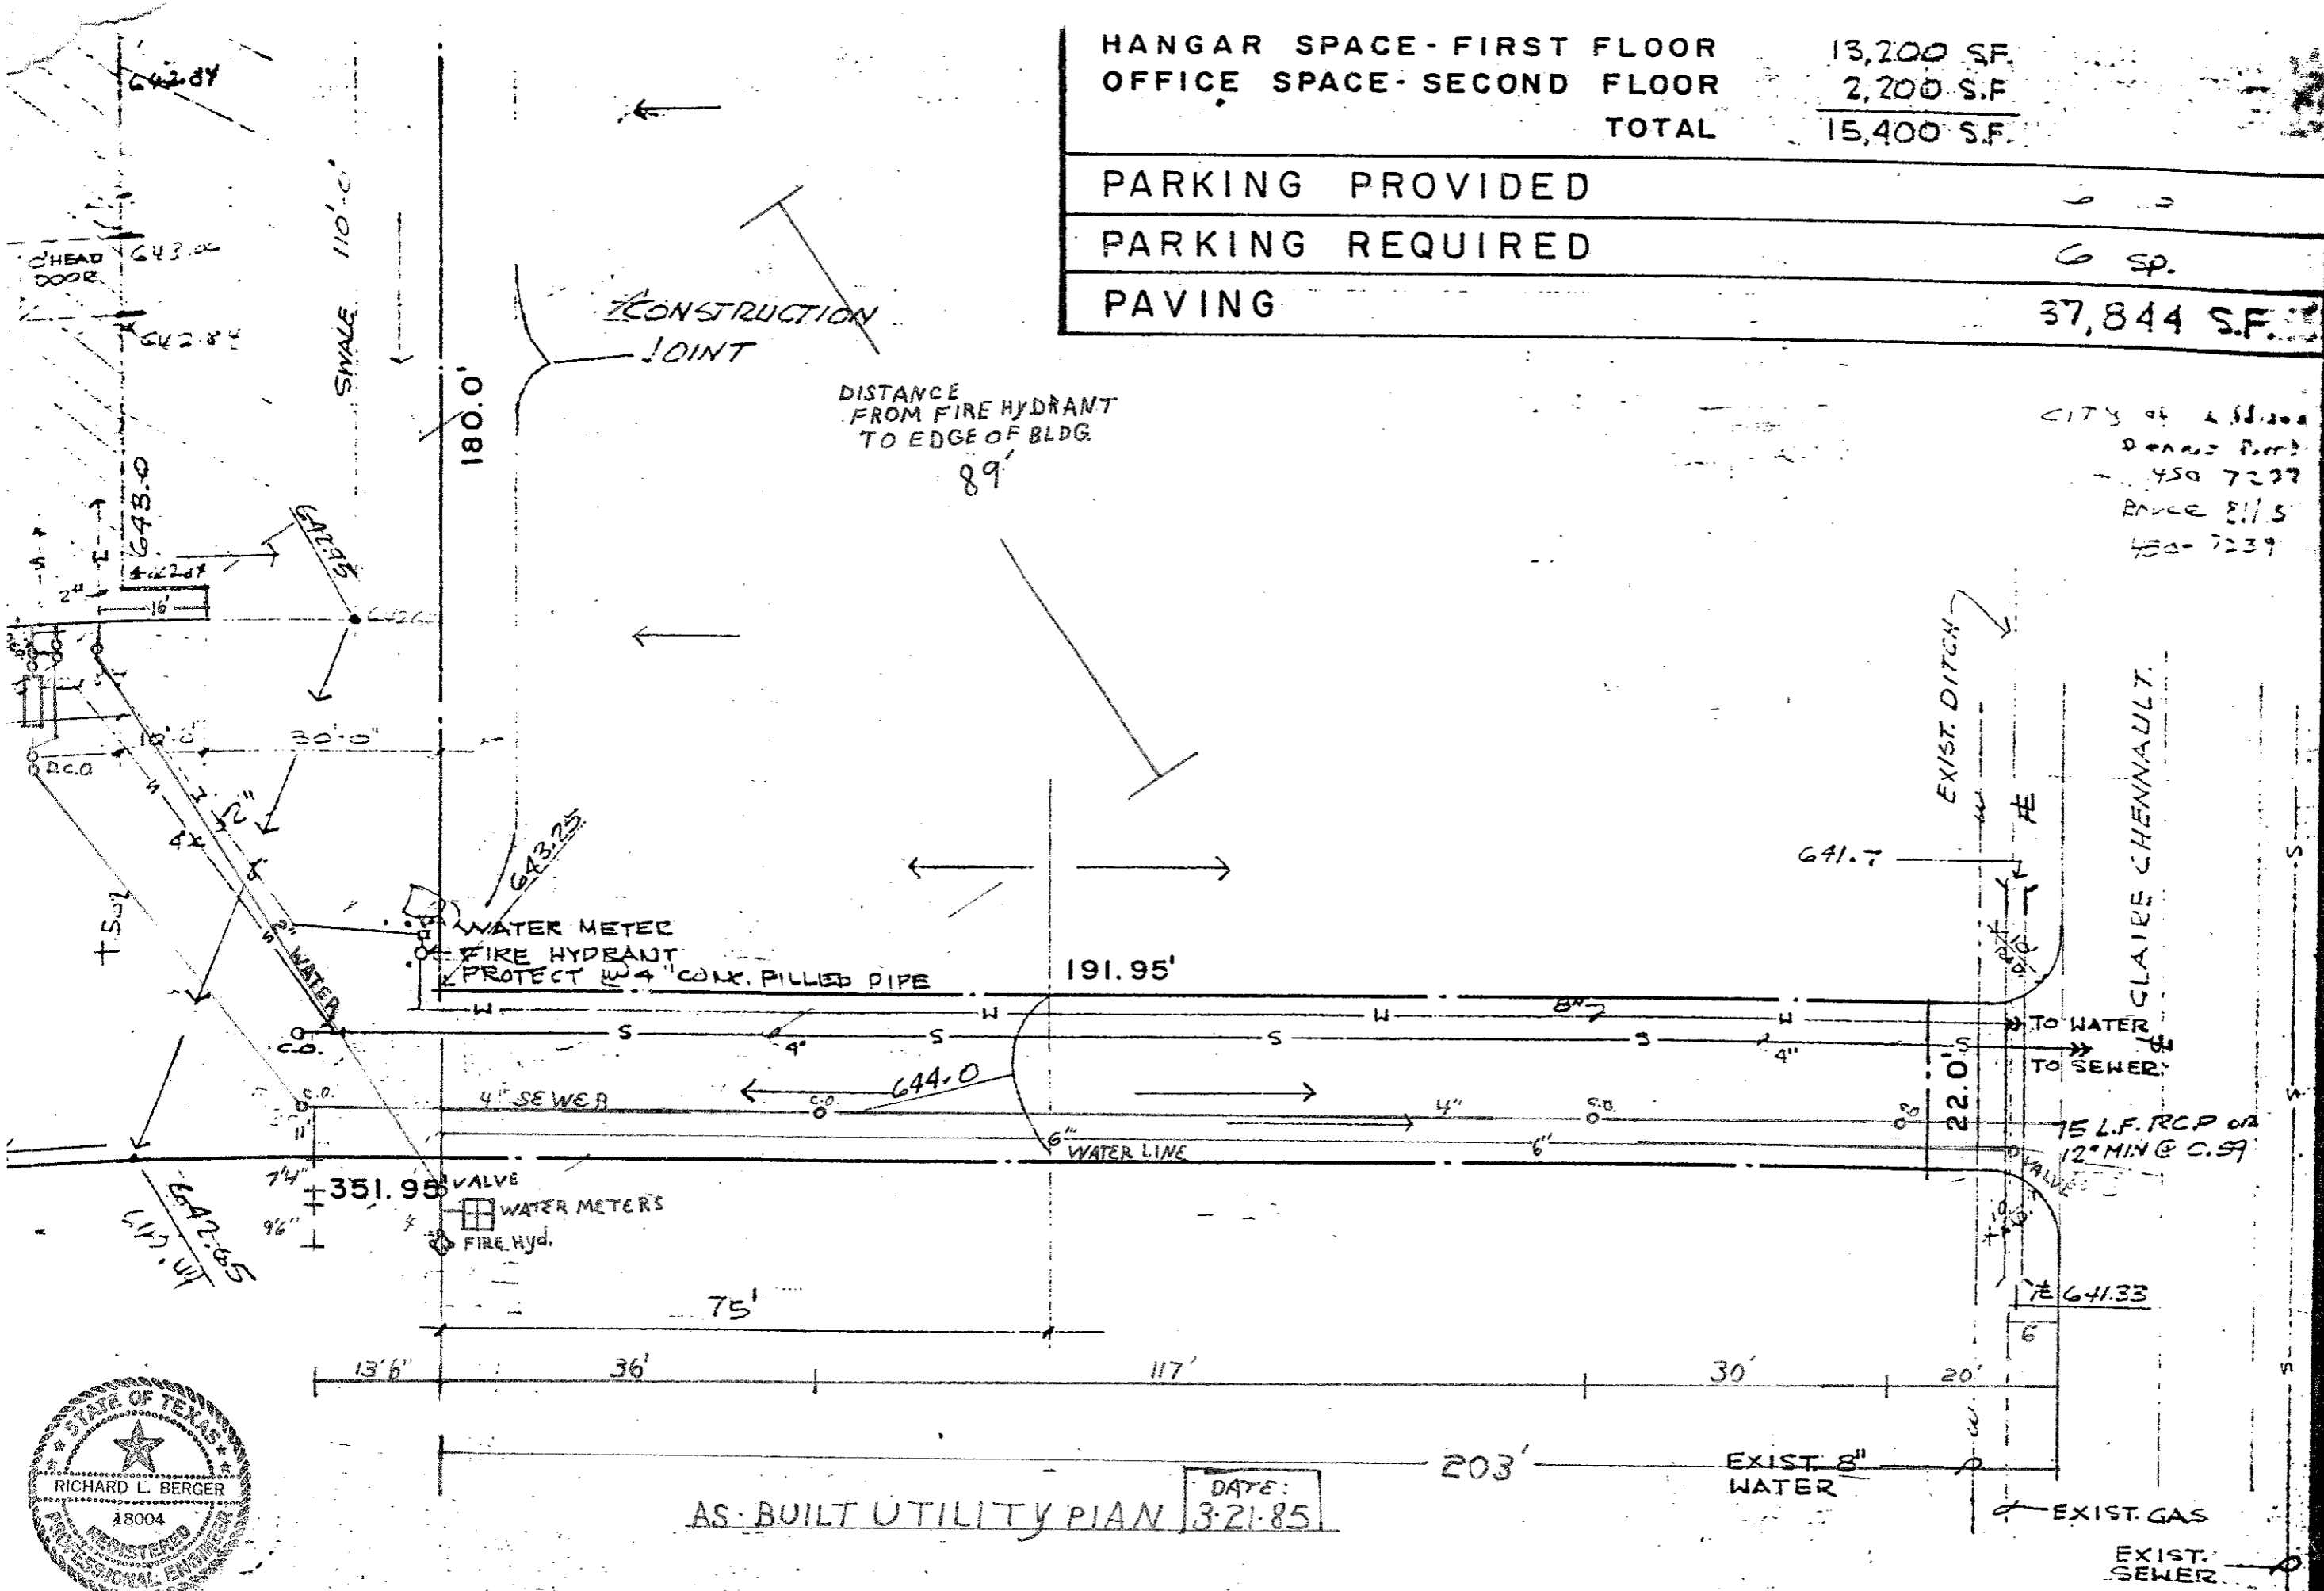

AS-BUILT UTILITY PLAN DATE: 3-21-85

4575 CLAIRE CHENNAULT

SCALE: 1"=20'

JAMES H. BERGER ARCHITECTS



JOB 84105

DATE: 2-13-84

SHEET

13-1