



REVISIONS	BY
GEN. REV. 2-5 PER CITY 10-21-84	RS

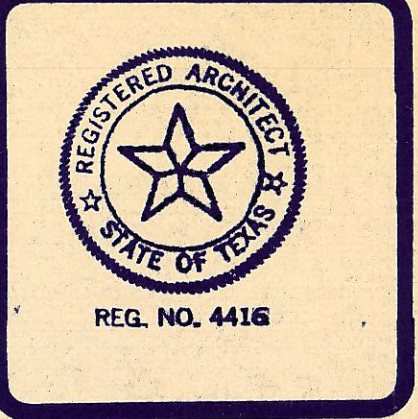

ROGER SMITH AIA
 ARCHITECT
 3306 WILEY POST DR.
 CARROLLTON, TEXAS, 75006
 387-4701

A HANGAR AND OFFICE BUILDING FOR REDMAN INVESTMENTS
 CLAIRE CHENNAULT DRIVE ADDISON AIRPORT, ADDISON, TEXAS

DRAWN	
CHECKED	
DATE	10-20-84
SCALE	
JOB NO.	8407
SHEET	

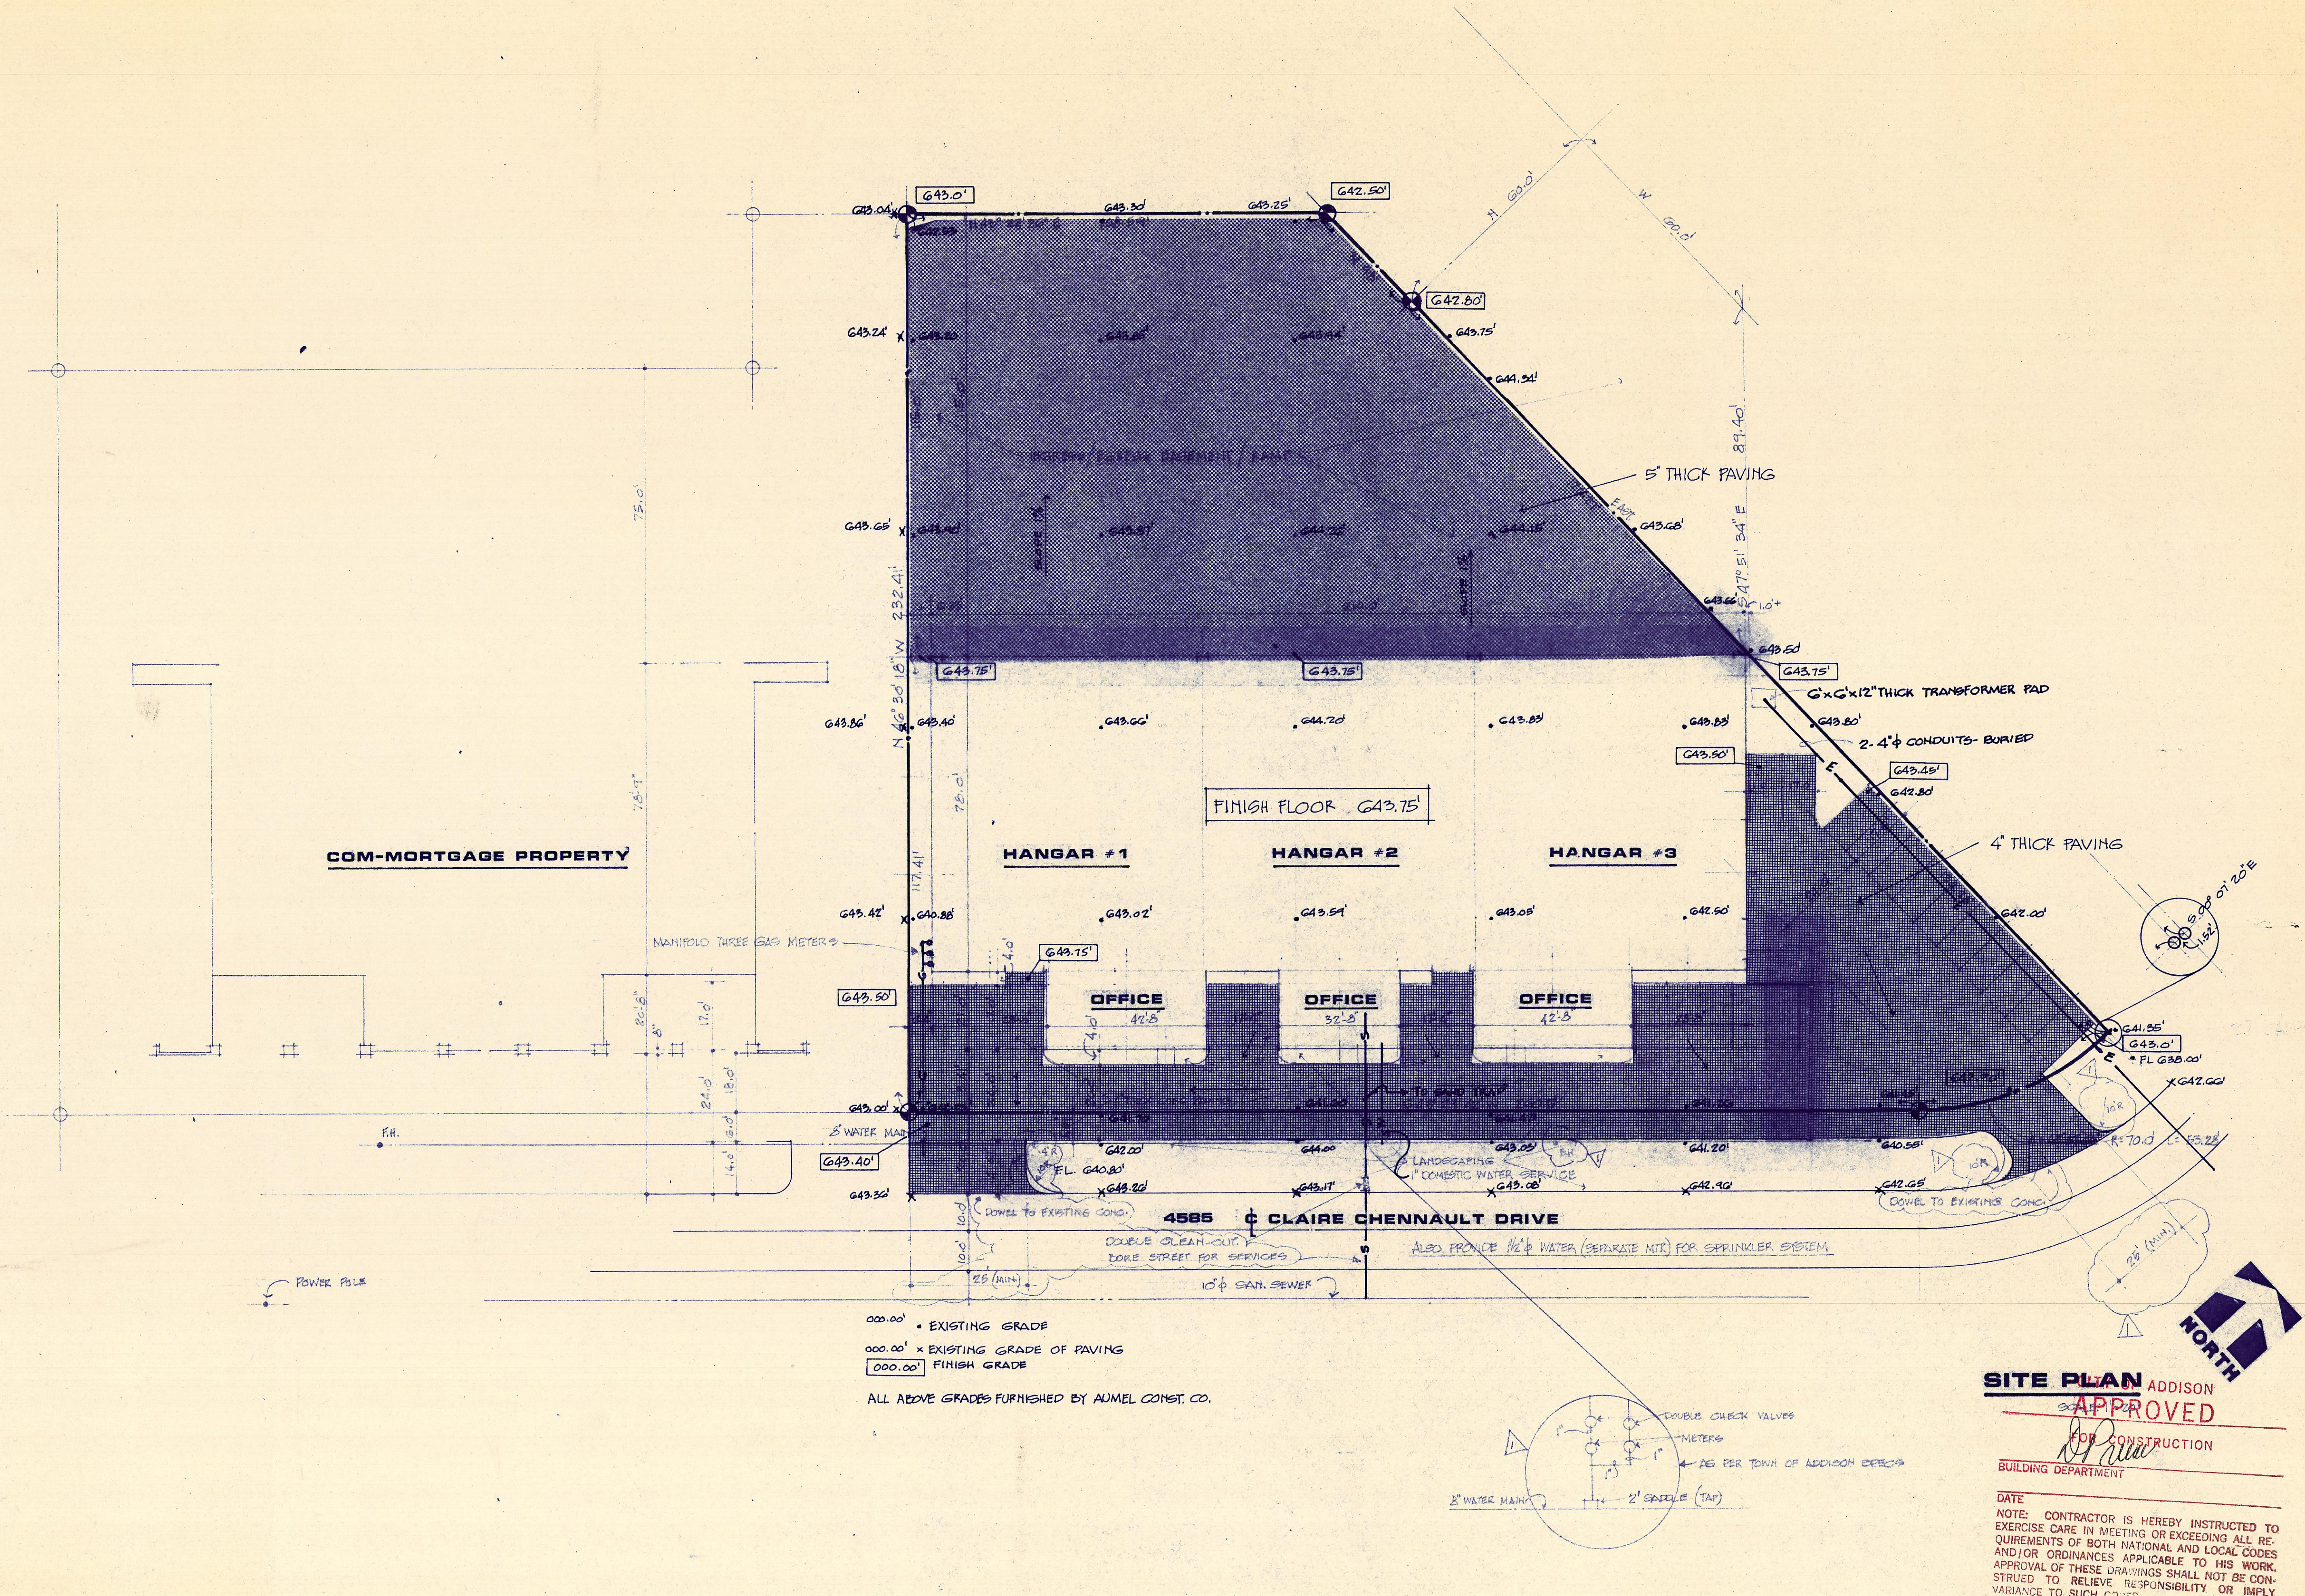

THIS SHEET SUPERCEDES SHEET DATED 7-31-84

SITE PLAN ADDISON
APPROVED
 FOR CONSTRUCTION
 BUILDING DEPARTMENT