



e:\94010.2\2\shht\abfct02.001
13 AUG 97
DART.TBL
JAMES LANDRY


DWG No. GC1-0002

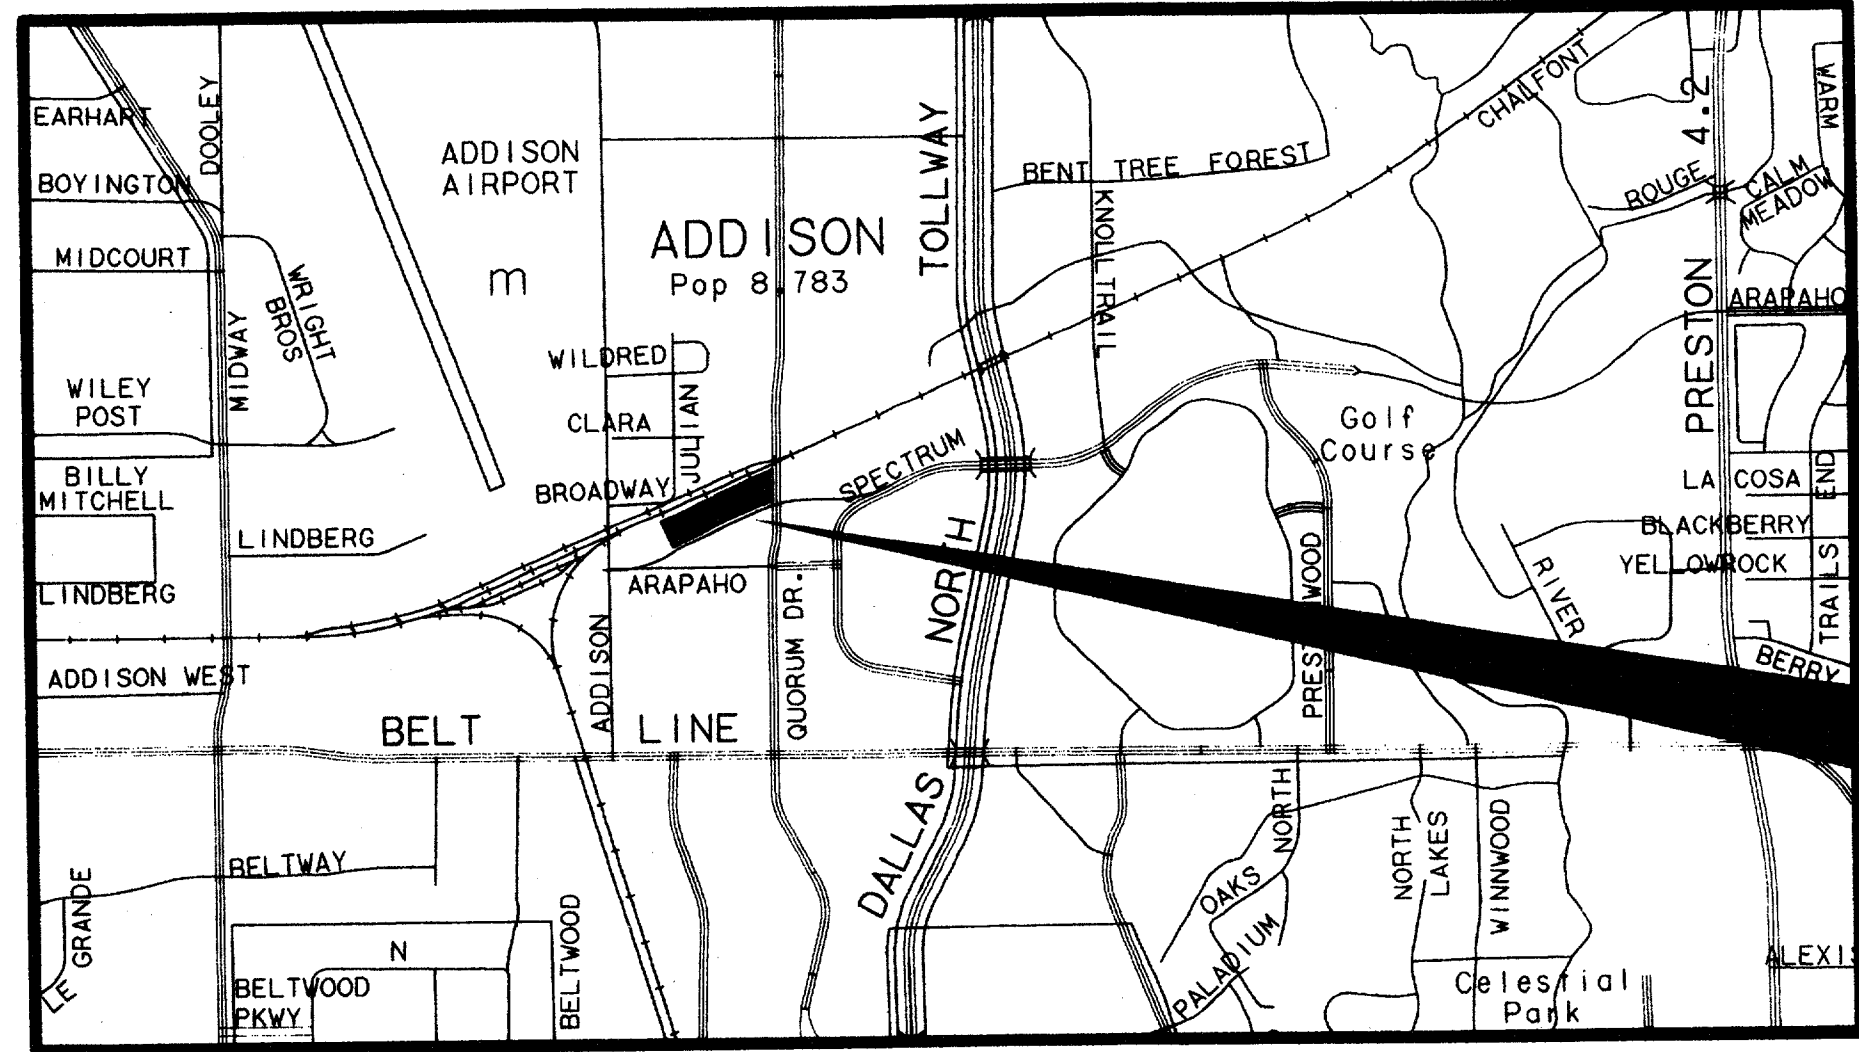

VICINITY MAP
SCALE 1"=3000'

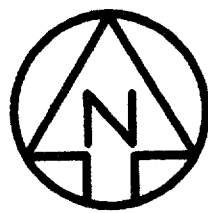

**ADDISON
TRANSIT CENTER
C-97000136**

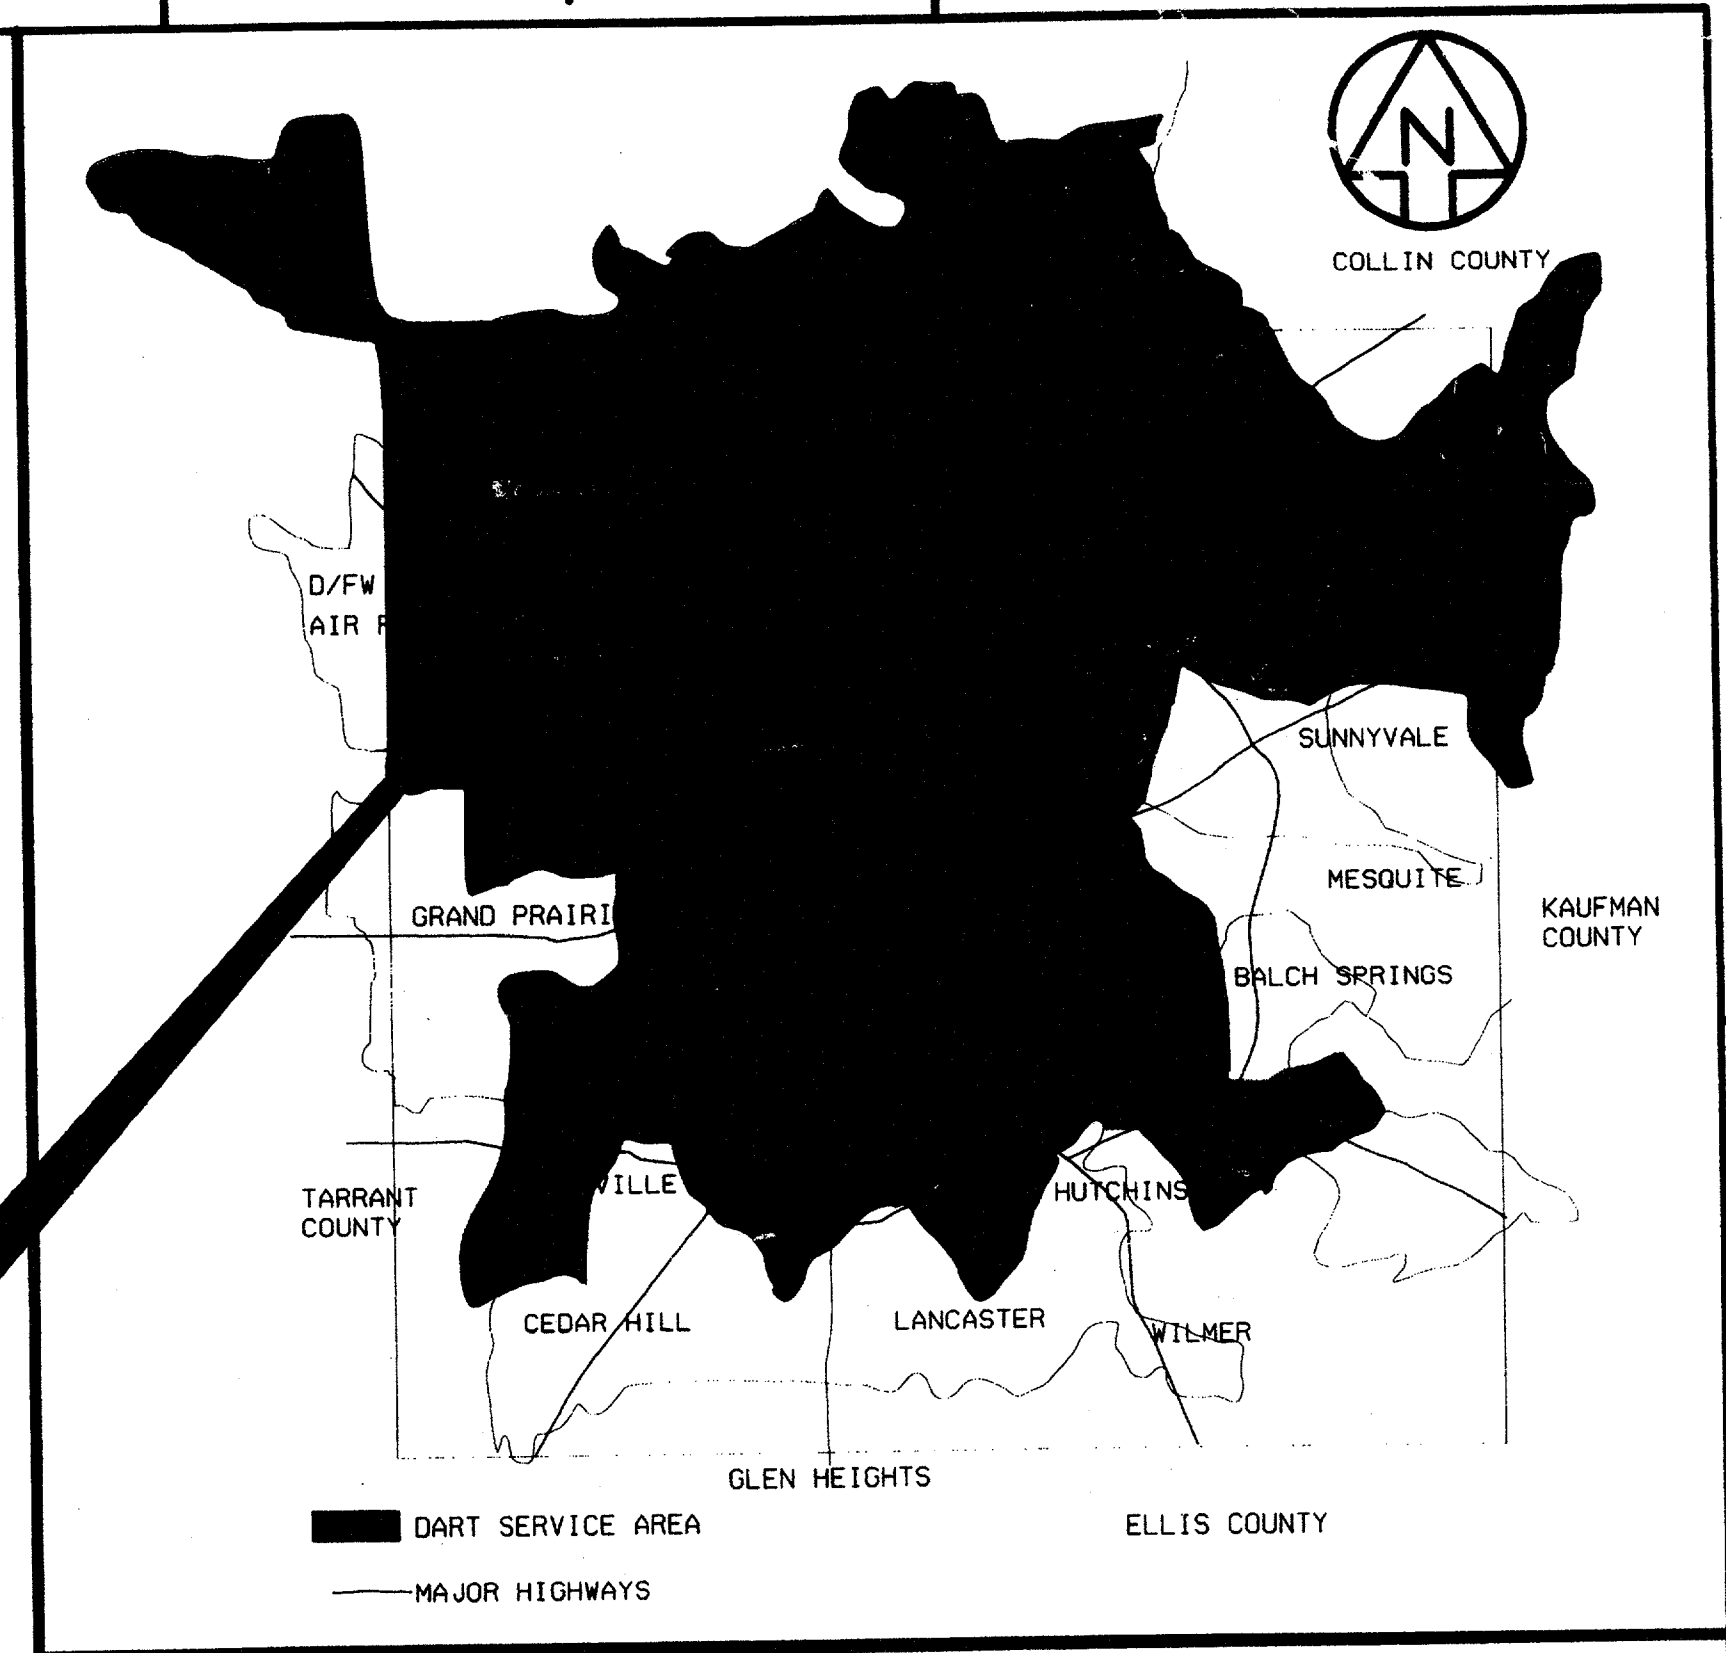

AREA MAP
N.T.S.


Record (Amended) Certificate
Having checked the information presented in this certificate, I hereby certify that the same is true and correct.
Wendy Lopez & Associates, Inc.
7-1997
TOM KADEL
PRESIDENT

CONFORMED



CONTRACT SHEET No. 2 OF 95

**ADDISON
TRANSIT CENTER
TITLE SHEET**

| NO. | BY | CHK | APP | REV | DATE | DESCRIPTION | BY | ENG | CHK | APP |
|-----|----|-----|-----|-----|------|-------------|----|-----|-----|-----|
| 1 | | | | | | | | | | |
| 2 | | | | | | | | | | |
| 3 | | | | | | | | | | |
| 4 | | | | | | | | | | |
| 5 | | | | | | | | | | |
| 6 | | | | | | | | | | |
| 7 | | | | | | | | | | |
| 8 | | | | | | | | | | |
| 9 | | | | | | | | | | |
| 10 | | | | | | | | | | |

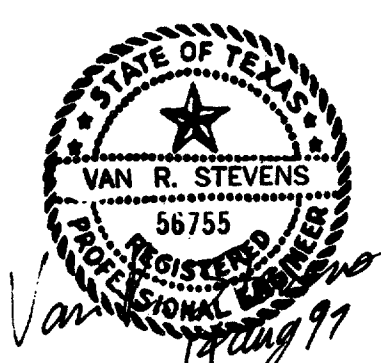

WENDY LOPEZ & ASSOC.
LOCKWOOD, ANDREWS & NEWMAN
THE SWA GROUP
GERARD & ASSOCIATES
ZAXON

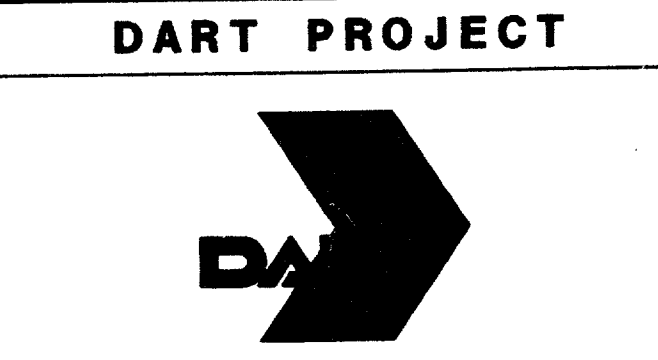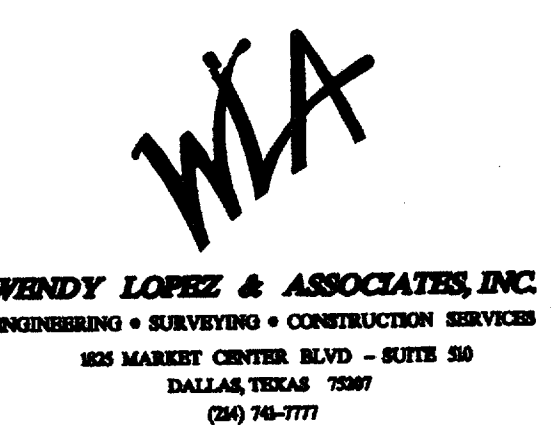

SCALE AS SHOWN
DRAWN D. KRUCIAK
DESIGNED P. ZHAO
CHECKED V. STEVENS
IN CHARGE V. STEVENS
DATE 14 AUG. 1997

CONTRACT C-97000136 DWG No. GC1-0002 REV 2