



c:\cadd\94010.212\shf\abtpcp08.01
 02 MAR 98
 DART.TBL
 \$(USER)

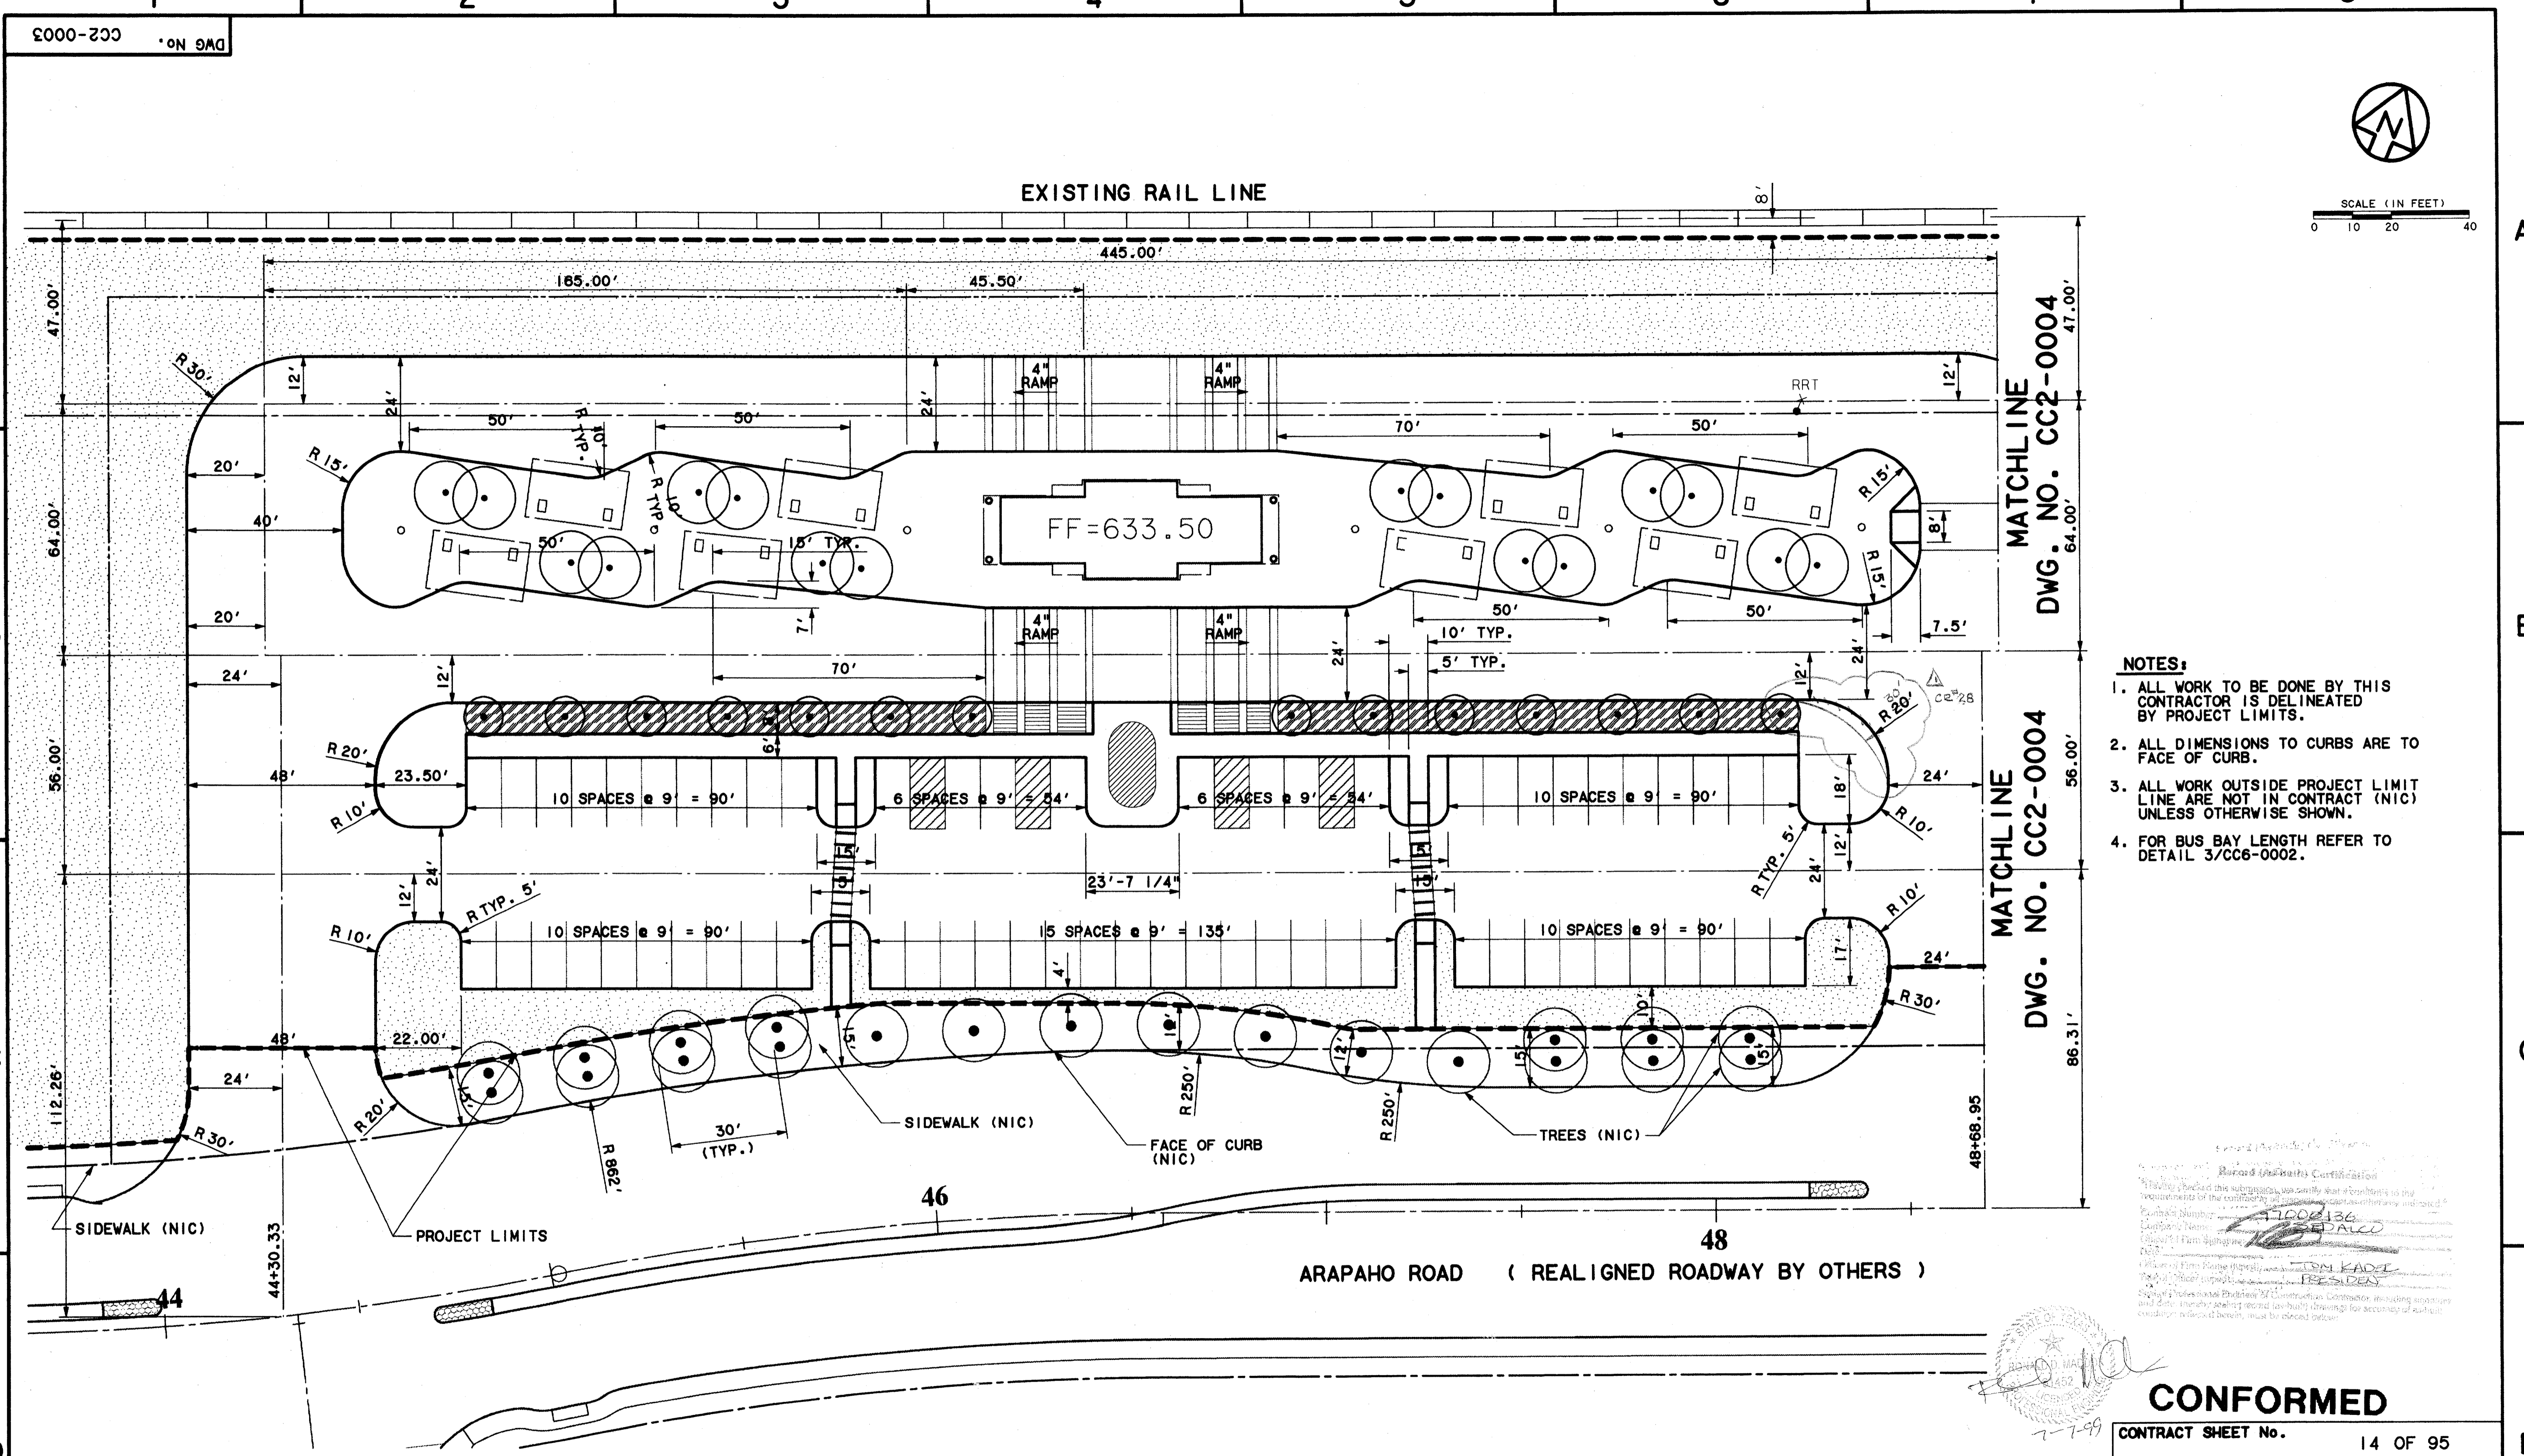

EXISTING RAIL LINE

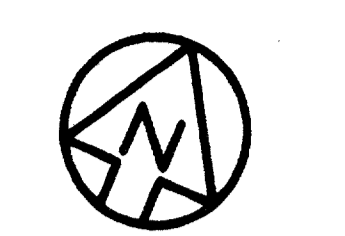

SCALE (IN FEET)
 0 10 20 40

- NOTES:**
1. ALL WORK TO BE DONE BY THIS CONTRACTOR IS DELINEATED BY PROJECT LIMITS.
 2. ALL DIMENSIONS TO CURBS ARE TO FACE OF CURB.
 3. ALL WORK OUTSIDE PROJECT LIMIT LINE ARE NOT IN CONTRACT (NIC) UNLESS OTHERWISE SHOWN.
 4. FOR BUS BAY LENGTH REFER TO DETAIL 3/CC6-0002.


MATCHLINE
 DWG. NO. CC2-0004
 MATCHLINE
 DWG. NO. CC2-0004

CONFORMED

CONTRACT SHEET No. 14 OF 95


**ADDISON
 TRANSIT CENTER
 PAVING DIMENSIONS**

REV	DATE	DESCRIPTION	BY	ENG	CHK	APP	REV	DATE	DESCRIPTION	BY	ENG	CHK	APP
△	8/30/99	RECORD (AS-BUILT) DRAWINGS		DLM		DLM	△						
△							△						
△							△						
△							△						
△							△						

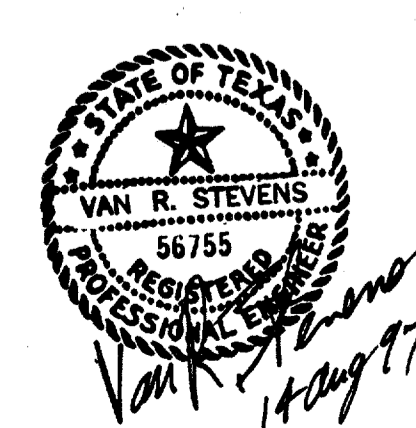

WENDY LOPEZ & ASSOC.
 LOCKWOOD, ANDREWS & NEWNAM
 THE SWA GROUP
 GERARD & ASSOCIATES
 ZAXON

WLA
WENDY LOPEZ & ASSOCIATES, INC.
 ENGINEERING • SURVEYING • CONSTRUCTION SERVICES
 202 MARKET CENTER BLVD - SUITE 200
 DALLAS, TEXAS 75207
 (214) 746-7777

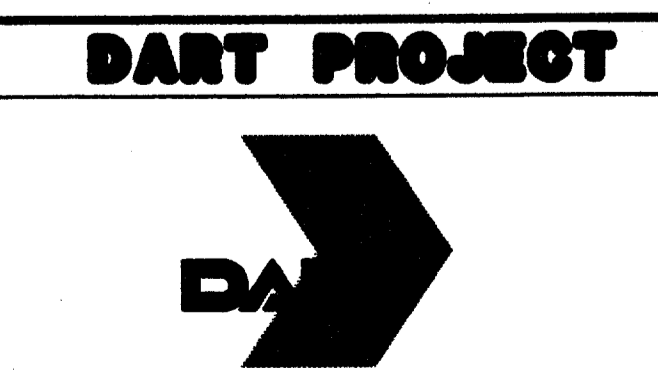

SCALE 1"=20'
 DRAWN D. KRUCIAK
 DESIGNED P. ZHAO
 CHECKED V. STEVENS
 IN CHARGE V. STEVENS
 DATE AUG. 14, 1997

CONTRACT C-97000136
 DWG No. CC2-0003
 REV 0