


c:\cadd\94010.2\12\sh1\ab1ccp09.02
02 MAR 98
DART.TBL
\$(USER)

DWG No. CC2-0004

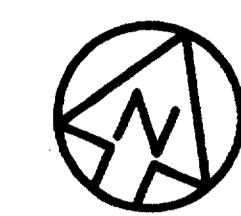

SCALE (IN FEET)
0 20 40 80

EXISTING RAIL LINE

A = 23°20'18.5"
R = 150.00'
L = 61.10'
T = 30.98'

DETAIL 02
CC6-0002

MATCHLINE
DWG. NO. CC2-0003

MATCHLINE
DWG. NO. CC2-0003

PROJECT LIMITS

1. ALL WORK TO BE DONE BY THIS CONTRACTOR IS DELINEATED BY PROJECT LIMITS.
2. ALL DIMENSIONS TO CURBS ARE TO FACE OF CURB.
3. ALL WORK OUTSIDE PROJECT LIMIT LINE ARE NOT IN CONTRACT (NIC) UNLESS OTHERWISE SHOWN.

Record (As-built) Certification
Having checked this submission, we certify that it conforms to the requirements of the contract in all respects, except as otherwise indicated.
Contract Number: 97000136
Company Name: [Signature]
Title: [Signature]
Date of this Report: [Signature]
Date of Project Completion: [Signature]
Date of Professional Engineer of Construction Contract, including signature and title, should be placed on the drawing for accuracy of as-built conditions where/when must be placed below:


CONFORMED

CONTRACT SHEET No. 15 OF 95

**ADDISON
TRANSIT CENTER
PAVING DIMENSIONS**

CONTRACT C-97000136 DWG No. CC2-0004 REV 0

| REV | DATE | DESCRIPTION | BY | ENG | CHK | APP | REV | DATE | DESCRIPTION | BY | ENG | CHK | APP |
|-----|------|-------------|----|-----|-----|-----|-----|------|-------------|----|-----|-----|-----|
| | | | | | | | | | | | | | |
| | | | | | | | | | | | | | |
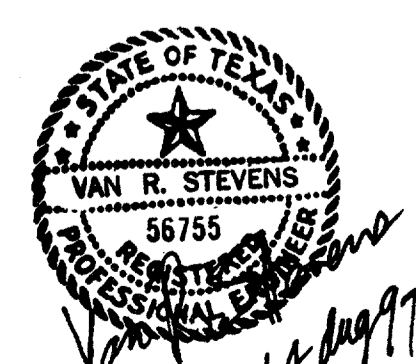

WENDY LOPEZ & ASSOC.
LOCKWOOD, ANDREWS & NEWMAN
THE SWA GROUP
GERARD & ASSOCIATES
ZAXON

WLA
WENDY LOPEZ & ASSOCIATES, INC.
ENGINEERING • SURVEYING • CONSTRUCTION SERVICES
805 MARKET CENTER BLVD - SUITE 200
DALLAS, TEXAS 75201
(214) 748-7777



SCALE 1"=20'
DRAWN D. KRUCIAK
DESIGNED P. ZHAO
CHECKED V. STEVENS
IN CHARGE V. STEVENS
DATE AUG. 14, 1997



ARAPAHO ROAD (REALIGNED ROADWAY BY OTHERS)

SIDEWALK (NIC) FACE OF CURB (NIC)

TREES (NIC) PROJECT LIMITS

SITE SIGN

PLANTER & SIDEWALK CORNER DETAIL BY OTHERS, COORDINATE WITH TOWN OF ADDISON CONTRACTOR.

QUORUM DRIVE

TREES (NIC) SIDEWALK (NIC)

