
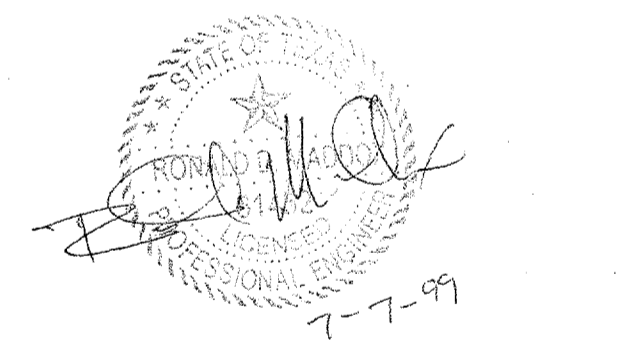


\\server\nt-cadd\94010.212\ssht\ng  
14 AUG 97  
DART.TBL  
JAMES LANDRY

9000-200  
DWG No. 9M

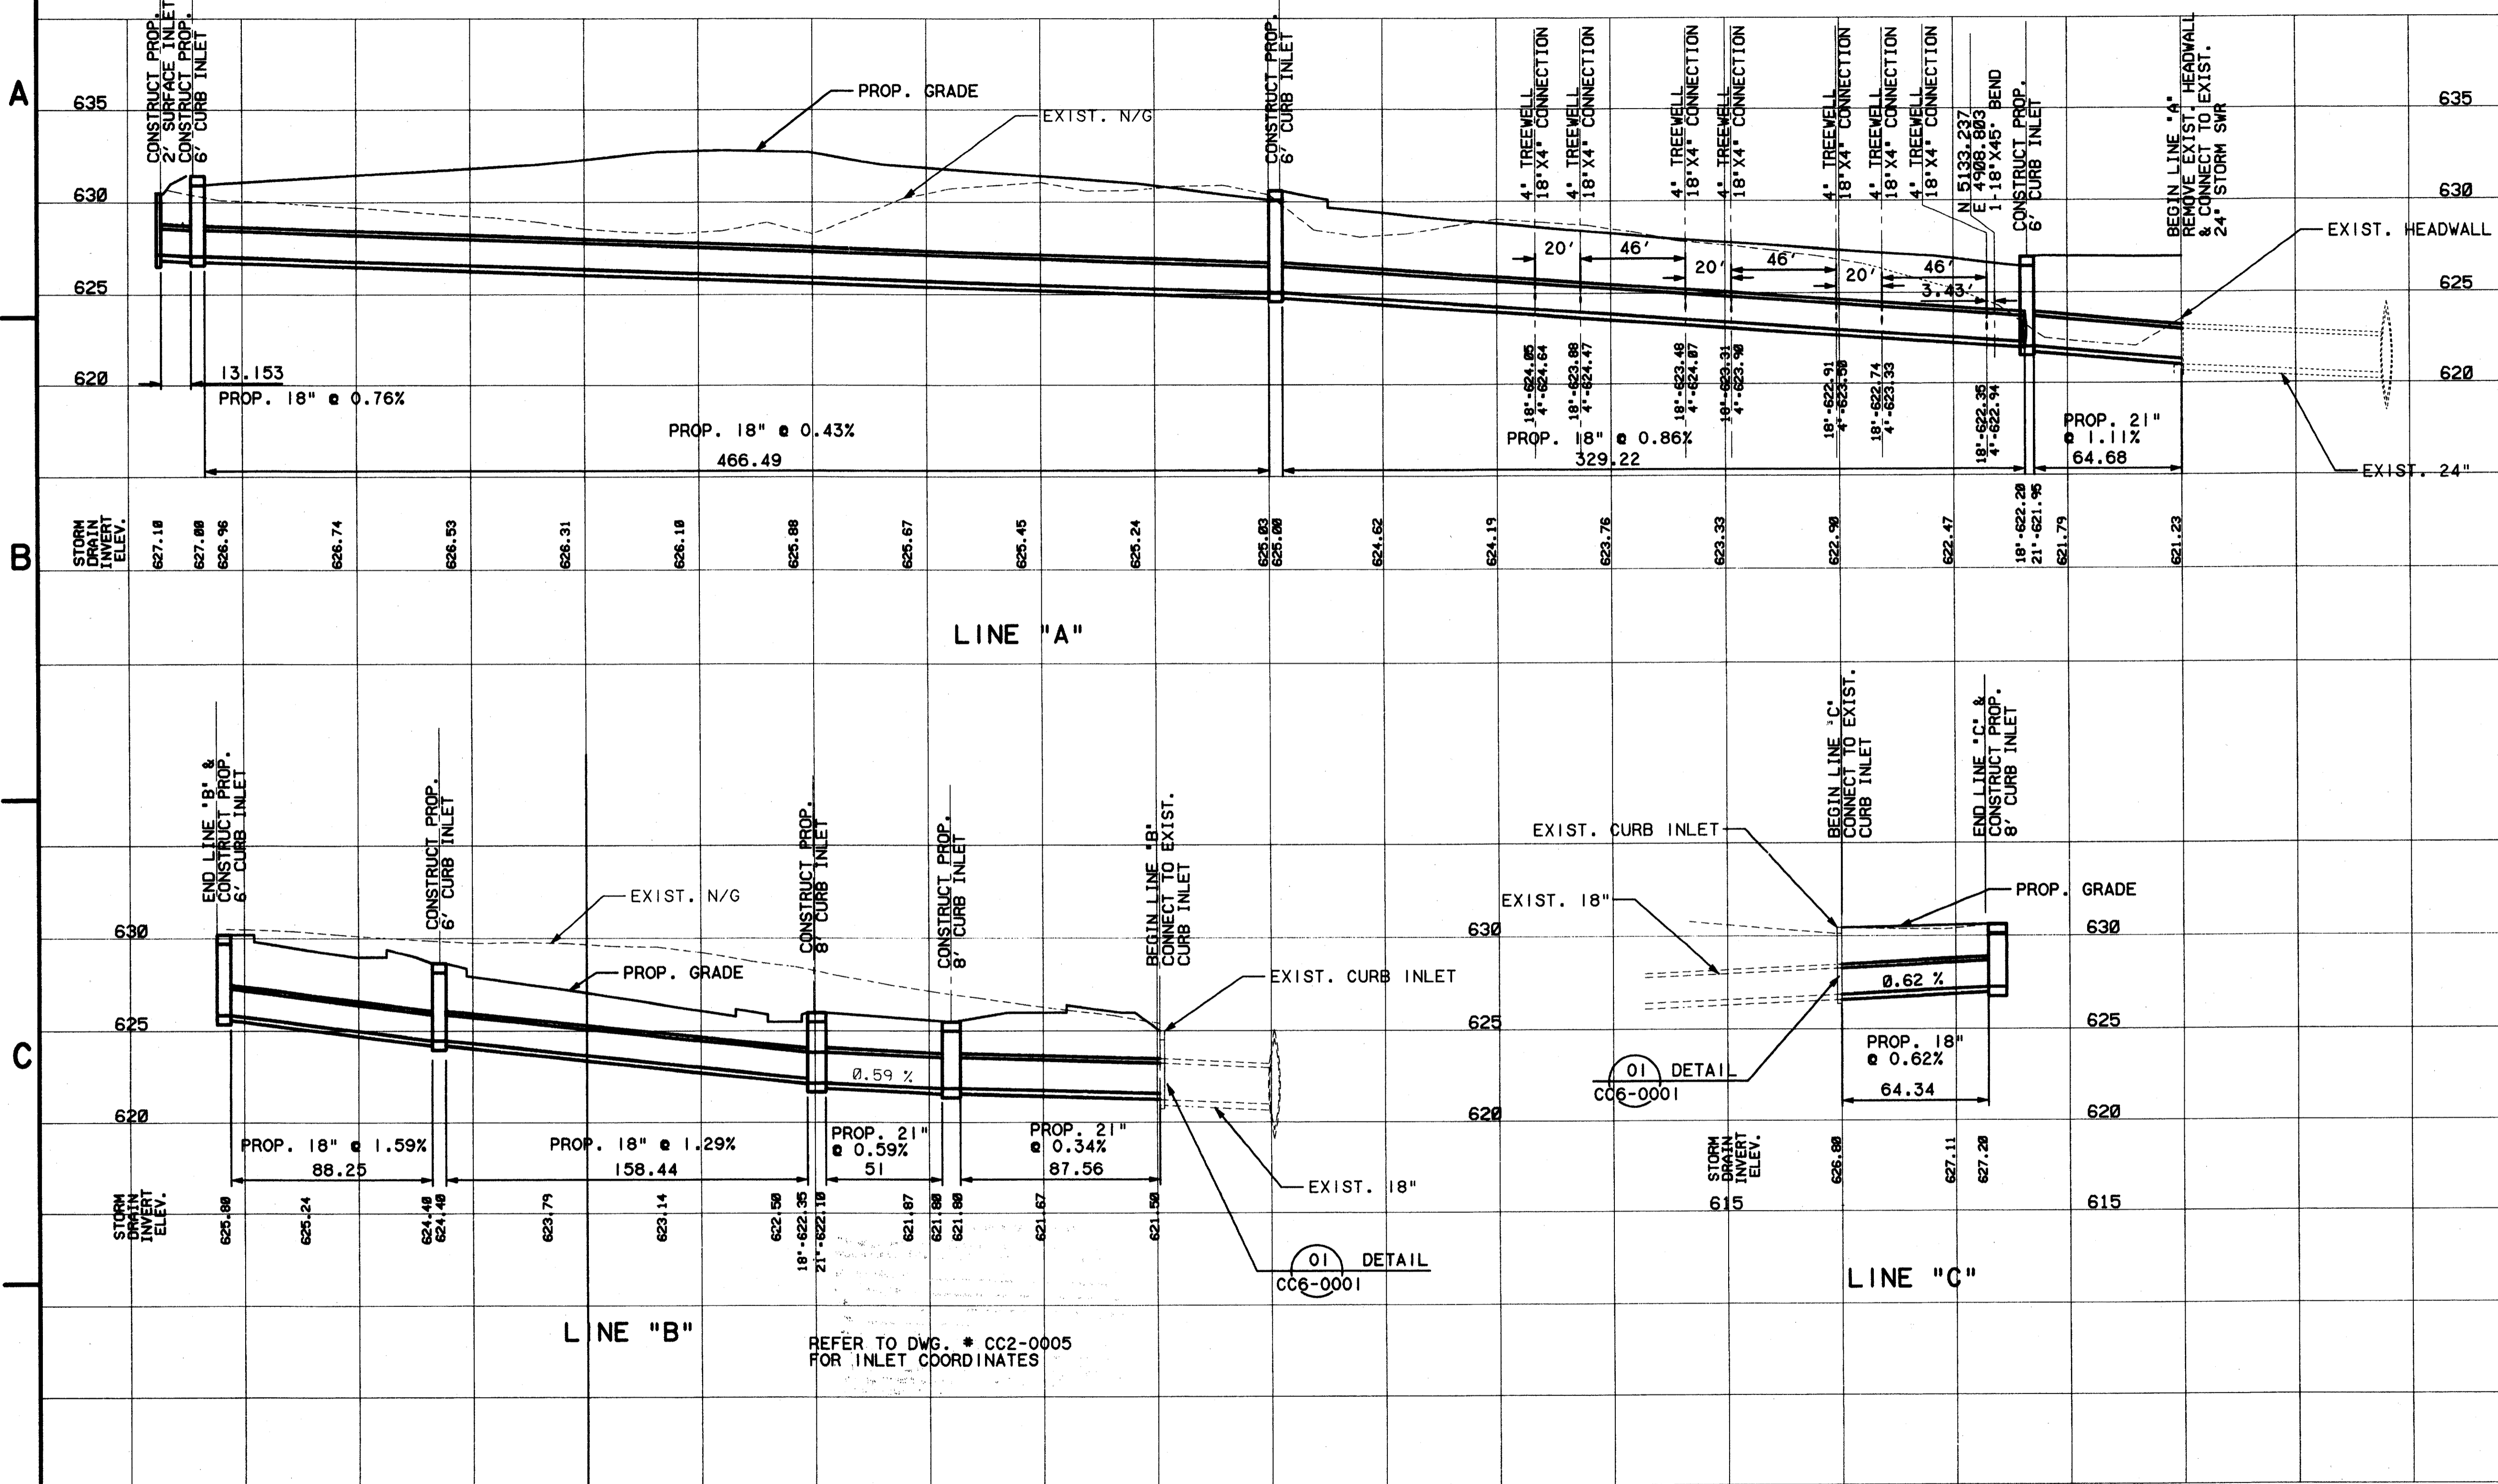


Record (As-Built) Certification  
I have checked this submission, and certify that it conforms to the  
requirements of the contract in all respects, and as otherwise indicated.  
Contract Number: 97065136  
Company Name: [Signature]  
Division of Professional Services: [Signature]  
Date: [Signature]  
Title of Person Issued: TOM KADER  
Title of Office Issued: PRESIDENT  
I warrant that the information contained in this submission is true and correct, and that I am a duly licensed professional engineer in the State of Texas.  
If any errors or omissions are discovered, I will be held responsible for the same.

**CONFORMED**


CONTRACT SHEET No. 18 OF 95

REV	DATE	DESCRIPTION	BY	ENG	CHK	APP	REV	DATE	DESCRIPTION	BY	ENG	CHK	APP

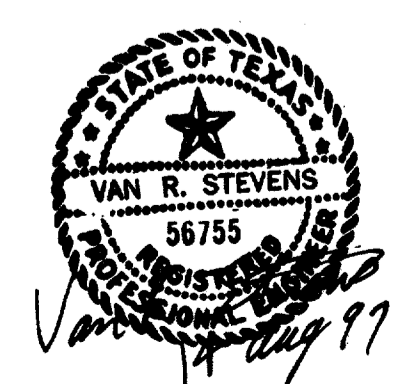

WENDY LOPEZ & ASSOC.  
LOCKWOOD, ANDREWS & NEWNAM  
THE SWA GROUP  
GERARD & ASSOCIATES  
ZAXON

**WLA**  
WENDY LOPEZ & ASSOCIATES, INC.  
ENGINEERING & SURVEYING - CONSTRUCTION SERVICES  
100 MARKET CENTER BLVD - SUITE 300  
DALLAS, TEXAS 75201  
(214) 746-7771

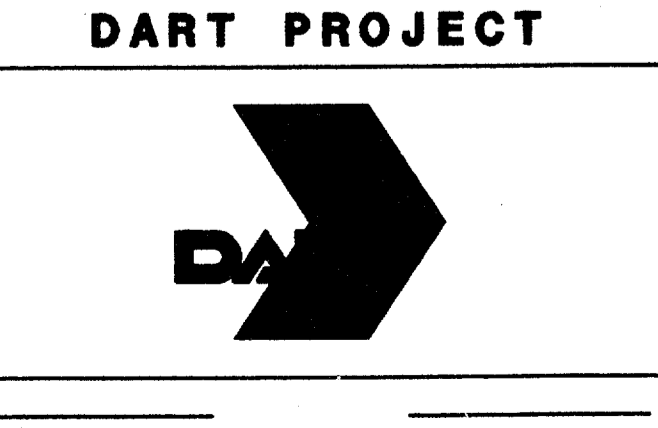

SCALE	1"=40'
DRAWN	D. KRUCIAK
DESIGNED	P. ZHAO
CHECKED	V. STEVENS
IN CHARGE	V. STEVENS
DATE	14 AUG. 1997

**ADDISON  
TRANSIT CENTER  
STORM SEWER PROFILES**

CONTRACT C-97000136  
DWG No. CC2-0005  
REV 0