


\$\$\$DGN SPECIFICATIONS\$\$\$  
 \$\$\$SYTIME\$\$\$  
 \$\$\$PRF\$\$\$  
 \$\$\$USERNAME\$\$\$  
 \$\$\$ROT\$\$\$  
 \$\$\$PEN\$\$\$  
 \$\$\$FILE6\$\$\$  
 \$\$\$FILE7\$\$\$  
 \$\$\$FILE8\$\$\$  
 \$\$\$FILE9\$\$\$  
 \$\$\$FILE10\$\$\$  
 \$\$\$FILE1\$\$\$  
 \$\$\$FILE2\$\$\$  
 \$\$\$FILE3\$\$\$  
 \$\$\$FILE4\$\$\$  
 \$\$\$FILE5\$\$\$

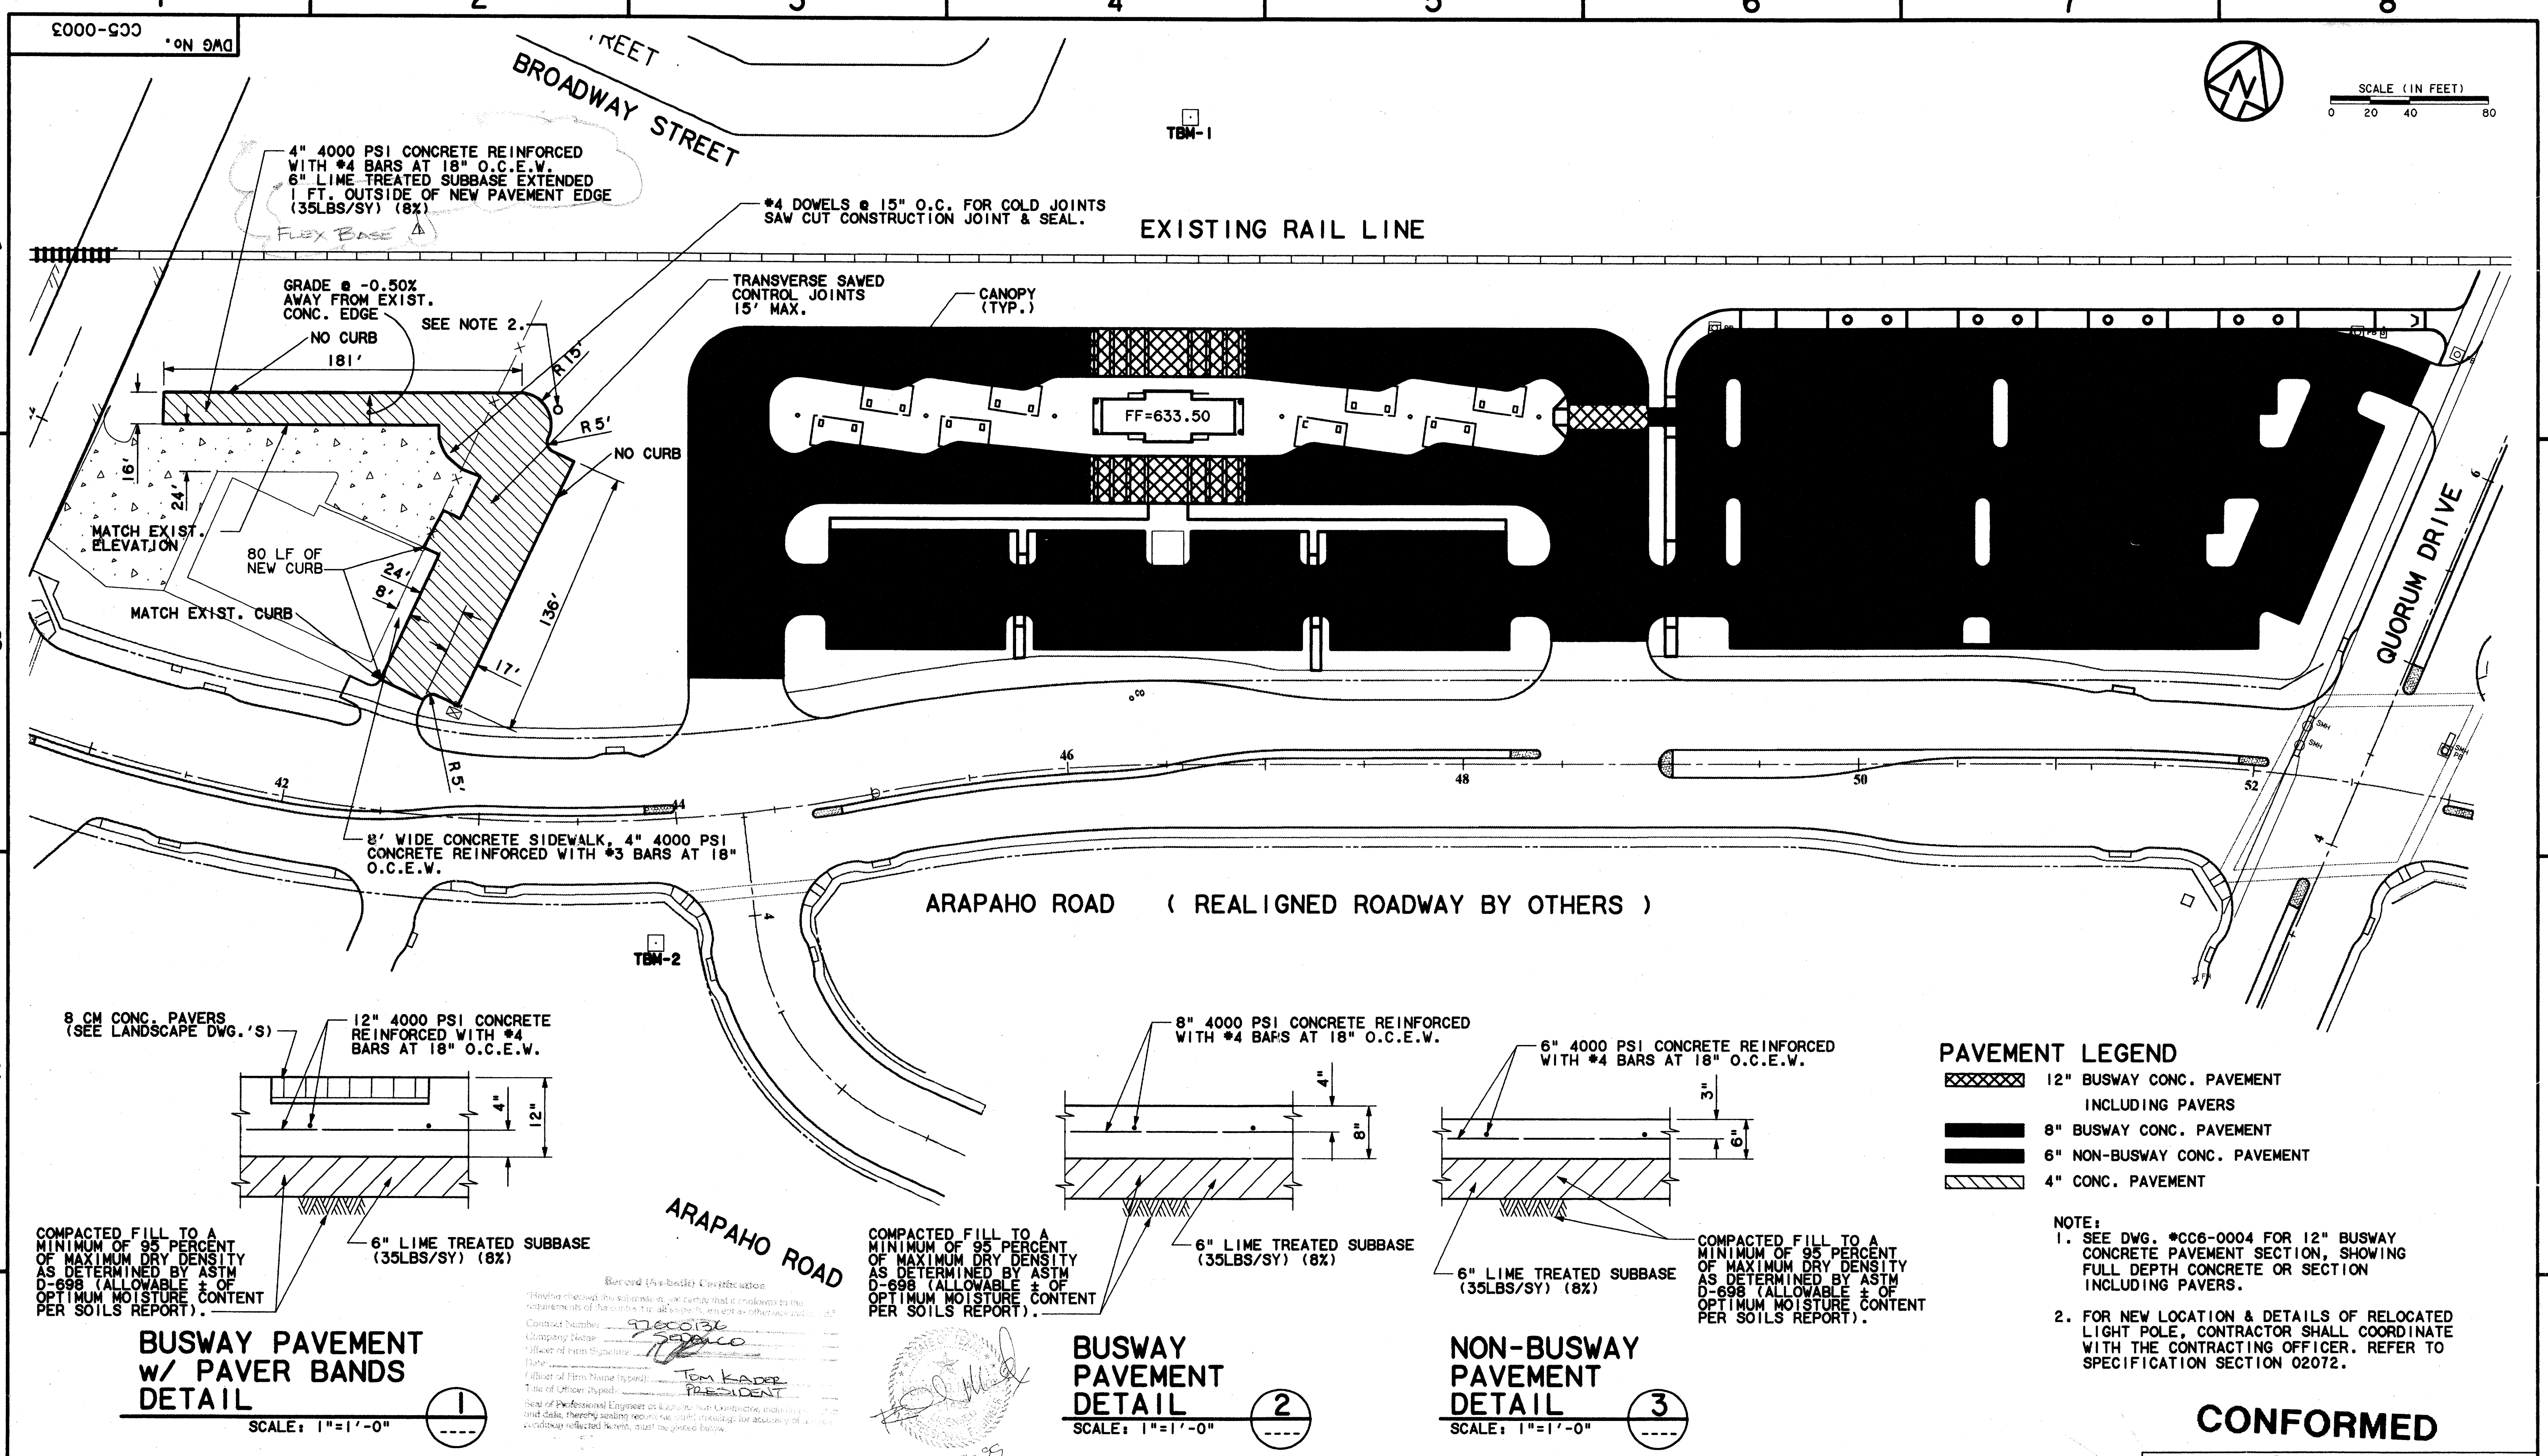

**BUSWAY PAVEMENT w/ PAVER BANDS DETAIL 1**  
SCALE: 1"=1'-0"


**BUSWAY PAVEMENT DETAIL 2**  
SCALE: 1"=1'-0"

**NON-BUSWAY PAVEMENT DETAIL 3**  
SCALE: 1"=1'-0"

**CONFORMED**


CONTRACT SHEET No. 21 OF 95

REV	DATE	DESCRIPTION	BY	ENG	CHK	APP	REV	DATE	DESCRIPTION	BY	ENG	CHK	APP
△	8/30/99	RECORD AS BUILT	EDW	SLM			△						
△							△						
△							△						
△							△						
△							△						

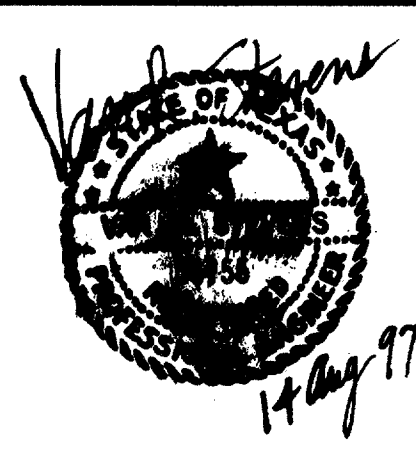

WENDY LOPEZ & ASSOC.  
 LOCKWOOD, ANDREWS & NEWMAN  
 THE SWA GROUP  
 GERARD & ASSOCIATES  
 ZAXON

**WLA**  
 WENDY LOPEZ & ASSOCIATES, INC.  
 ENGINEERING • SURVEYING • CONSTRUCTION SERVICES  
 102 MARKET CENTER BLVD - SUITE 510  
 DALLAS, TEXAS 75207  
 (214) 746-7777

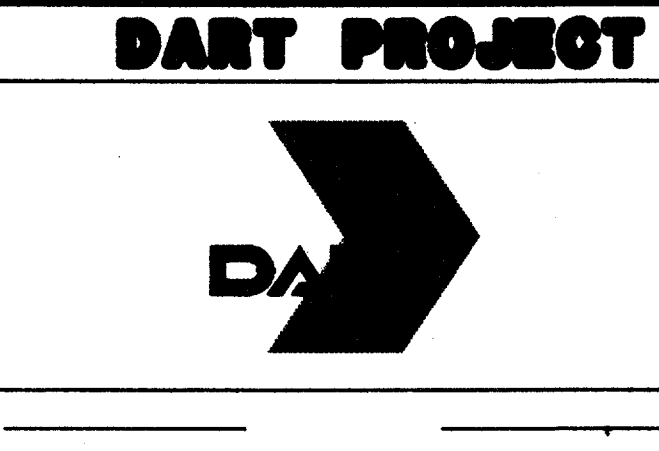

SCALE	1"=40'
DRAWN	D. KRUCIAK
DESIGNED	P. ZHAO
CHECKED	V. STEVENS
IN CHARGE	V. STEVENS
DATE	AUG. 14, 1997

**ADDISON TRANSIT CENTER PAVING PLAN**  
 CONTRACT C-97000136  
 DWG No. CC5-0003  
 REV 6