

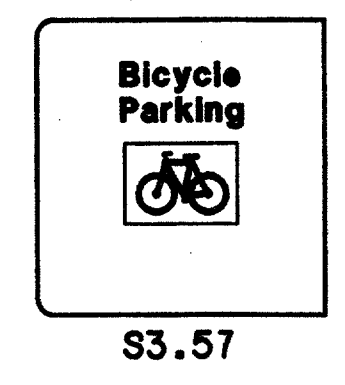
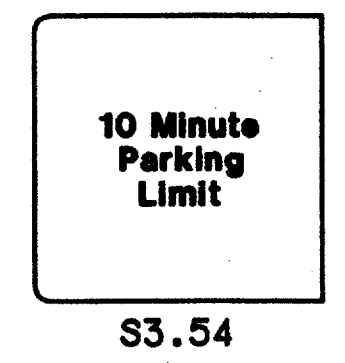
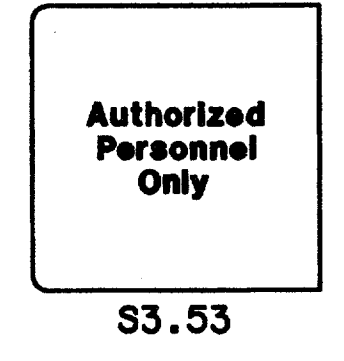
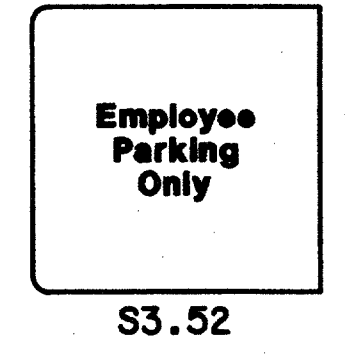
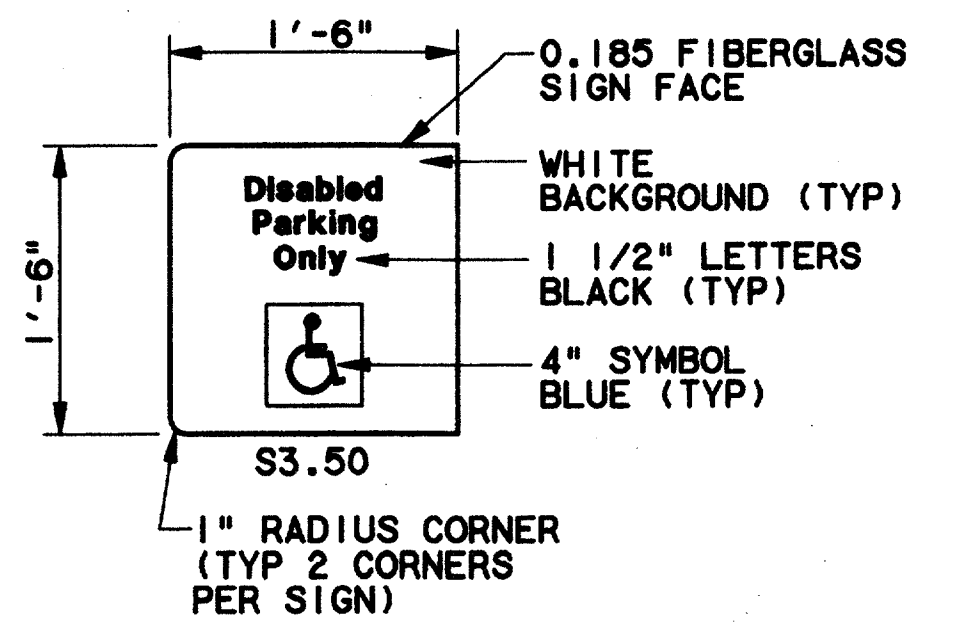
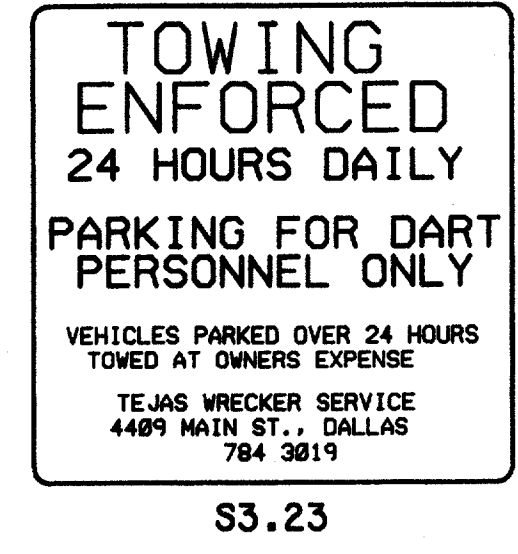
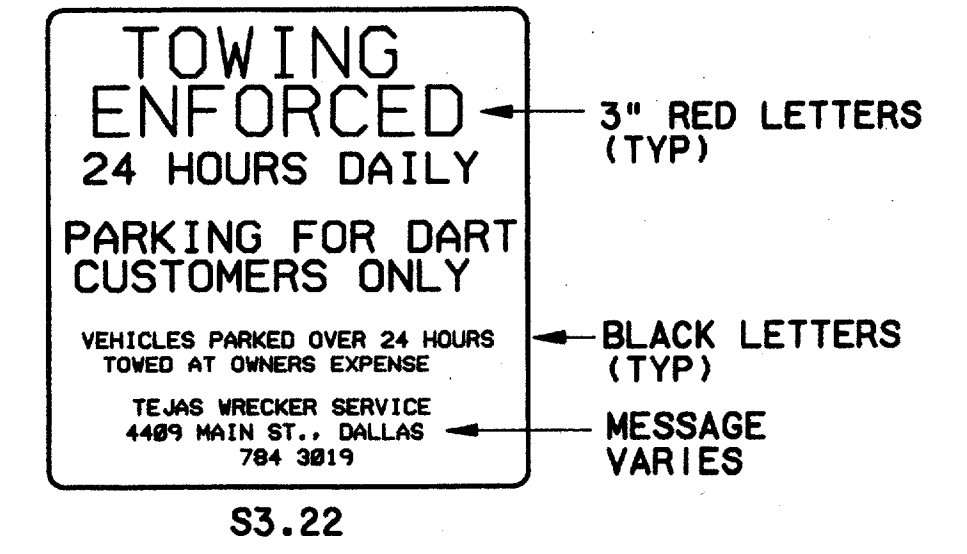
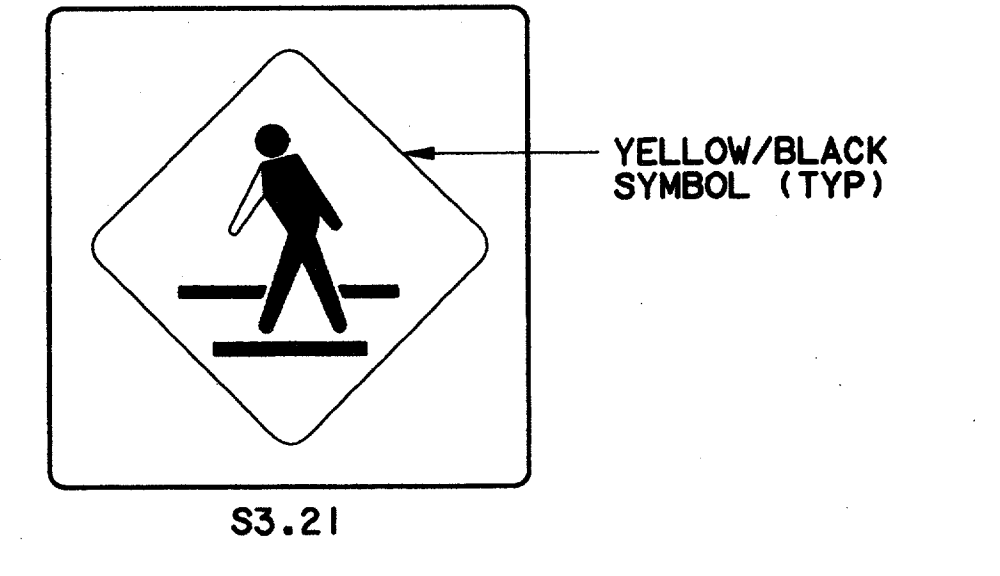
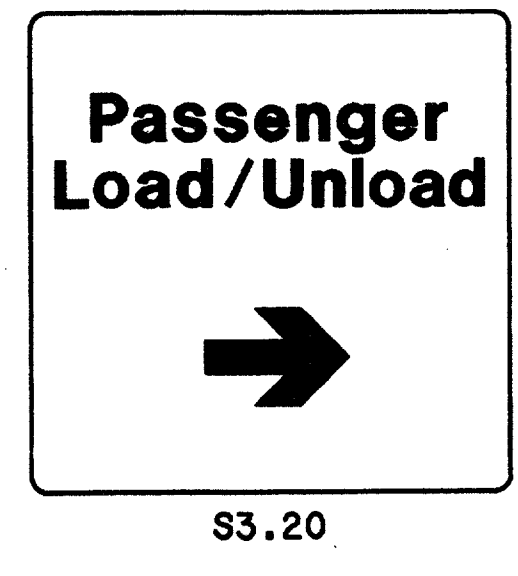
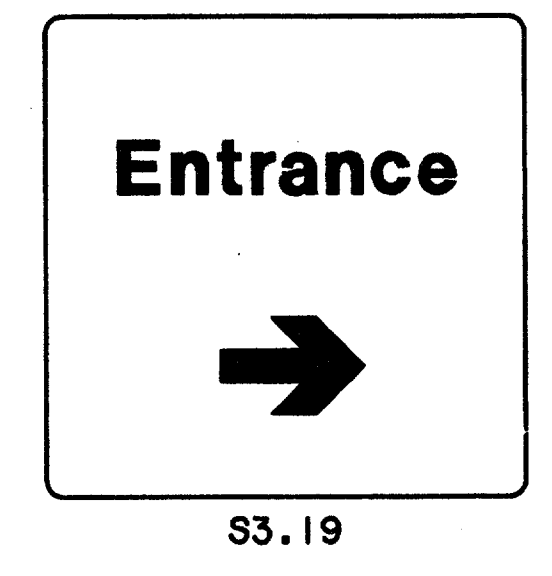
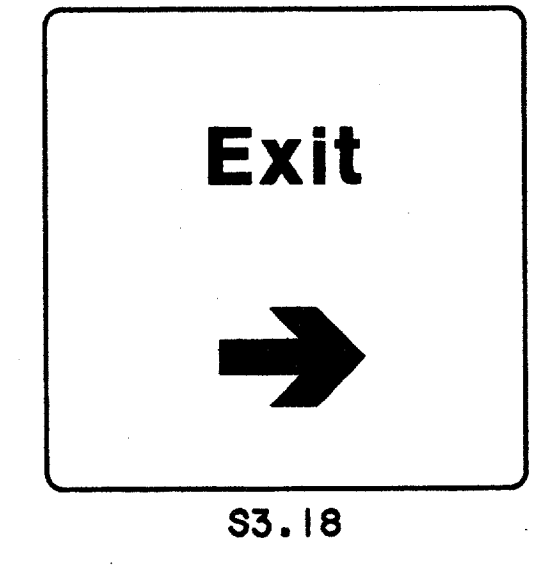
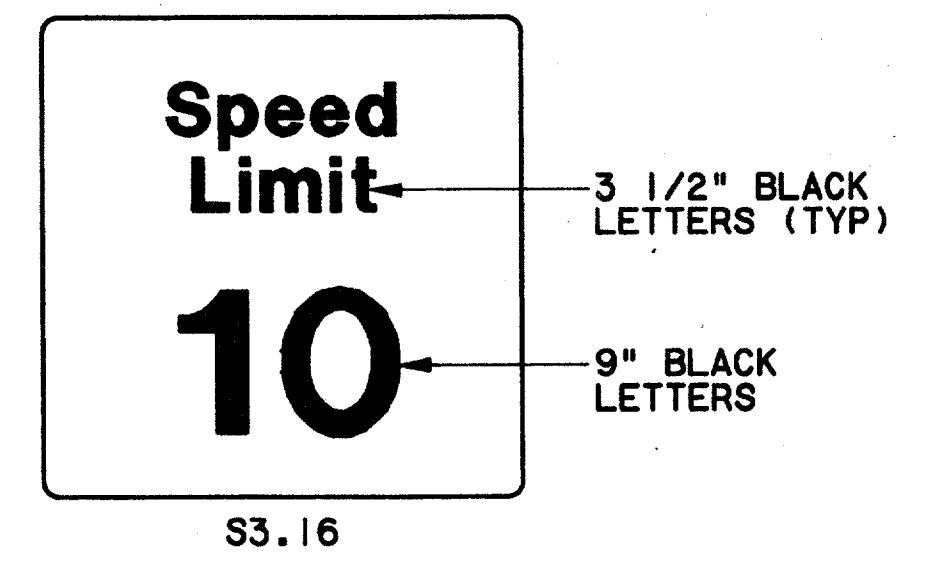
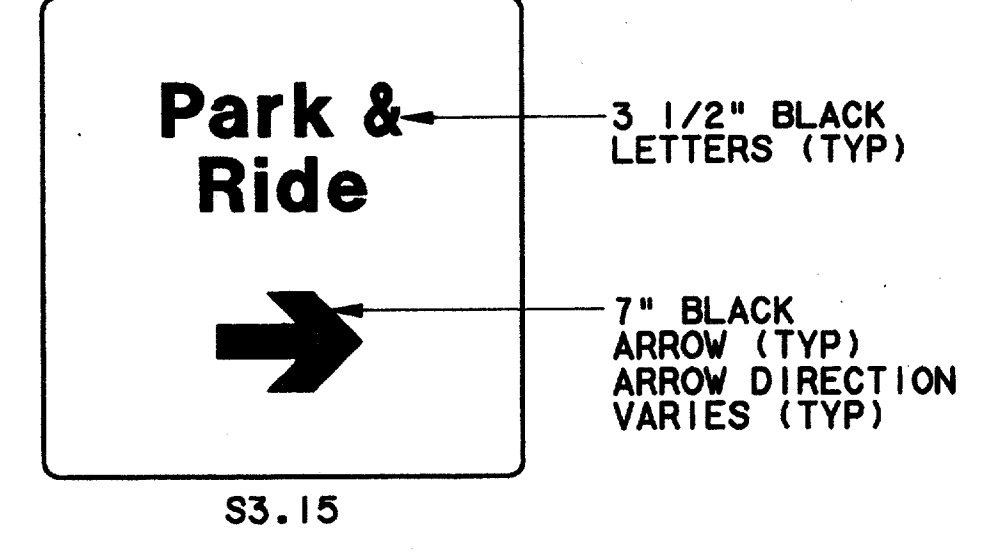
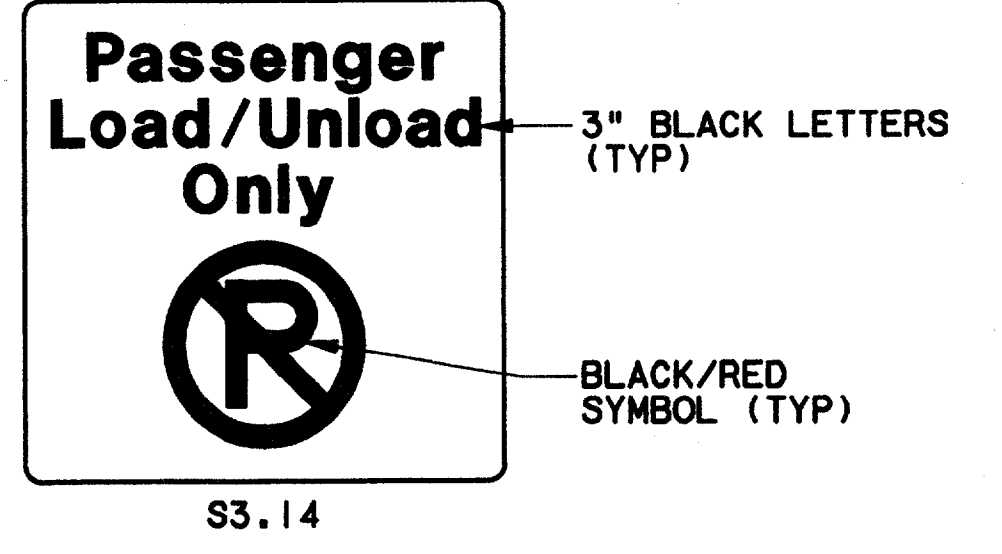
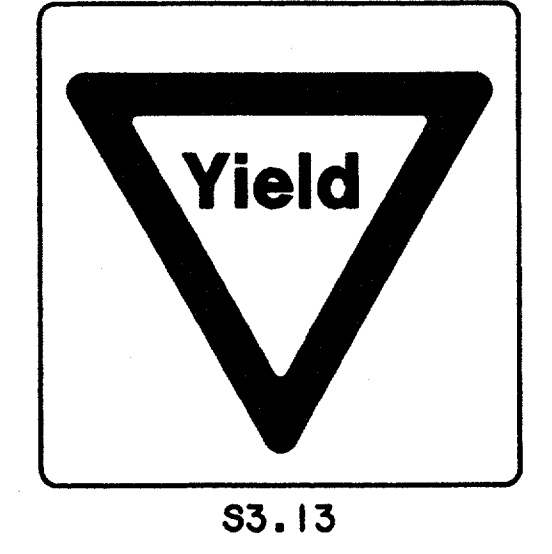


e:\94010.2\12\sh\abtesg01.008
13 AUG 97
DART.TBL
JAMES LANDRY

1000-133
ON 9A0

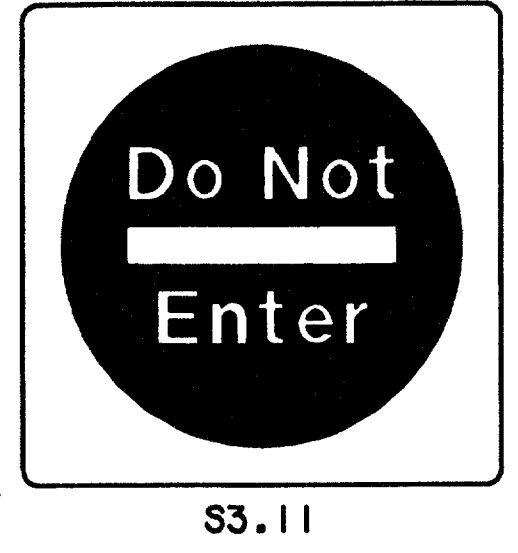

**ELEVATIONS SIGN
PANELS S3.50 - S3.56**
SCALE: 1"=1'-0" (A)

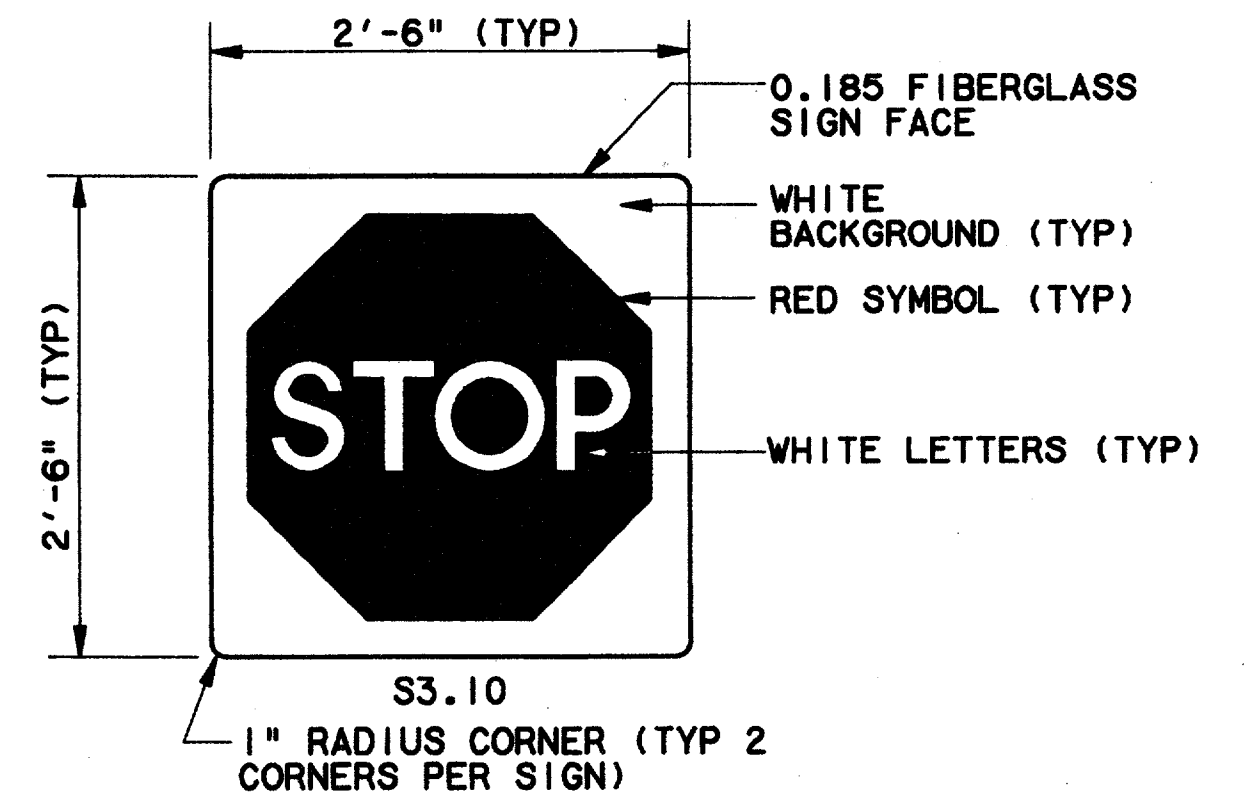

**ELEVATIONS SIGN
PANELS S3.10 - S3.23**
SCALE: 1"=1'-0" (B)

GENERAL NOTES

- REFER TO DART SIGN STANDARDS MANUAL FOR CORRECT FONTS, SYMBOLS AND REPRODUCTION ART.
- SIGNS 3.10-3.56 ARE SINGLE FACE CONFIGURATION UNLESS OTHERWISE NOTED ON SITE-SPECIFIC SIGN SCHEDULES.
- FOR SINGLE FACE CONFIGURATIONS BACK SIDE OF SIGN FACE TO BE WHITE.
- ALL GRAPHICS TO BE SCREEN-PRINTED.
- SIGNS WITH DIRECTIONAL DESIGNATION TO BE INDICATED AS FOLLOWS:
S3.XXR-ARROW RIGHT
S3.XXL-ARROW LEFT
S3.XXU-ARROW UP
- CAMERA READY ARTWORK FOR SIGN TO BE SUPPLIED BY OWNER.

Professional Engineer Seal
Tom Kader, President
7-7-99

CONFORMED

CONTRACT SHEET No. 27 OF 95

REV	DATE	DESCRIPTION	BY	ENG	CHK	APP	REV	DATE	DESCRIPTION	BY	ENG	CHK	APP

	WENDY LOPEZ & ASSOC. LOCKWOOD, ANDREWS & NEWMAN THE SWA GROUP GERARD & ASSOCIATES ZAXON		DART PROJECT 	SCALE: AS NOTED DRAWN: G. SCOLARO DESIGNED: A. ZREET CHECKED: L. BERNAUER IN CHARGE: V. STEVENS DATE: 14 AUG. 1997	SIGNAGE STANDARDS SIGN TYPES S3.10 - S3.56 TRAFFIC CONTROL SIGNS DETAILS
		CONTRACT C-97000136 DWG No. CCI-0001 REV 0			