
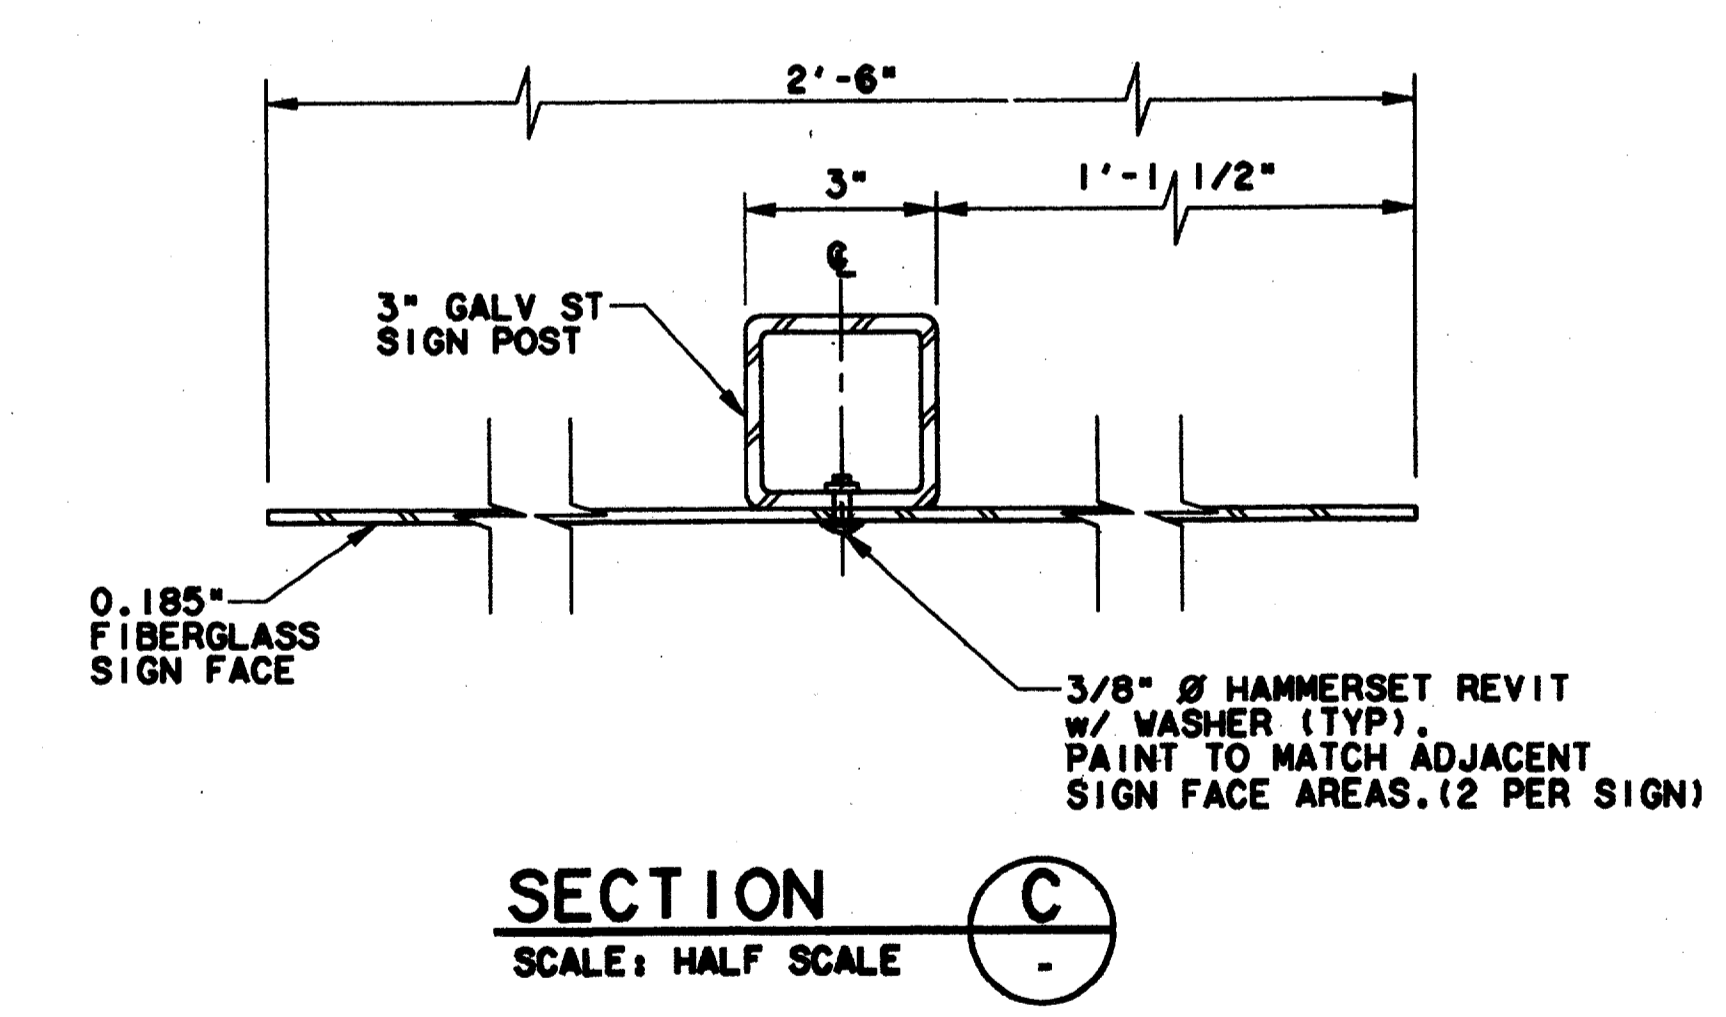
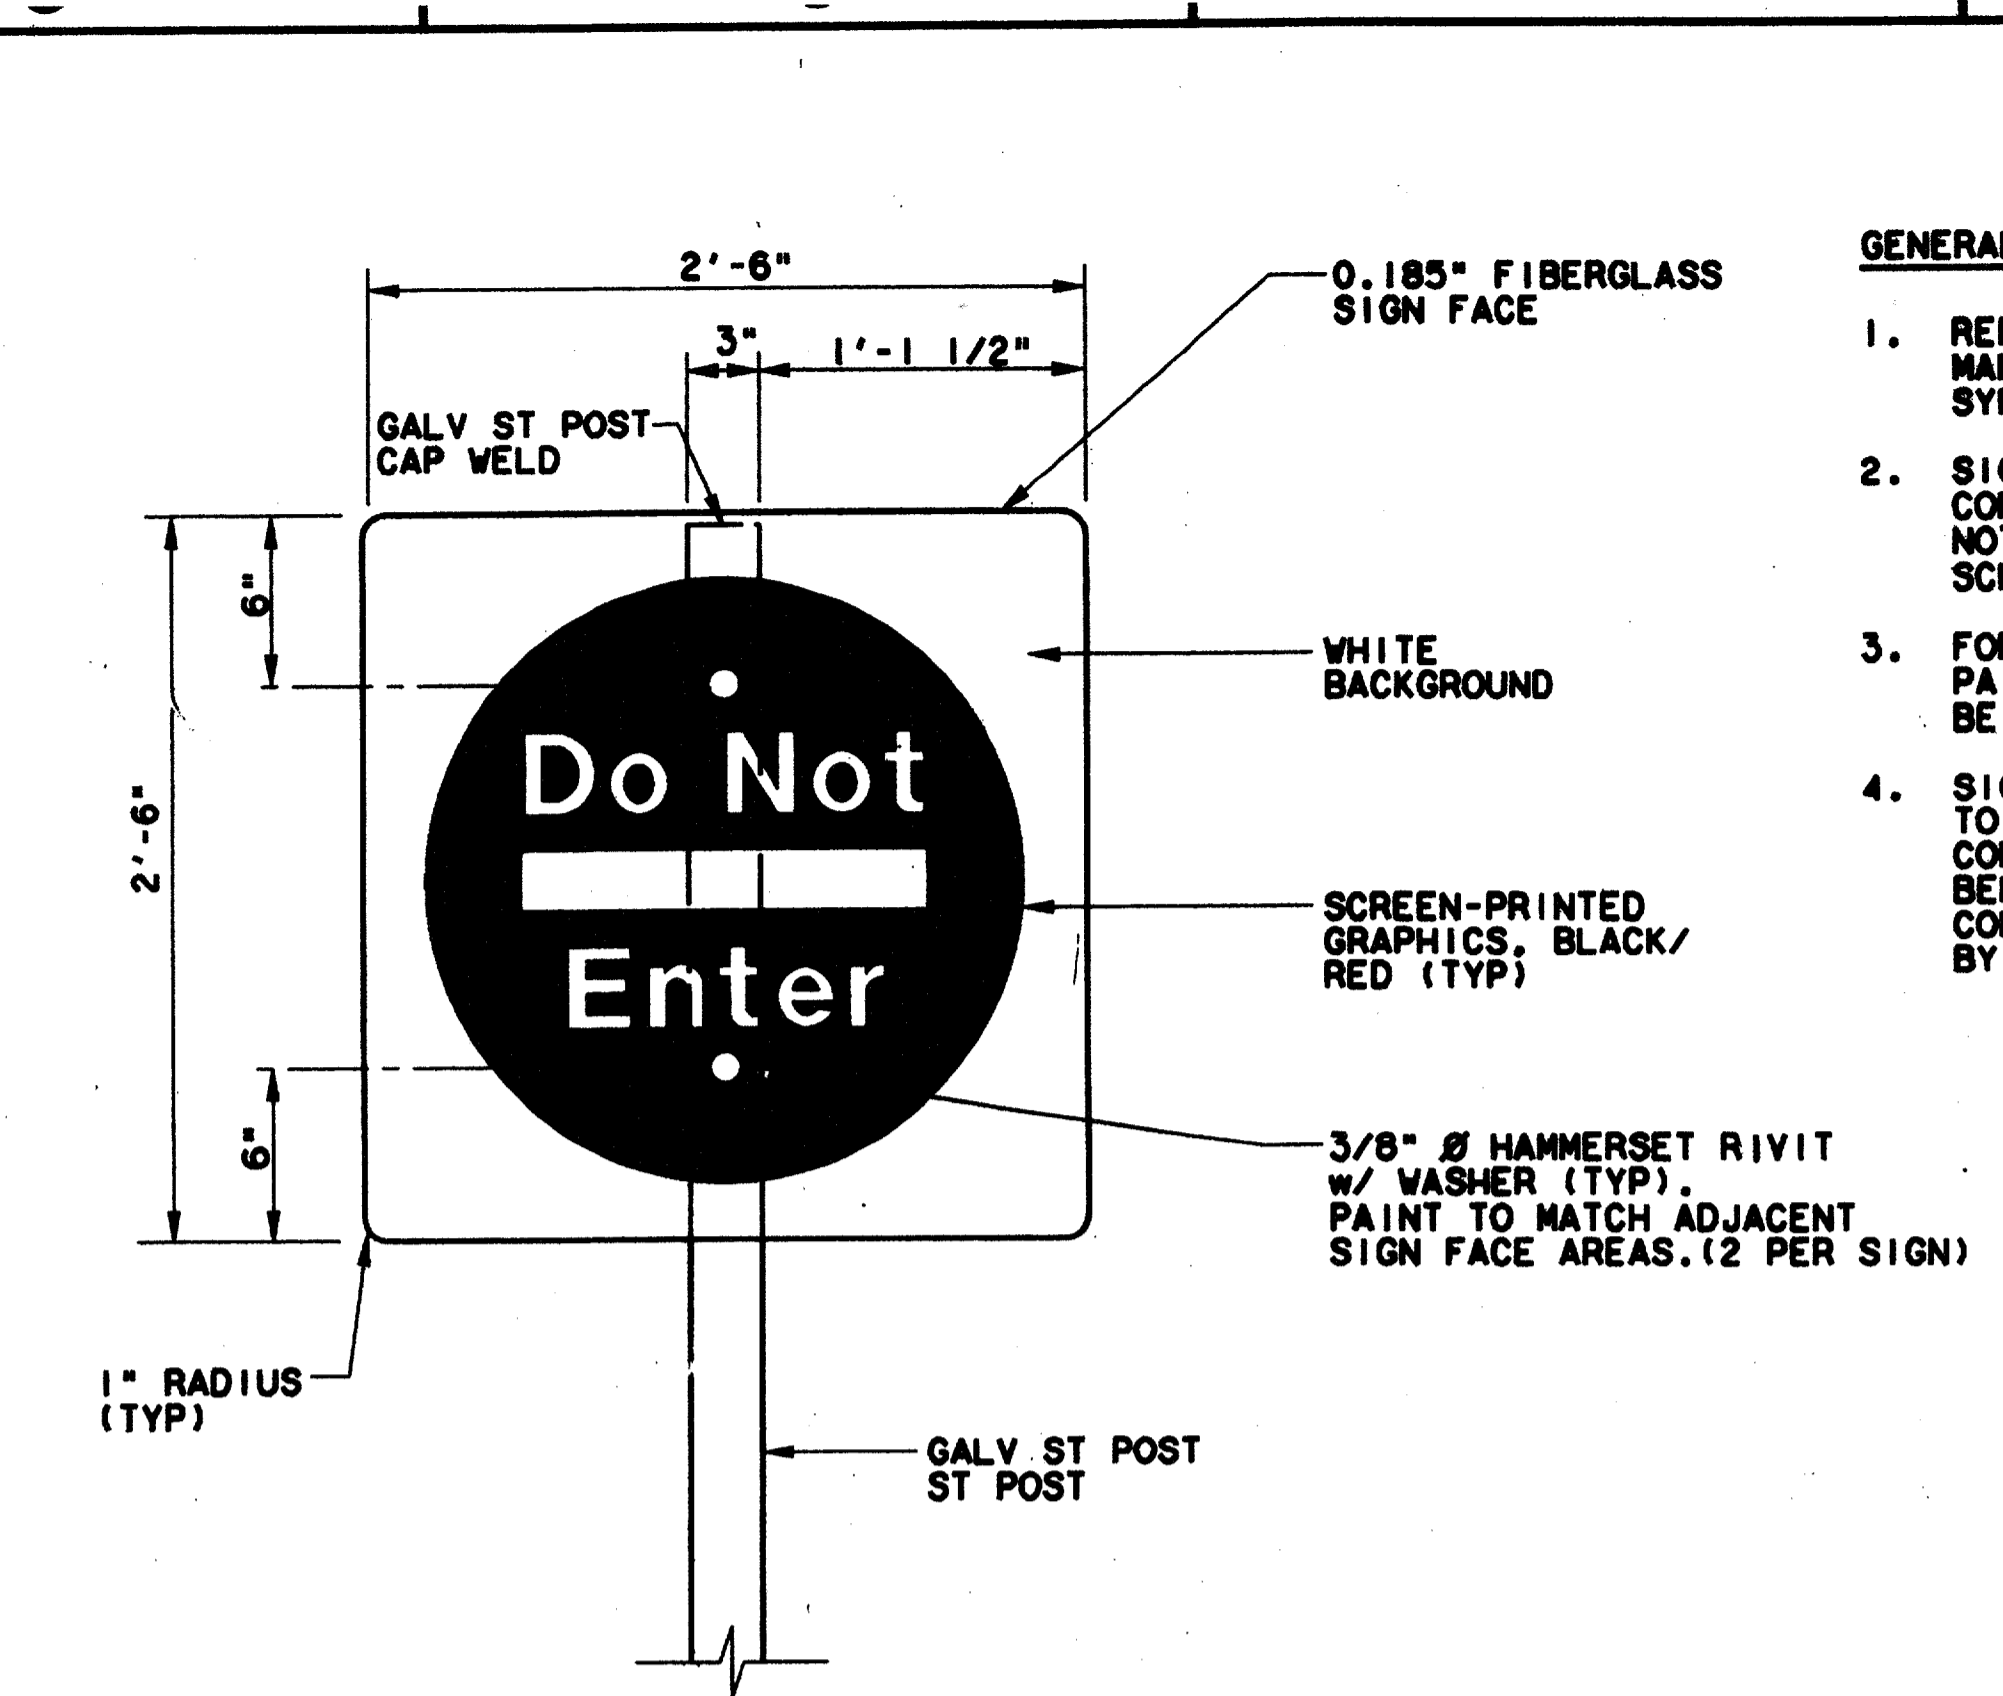
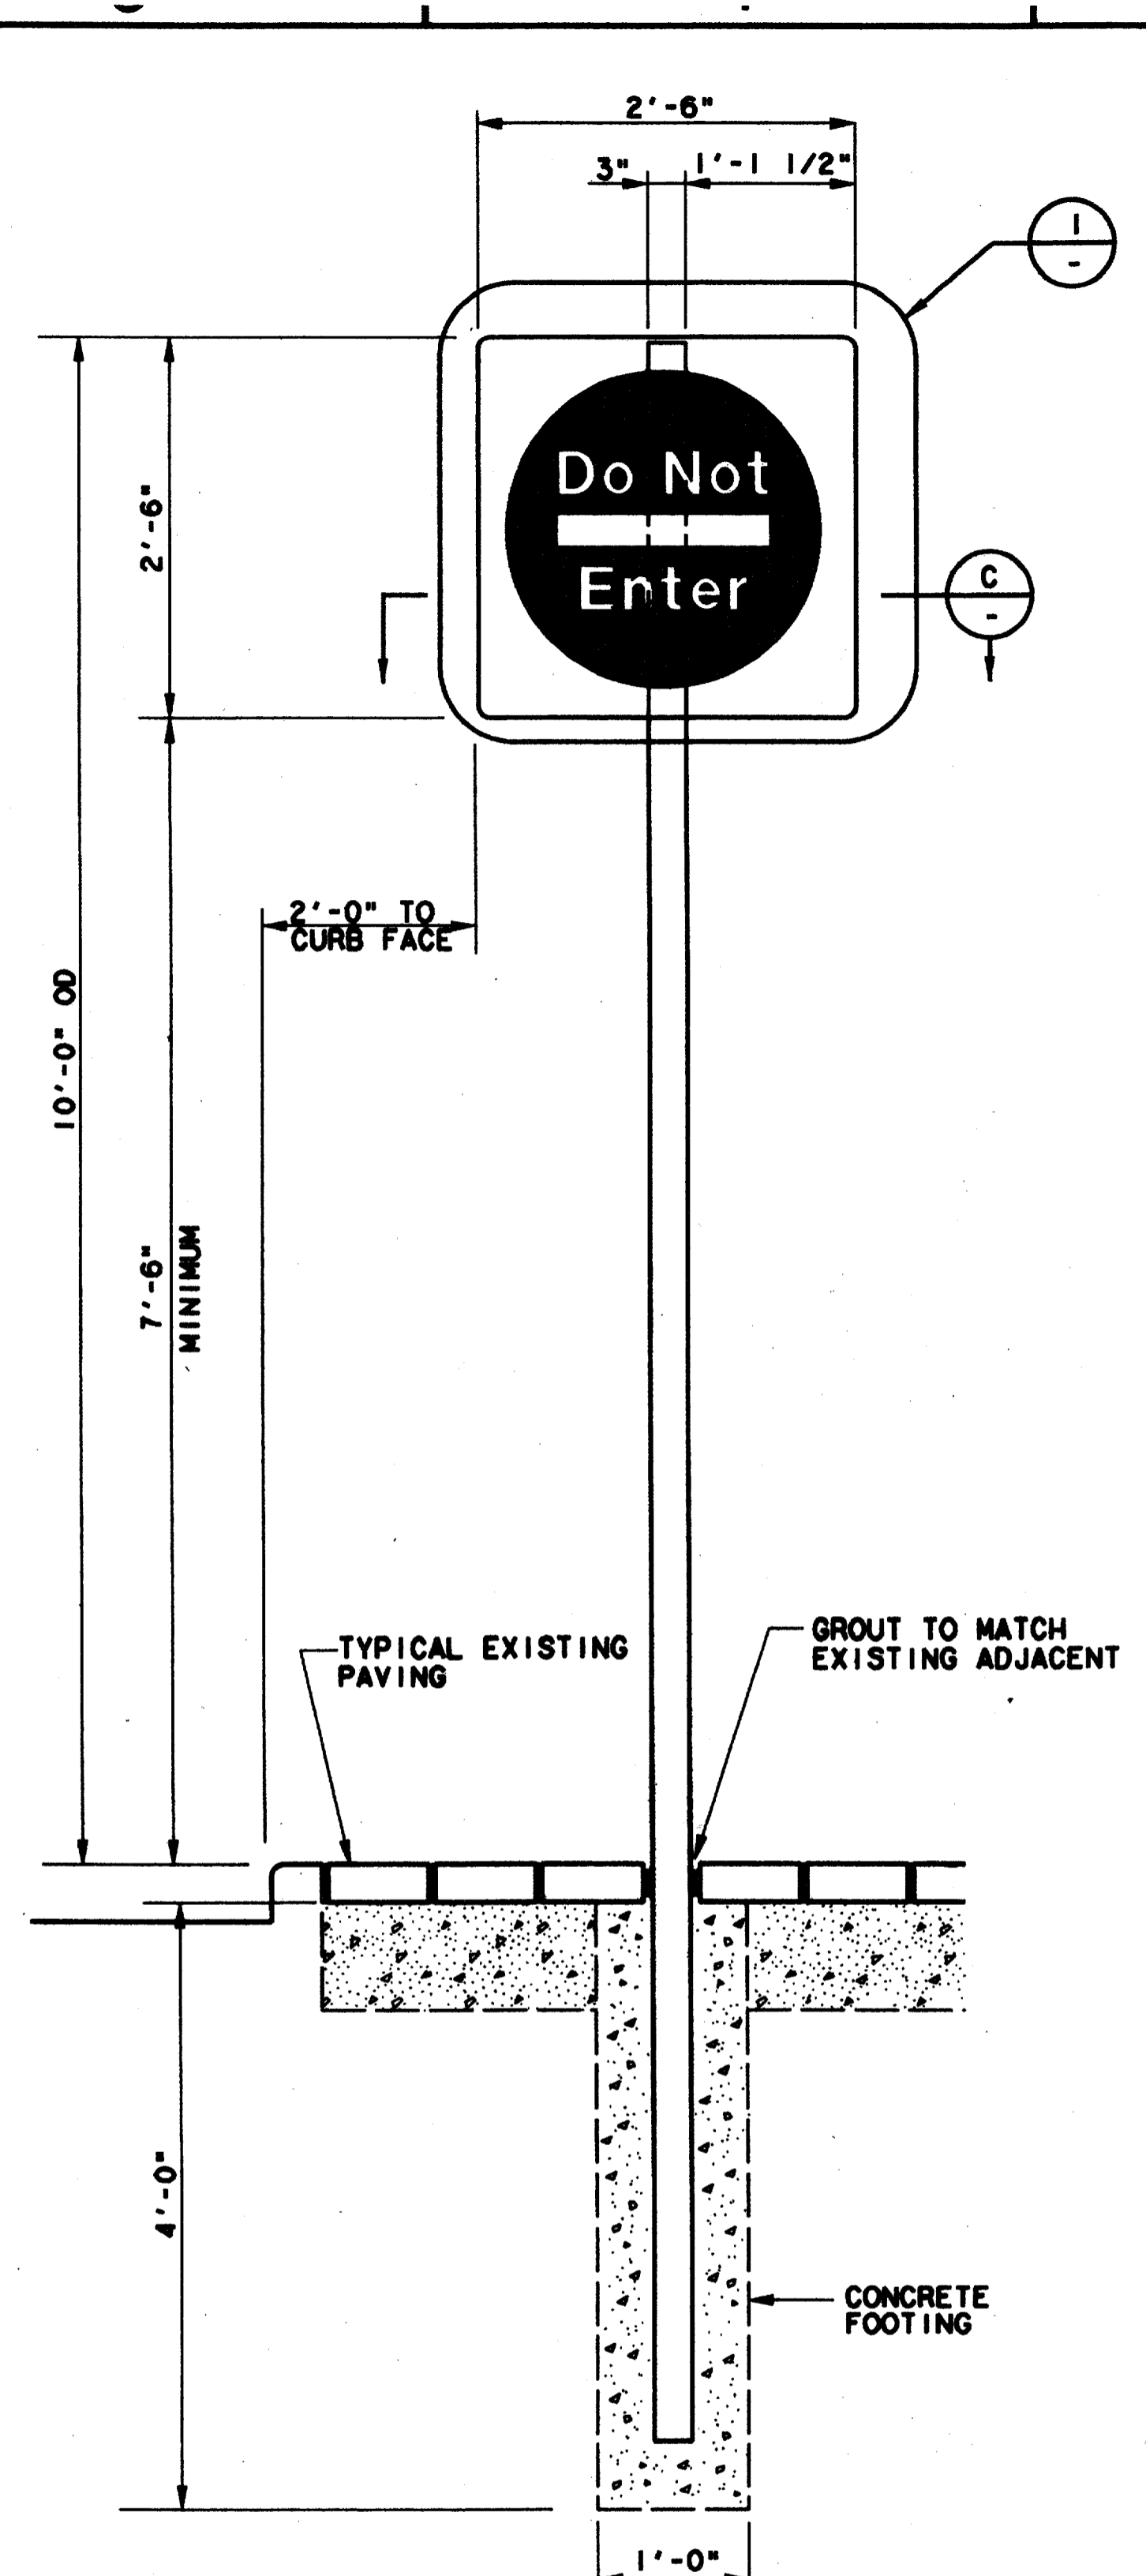


J:\PLOT\TTING\400M\DNCTSG33.PRF  
Dco\lv\in

LGDART.TBL

no ref logical, no ref name, no ref levels, no ref logical, no ref name, no ref levels, no ref logical, no ref name, no ref levels, no ref logical, no ref name, no ref levels, no ref logical, no ref name, no ref levels


no ref logical, no ref name, no ref levels, no ref logical, no ref name, no ref levels, no ref logical, no ref name, no ref levels, no ref logical, no ref name, no ref levels, no ref logical, no ref name, no ref levels

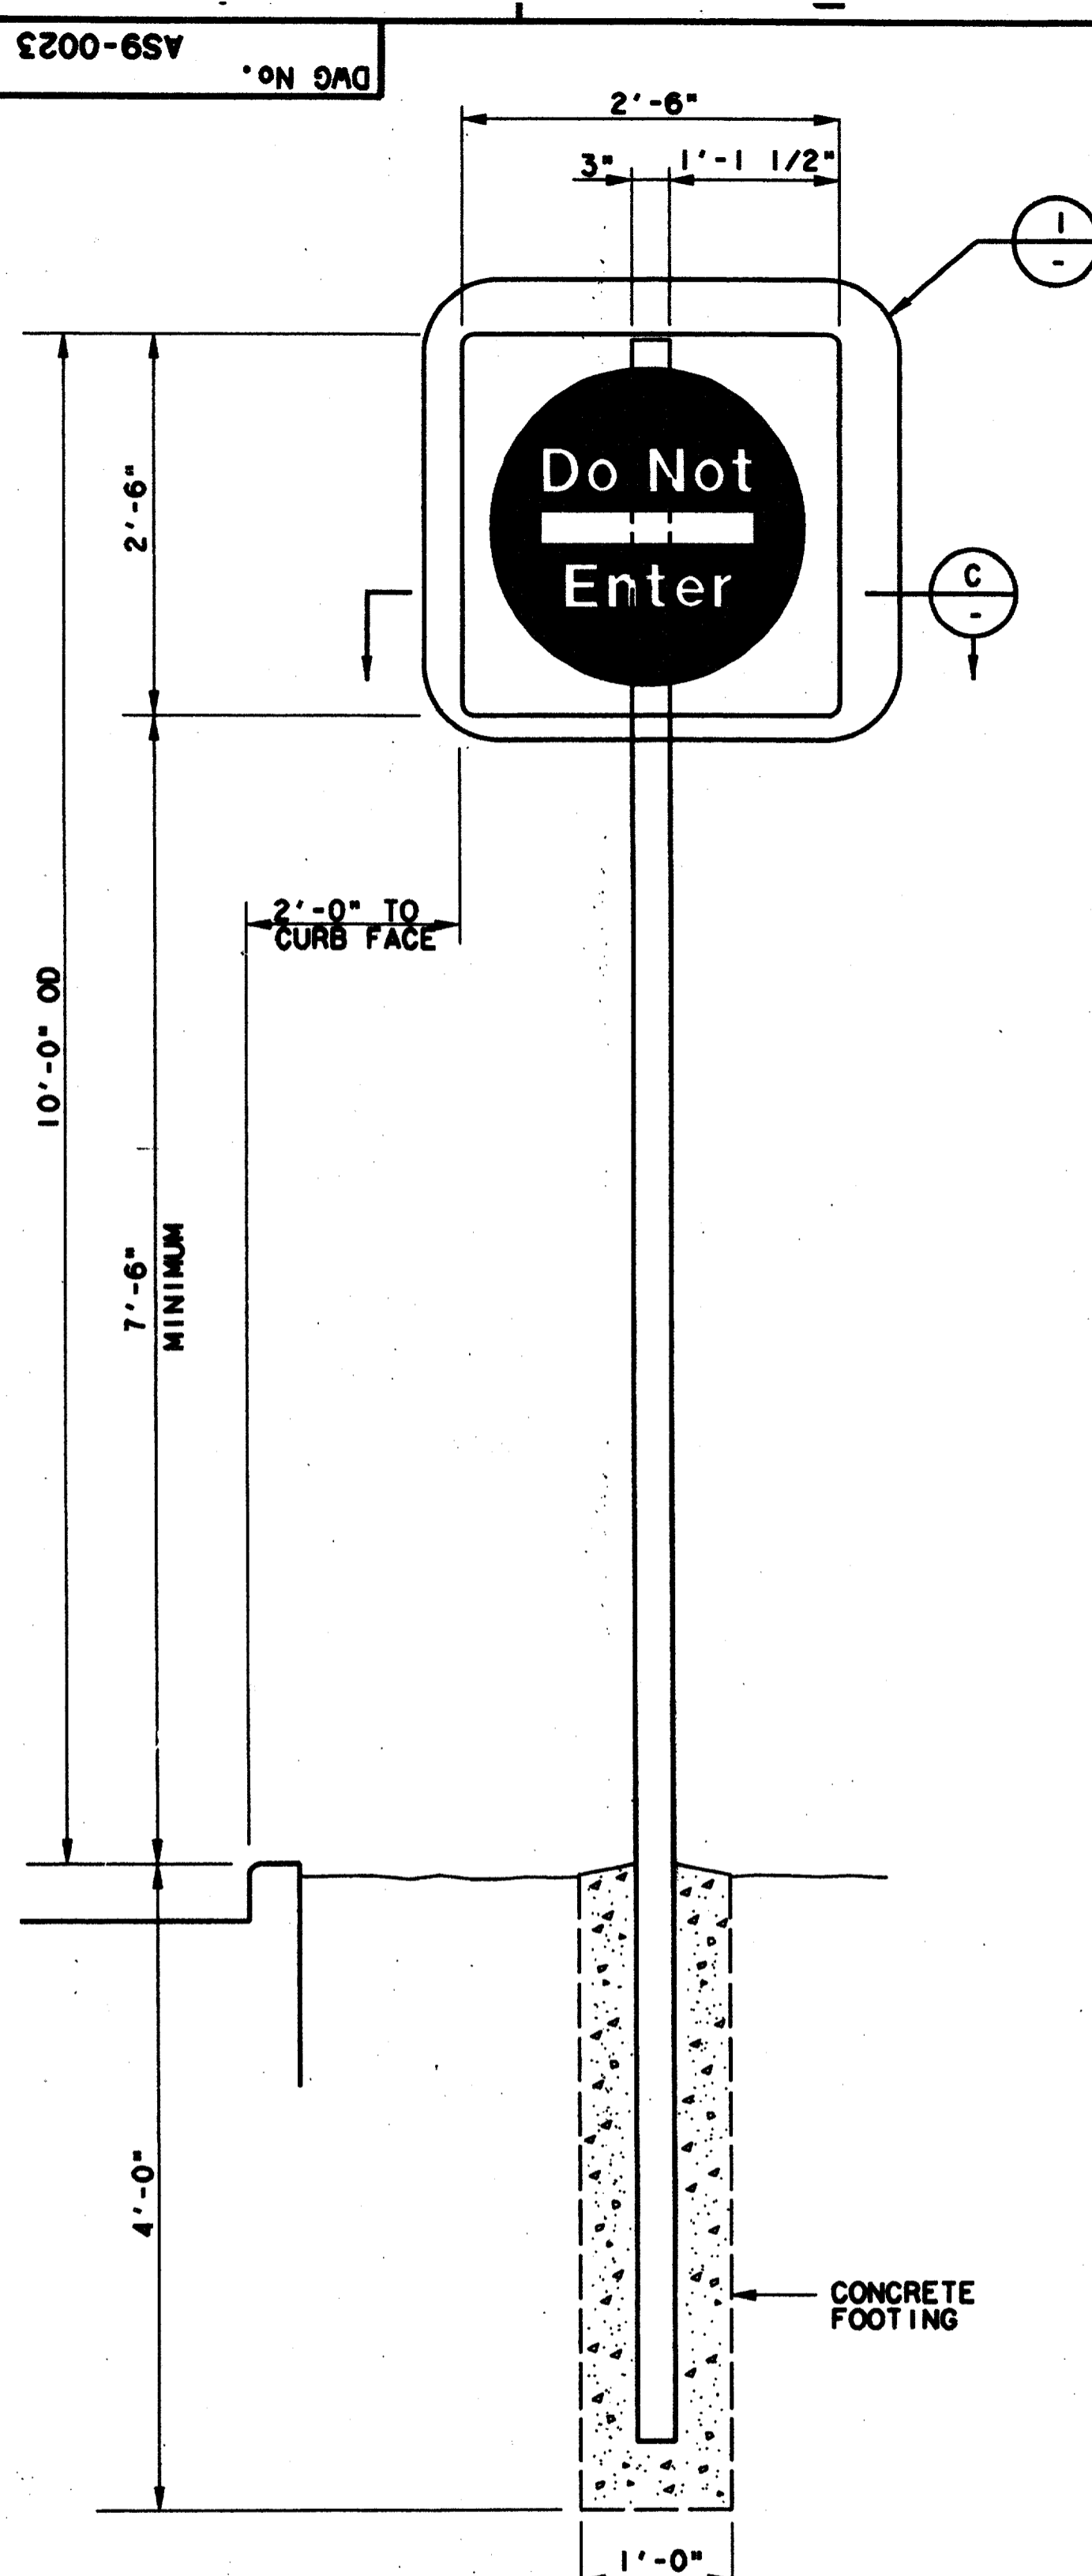

- GENERAL NOTES**
- REFER TO DART SIGN STANDARDS MANUAL FOR CORRECT FONTS, SYMBOLS AND REPRODUCTION ART.
  - SIGNS 3.10-3.56 ARE SINGLE FACE CONFIGURATION UNLESS OTHERWISE NOTED ON SITE-SPECIFIC SIGN SCHEDULES.
  - FOR SINGLE FACE CONFIGURATIONS PAINT BACK SIDE OF SIGN FACE TO BE WHITE.
  - SIGN POST, CAP AND FACE BRACKET TO BE UNFINISHED FOR LANDSCAPED CONDITIONS. PAINT GRAY TO MATCH BENJAMIN MOORE 1600 FOR PLATFORM CONDITIONS USING GALVITE PRIMER BY SHERWIN WILLIAMS OR EQUAL.

Record (As-built) Certification  
This firm checked this submission, we certify that it conforms to the requirements of the contract in all respects unless otherwise indicated.

Contract Number: 97060136  
Company Name: **TRALCO**  
Officer of Firm Signature: [Signature]  
Title of Officer (Typed): **TOM KADER**  
Director of Firm (Typed): **PRESIDENT**  
Date of Professional Engineer of Construction Contractor, including registration and date, together with second (as-built) drawings for accuracy of as-built condition reflected herein, shall be placed below:

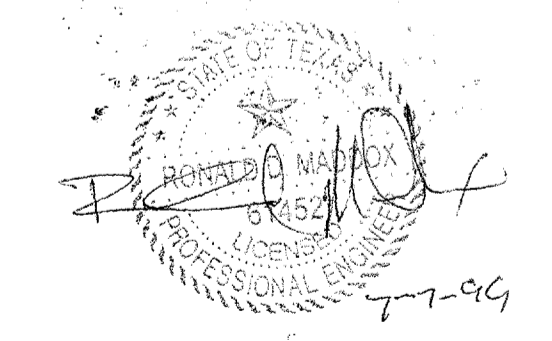

**CONFORMED**

CONTRACT SHEET No. 28A of 95

**SIGNAGE STANDARDS**

**SIGN TYPES S3.10 - S3.23  
TRAFFIC CONTROL SIGNS  
ELEVATIONS, DETAILS, SECTIONS**

REV	DATE	DESCRIPTION	BY	ENG	CHK	APP	REV	DATE	DESCRIPTION	BY	ENG	CHK	APP
△	6-25-93	ENTIRE SHEET REVISED					△						
△	1-25-94	ENTIRE SHEET REVISED	GS	DS	AZ		△						
△	7-7-95	ENTIRE SHEET REVISED	WMH	DS	AZ		△						
△							△						
△							△						
**ILUM**  
ILUM ASSOCIATES, INC.  
500 108th Avenue NE  
Suite 2450  
Belleview, VA 98004

**HUITT-ZOLLARS**  
3131 HIKKINNEY AVENUE/SUITE 600  
DALLAS, TEXAS 75214-9711-3311

Sverdrup Corporation  
Barton-Aschman Associates, Inc.  
Arredondo, Brunz & Associates, Inc.  
Hellmuth Obata & Kassabaum, Inc.

**DART PROJECT**

SCALE: AS NOTED  
DRAWN: G. SCOLARO  
DESIGNED: A. ZREET  
CHECKED: L. BERNAUER  
IN CHARGE: D. KELLY  
DATE: 16 FEB 93