


c:\cadd\94010.212\sheet\abtcut01.dwg
 02 MAR 98
 DART.TBL
 \$(USER)

DWG No. UC2-0001

BROADWAY STREET

MAJOR FIBER OPTIC LINES, GAS LINE, PETROLEUM PIPE LINE,
 AS WELL AS STORM SEWER AND WASTEWATER LINES EXIST
 WITHIN OR NEAR THIS 100' R.O.W. CONTRACTOR SHALL
 COORDINATE WITH THESE UTILITY COMPANY/AGENCIES
 AND SHALL EXERCISE EXTREME CARE WHEN WORKING
 WITHIN THIS AREA. CONTRACTOR IS RESPONSIBLE FOR
 ANY AND ALL COSTS INCURRED DUE TO DAMAGE OF LINES.

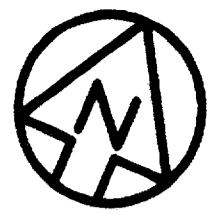

SCALE (IN FEET)
 0 20 40 80

EXISTING RAIL LINE

4" SP TELECOM CONDUIT

EXISTING MCI AND MFS
 FIBER OPTIC SYSTEMS
 CONTAINED WITHIN 4"
 SP TELECOM CONDUIT

4" SP TELECOM CONDUIT
 EXISTING MFS
 MANHOLES (SEE
 NOTE NO. 1)

EXISTING MFS
 MANHOLE (SEE
 NOTE NO. 1)

ARAPAHO ROAD (REALIGNED ROADWAY BY OTHERS)

ARAPAHO ROAD

QUORUM DRIVE

NOTES:

- 1. EXIST. FIBER OPTIC MANHOLE WILL BE ADJUSTED TO GRADE BY MCI/QWEST DURING CONSTRUCTION. CONTRACTOR TO COORDINATE WITH: GEORGE McELVAIN - 303/291-1419 SENIOR MANAGER - RELOCATIONS QWEST 555 17th ST. DENVER, CO. 80202 48 HOURS PRIOR TO ANY EXCAVATION.
- 2. SEE DWG NO. GCI-0004 FOR GENERAL NOTES

Record (As-Built) Certification


"Having checked this submission, we certify that it conforms to the requirements of the contract in all respects, except as otherwise indicated."
 Contract Number: 97000136
 Company Name: CAES
 Release of Firm Signature: *[Signature]*
 Title: *[Signature]*
 Name: *[Signature]*
 Title: PRESIDENT
 Date: 7-7-99
 Seal: PROFESSIONAL ENGINEER, STATE OF TEXAS, 7749

CONFORMED

CONTRACT SHEET No. 32 OF 95

ADDISON TRANSIT CENTER EXISTING UTILITIES LAYOUT

REV	DATE	DESCRIPTION	BY	ENG	CHK	APP	REV	DATE	DESCRIPTION	BY	ENG	CHK	APP

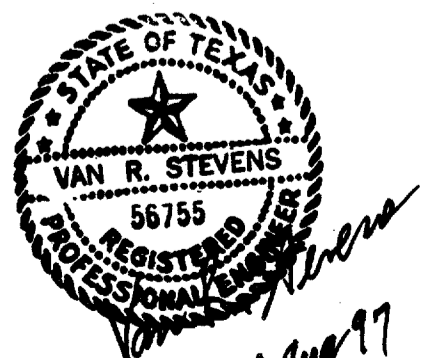

WENDY LOPEZ & ASSOC.
 LOCKWOOD, ANDREWS & NEWNAM
 THE SWA GROUP
 GERARD & ASSOCIATES
 ZAXON

WLA
 WENDY LOPEZ & ASSOCIATES, INC.
 ENGINEERING + SURVEYING + CONSTRUCTION SERVICES
 105 MARKET CENTER BLVD - SUITE 510
 DALLAS, TEXAS 75201
 (214) 748-7777

DART PROJECT

SCALE	1"=40'
DRAWN	D. KRUCIAK
DESIGNED	P. ZHAO
CHECKED	V. STEVENS
IN CHARGE	V. STEVENS
DATE	AUG. 14, 1997

CONTRACT C-97000136	DWG No. UC2-0001	REV 0
---------------------	------------------	-------