


c:\cadd\94010.212\sh\abtcu01.0  
 02 MAR 98  
 DART.TBL  
 \$(USER)

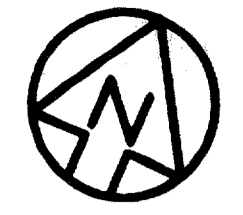

SCALE (IN FEET)  
 0 20 40 80

**NOTES:**

1. THE PROPOSED WATER LINE AND THE ASSOCIATED FIRE HYDRANTS ALONG ARAPAHO ROAD WILL BE DESIGNED AND CONSTRUCTED BY THE TOWN OF ADDISON WITH THE ARAPAHO ROAD PROJECT. THE WATER LINE WILL BE CONSTRUCTED BEHIND THE NORTH CURB OF ARAPAHO ROAD.
2. THE TOWN OF ADDISON WILL CONSTRUCT THE PROPOSED SANITARY SEWER FROM THE EXISTING LINE IN ARAPAHO ROAD TO THE NEW MANHOLE ON THE SITE.

Record (As-built) Certification  
 "Having checked this submission, we certify that it conforms to the requirements of the contract in all respects, except as otherwise indicated."  
 Control Number: 9700136  
 Company Name: BECALCO  
 Officer of Firm Signature: *[Signature]*  
 Date: 7/27/99  
 Title of Officer (Typed): TOM KADER, PRESIDENT  
 As a Professional Engineer of Construction Consultant, including signature and title, thereby attesting to the accuracy of the drawings or accuracy of as-built conditions reflected hereon, must be placed below.




**CONFORMED**


CONTRACT SHEET No. 33 OF 95

**ADDISON  
 TRANSIT CENTER  
 UTILITY  
 MODIFICATION PLAN**

REV	DATE	DESCRIPTION	BY	ENG	CHK	APP	REV	DATE	DESCRIPTION	BY	ENG	CHK	APP
△	8/30/99	Record As-Built Signature	JDM	JLM			△						
△							△						
△							△						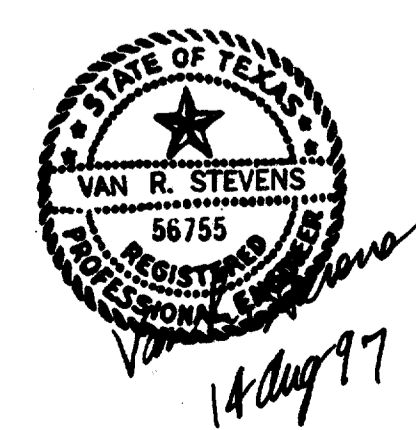
WENDY LOPEZ & ASSOC.  
 LOCKWOOD, ANDREWS & NEWMAN  
 THE SWA GROUP  
 GERARD & ASSOCIATES  
 ZAXON

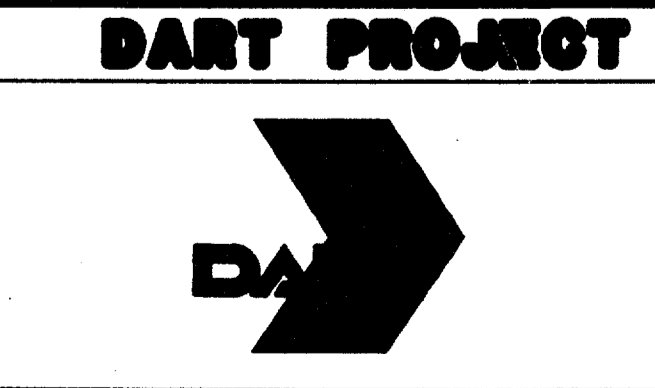

SCALE	1"=40'
DRAWN	D. KRUCIAK
DESIGNED	P. ZHAO
CHECKED	V. STEVENS
IN CHARGE	V. STEVENS
DATE	AUG. 14, 1997

CONTRACT C-97000136 DWG No. UC3-0001 REV 01