



e:\94010.212\sh\abfcoz05.001
13 AUG 97
DART.TBL
JAMES LANDRY

1000-100 ON DWG

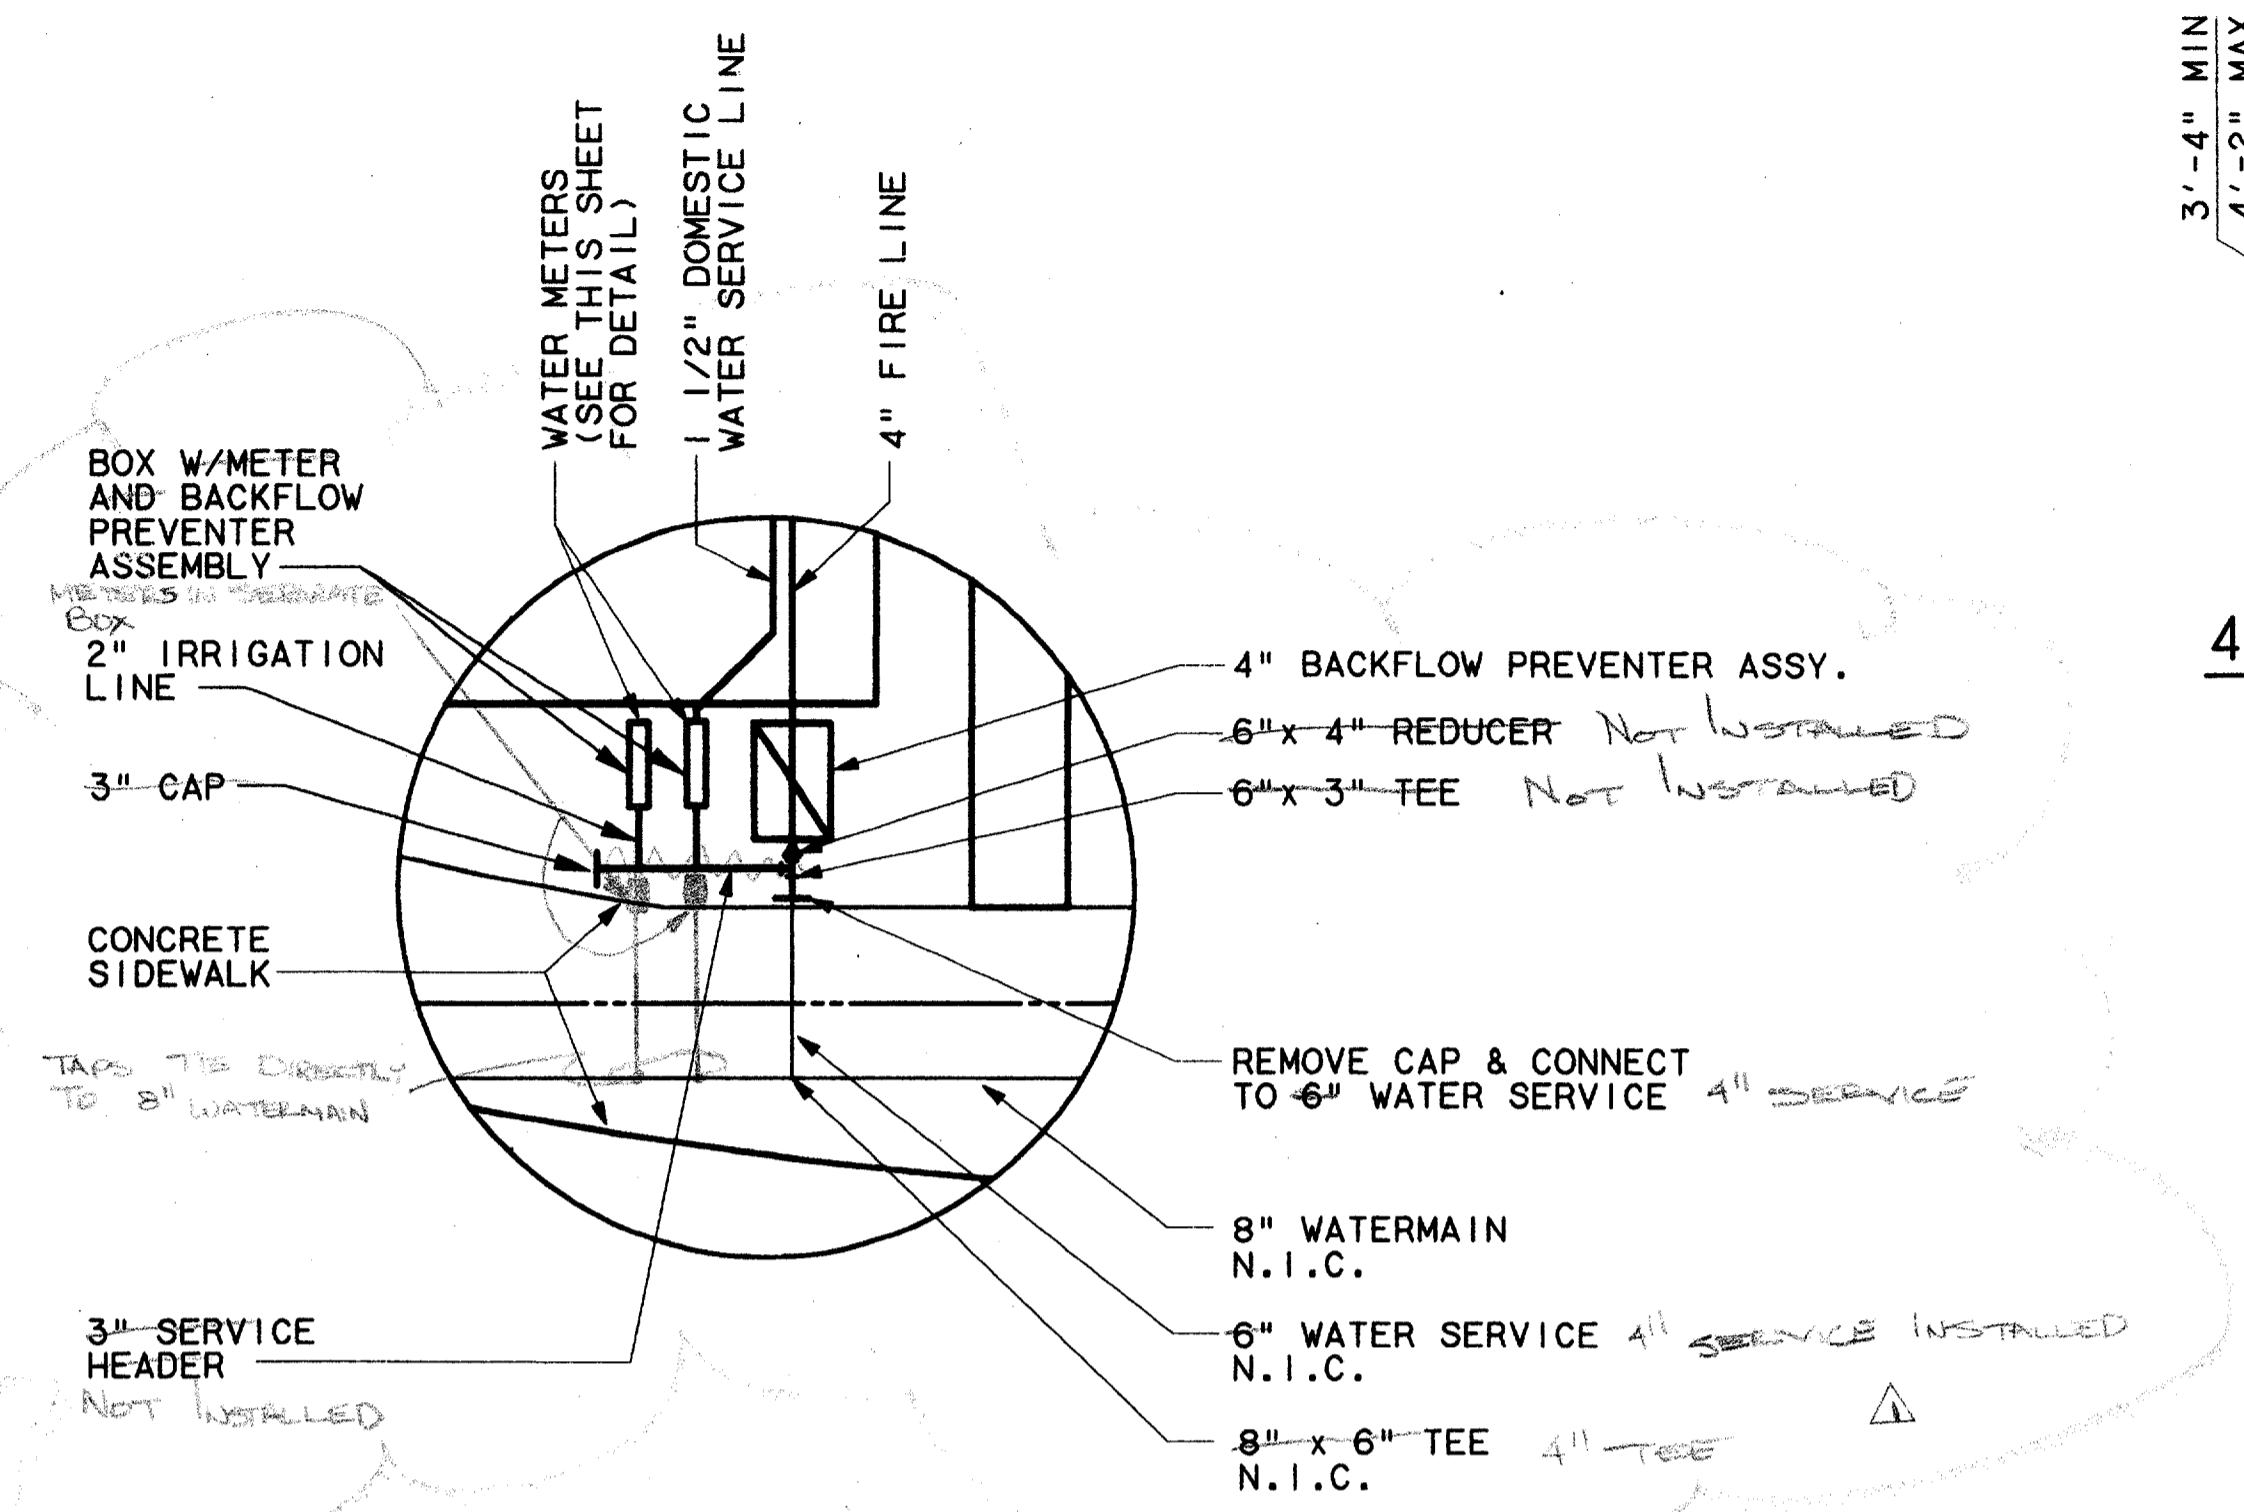


DETAIL 01
N.T.S. UC3-0002

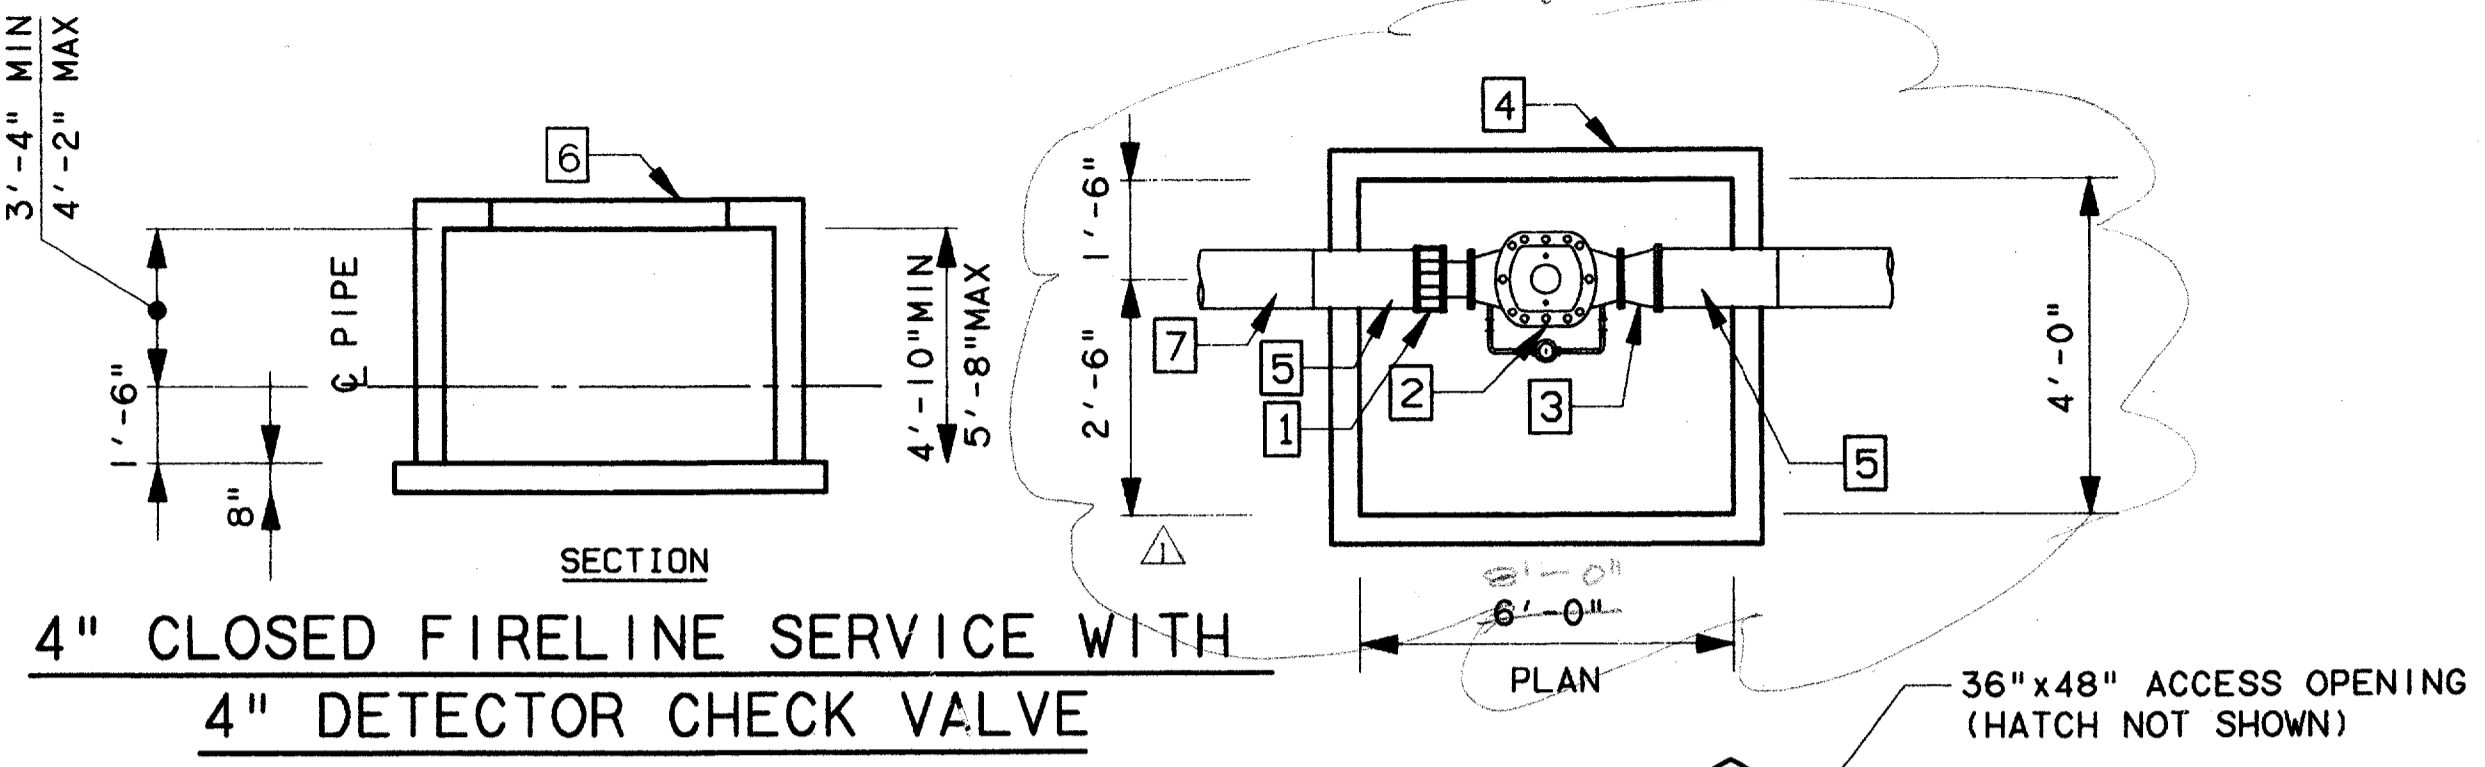

- 1 4" FLNG. CPLG. ADAPTER
- 2 4" DETECTOR CHECK VALVE WITH BYPASS METER
- 3 4"x6" LONG C.I. NIPPLE M.U. FLANGE
- 4 PRECAST DETECTOR CHECK VAULT
- 5 4" CL. 51 DUCTILE IRON PIPE
- 6 ACCESS FRAME & COVER

DIAGRAMATIC PRECAST CONCRETE VAULT DETAIL

N.T.S.

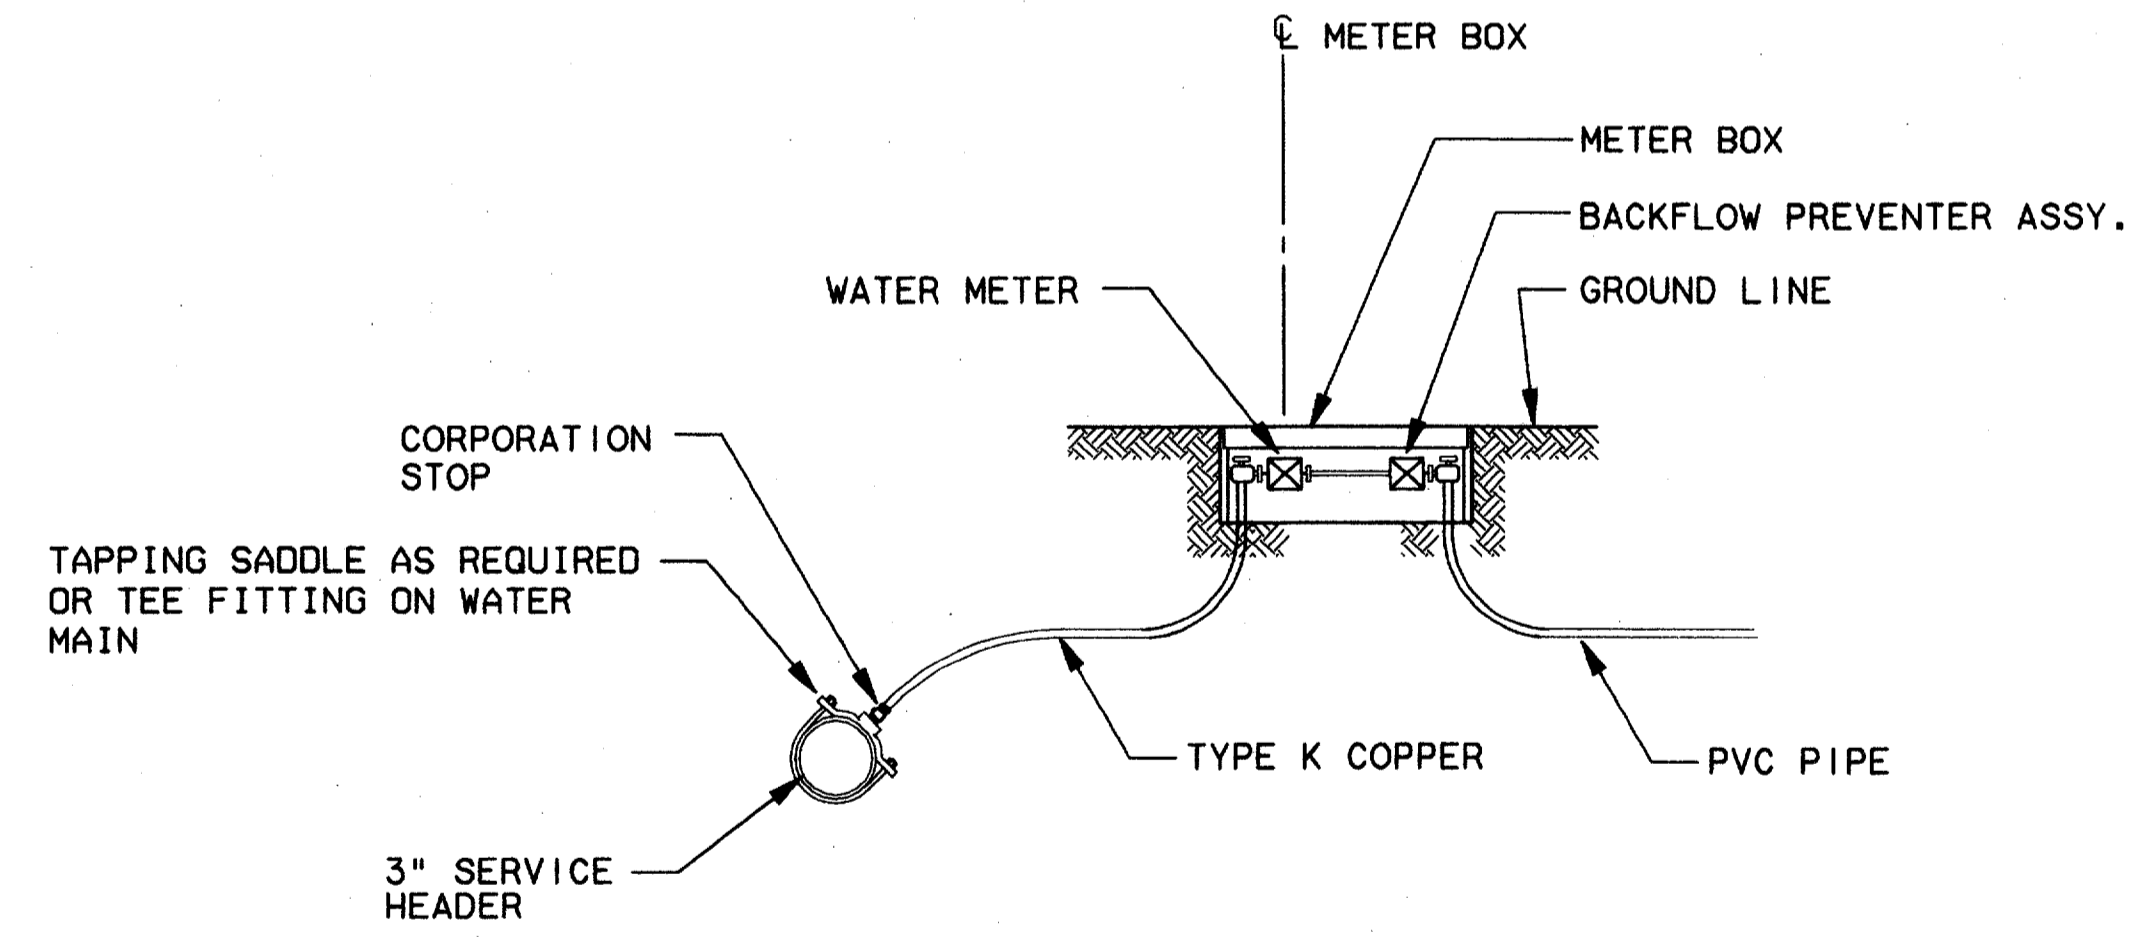


WATER SERVICE DETAIL
N.T.S.

NOTES:

1. DOMESTIC USE:
ALL SERVICES WITH FLOW CAPABILITIES LESS THAN OR EQUAL TO 160 GPM SHALL EMPLOY A DISC OR TURBINE METER CONFORMING TO TOWN OF ADDISON SPECIFICATION * 6-95.1, * 6-95.2, OR * 6-95.3 OR 6-95.4.
2. LAWN IRRIGATION:
ALL IRRIGATION SERVICES GREATER THAN OR EQUAL TO 1.5" SHALL EMPLOY A TURBINE TYPE METER CONFORMING WITH TOWN OF ADDISON SPECIFICATION * 6-95.3.
3. FIRE SERVICE:
GREATER THAN 2" SHALL EMPLOY EITHER DOUBLE CHECK DETECTOR ASSEMBLY, TOWN OF ADDISON SPECIFICATION * 6-95.7, OR * 6-95.8. THESE ASSEMBLIES SHALL BE APPROVED BY THE USCFCCHR.
4. ALL INSTALLATIONS MUST COMPLY WITH TOWN OF ADDISON CODE OF ORDINANCE, SECTION 18-94, INSTALLATION OF CHECK VALVES.
5. METER AND VALVE BOXES MUST BE LARGE ENOUGH TO ACCOMMODATE FUTURE TESTING, REPAIRS, ETC. AND COMPLY WITH TOWN OF ADDISON CODE OF ORDINANCE.


Record (As-Built) Certification
Having checked this submission, we certify that it conforms to the requirements of the contract in all respects except as otherwise indicated.
Contract Number: 97000136
Company Name: WEA
Official Firm Signature: [Signature]
Name: Tom Kader
Title: President
Date: 7-7-99
Seal of Professional Engineer of Construction Contractor, including signature and date, through sealing record (as-built) drawings for accuracy of as-built condition indicated herein, must be placed below.

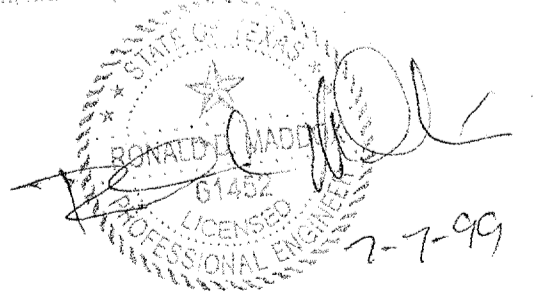

CONFORMED

CONTRACT SHEET No. 35 OF 95

REV	DATE	DESCRIPTION	BY	ENG	CHK	APP	REV	DATE	DESCRIPTION	BY	ENG	CHK	APP
△	8/30/99	RECORD (AS BUILT) SUBMITTAL	ROM		JLM		△						
△							△						
△							△						
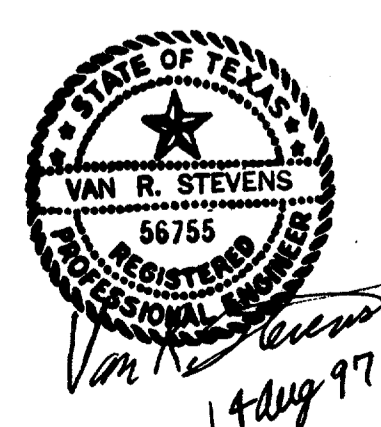

WENDY LOPEZ & ASSOC.
LOCKWOOD, ANDREWS & NEWNAM
THE SWA GROUP
GERARD & ASSOCIATES
ZAXON

WEA
WENDY LOPEZ & ASSOCIATES, INC.
ENGINEERING • SURVEYING • CONSTRUCTION SERVICES
205 MARKET CENTER BLVD - SUITE 300
DALLAS, TEXAS 75207
(214) 741-7777

DART PROJECT

SCALE	N.T.S.
DRAWN	D. KRUCIAK
DESIGNED	P. ZHAO
CHECKED	V. STEVENS
IN CHARGE	V. STEVENS
DATE	14 AUG. 1997

ADDISON
TRANSIT CENTER
UTILITY STANDARD
DETAILS

CONTRACT C-97000136
DWG No. UCI-0001
REV 01