



c:\cadd\94010.2\12\sh\abf\cp07.0
02 MAR 98
DART.TBL
\$(USER)

2000-200 .on 9AD

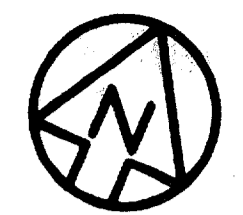

SCALE (IN FEET)
0 20 40 80

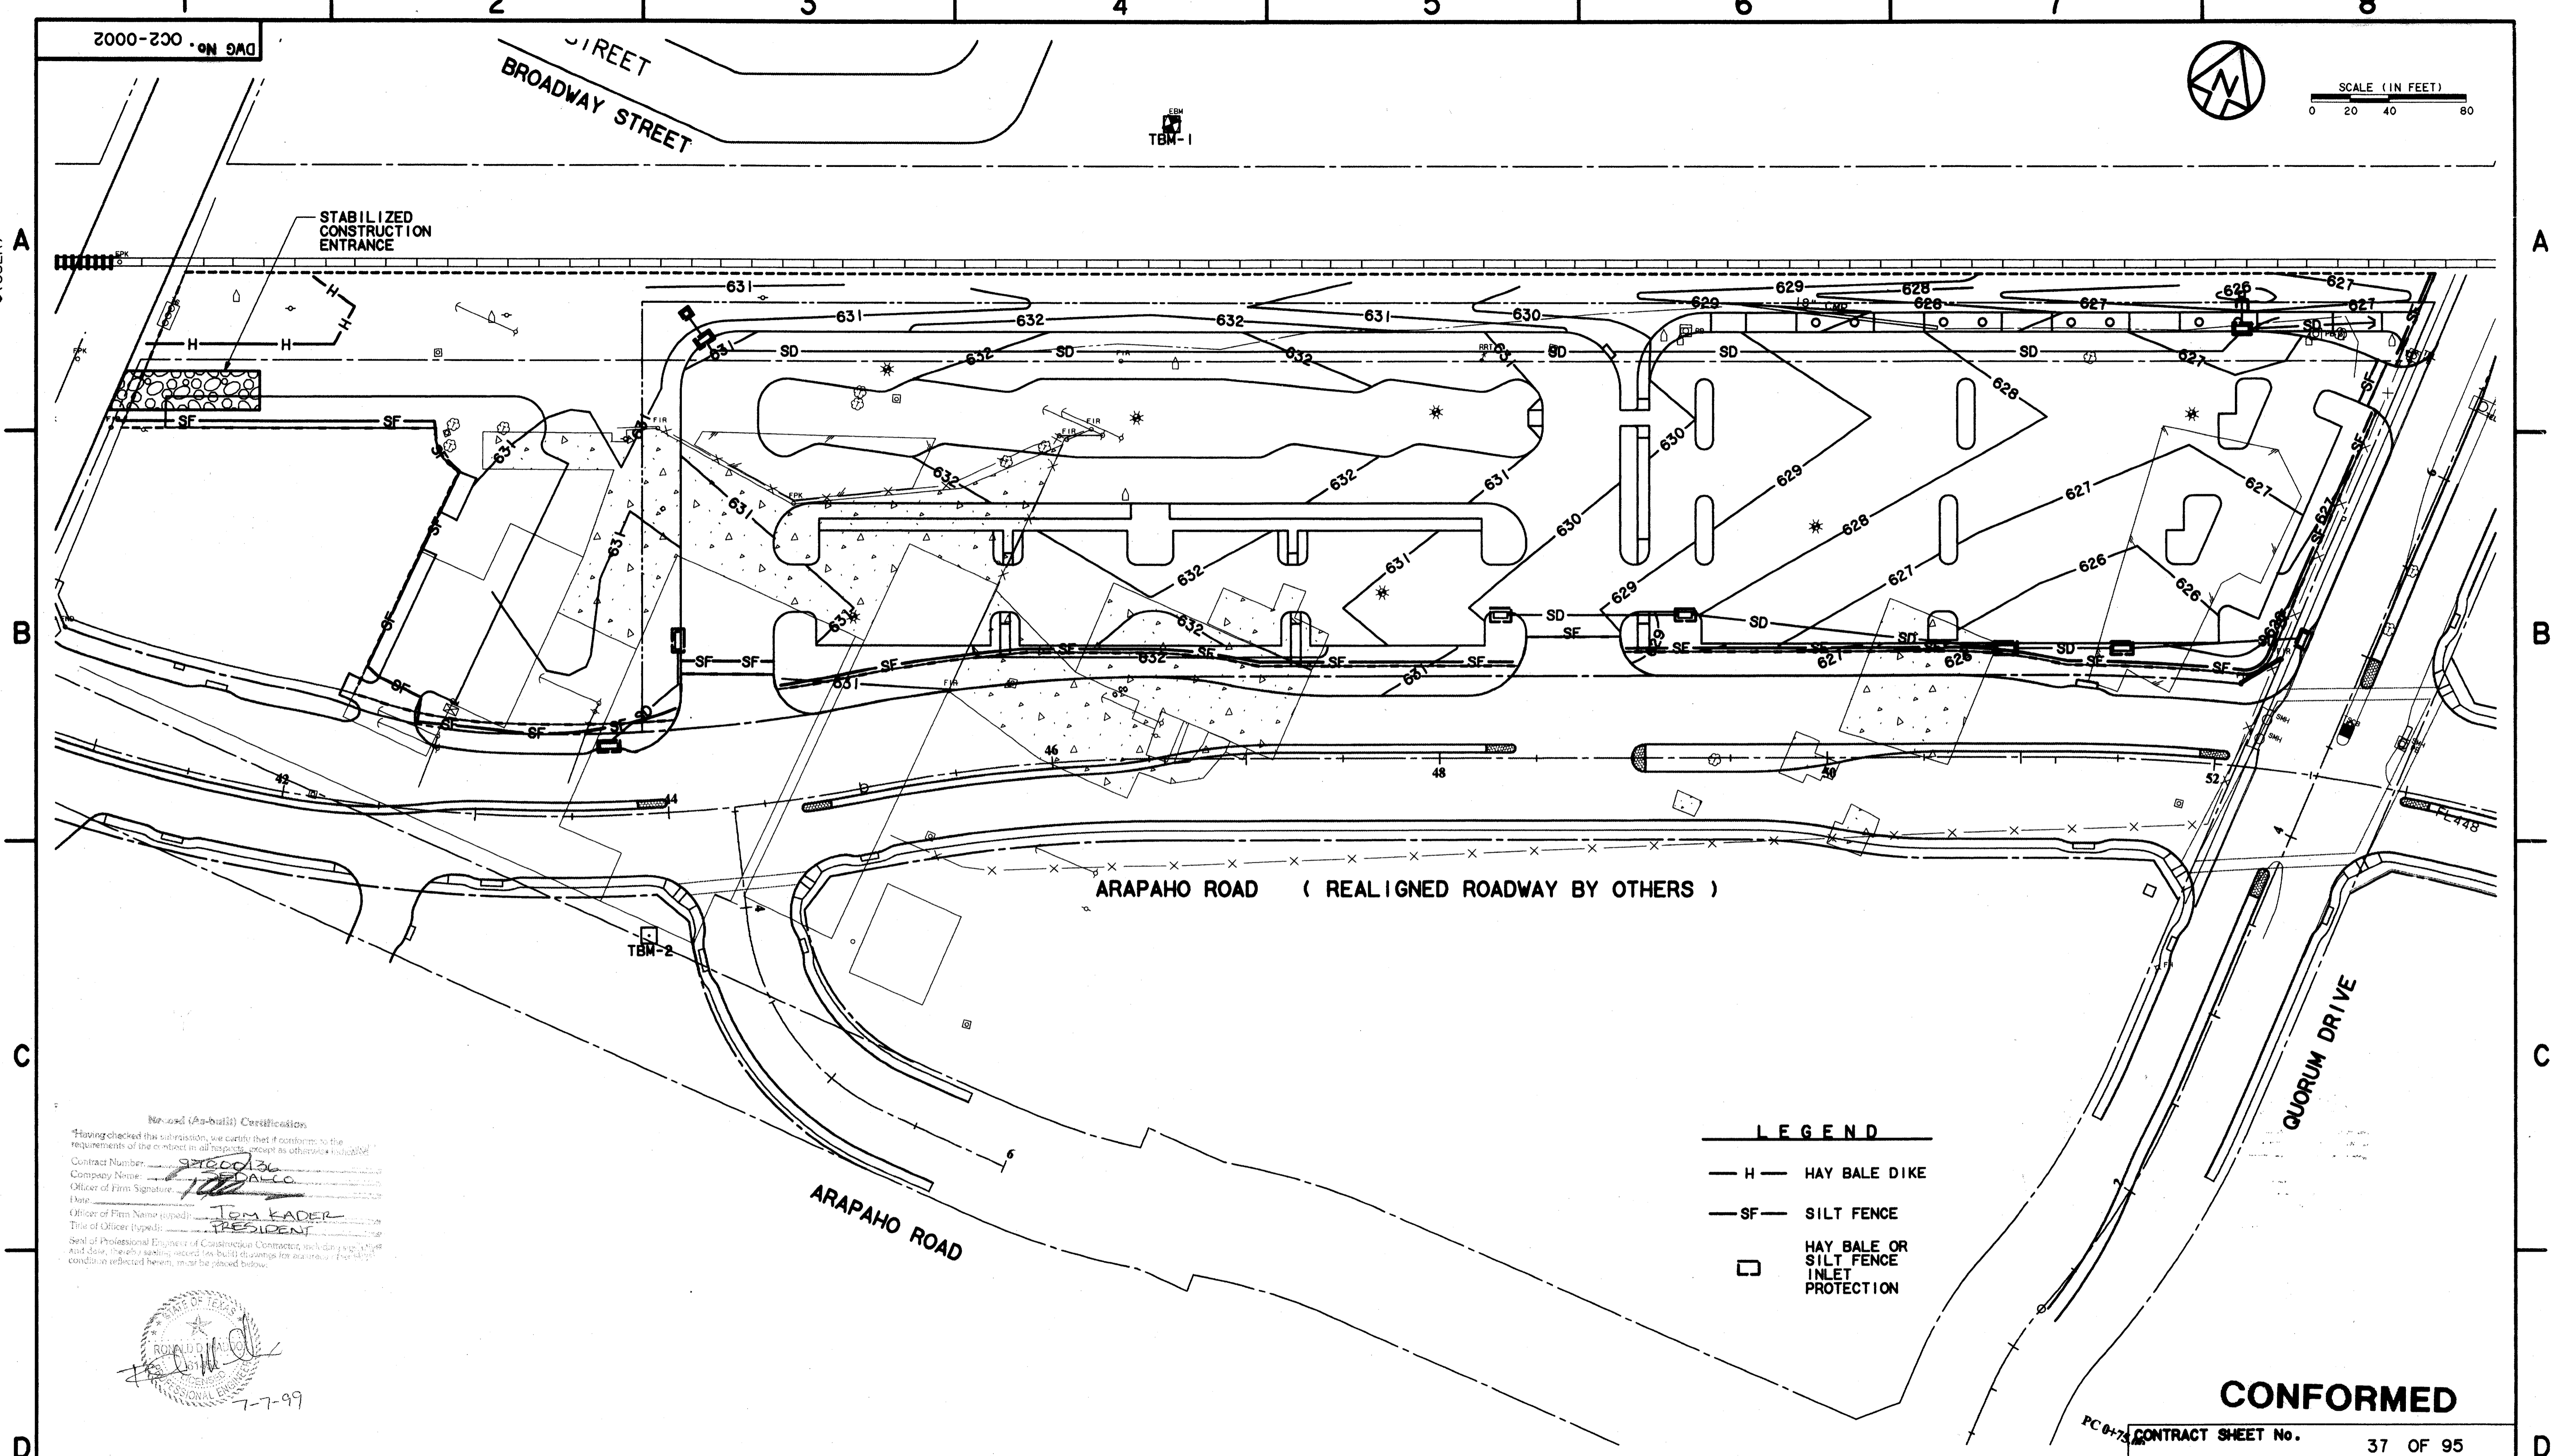

Record (As-built) Certifications
Having checked this submission, we certify that it conforms to the requirements of the contract in all respects, except as otherwise indicated.
Contract Number: 97000136
Company Name: W&A
Officer of Firm Signature: [Signature]
Date: 7-7-99
Officer of Firm Name (Typed): TOM KADER
Title of Officer (Typed): PRESIDENT
Send of Professional Engineer of Construction Contract, with date, sheet and date, the plan being recorded for approval. If any condition is reflected herein, it may be placed below.

- LEGEND**
- H — HAY BALE DIKE
 - SF — SILT FENCE
 - HAY BALE OR SILT FENCE INLET PROTECTION


CONFORMED

CONTRACT SHEET No. 37 OF 95

REV	DATE	DESCRIPTION	BY	ENG	CHK	APP	REV	DATE	DESCRIPTION	BY	ENG	CHK	APP
△							△						
△							△						
WENDY LOPEZ & ASSOC.
LOCKWOOD, ANDREWS & NEWNAM
THE SWA GROUP
GERARD & ASSOCIATES
ZAXON

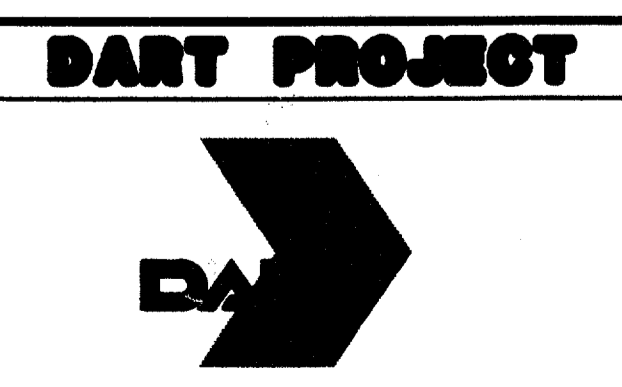

SCALE 1"=40'
DRAWN D. KRUCIAK
DESIGNED P. ZHAO
CHECKED V. STEVENS
IN CHARGE V. STEVENS
DATE AUG. 14, 1997

ADDISON TRANSIT CENTER
SWPPP DEVICE LAYOUT PLAN