


e:\94010.212\shf\abf\ccz06.001  
13 AUG 97  
DART.TBL  
JAMES LANDRY


DWG No. OC2-0003

REINFORCED FILTER FABRIC BARRIER


1. SET POSTS AND EXCAVATE 4" X 4" TRENCH UPSLOPE ALONG LINE OF POSTS.

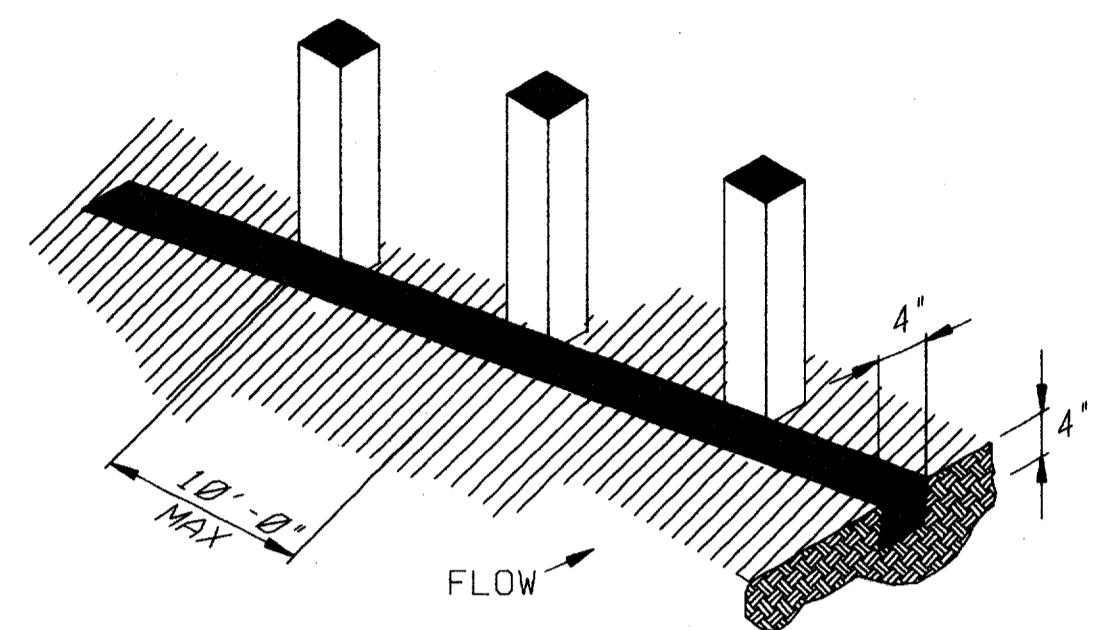



2. SECURE WIRE FENCING TO POSTS.

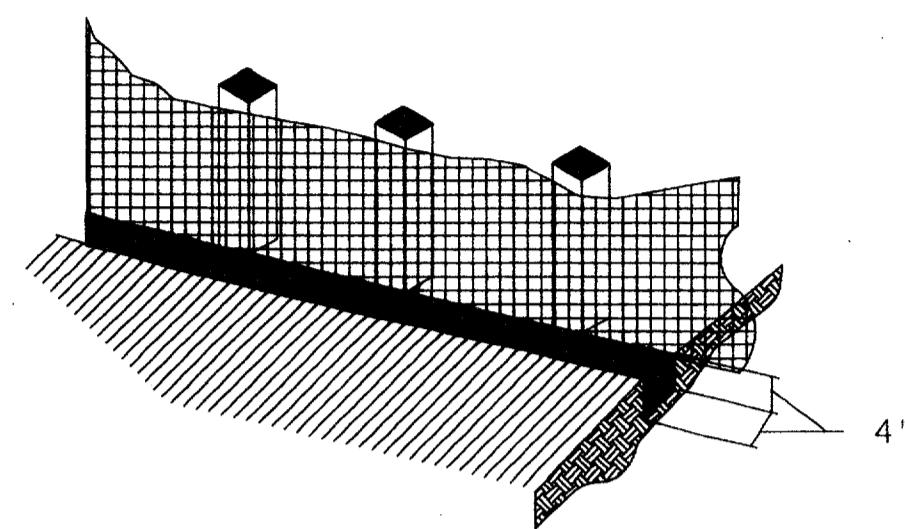


3. ATTACH FILTER MATERIAL TO WIRE FENCE AND EXTEND IT INTO THE TRENCH

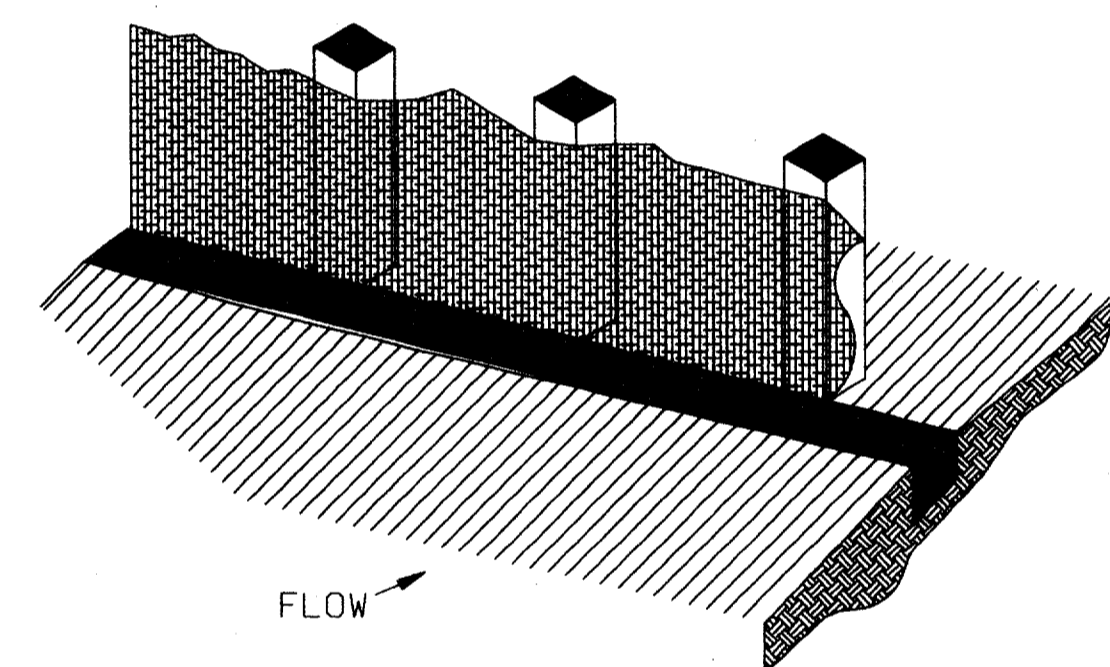


4. BACKFILL AND COMPACT THE EXCAVATED SOIL.

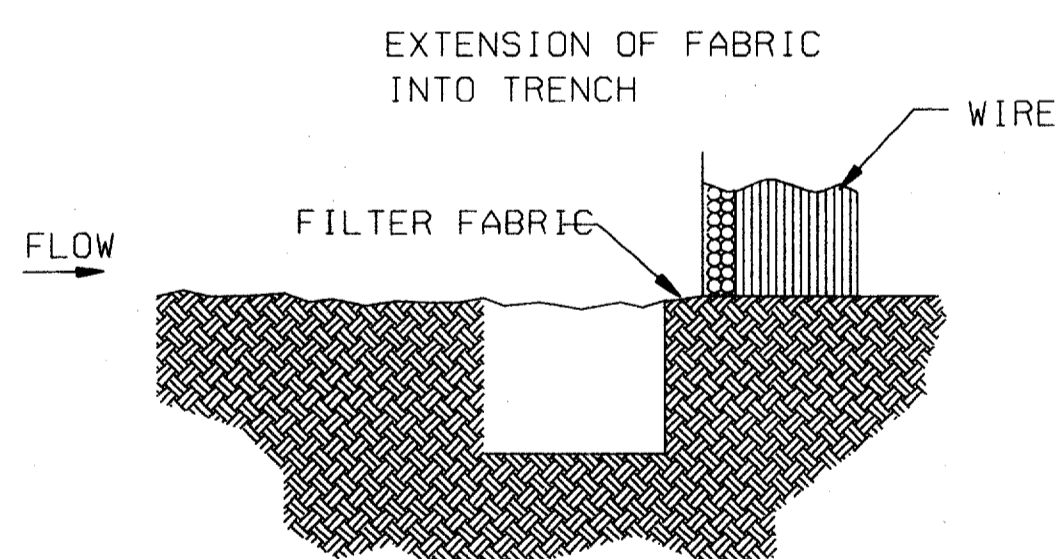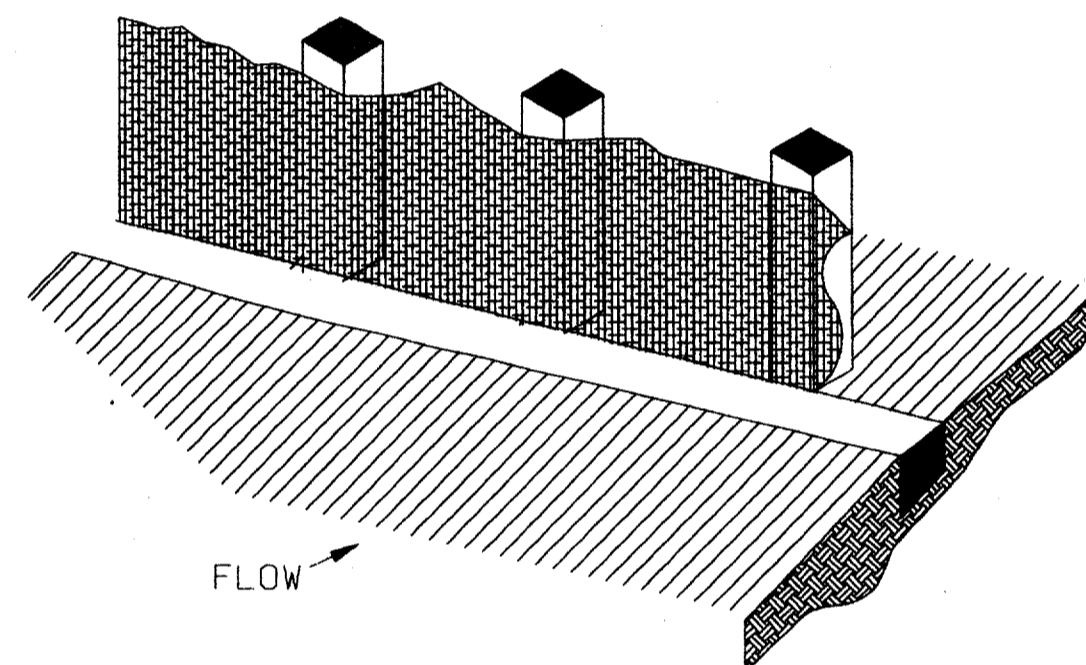

ITEM 4311  
REINFORCED  
FILTER FABRIC BARRIER

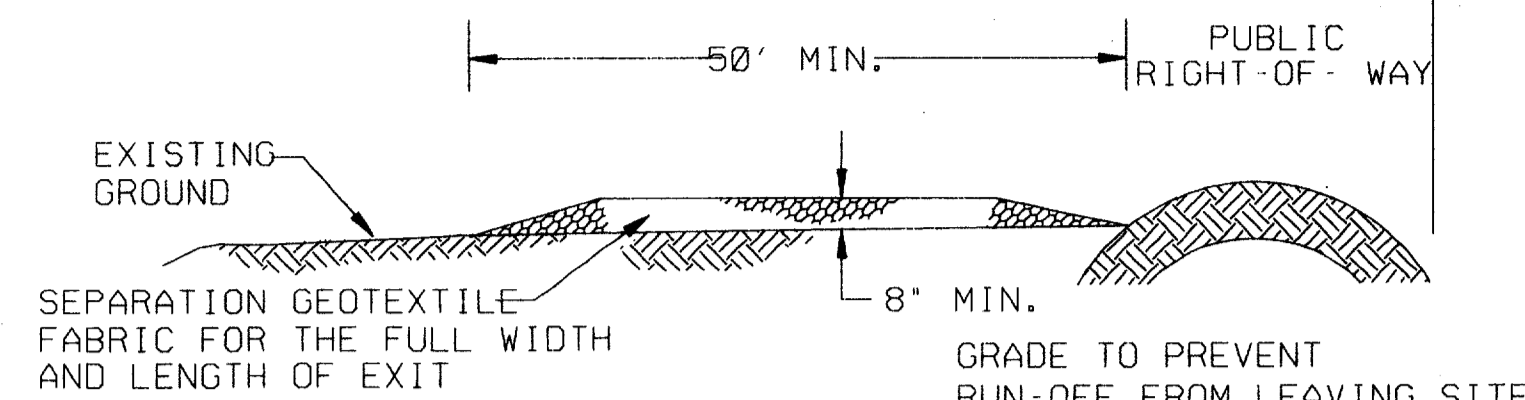

PROFILE

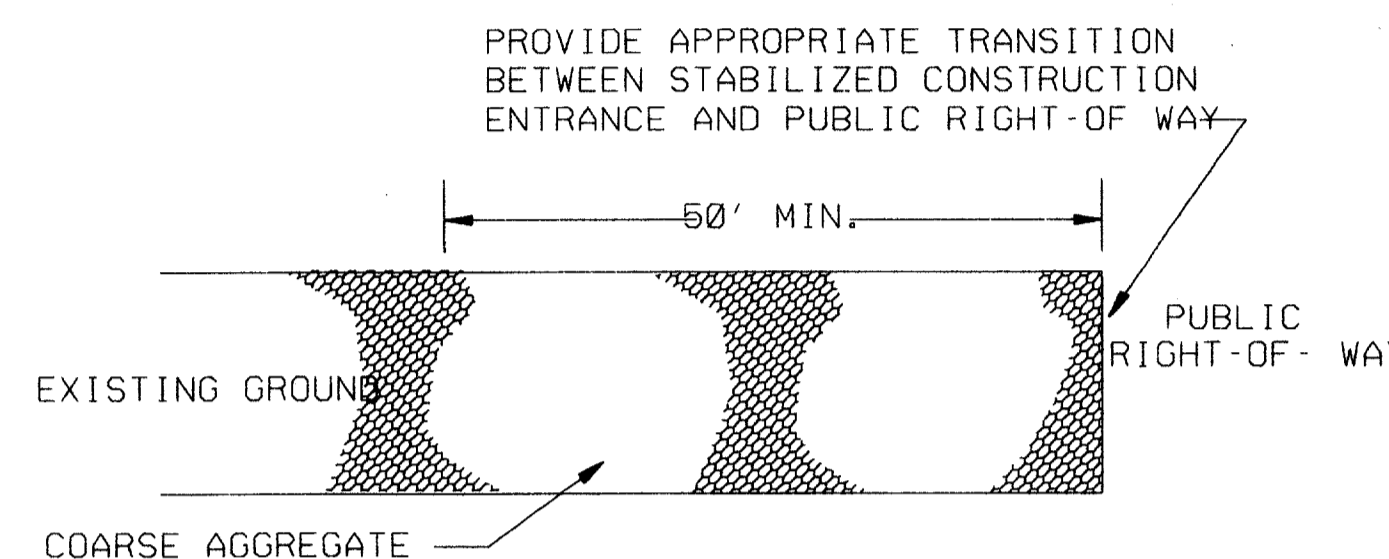

PLAN VIEW

GENERAL NOTES


1. LENGTH SHALL BE AS SHOWN ON THE CONSTRUCTION DRAWINGS, BUT NOT LESS THAN 50 FEET.
2. THICKNESS SHALL BE NOT LESS THAN 8 INCHES.
3. WIDTH SHALL NOT BE LESS THAN FULL WIDTH OF ALL POINTS OF INGRESS OR EGRESS.
4. STABILIZATION FOR OTHER AREAS SHALL HAVE THE SAME AGGREGATE THICKNESS AND WIDTH REQUIREMENTS AS THE STABILIZED CONSTRUCTION EXIT, UNLESS OTHERWISE SHOWN ON THE CONSTRUCTION DRAWINGS.
5. STABILIZED AREA MAY BE WIDEN OR LENGTHEN TO ACCOMMODATE A TRUCK WASHING AREA, WHEN SHOWN ON THE CONSTRUCTION DRAWING. AN OUTLET SEDIMENT TRAP MUST BE PROVIDED FOR THE TRUCK WASHING AREA.

ITEM 4711  
STABILIZED CONSTRUCTION EXIT

GENERAL NOTES

1. WOVEN WIRE FENCE TO BE FASTENED SECURELY TO FENCE POSTS WITH STAPLES.
2. FILTER CLOTH TO BE FASTENED SECURELY TO WOVEN WIRE FENCE, WITH TIES SPACED EVERY 24 INCHES AT TOP AND MIDSECTION.
3. WHEN TWO SECTIONS OF FILTER CLOTH ADJOIN EACH OTHER, THEY SHALL BE OVERLAPPED 6 INCHES AT THE POSTS, AND FOLDED.

STRAW BALE CURB INLET PROTECTION BARRIER

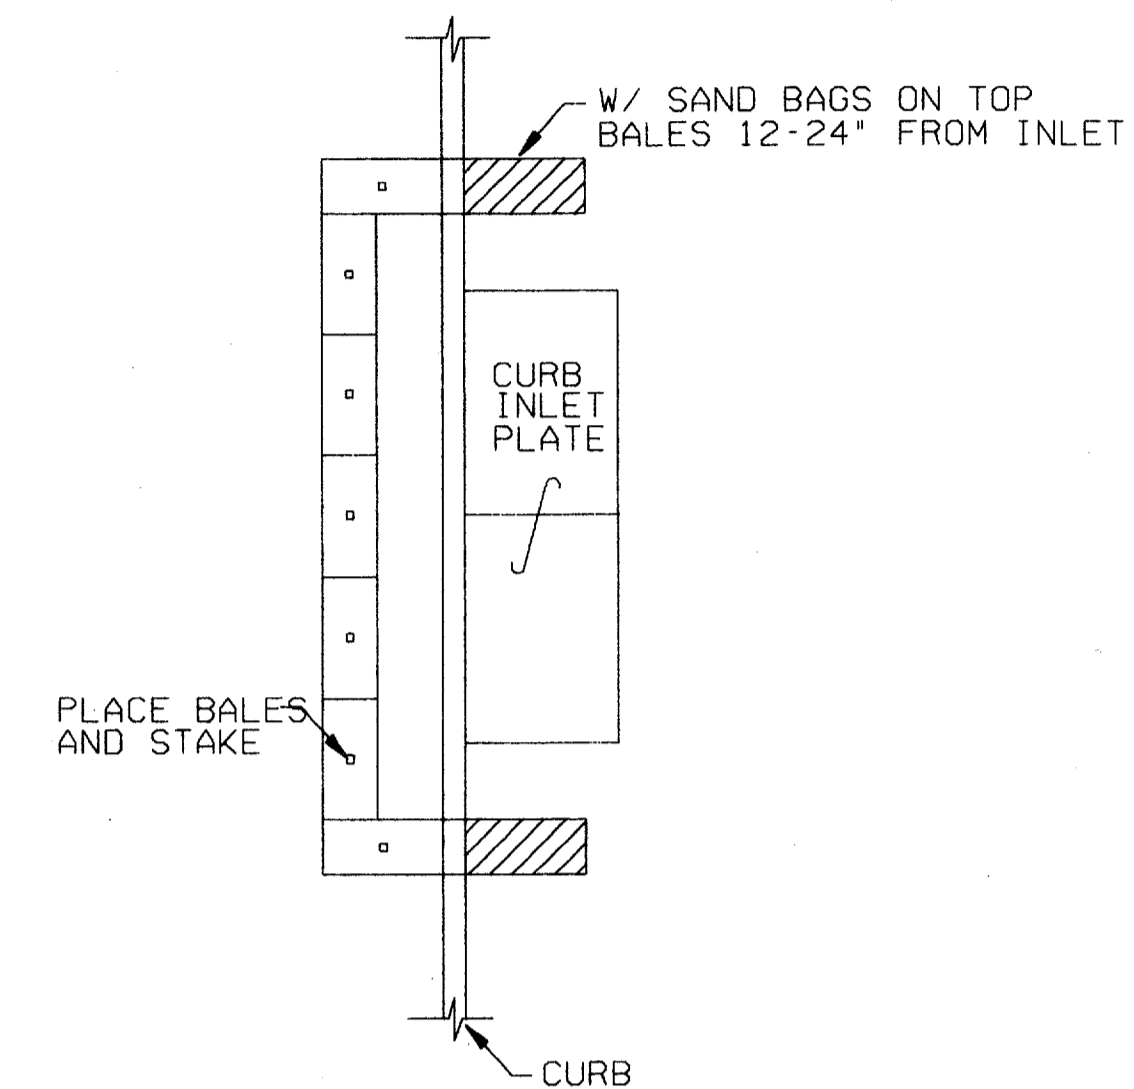

BMP 4. 5. 1. 1.  
INLET PROTECTION BARRIERS

Record (As-built) Certification  
I hereby certify that this drawing conforms to the requirements of the contract, as indicated, or as otherwise indicated.  
Contract No. 9700136  
County of Tarrant  
City of Dallas  
Tom Kader  
PRESIDENT  
Professional Engineer of Construction Contractor, including signature and date, by photo reading and/or (as-built) drawings for accuracy of as-built records as indicated herein.




CONFORMED

CONTRACT SHEET No. 38 OF 95

ADDISON  
TRANSIT CENTER  
SWPPP STANDARD  
DETAILS

REV	DATE	DESCRIPTION	BY	ENG	CHK	APP	REV	DATE	DESCRIPTION	BY	ENG	CHK	APP

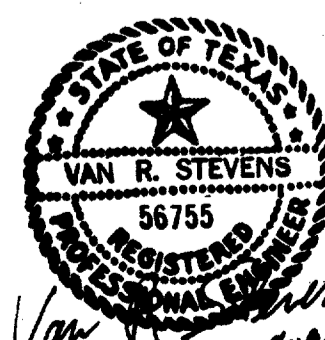

WENDY LOPEZ & ASSOC.  
LOCKWOOD, ANDREWS & NEWNAM  
THE SWA GROUP  
GERARD & ASSOCIATES  
ZAXON

**WLA**  
WENDY LOPEZ & ASSOCIATES, INC.  
ENGINEERING • SURVEYING • CONSTRUCTION SERVICES  
200 MARKET CENTER BLVD - SUITE 200  
DALLAS, TEXAS 75201  
(214) 746-7777

DART PROJECT



SCALE N.T.S.  
DRAWN D. KRUCIAK  
DESIGNED P. ZHAO  
CHECKED V. STEVENS  
IN CHARGE V. STEVENS  
DATE 14-AUG-1997



CONTRACT C-97000136  
DWG No. OC2-0003  
REV 0