
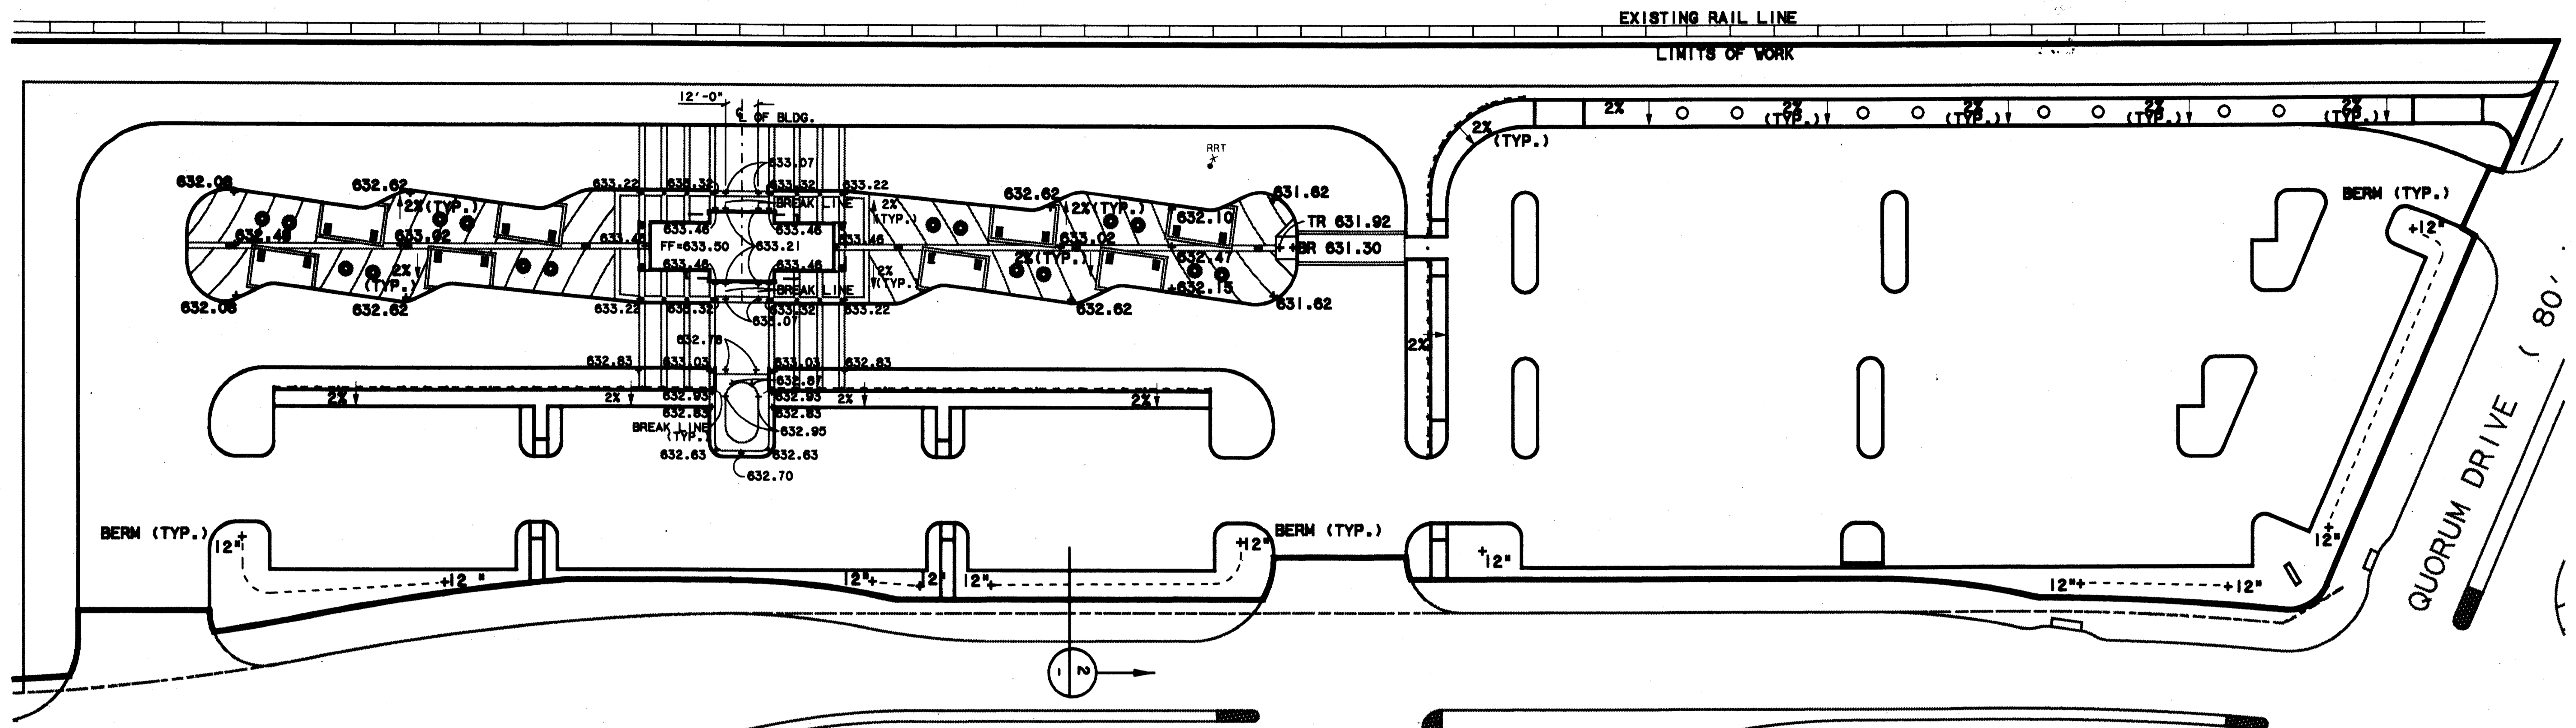


\$\$\$SPECIFICATIONS\$\$\$  
 \$\$\$SYTIME\$\$\$  
 \$\$\$PRF\$\$\$  
 \$\$\$SERNAME\$\$\$  
 \$\$\$PRF ROT\$\$\$  
 \$\$\$PEN\$\$\$  
 \$\$\$FILE6\$\$\$  
 \$\$\$FILE7\$\$\$  
 \$\$\$FILE8\$\$\$  
 \$\$\$FILE9\$\$\$  
 \$\$\$FILE10\$\$\$  
 \$\$\$FILE11\$\$\$  
 \$\$\$FILE12\$\$\$  
 \$\$\$FILE13\$\$\$  
 \$\$\$FILE14\$\$\$  
 \$\$\$FILE15\$\$\$

9000-930 ON 9AD



NOTE:  
ALL SPOT ELEVATIONS SHOWN  
ARE TOP OF CURB TYPICAL,  
UNLESS OTHERWISE NOTED.

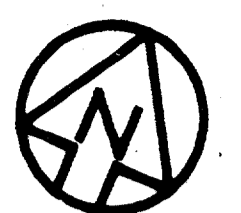

ARAPAHO ROAD  
( PROPOSED 84' R.O.W. )

FINE GRADING PLAN  
SCALE: 1"=30'-0"

Record (As-built) Certification  
Having checked this submission, we certify that it conforms to the requirements of the contract in all respects, except as otherwise indicated.  
Contract Number: 97000136  
Company Name: WENDY LOPEZ & ASSOCIATES, INC.  
Official of Firm Signature: [Signature]  
Date: 7-7-99  
Official of Firm Name (Typed): RONALD D. WILSON  
Title of Official (Typed): PRESIDENT  
Seal of Professional Engineer of Construction Contract, including signature and date, showing passing record for building drawings for accuracy of as-built and from subsequent herein, must be placed below.

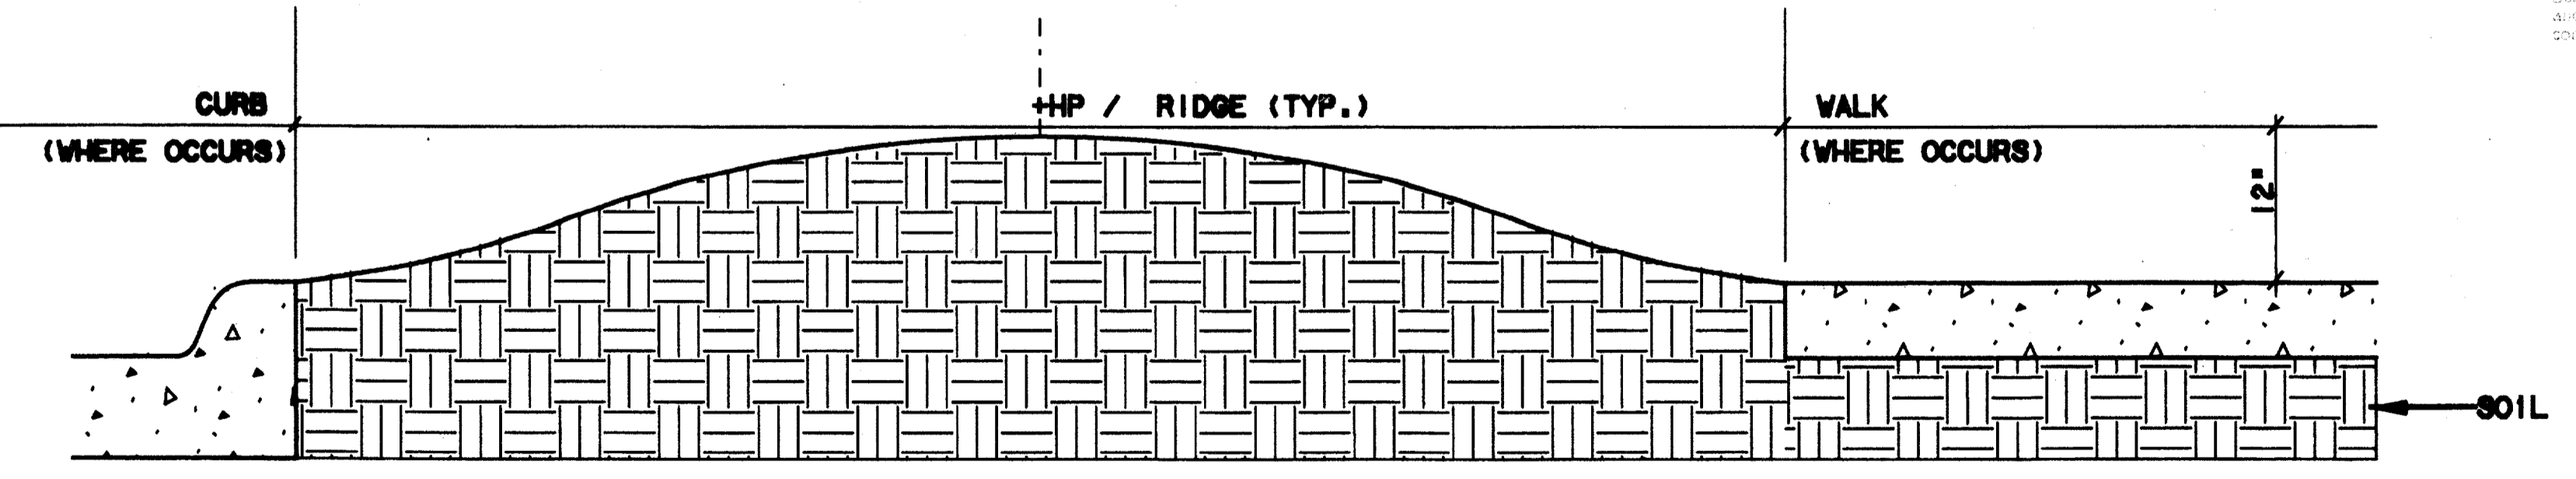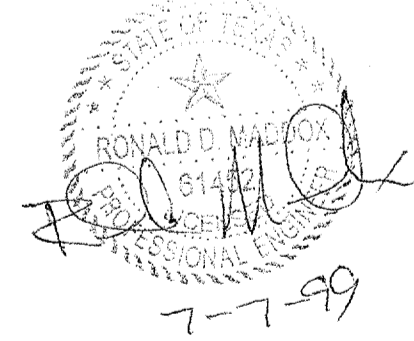

BERM SECTION - TYPICAL  
SCALE: 1"=1'-0"

**CONFORMED**

CONTRACT SHEET No. 39 OF 95

**ADDISON  
TRANSIT CENTER  
FINE GRADING PLAN**

SCALE	1"=30'-0"
DRAWN	N. AVETON
DESIGNED	C. MILLER
CHECKED	C. MILLER
IN CHARGE	V. STEVENS
DATE	14 AUGUST 97

CONTRACT C-97000136    DWG No. CC5-0006    REV 0

REV	DATE	DESCRIPTION	BY	ENG	CHK	APP	REV	DATE	DESCRIPTION	BY	ENG	CHK	APP

 3-2-98	<b>SWA</b> Group 2211 North Lamar Dallas, Texas, 75202 214-954-0016 Landscape Architecture Site Planning Urban Design	 <b>WLA</b> WENDY LOPEZ & ASSOCIATES, INC. ENGINEERING • SURVEYING • CONSTRUCTION SERVICES 1825 MARKET CENTER BLVD - SUITE 510 DALLAS, TEXAS 75207 (214) 746-7777	<b>DART PROJECT</b> 	CAES
------------	--	---	-------------------------	------