



base1, F:\TRANSIT CENTERS\abtc\prl\040, 1-11, 13, 15-32, 34-49, 51-62, 64-79, 81-99, 101-119, 121-139, 961-979, 981-999  
 base2, F:\TRANSIT CENTERS\abtc\prl\040, 10  
 base3, F:\TRANSIT CENTERS\abtc\prl\040, 1-5, 7-15, 17, 18, 20, 23-24, 26, 28-29, 31, 33-34, 36, 38-39, 41, 43-44, 46, 48-49, 51, 53-54, 56, 58-59, 61, 63-64, 66, 68-69, 71, 73-74, 76, 78-79, 81, 83-84, 86, 88-89, 91, 93-94, 96, 98-99  
 base4, F:\TRANSIT CENTERS\abtc\prl\040, 2-9, 11-40, 43-50, 53-60, base11, F:\TRANSIT CENTERS\abtc\prl\040, 1-11, 13, 15-49, 51-62  
 border, F:\TRANSIT CENTERS\abtc\prl\001, 1-3, 6, 15-22, 24-31, 33-34, 36-37, 39-42, 44-45, 47-48, 50-51, 53-54, 56-57, 59-60, 62-63, 65-66, 68-69, 71-72, 74-75, 77-78, 80-81, 83-84, 86-87, 89-90, 92-93, 95-96, 98-99

1000-0007

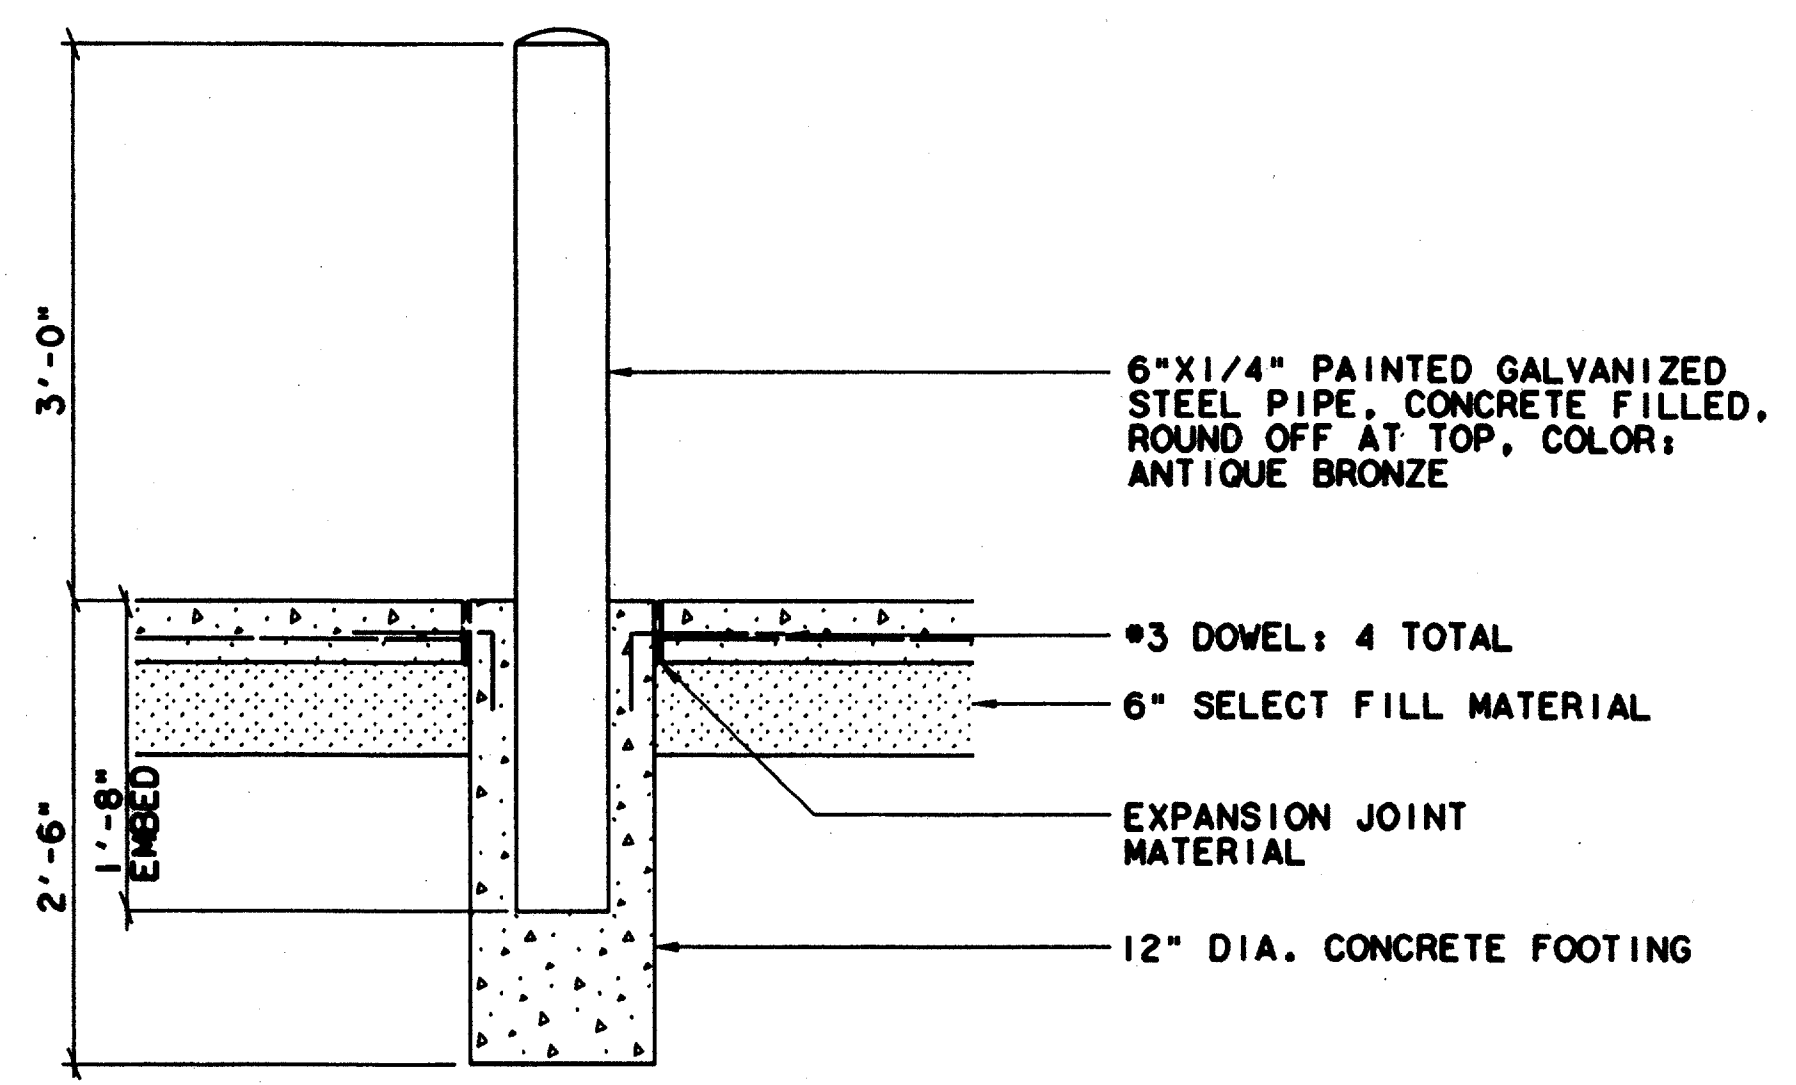



**PEDESTRIAN PIPE BOLLARD - SECTION**  
SCALE: 1"=1'-0"

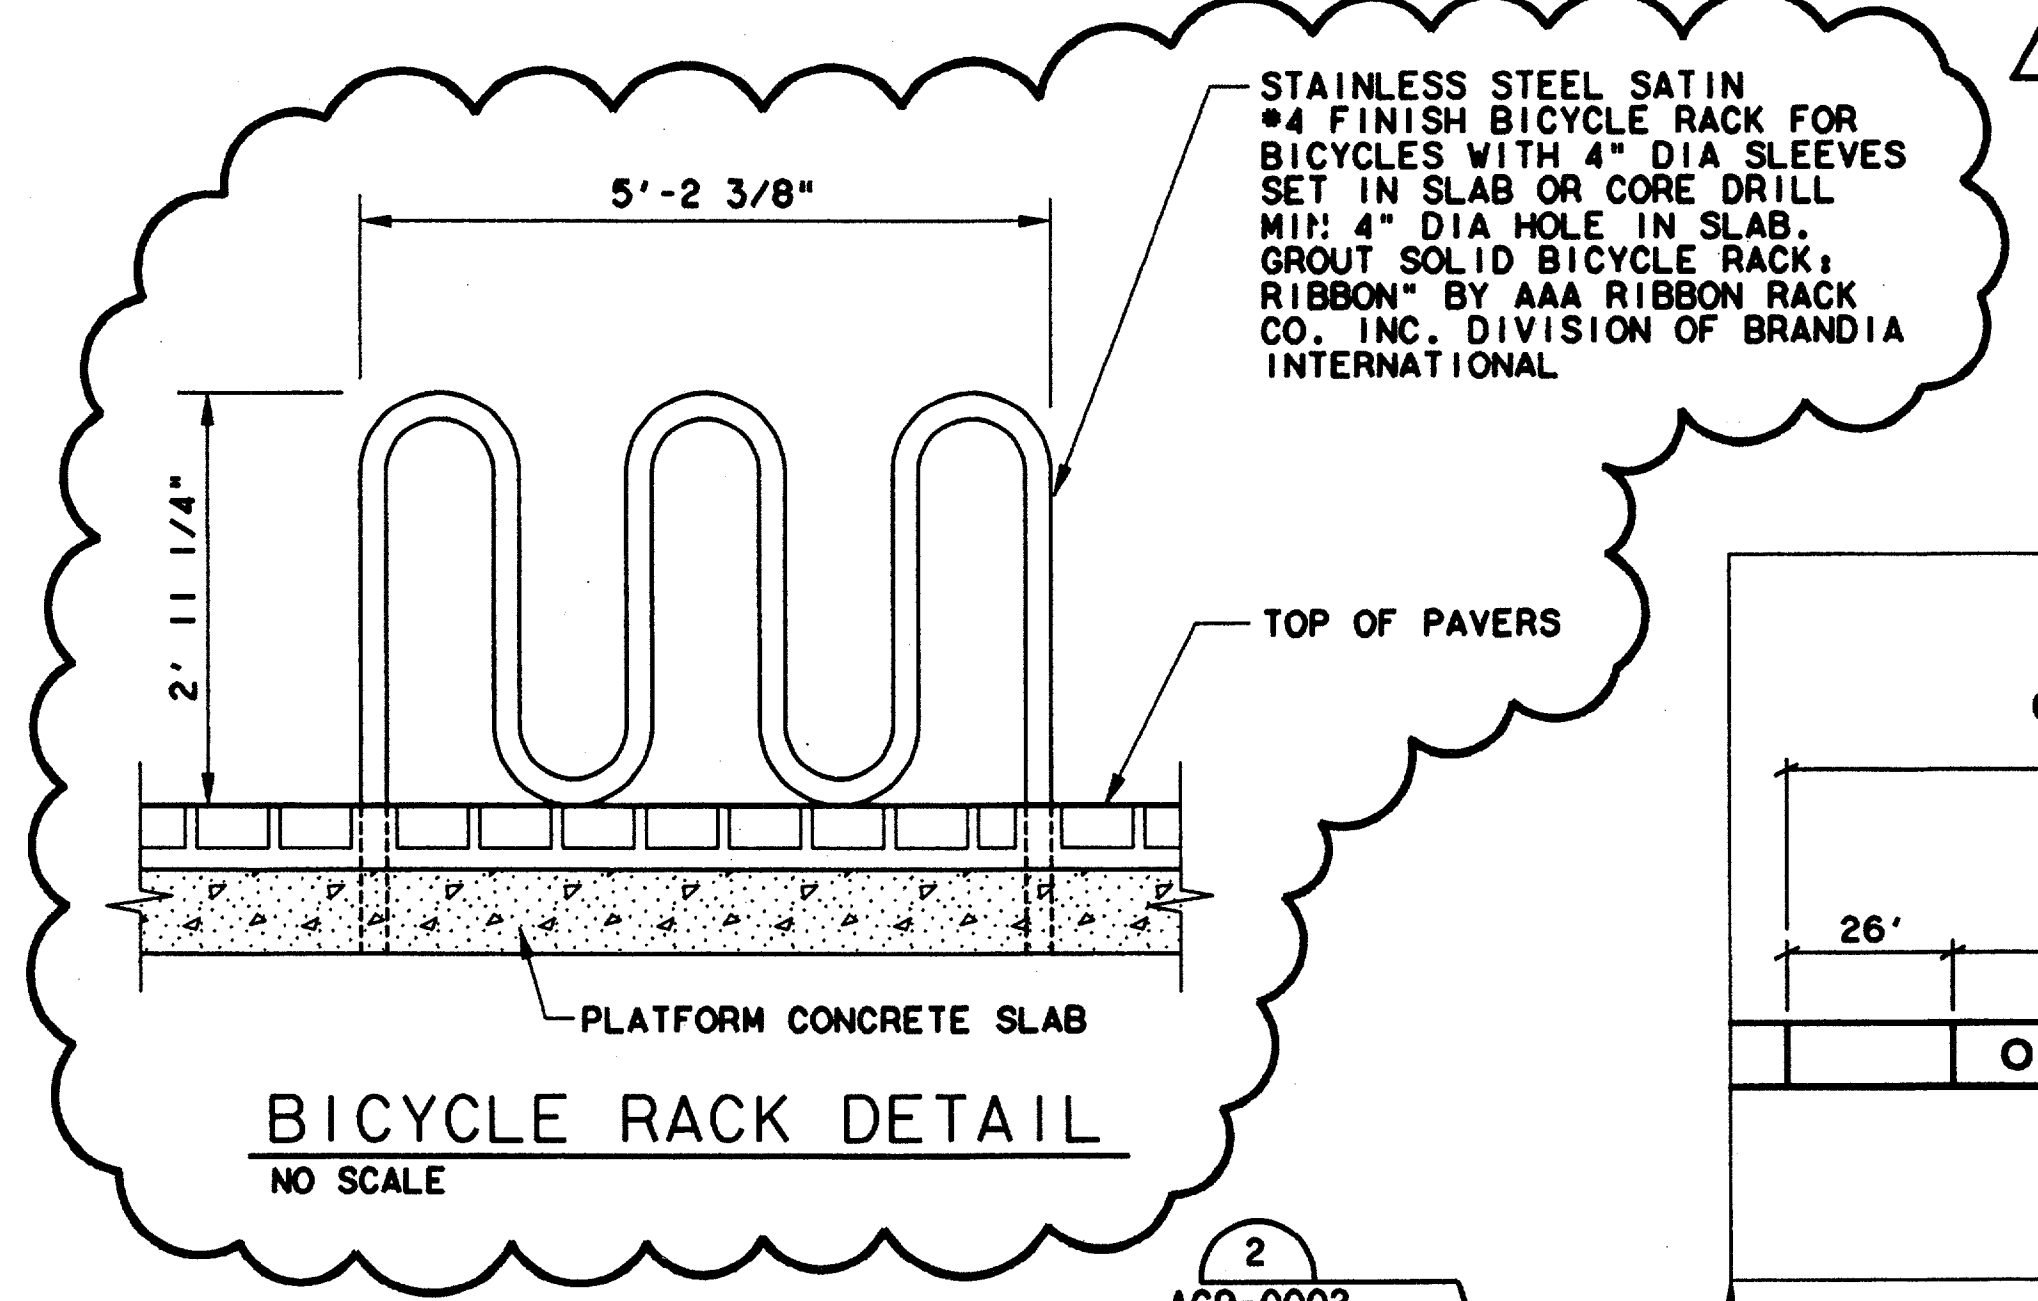


**BICYCLE RACK DETAIL**  
NO SCALE

STAINLESS STEEL SATIN #4 FINISH BICYCLE RACK FOR BICYCLES WITH 4" DIA SLEEVES SET IN SLAB OR CORE DRILL MIN. 4" DIA HOLE IN SLAB. GROUT SOLID BICYCLE RACK, RIBBON" BY AAA RIBBON RACK CO. INC. DIVISION OF BRANDIA INTERNATIONAL


Records (As-built) Certification  
 Having checked this submission, we certify that it conforms to the requirements of the contract as all respects, as otherwise indicated.  
 Contract No. 97000136  
 Company Name: CR#014KE SA#010KA  
 Title of Firm: President  
 Date: 7-7-99  
 Title of Officer: President  
 Seal of Professional Engineer of Construction Contractor, including signature and date, showing sealing record for accuracy of seal must be placed below.

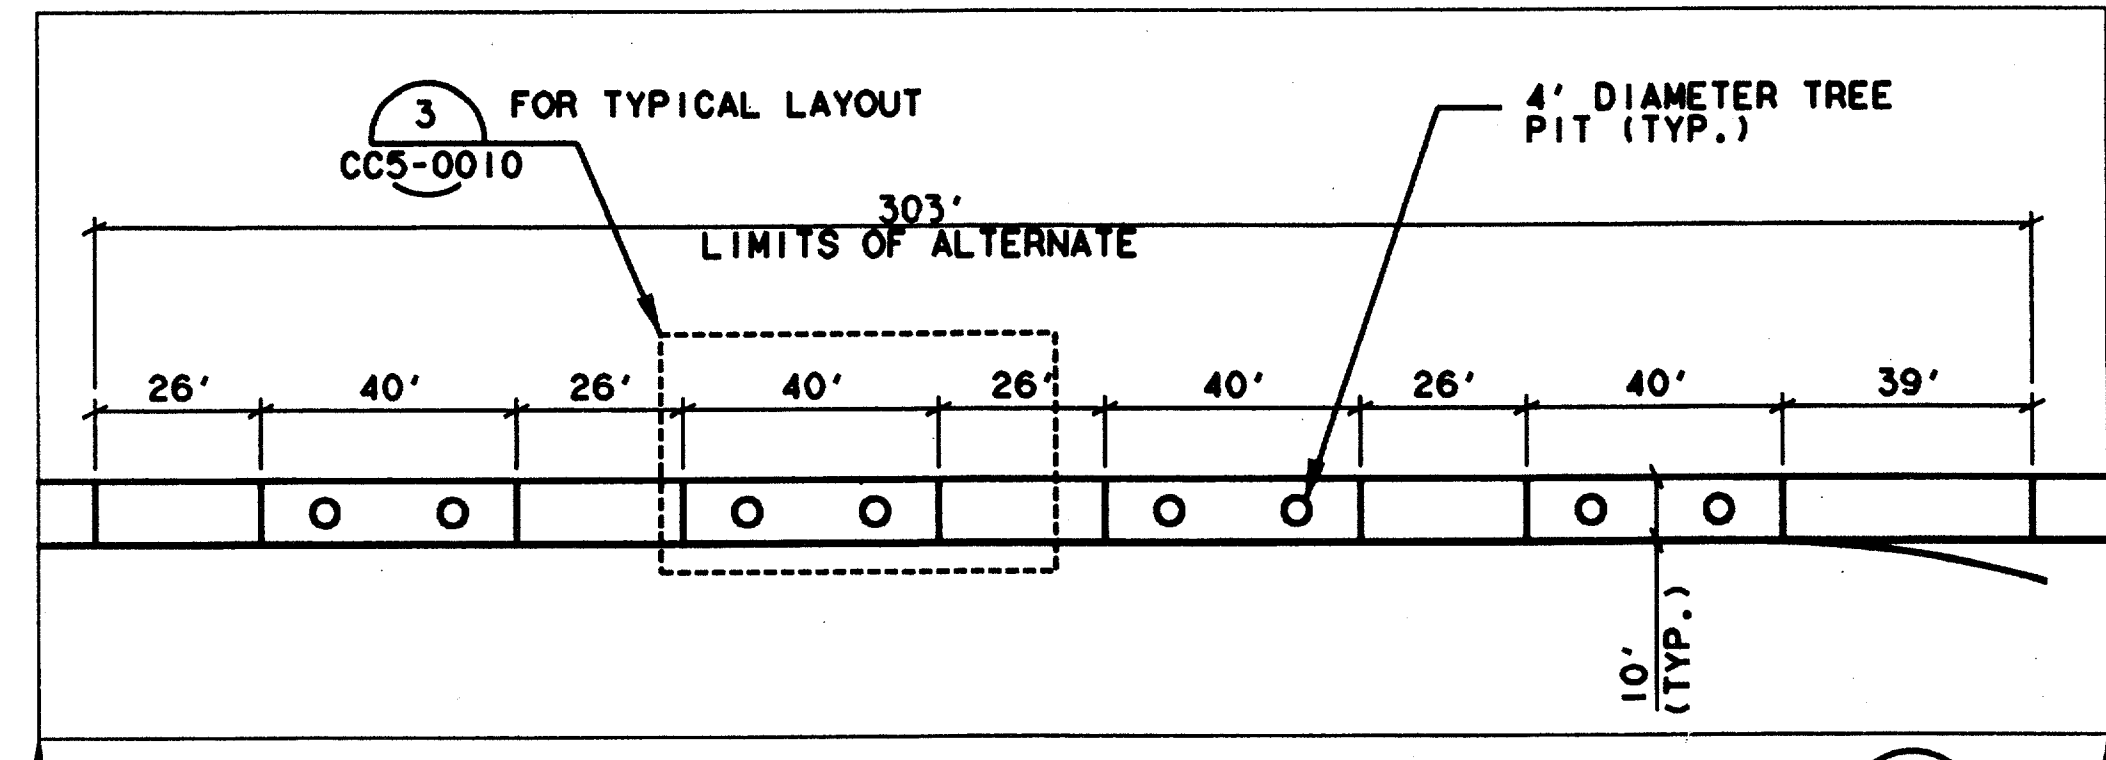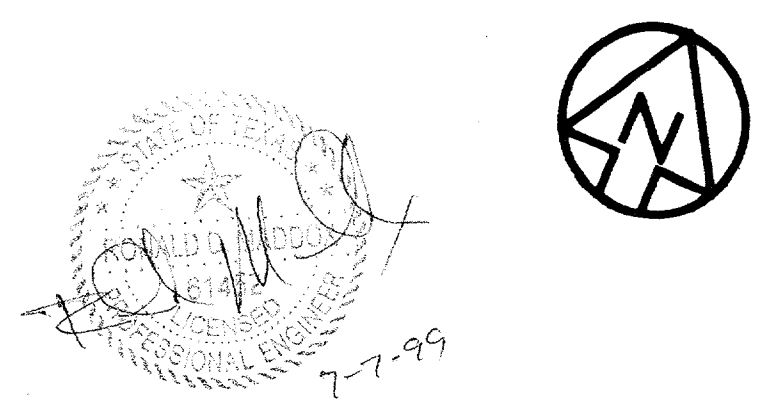

**BRICK PAVER ALTERNATE - PLAN**  
SCALE: 1"=30'-0"

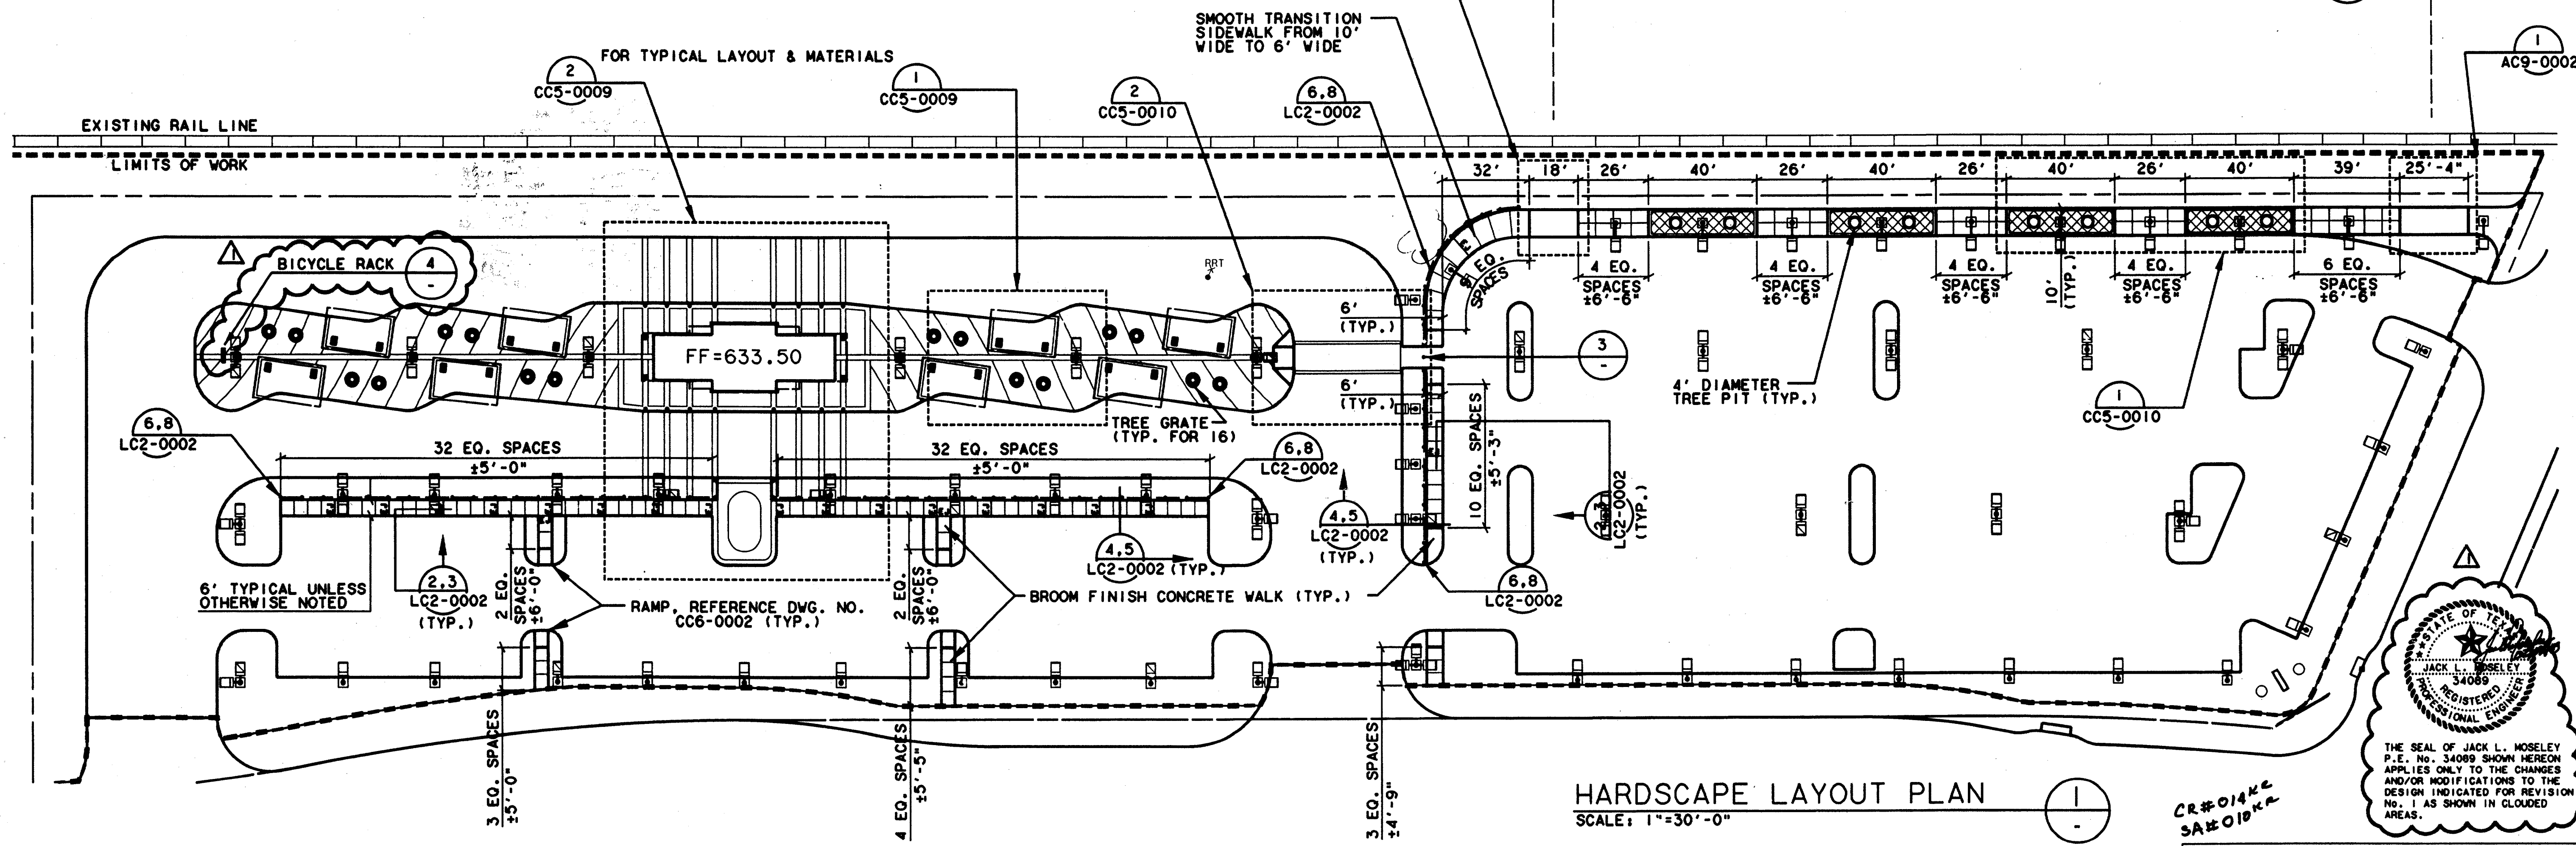

**HARDSCAPE LAYOUT PLAN**  
SCALE: 1"=30'-0"

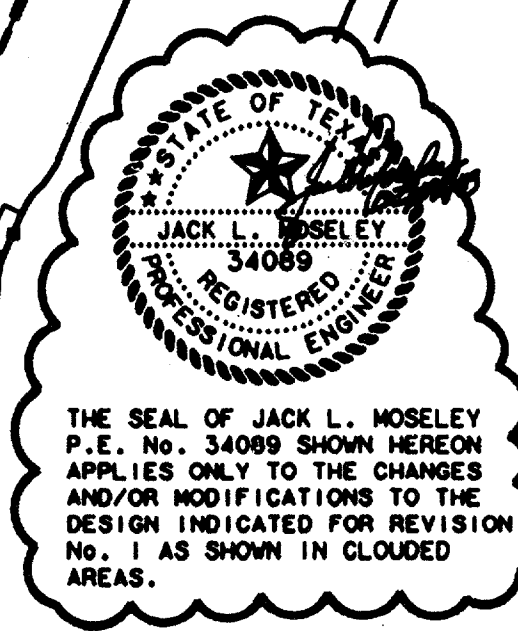

CONTRACT SHEET No. 40 OF 95

REV	DATE	DESCRIPTION	BY	ENG	CHK	APP	REV	DATE	DESCRIPTION	BY	ENG	CHK	APP
△	2/8/99	ADDED BICYCLE RACK	DC	JCM	TJS	JLM							
△													
△													
ORIGINAL SEAL(S) RESIDE IN DART FOR THE FOLLOWING REVISION(S):  
 REV 01: SEALED BY CHRISTOPHER L. MILLER LANDSCAPE ARCHITECT No. 682

**WLA**  
 WENDY LOPEZ & ASSOCIATES, INC.  
 ENGINEERING • SURVEYING • CONSTRUCTION SERVICES  
 102 MARKET CENTER BLDG - SUITE 500  
 DALLAS, TEXAS 75207  
 (214) 746-7777

**DART PROJECT**

SCALE: 1"=30'-0"  
 DRAWN: N. AVETON  
 DESIGNED: C. MILLER  
 CHECKED: C. MILLER  
 IN CHARGE: V. STEVENS  
 DATE: AUG. 14, 1997

**ADDISON TRANSIT CENTER HARDSCAPE LAYOUT PLAN**

CONTRACT C-97000136    DWG No. CC5-0007    REV 1