



\$\$\$\$SYTIME\$\$\$\$
 \$\$\$PRF\$\$\$
 \$\$\$PEN\$\$\$
 \$\$\$ROT\$\$\$
 \$\$\$FILE1\$\$\$
 \$\$\$FILE2\$\$\$
 \$\$\$FILE3\$\$\$
 \$\$\$FILE4\$\$\$
 \$\$\$FILE5\$\$\$

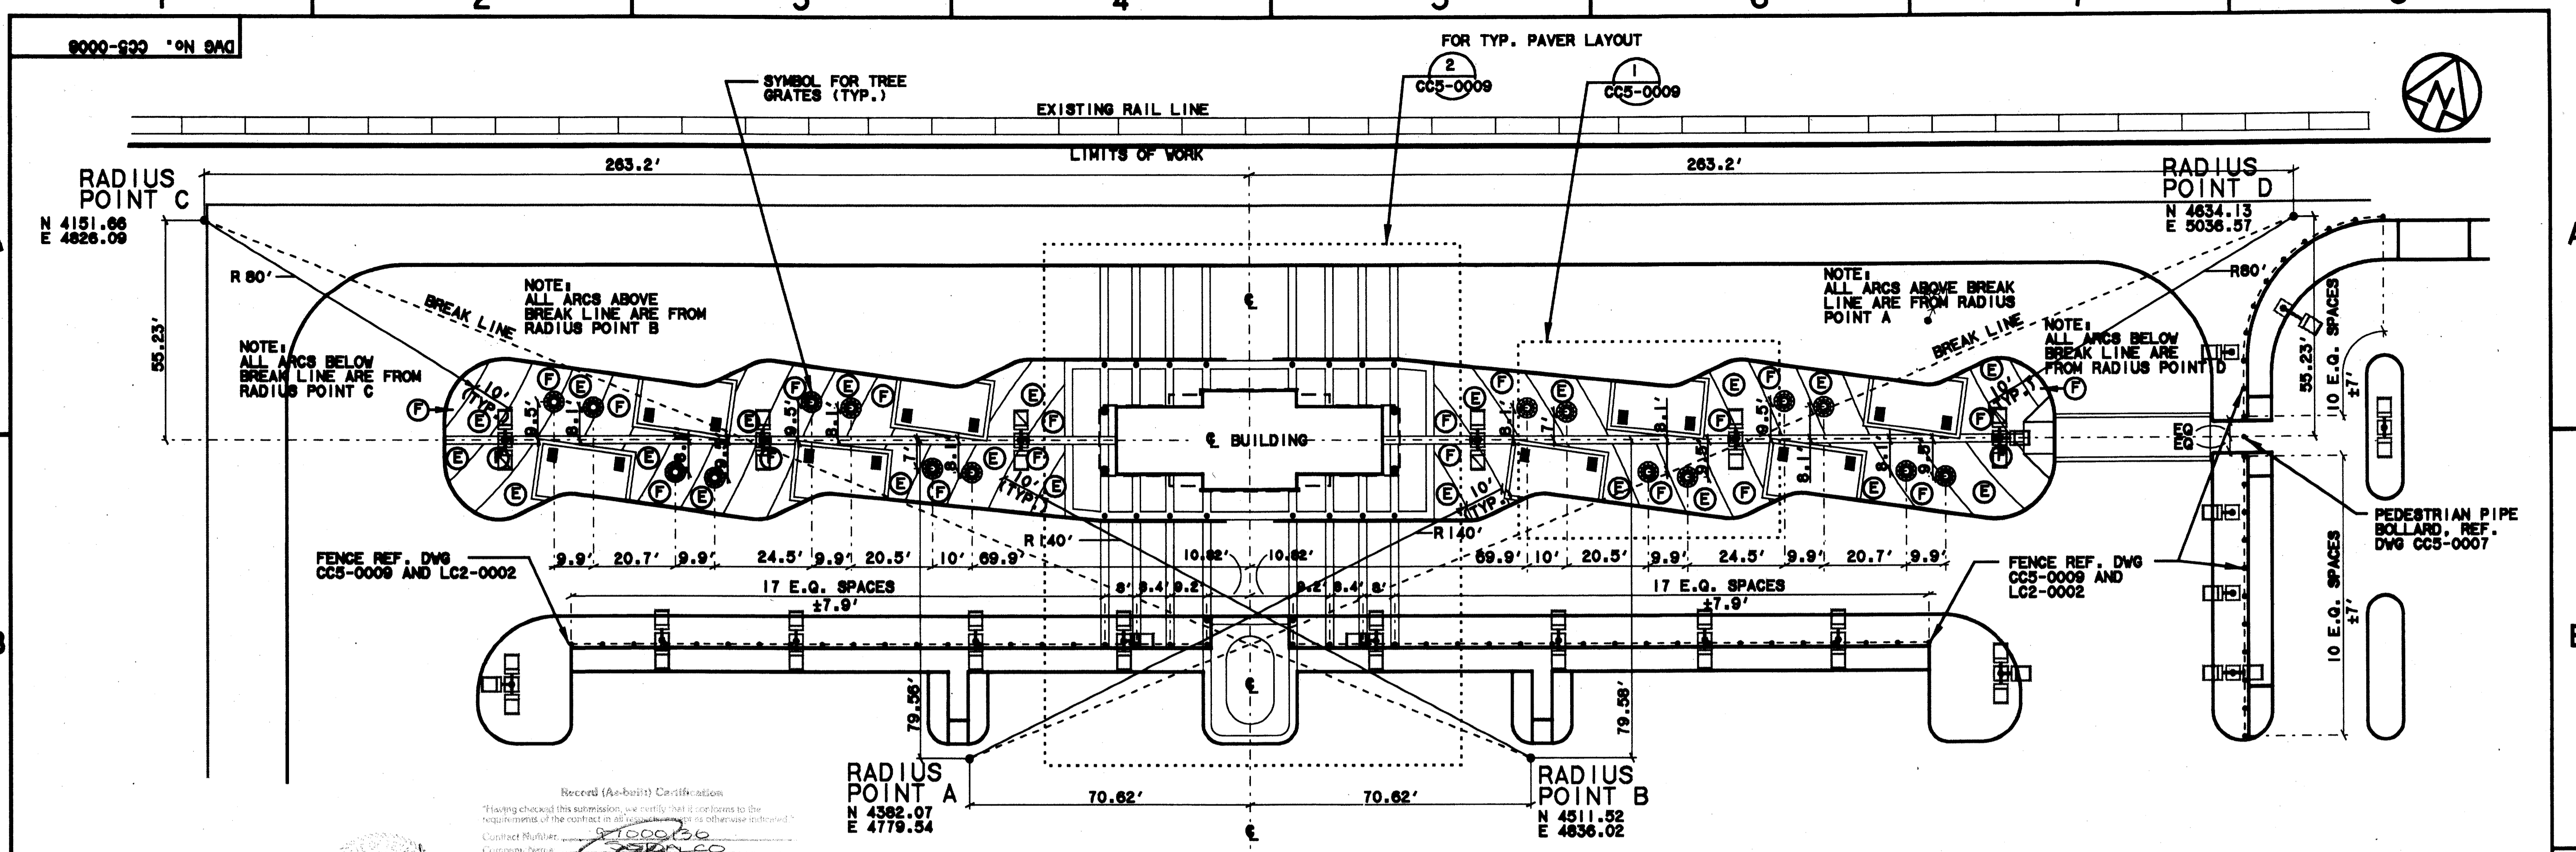

Record (As-built) Certification
 Having checked this submission, we certify that it conforms to the requirements of the contract in all respects unless otherwise indicated.
 Contract Number: 1000136
 Contract Name: ADDISON TRANSIT CENTER
 Date: 7-17-09
 Title of Firm: TOM KADER, PRESIDENT
 Title of Officer: PRESIDENT
 Seal of Licensed Professional Engineer of Construction Contracting, including signature and title, thereby certifying that the drawings are true and correct to the best of his knowledge and belief, and that he is duly licensed to practice in the State of Texas.

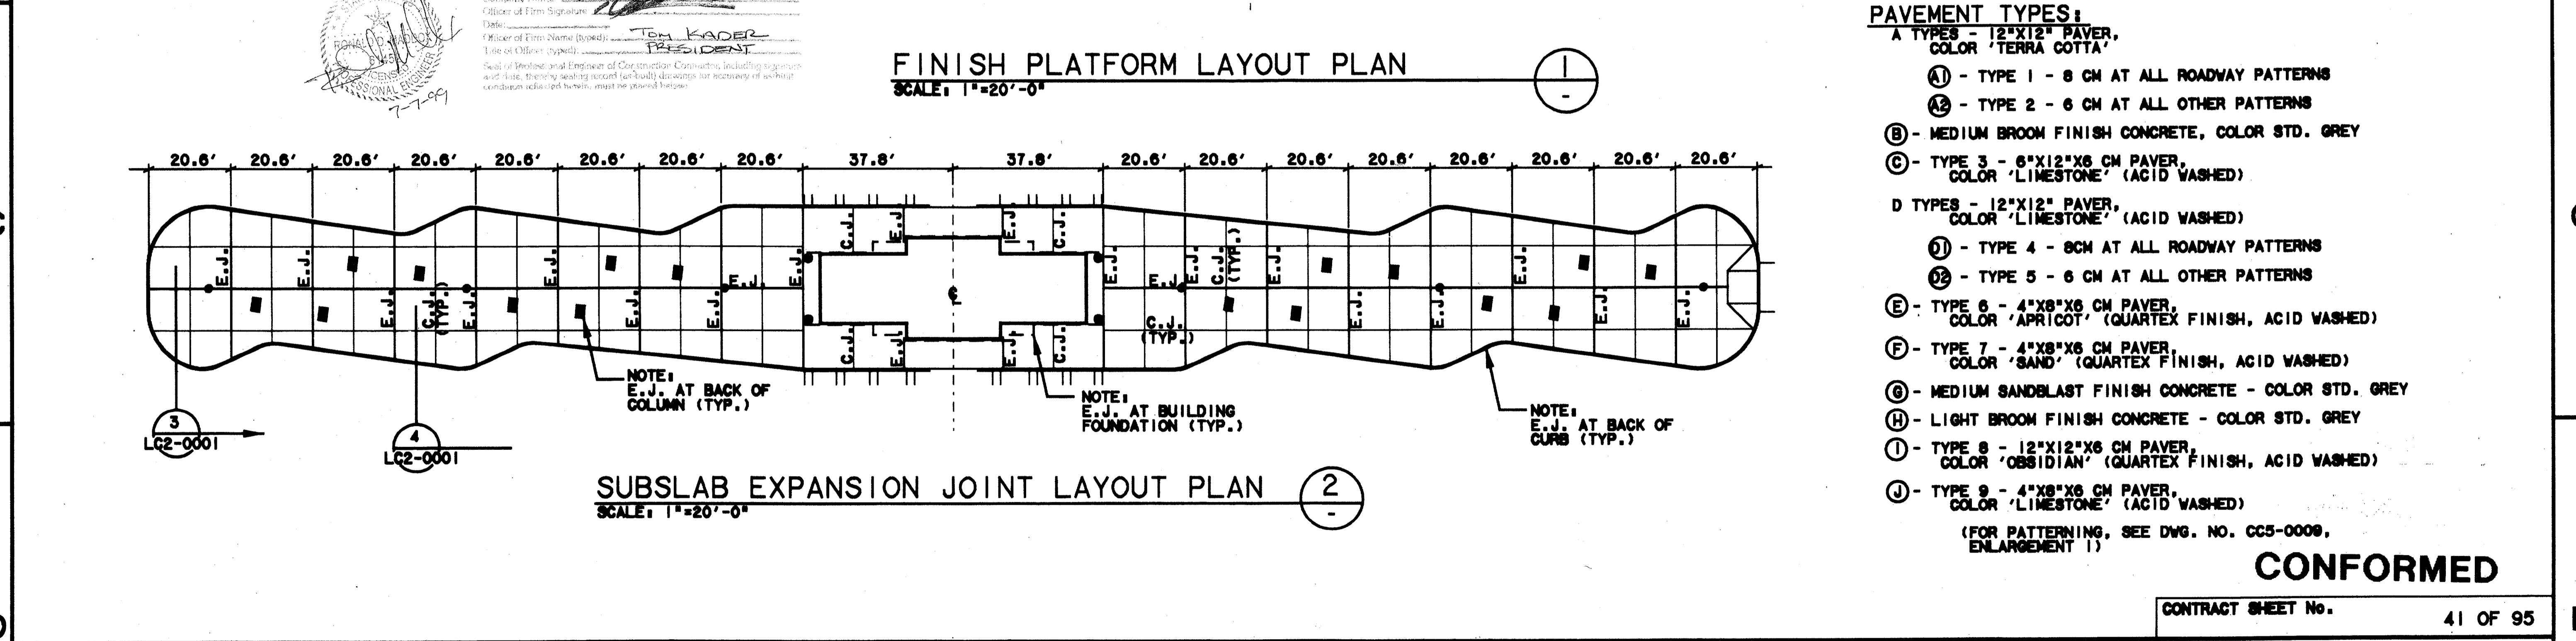

- PAVEMENT TYPES:**
- A TYPES - 12"x12" PAVER, COLOR 'TERRA COTTA'
 - ① - TYPE 1 - 8 CM AT ALL ROADWAY PATTERNS
 - ② - TYPE 2 - 6 CM AT ALL OTHER PATTERNS
 - B - MEDIUM BROOM FINISH CONCRETE, COLOR STD. GREY
 - C - TYPE 3 - 8"x12"x6 CM PAVER, COLOR 'LIMESTONE' (ACID WASHED)
 - D TYPES - 12"x12" PAVER, COLOR 'LIMESTONE' (ACID WASHED)
 - ① - TYPE 4 - 8 CM AT ALL ROADWAY PATTERNS
 - ② - TYPE 5 - 6 CM AT ALL OTHER PATTERNS
 - E - TYPE 6 - 4"x8"x6 CM PAVER, COLOR 'APRICOT' (QUARTEX FINISH, ACID WASHED)
 - F - TYPE 7 - 4"x8"x6 CM PAVER, COLOR 'SAND' (QUARTEX FINISH, ACID WASHED)
 - G - MEDIUM SANDBLAST FINISH CONCRETE - COLOR STD. GREY
 - H - LIGHT BROOM FINISH CONCRETE - COLOR STD. GREY
 - I - TYPE 8 - 12"x12"x6 CM PAVER, COLOR 'OBSIDIAN' (QUARTEX FINISH, ACID WASHED)
 - J - TYPE 9 - 4"x8"x6 CM PAVER, COLOR 'LIMESTONE' (ACID WASHED)
- (FOR PATTERNING, SEE DWG. NO. CC5-0009, ENLARGEMENT 1)


CONFORMED

CONTRACT SHEET No. 41 OF 95
ADDISON TRANSIT CENTER
 PLATFORM LAYOUT PLAN

SCALE: 1"=20'-0"
 DRAWN: N. AVETON
 DESIGNED: G. MILLER
 CHECKED: G. MILLER
 IN CHARGE: V. STEVENSON
 DATE: 14 AUGUST 07

CONTRACT C-97000136
 DWG No. CC5-0008
 REV 0

REV	DATE	DESCRIPTION	BY	ENG	CHK	APP	REV	DATE	DESCRIPTION	BY	ENG	CHK	APP

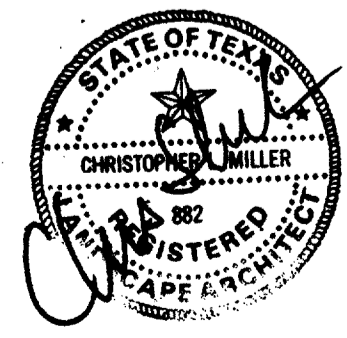

SWA Group
 2211 North Lamar
 Dallas, Texas 75202
 214-954-0016
 Landscape Architecture
 Site Planning
 Urban Design

WLA
WENDY LOPEZ & ASSOCIATES, INC.
 ENGINEERING • SURVEYING • CONSTRUCTION SERVICES
 383 MARKET CENTER BLVD - SUITE 310
 DALLAS, TEXAS 75207
 (214) 761-7777

DART PROJECT